

O.D.O.T. DISTRICT 2 SURVEY OFFICE (USE ONLY)

PERSONNEL

REFERENCE NO. 23

SHEET 21 OF 25

NOTES NIESE

DATE 10/7/24

ROUTE SR 109

H.C. MILLER

WEATHER SUNNY

COUNTY HENRY

R.C. PRESTON-COLVIN

TEMP. 65°

TOWNSHIP MONROE

DWG BY BARRIERE

PID 99587

SECTION 11

T 4 N R 7 E

TYPE MONUMENT MAG NAIL/WASHER

ON SURFACE - BELOW ON

OFFSET Q PAVEMENT LT : RT

TO EDGE PAVEMENT

STATION: 556+89

HORIZ.DATUM: OHIO LDP (HENRY)


GEOID: 18

GRID: NORTHING: 640314.4041


EASTING: 157193.2239

LDP: NORTHING: 462507.609

EASTING: 181181.161

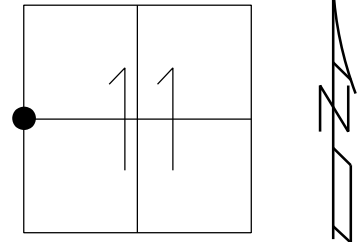

RECORD:
SET MAG/WASHER
10-28-04, MC
FD MAG/W
REF23
12/7/21, DSA
SET MAG/WASHER
10/7/24, TDN

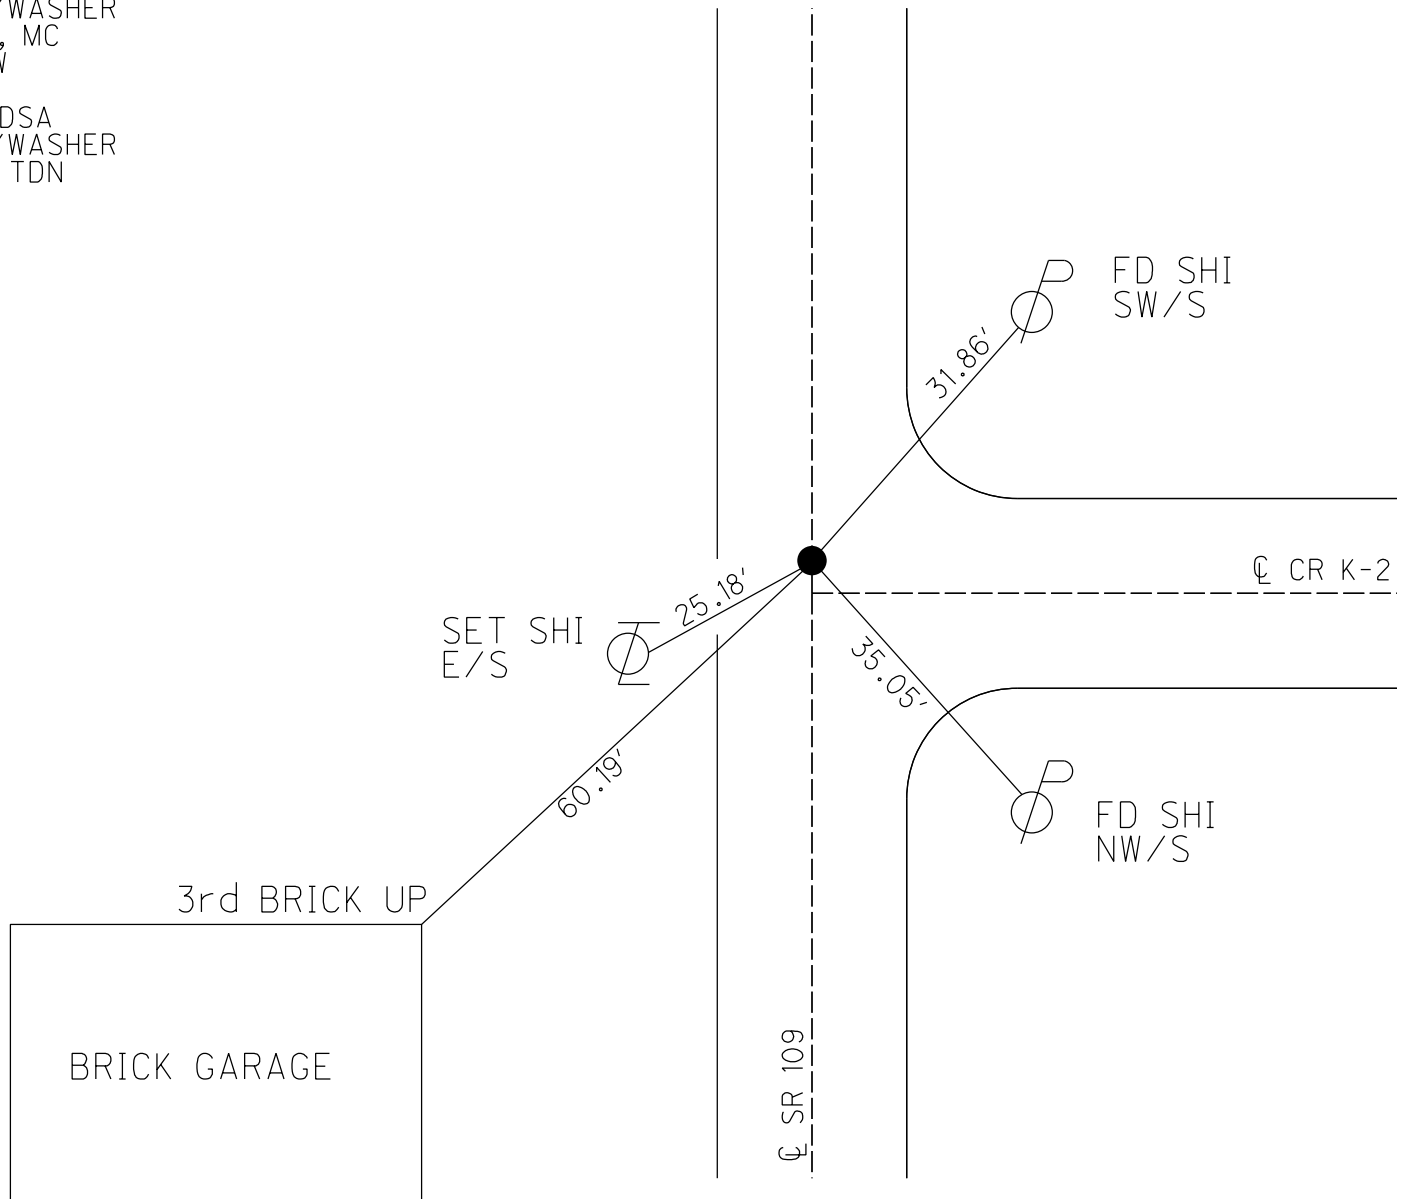


O.D.O.T. DISTRICT 2 SURVEY OFFICE (USE ONLY)


PERSONNEL _____ REFERENCE NO. 23 SHEET 8 OF 38
NOTES CANTERBURY DATE 8-31-04 ROUTE SR 109
H.C. BARNHISEL WEATHER SUNNY COUNTY HENRY
R.C. HOOKE TEMP. 70°F TOWNSHIP MONROE
SECTION 11
T 4 N R 7 E

TYPE MONUMENT PK/WASHER
ON SURFACE - ~~BELOW~~ ON
LEFT - ℄ PAV'T - RIGHT ON
10.1' TO LT EDGE PAVEMENT
S.L.M. 556+89

Grid: Northing: 640314.4041 Easting: 157193.2239

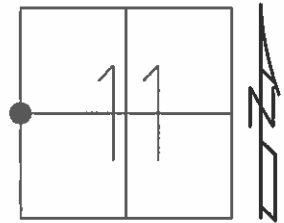

RECORD:
SET MAG/WASHER
10-28-04, MC

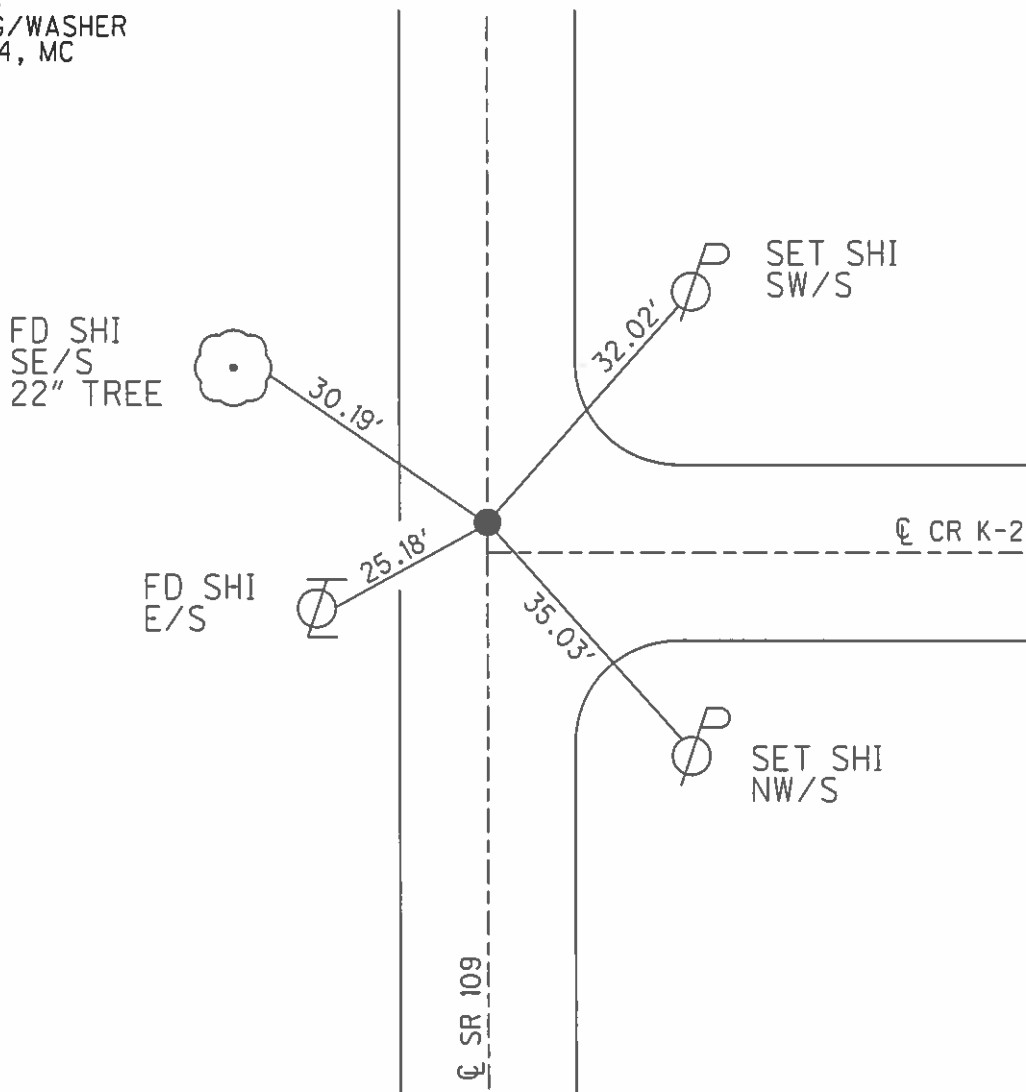

O.D.O.T. DISTRICT 2 SURVEY OFFICE

PERSONNEL

REFERENCE NO. 23

SHEET 7 OF 23

NOTES CANTERBURY

H.C. BARNHISEL

R.C. HOOKE

DATE 8-31-04

WEATHER SUN

TEMP. +70°

ROUTE 109

COUNTY HENRY

TOWNSHIP MONROE

SECTION 11

T 4 N R 7 E


TYPE MONUMENT P.K. / WASHER

ON SURFACE - ~~BELOW~~ SURFACE

~~LEFT - & PAV'T. - RIGHT~~ ON &

10.1' TO LT. EDGE PAVEMENT 2' N. OF & "K-2"

S.L.M. 556 + 89

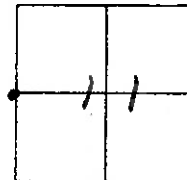

RESET MAG / WASHER

10/28/04

M.C.

Fd. SHI.
22" TREE
SE/S

Fd. SHI.
E/S.

THIS POLE TO BE REMOVED

SET SHI.
SW/S.

Co. Rd "K-2"

THIS POLE TO BE REMOVED

SET SHI.
NW/S.

SR 109

& PAV'T.

30.19'
25.18'

32.02'
35.03'

O.D.O.T. DISTRICT 2 SURVEY OFFICE

PERSONNEL _____

REFERENCE NO. 23

SHEET _____ OF _____

NOTES BARNHISEL

H.C. VAN DUSEN

R.C. KUSZ

DATE 8-17-93

WEATHER Fog

TEMP. +81° F.

ROUTE 109

COUNTY HENRY

TOWNSHIP MONROE

SECTION 11

T 4 N R 7 E



TYPE MONUMENT LG. RR/SPK. PUNCH

ON SURFACE - BELOW YES

LEFT - & PAV'T. - RIGHT YES

10.5 TO LT. EDGE PAVEMENT 2' N. OF E "K2"

S.L.M. 556+89

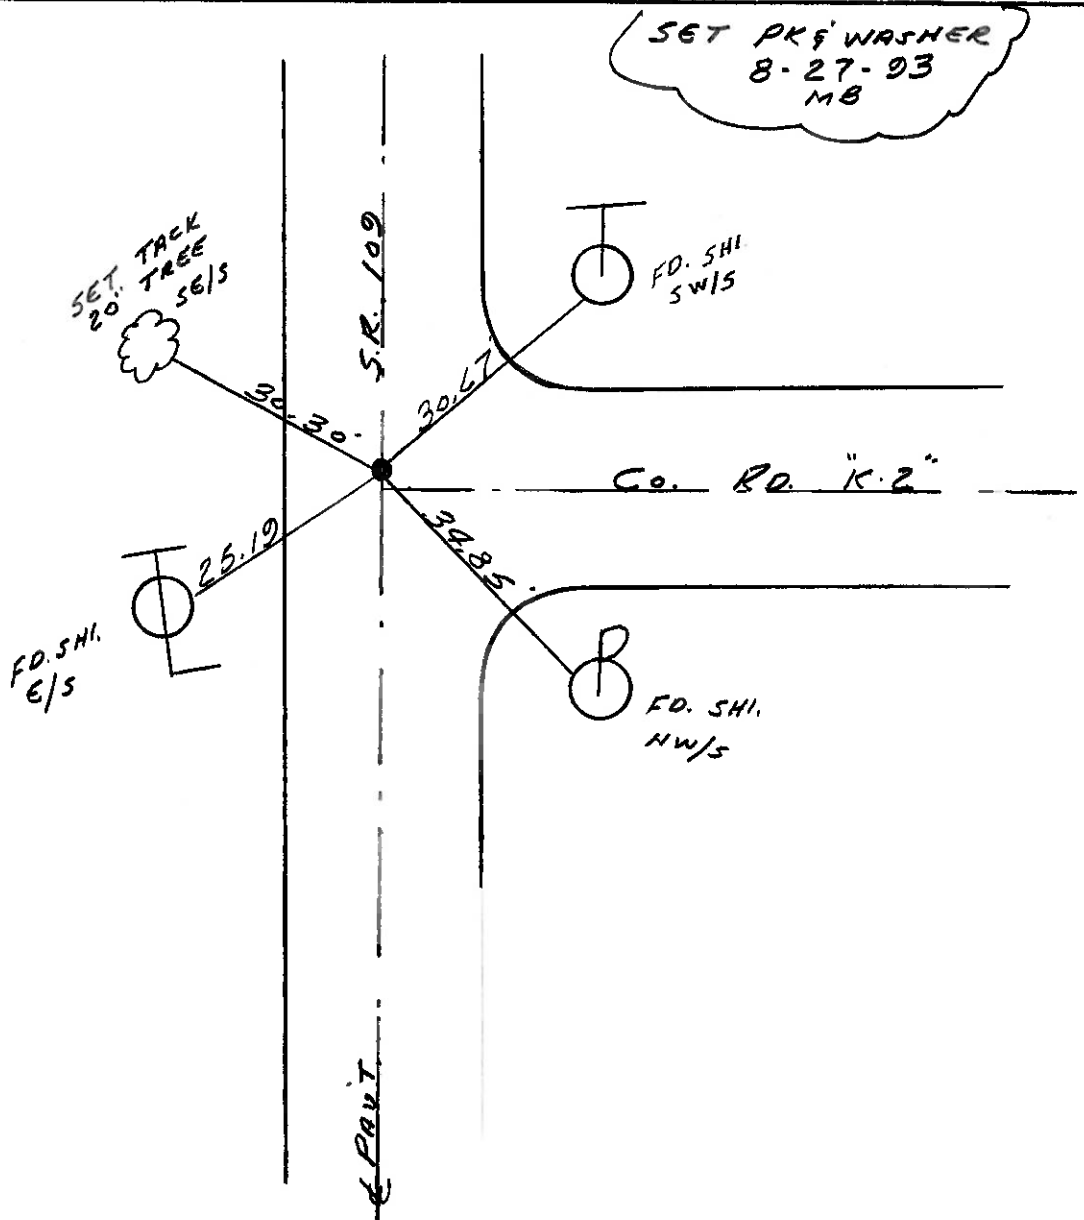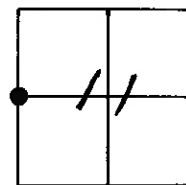

O.D.O.T. DISTRICT 2 SURVEY OFFICE

PERSONNEL

REFERENCE NO. 23

SHEET OF

NOTES Barnhisel

H.C. Hoffman

R.C. Loehrke

DATE 4-8-85

WEATHER cloudy

TEMP. +35°

ROUTE 109

COUNTY Henry

TOWNSHIP Monroe

SECTION 11

T. 4 N. R. 7 E.


TYPE MONUMENT Lg RR/SPK Punch Hole

ON SURFACE - BELOW ✓


~~LEFT~~ - PAV'T. - ~~RIGHT~~ ✓

9.8 TO LT EDGE PAVEMENT 2' N of E "K2"

S.L.M. 556+31

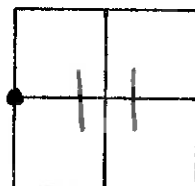

Set PK/Washer
5-24-85
MTB

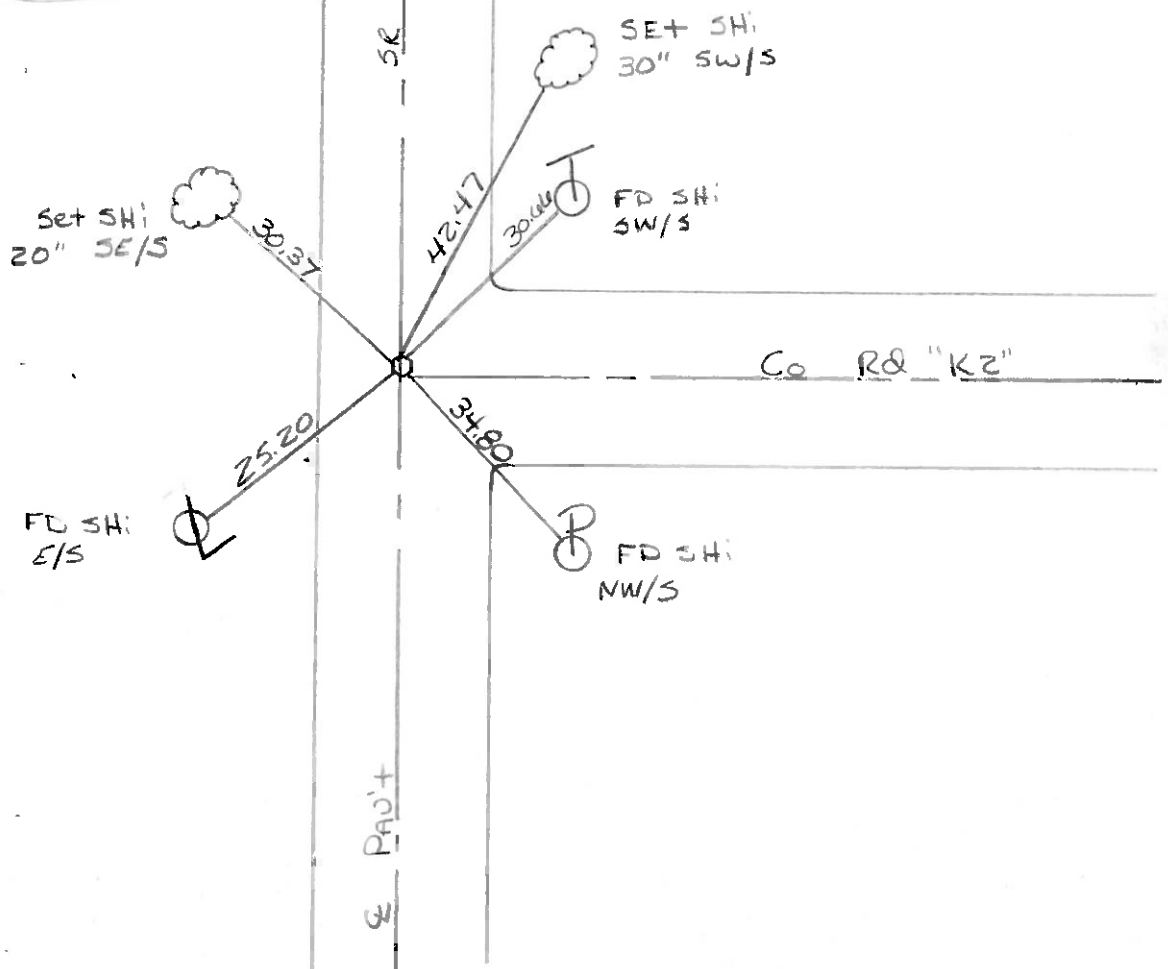


COUNTY HENRY S.R. 109

T 4 N , R 7 E

TOWNSHIP MONROE

SECTION 11

23

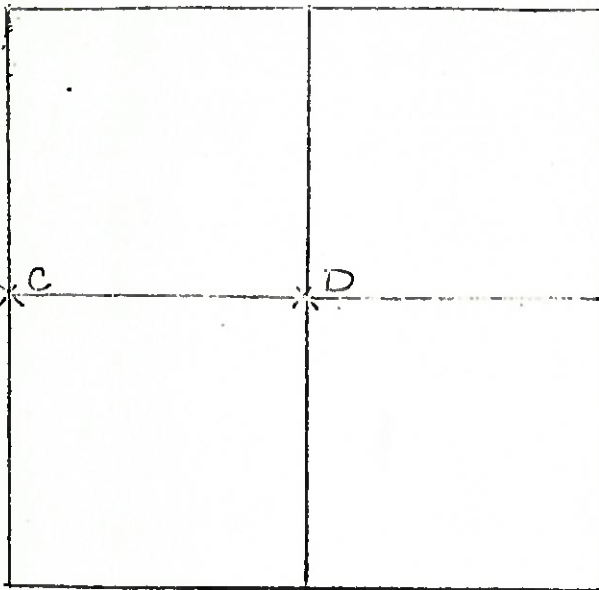

7-5-79 R.W. J.J. G.M.

C - FOUND R.R. SPIKE ON
SURFACE. INTENDED FOR FOUND
BUT COULD NOT LOCATE
D.M.D. CENTER PLUNKED R.R.
SPIKE ON SURFACE IN AREA
OF SPIKE FOUND. P.P. ST.
IS LOCATED 10.8' FROM OF
WEST END OF 18' P.M.D. ST.

P.K.'S SET 6' N & W

25.20' W.S.W. TO SHINER E/S. T

30.62 N.E. TO SHINER S.W/S T

34.76 S.E. TO SHINER N.W/S T

D - FOUND RECORDED IRON PIN (3/4" DIA.) AND BRICK BATS. STONE HAD
BEEN REMOVED IN 1961. PLACED P.K.'S 6' NW & N.E.

70.25' N.W. TO FACE OF 8" PINE (CHAIN LEVEL)

46.29' E.S.E. TO BARGE SPIKE IN CONC. BRIDGE (PLUNKED)

PERSONNEL TITLE PERSONNEL TITLE

TOMSK

NORSE

GRANATI

VANYA

COUNTY. HENRY

DATE NOV. 1, 1973

S. R. 109

WEATHER

SEC. MONROE TWP.

TEMP.

DESCRIPTION

LEFT

CENTER LINE

RIGHT

JOB NO.

Jct. S.R. 109
MAIN ST
MALINTA O.

23-A

Fd. Nail @ surface

shiner

23.16'

S.R.
(TURKEYFOOT)

109 Rd

46.08'

MAIN ST.

shiner

36.01'

shiner

Jct. S.R. 109
TWP. Rd K-2
MALINTA O.

23

Fd. R.R. spk. @ surface

shiner

25.15'

S.R.
(TURKEYFOOT)

109 Rd

39.68'

TWP. K-2

shiner

34.80'

shiner

S. CORP LINE
MALINTA O.

22

shiner

shiner

59.61'

S.R.
(TURKEYFOOT)

109 Rd

47.06'

Fd. Iron Rod 3" below surface
(8 1/2 S. & Co. Rd "K")S. CORP.
Co. Rd. "K"LINE MALINTA
TWP. Rd. "K"

33.00'

shiner

shiner

PERSONNEL TITLE PERSONNEL TITLE

COUNTY HenryDATE 2-6-58S. R. #109

WEATHER

SEC.

TEMP.

DESCRIPTION

Malinta

JOB NO.

LEFT

CENTER LINE

RIGHT

Control Points checked by Jameson 3-6-58

22 #72 Iron Pin

60.80

#1.07' N.W. To Shi. ^{T POLE} ~~P. Pole~~

✓ South Corp Line

OK 2/6/58

39.20

21.65' S.W. To ~~SHINER~~ ^{SHINER} ~~1.0' W. P Pole~~

Sta 530+11.2

41.35

21.55' S.E. To ~~SHINER~~ ^{SHINER} ~~T Pole~~

2?

51.60' NW TO CONC FOUNDATION 1' FROM GRND

43.0' NE TO SHINER IN MAPLE TREES

23 #73 IRON PIN. OK 2/6/58

Sta 556+44.15 Twp. Rd. K. 2

Angle 00°-17' H. E. Rd.

33.28' S.E. To ~~SHINER~~ ^{SHINER} N.W. Conc. S.W. Side,

38.30

T POLE ~~P. Pole~~

60.39' S.W. To N.E. Cor. Tile

Block Garage

24 #74 Iron Pipe

OK 2/6/58

North Corp Line Co. Rd. L

Sta 583+22.38

80.41' N.W. To S.E. Cor. Walk To

Porch

40.45' N.E. To X on Hd. W.

41.30' E.N.E. " " " "