

O.D.O.T. DISTRICT 2 SURVEY OFFICE (USE ONLY)

PERSONNEL

REFERENCE NO. 23A

SHEET 21 OF 25

NOTES NIESE

DATE 10/7/24

ROUTE SR 109

H.C. MILLER

WEATHER SUNNY

COUNTY HENRY

R.C. PRESTON-COLVIN

TEMP. 65°

TOWNSHIP MONROE

SECTION 11

DWG BY BARRIERE PID 99587

T 4 N R 7 E

TYPE MONUMENT MAG NAIL/WASHER

ON SURFACE - BELOW ON

OFFSET Q PAVEMENT LT : RT

 TO EDGE PAVEMENT

STATION: 571+15

HORIZ.DATUM: OHIO LDP (HENRY)


GEOID: 18

GRID: NORTHING: 640291.0714


EASTING: 1572289.2497

LDP: NORTHING: 463931.79

EASTING: 181157.453

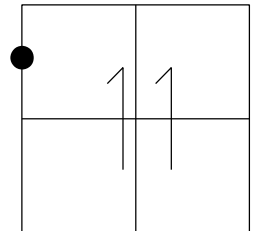

RECORD:
SET MAG/WASHER
10-28-04, MC
FD MAG/W
REF23
12/7/21, DSA
SET MAG/WASHER
10/7/24, TDN

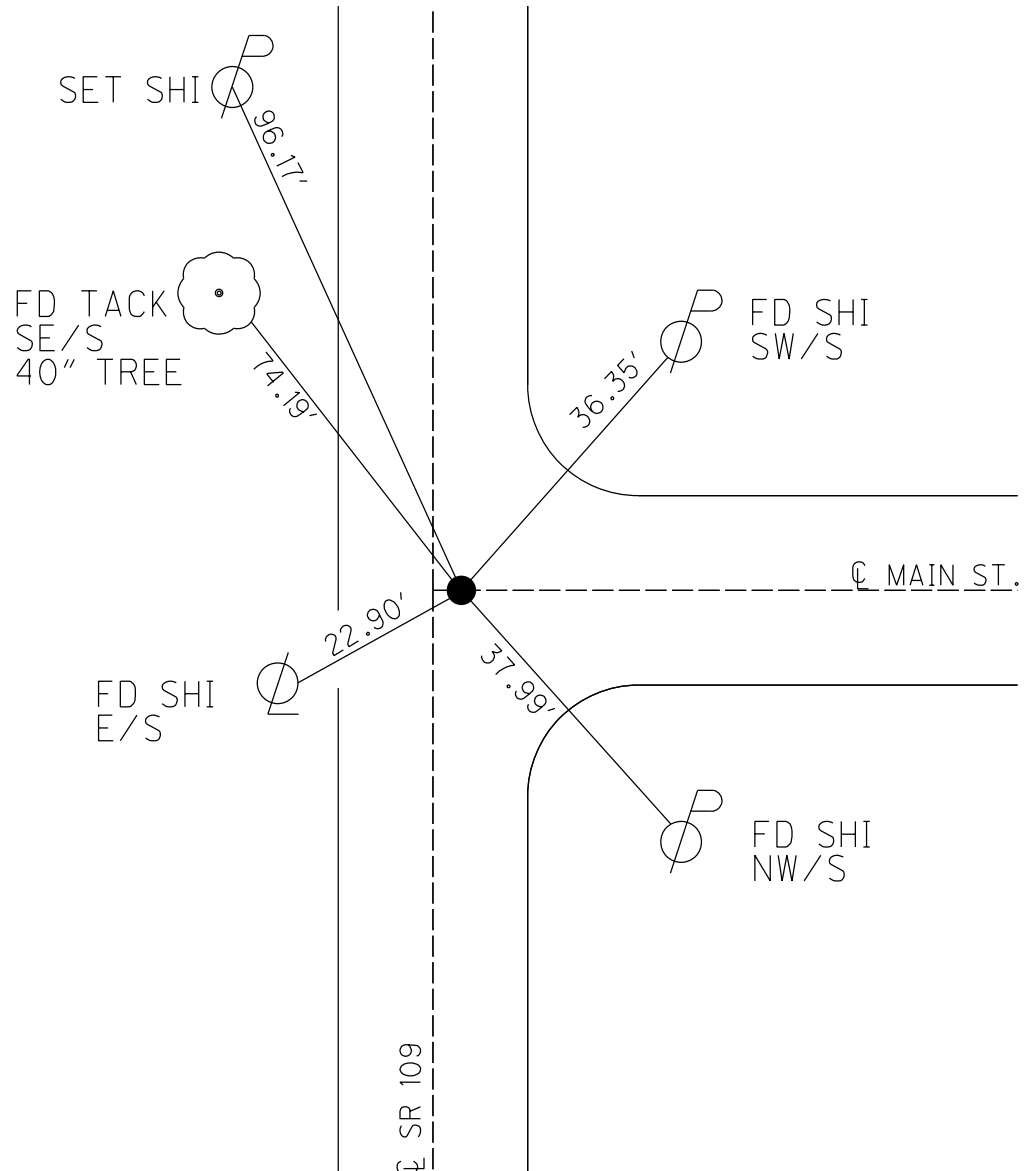

O.D.O.T. DISTRICT 2 SURVEY OFFICE (USE ONLY)

PERSONNEL _____ REFERENCE NO. 23 A SHEET 9 OF 38

NOTES CANTERBURY DATE 8-31-04 ROUTE SR 109
H.C. BARNHISEL WEATHER SUNNY COUNTY HENRY
R.C. HOOKE TEMP. 70°F TOWNSHIP MONROE
SECTION 11
T 4 N R 7 E

TYPE MONUMENT PK/WASHER


ON SURFACE - ~~BELOW~~ ON _____

~~LEFT~~ - Q PAV'T - RIGHT 0.5'


10.6' TO LT EDGE PAVEMENT

S.L.M. 571+15

Grid: Northing: 640291.0714 Easting: 1572289.2497

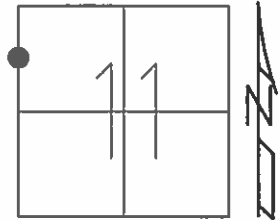

RECORD:
SET MAG/WASHER
10-28-04, MC

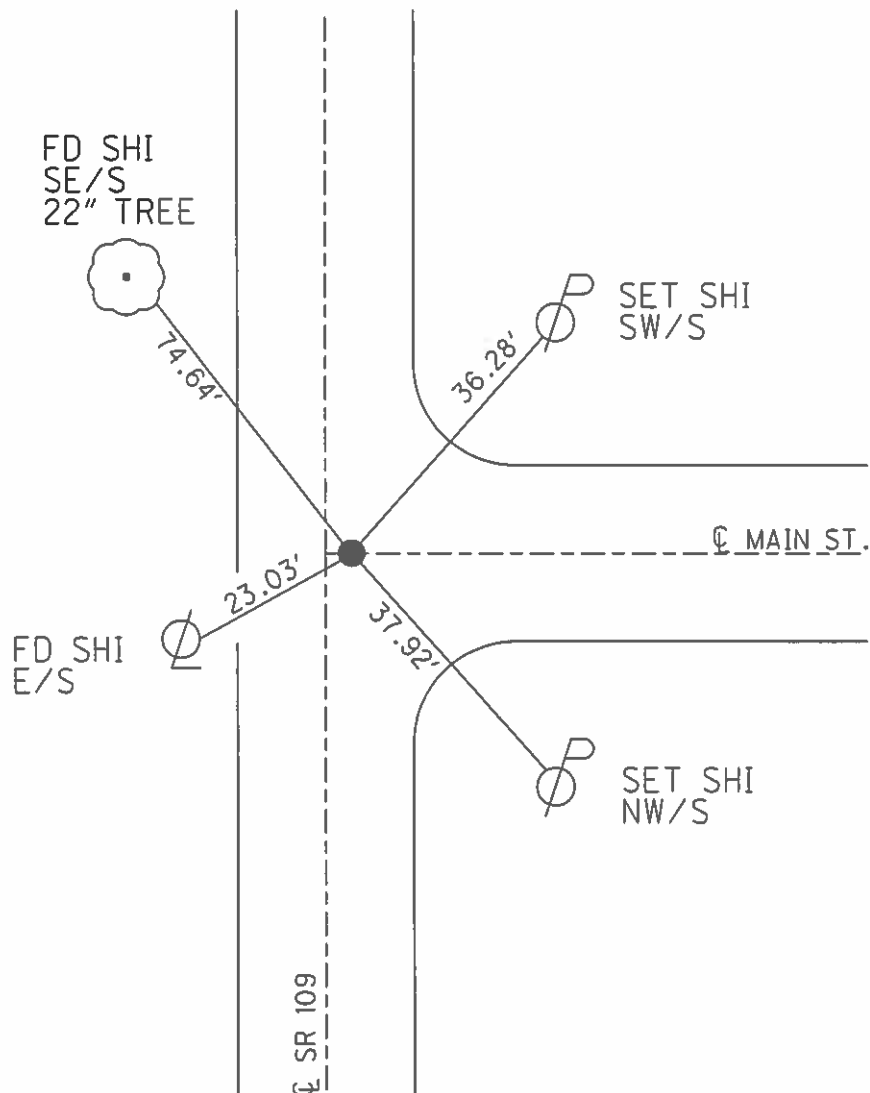

O.D.O.T. DISTRICT 2 SURVEY OFFICE

PERSONNEL

REFERENCE NO. 23-A

SHEET 8 OF 23

NOTES CANTERBURY

H.C. BARNHISEL

R.C. HOOGER

DATE 8-31-04

WEATHER SUN

TEMP. +70°

ROUTE 109

COUNTY HENRY

TOWNSHIP MONROE

SECTION 11

T4 N R 7 E


TYPE MONUMENT P.K. / WASHER

ON SURFACE - BELOW SURFACE


LEFT - & PAV'T. - RIGHT 0.5' RT &

10.6' TO LT EDGE PAVEMENT ON & EAST

S.L.M. 571 +15

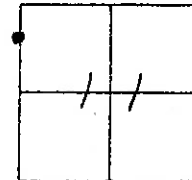

RESET MAG / WASHER
10/28/04
M.C.

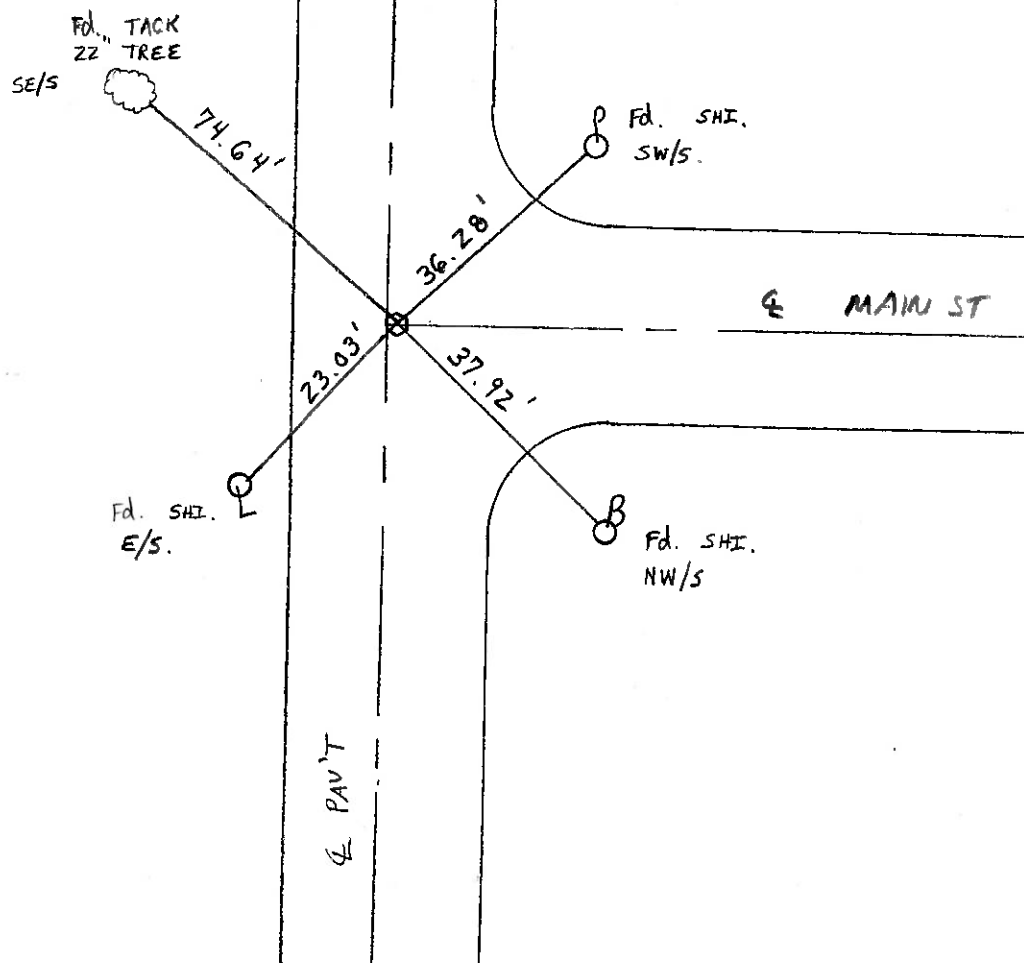

O.D.O.T. DISTRICT 2 SURVEY OFFICE

PERSONNEL

REFERENCE NO. 23-A

SHEET _____ OF _____

NOTES BARNHISEL

H.C. VANDUSEN

R.C. KUSZ

DATE 8-17-93

WEATHER Fog

TEMP. +81° F.

ROUTE 109

COUNTY HENRY

TOWNSHIP MONROE

SECTION 11

T4 N R 7 E



TYPE MONUMENT BOLT SPK.

ON ~~SURFACE~~ - BELOW 2" DOWN

LEFT- & PAV'T. - RIGHT YES

10.6 TO LT. EDGE PAVEMENT

S.L.M. 571+15

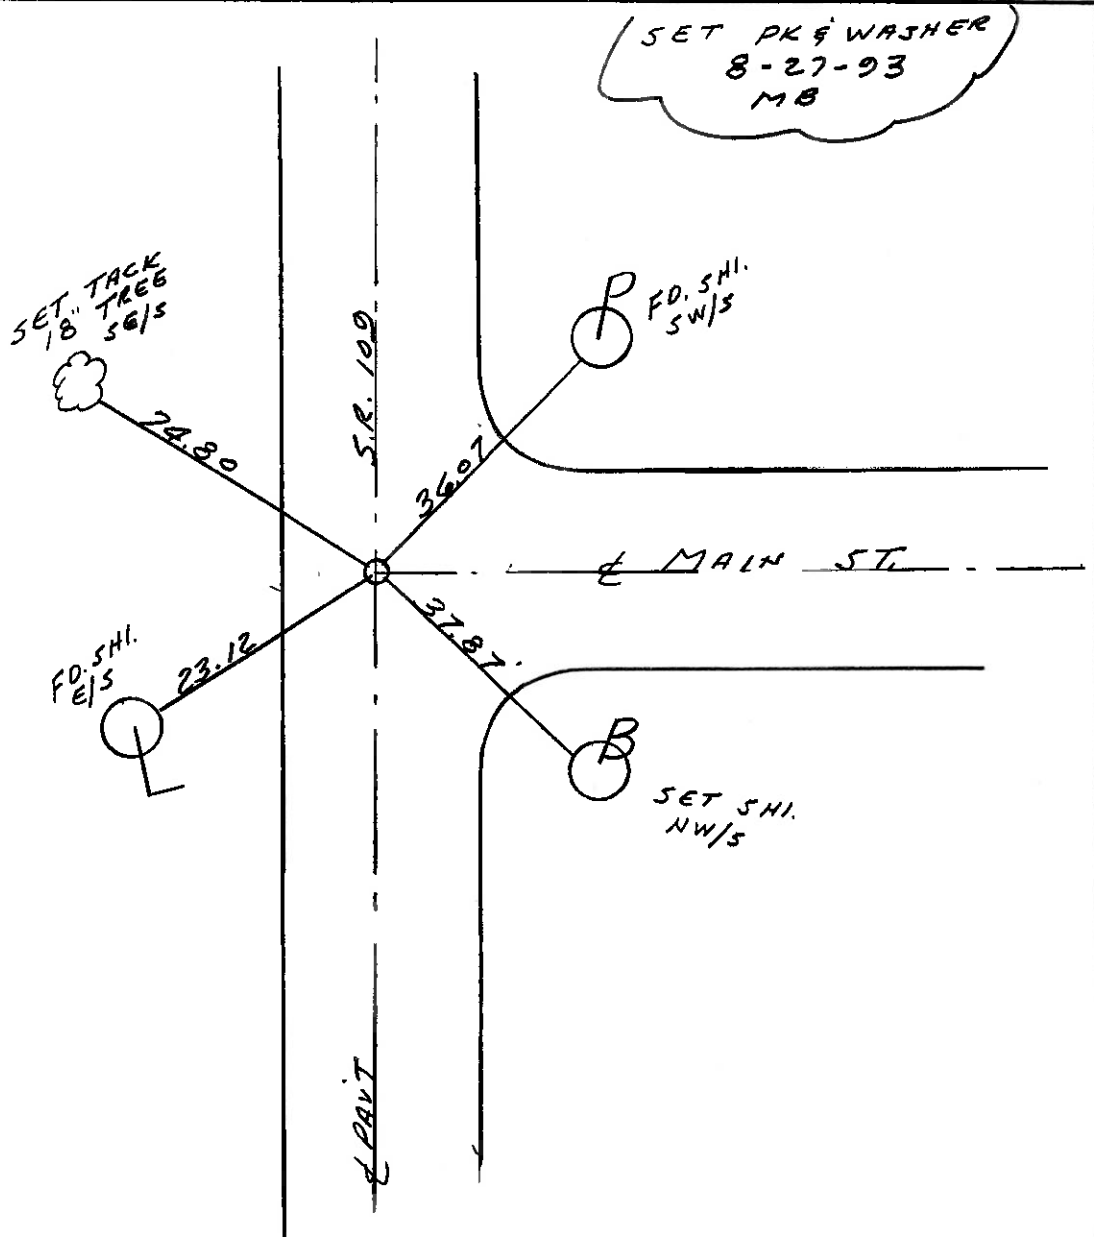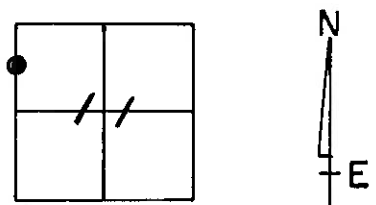

O.D.O.T. DISTRICT 2 SURVEY OFFICE

PERSONNEL

REFERENCE NO. 23-A

SHEET ____ OF ____

NOTES Barnhisel

H.C. Hoffman

R.C. Loehrke

DATE 4-8-85

WEATHER cloudy

TEMP. +350

ROUTE 109

COUNTY Henry

TOWNSHIP Monroe

SECTION 11

T. 4 N. R. 7 E.



TYPE MONUMENT Bolt spk

ON SURFACE - BELOW ✓

~~LEFT~~ - & PAV'T. - RIGHT ✓

10.4 TO .4+ EDGE PAVEMENT

S.L.M. 570+57

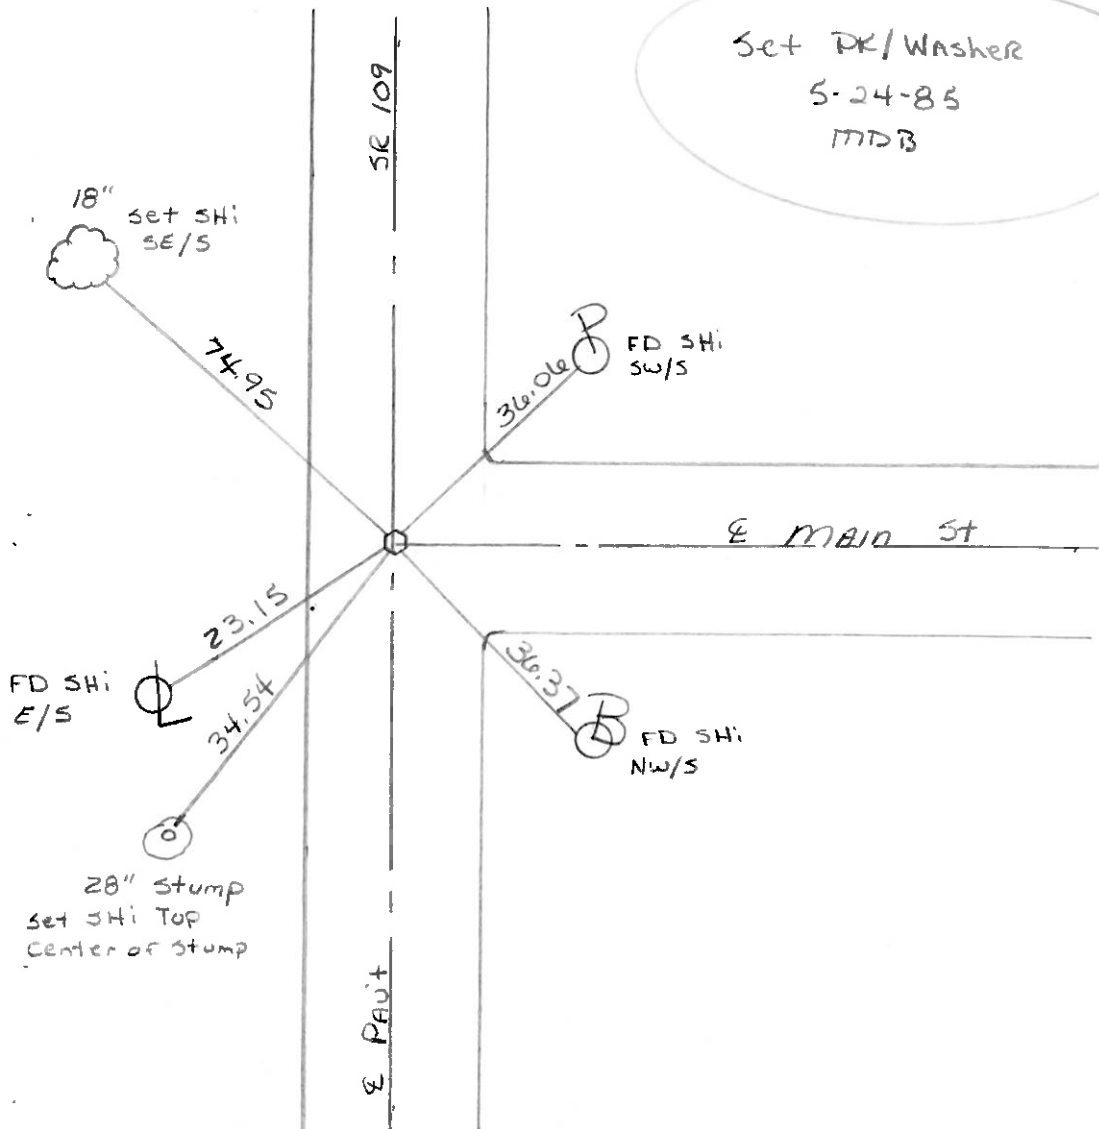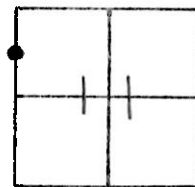

PERSONNEL TITLE PERSONNEL TITLE

TOMSK

NORSE

GRANATI

VANYA

COUNTY. HENRY

DATE NOV. 1, 1973

S. R. 109

WEATHER

SEC. MONROE TWP.

TEMP.

DESCRIPTION

LEFT

CENTER LINE

RIGHT

JOB NO.

Jct. S.R. 109
\$ MAIN ST
MALINTA O.

23-A

Fd. Nail @ surface

shiner

23.16'

S.R.
(TURKEYFOOT)

109 Rd

46.08'

MAIN ST.

shiner

36.01'

shiner

Jct. S.R. 109
\$ TWP. Rd K-2
MALINTA O.

23

Fd. R.R. spk. @ surface

shiner

25.15'

S.R.
(TURKEYFOOT)

109 Rd

39.68'

TWP. K-2

shiner

34.80'

shiner

S. CORP LINE
MALINTA O.

22

shiner

shiner

59.61'

S.R.
(TURKEYFOOT)

109 Rd

33.00'

Fd. Iron Rod 3" below surface
(8 1/2 S. & Co. Rd. "K")S. CORP.
Co. Rd. "K"LINE MALINTA
TWP. Rd. "K"

47.06'

shiner

S.R.
(TURKEYFOOT)

109 Rd

33.00'

shiner