

O.D.O.T. DISTRICT 2 SURVEY OFFICE (USE ONLY)

PERSONNEL

REFERENCE NO. 23B

SHEET 21 OF 25

NOTES NIESE

DATE 10/7/24

ROUTE SR 109

H.C. MILLER

WEATHER SUNNY

COUNTY HENRY

R.C. PRESTON-COLVIN

TEMP. 60°

TOWNSHIP MONROE

DWG BY BARRIERE

PID 99587

SECTION 11

T 4 N R 7 E

TYPE MONUMENT MAG NAIL/WASHER

ON SURFACE - BELOW ON

OFFSET Q PAVEMENT LT : RT

TO EDGE PAVEMENT

STATION: 578+49

HORIZ.DATUM: OHIO LDP (HENRY)



GEOID: 18

GRID: NORTHING: 640257.309

EASTING: 1572666.359

LDP: NORTHING: 464665.384

EASTING: 181144.817

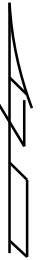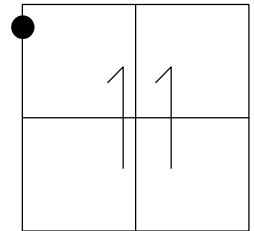

RECORD:
FD P.K.NAIL
8/31/04, MB
SET MAG/WASHER
10-28-04, MC
FD SM RR SPIKE
4" DOWN
REFB23
4/6/20, JFO
FD SM RR SPIKE
REFB23
12/7/21, DSA
SET MAG/WASHER
10/7/24, TDN

FD "+" RIM
SAN MH

29.55' P

FD
SHI

31.07'

Q SR 109

34.07'

72.76'

FD "+"
SW BOLT
BONNET
HYDRANT

Q FREASE ST

SET
SHI

O.D.O.T. DISTRICT 2 SURVEY OFFICE (USE ONLY)

PERSONNEL

REFERENCE NO. 23 B

SHEET 10 OF 39

NOTES BALBAUGH

DATE 4/6/20

ROUTE SR 109

H.C. O'DONNELL

WEATHER SUNNY

COUNTY HENRY

R.C. LEU

TEMP. 43°

TOWNSHIP MONROE

DWG BY GARRETT

PID PAVETRAIN

SECTION 11

T 4 N R 7 E

TYPE MONUMENT SM.R.R.SPIKE

~~ON SURFACE~~ - BELOW 4"

OFFSET CL PAVEMENT ON LT : RT

9.4' TO LT EDGE PAVEMENT


STATION: 578+49

HORZ.DATUM: NAD83 (2011)

GEOID: 2012A

GRID: NORTHING: 640257.309

EASTING: 1572666.359

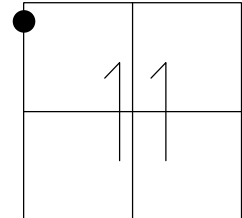

RECORD:
FD P.K.NAIL
8/31/04, MB
SET MAG/WASHER
10-28-04, MC
FD SM RR SPIKE
4" DOWN
REFB23
4/6/20, JFO

SET "+" RIM
SAN MH

29.58' P

FD
SHI

31.08'

CL SR 109

34.12'

FD "+"
SW BOLT
BONNET
HYDRANT

CL FREASE ST

72.79'

SET
SHI

O.D.O.T. DISTRICT 2 SURVEY OFFICE (USE ONLY)

PERSONNEL

REFERENCE NO. 23 B

SHEET 10 OF 38

NOTES CANTERBURY

DATE 8-31-04

ROUTE SR 109

H.C. BARNHISEL

WEATHER SUNNY

COUNTY HENRY

R.C. HOOKE

TEMP. 70°F

TOWNSHIP MONROE

SECTION 11

T 4 N R 7 E

TYPE MONUMENT PK NAIL


ON SURFACE - ~~BELOW~~ ON

LEFT - Q PAV'T - RIGHT ON


9.4' TO LT EDGE PAVEMENT

S.L.M. 578+49

Grid: Northing: 640257.3093 Easting: 1572666.3589

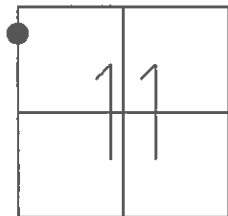

RECORD:
SET MAG/WASHER
10-28-04, MC

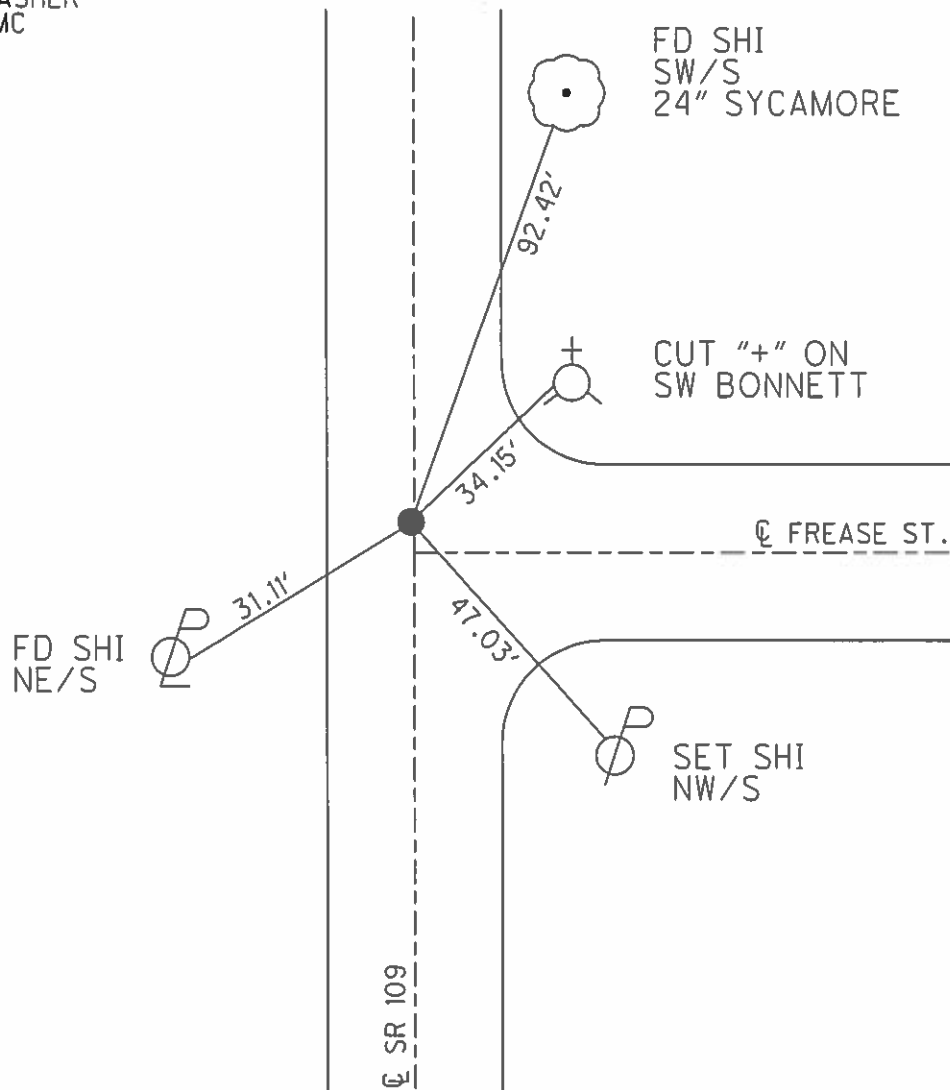

O.D.O.T. DISTRICT 2 SURVEY OFFICE

PERSONNEL

REFERENCE NO. 23-B

SHEET 9 OF 23

NOTES CANTERBURY

H.C. BARNHISEL

R.C. HOOKE

DATE 8-31-04

WEATHER SUN

TEMP. +70°

ROUTE 109

COUNTY HENRY

TOWNSHIP MONROE

SECTION 11

T 4 N R 7 E



TYPE MONUMENT P.K. NAIL

ON SURFACE - ~~BELOW~~ SURFACE

~~LEFT - & PAV'T. - RIGHT~~ ON & PAV'T.

9.4' TO LT. EDGE PAVEMENT 1.0' N. OF & FREASE ST.

S.L.M. 578 + 49

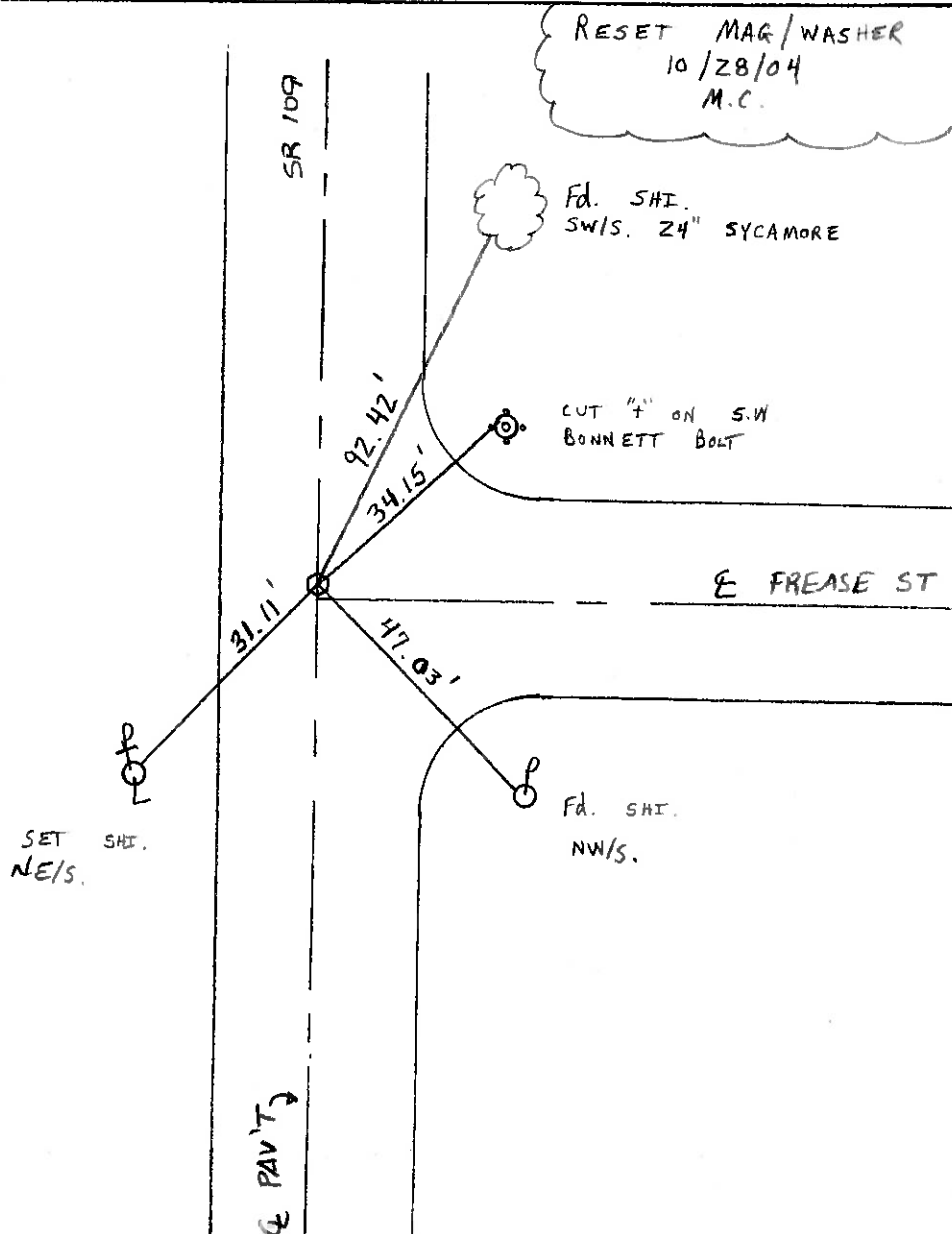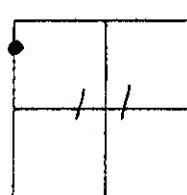

O.D.O.T. DISTRICT 2 SURVEY OFFICE

PERSONNEL

REFERENCE NO. 23-B SHEET ____ OF ____

NOTES BARNHISEL

H.C. VANDUSEN

DATE 8-17-93

ROUTE 109

R.C. KUZZ

WEATHER FOG

COUNTY HENRY

TEMP. +81° F

TOWNSHIP MONROE

SECTION 11

T4 NR 7 E


TYPE MONUMENT SM RR/SPK.

ON SURFACE - BELOW YES


LEFT- & PAV'T. - RIGHT YES

10.0 TO LT. EDGE PAVEMENT

S.L.M. 578+49 1.0' N. OF E. FREASE ST.

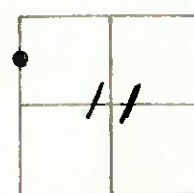

SET PK & WASHER
8-27-93
MB

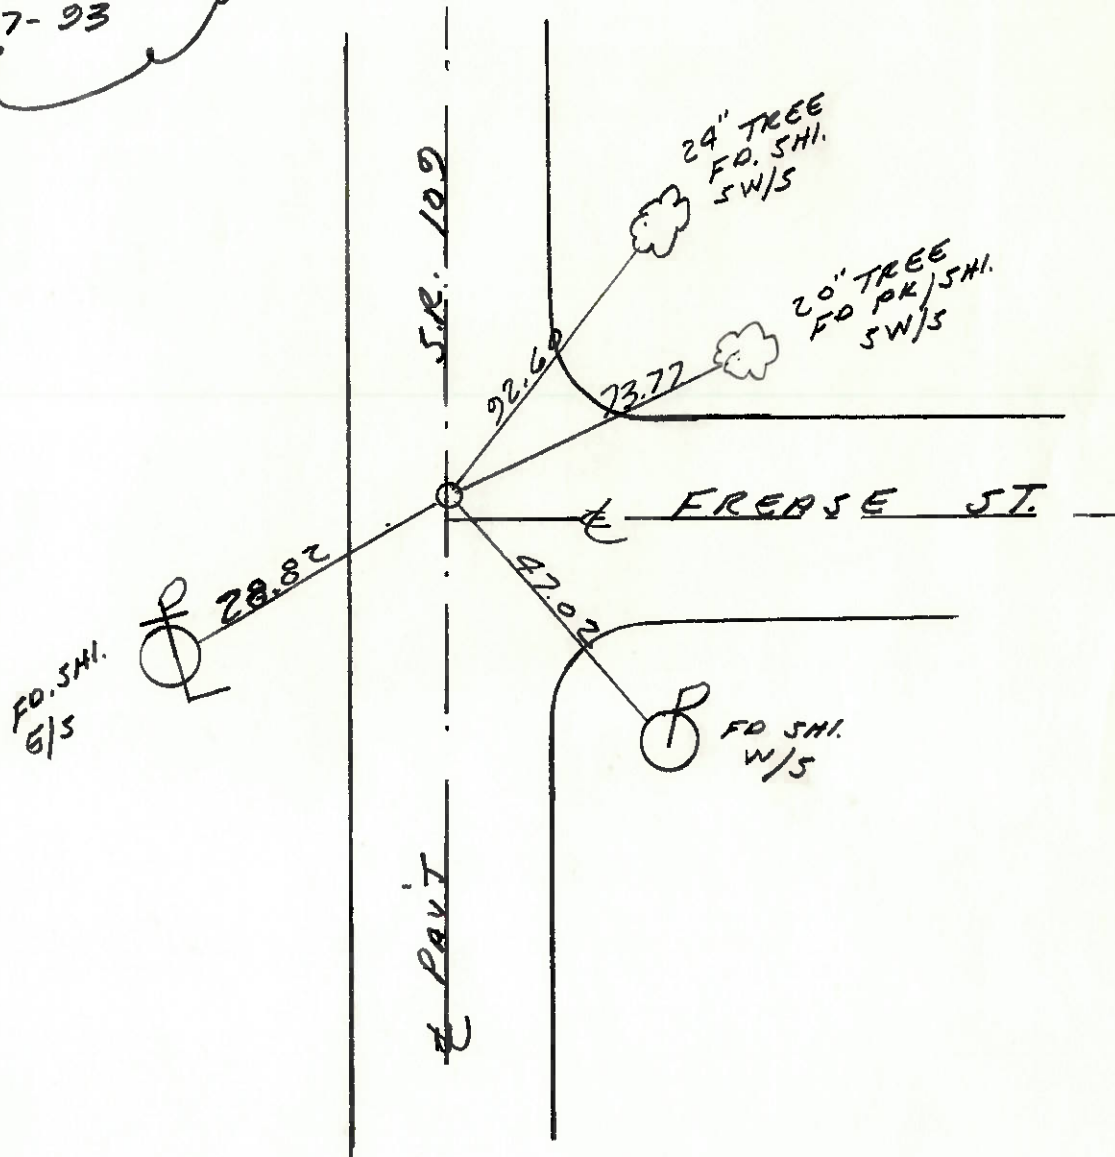

O.D.O.T. DISTRICT 2 SURVEY OFFICE

PERSONNEL

REFERENCE NO. 23-B

SHEET OF

NOTES BARNHISEL

H.C. Hoffman

R.C. Loehrke

DATE 4-8-85

WEATHER cloudy

TEMP. +35°

ROUTE 109

COUNTY Henry

TOWNSHIP Monroe

SECTION 11

T 4 N R 7 E

TYPE MONUMENT 5m RR / spk



ON SURFACE - BELOW ✓

LEFT - & PAU'T. - RIGHT ✓

9.0 TO LT EDGE PAVEMENT

S.L.M. 577+89

1' Nor E Frease St

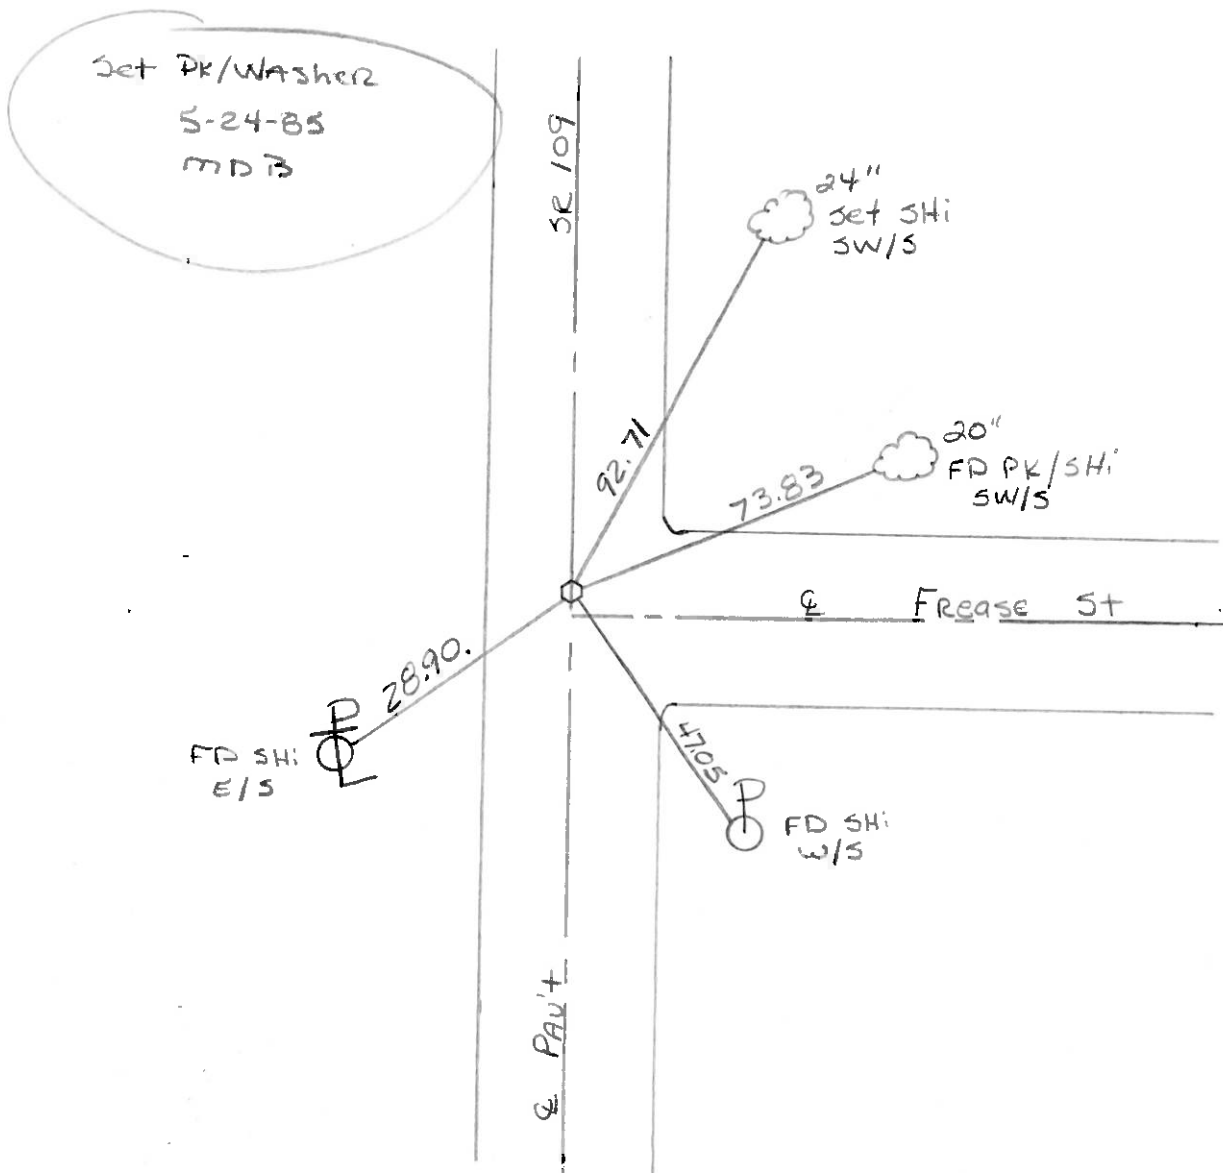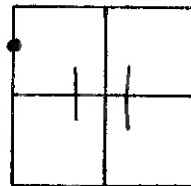

PERSONNEL	TITLE	PERSONNEL	TITLE	COUNTY	DATE
TOMASIE				HENRY	NOV 2, 1973
Neuser				S. R. 109	WEATHER
Wright				SEC. MONROE TWP.	TEMP.

DESCRIPTION	LEFT	CENTER LINE	RIGHT	JOB NO.
-------------	------	-------------	-------	---------

