

O.D.O.T. DISTRICT 2 SURVEY OFFICE (USE ONLY)

PERSONNEL

REFERENCE NO. 26

SHEET 21 OF 25

NOTES NIESE

DATE 10/7/24

ROUTE SR 109

H.C. MILLER

WEATHER SUNNY

COUNTY HENRY

R.C. PRESTON-COLVIN

TEMP. 58°

TOWNSHIP MONROE

SECTION 3

DWG BY BARRIERE PID 99587

T 4 N R 7 E

TYPE MONUMENT SM R.R. SPIKE

ON SURFACE - BELOW ON

OFFSET $\angle$ PAVEMENT LT : RT

TO EDGE PAVEMENT

STATION: 638+17

HORIZ.DATUM: OHIO LDP (HENRY)


GEOID: 18

GRID: NORTHING: 613990.0988


EASTING: 1546109.2607


LDP: NORTHING: 470630.253

EASTING: 180973.356

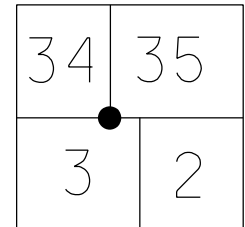

RECORD:
FD SM.R.R.SPIKE
10-28-04, MC
REF26
9-2-15, JFO
8-3-16, JMR
REF26
6/27/22, DSA
1/11/23, JMR
FD SM RR SPIKE
10/7/24, TDN

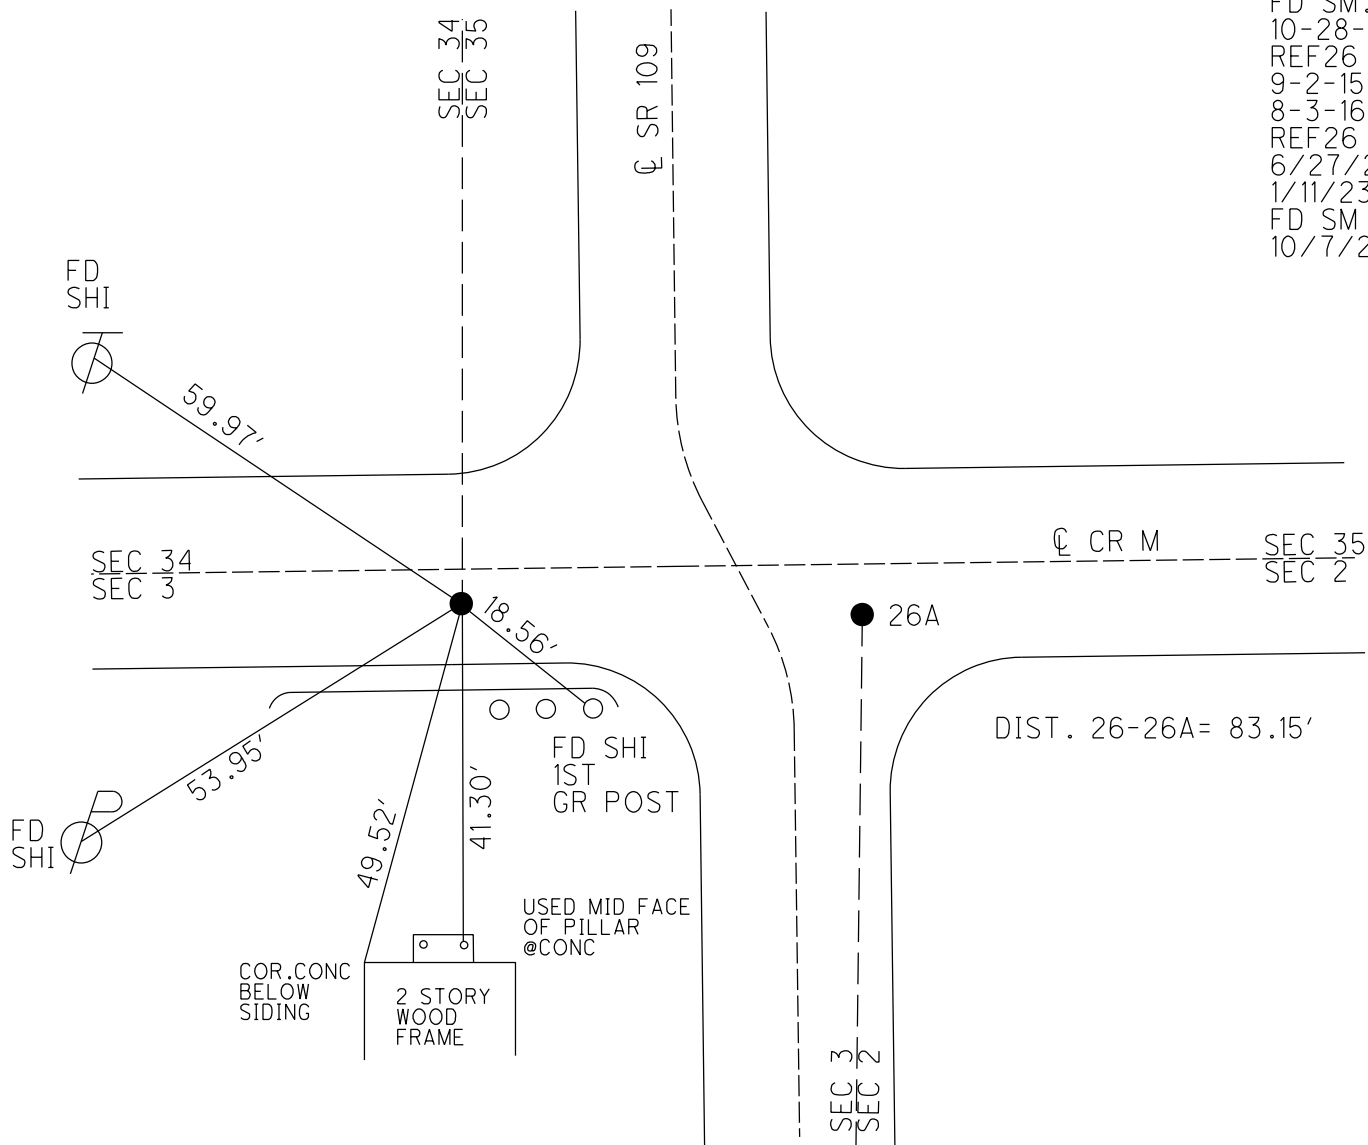


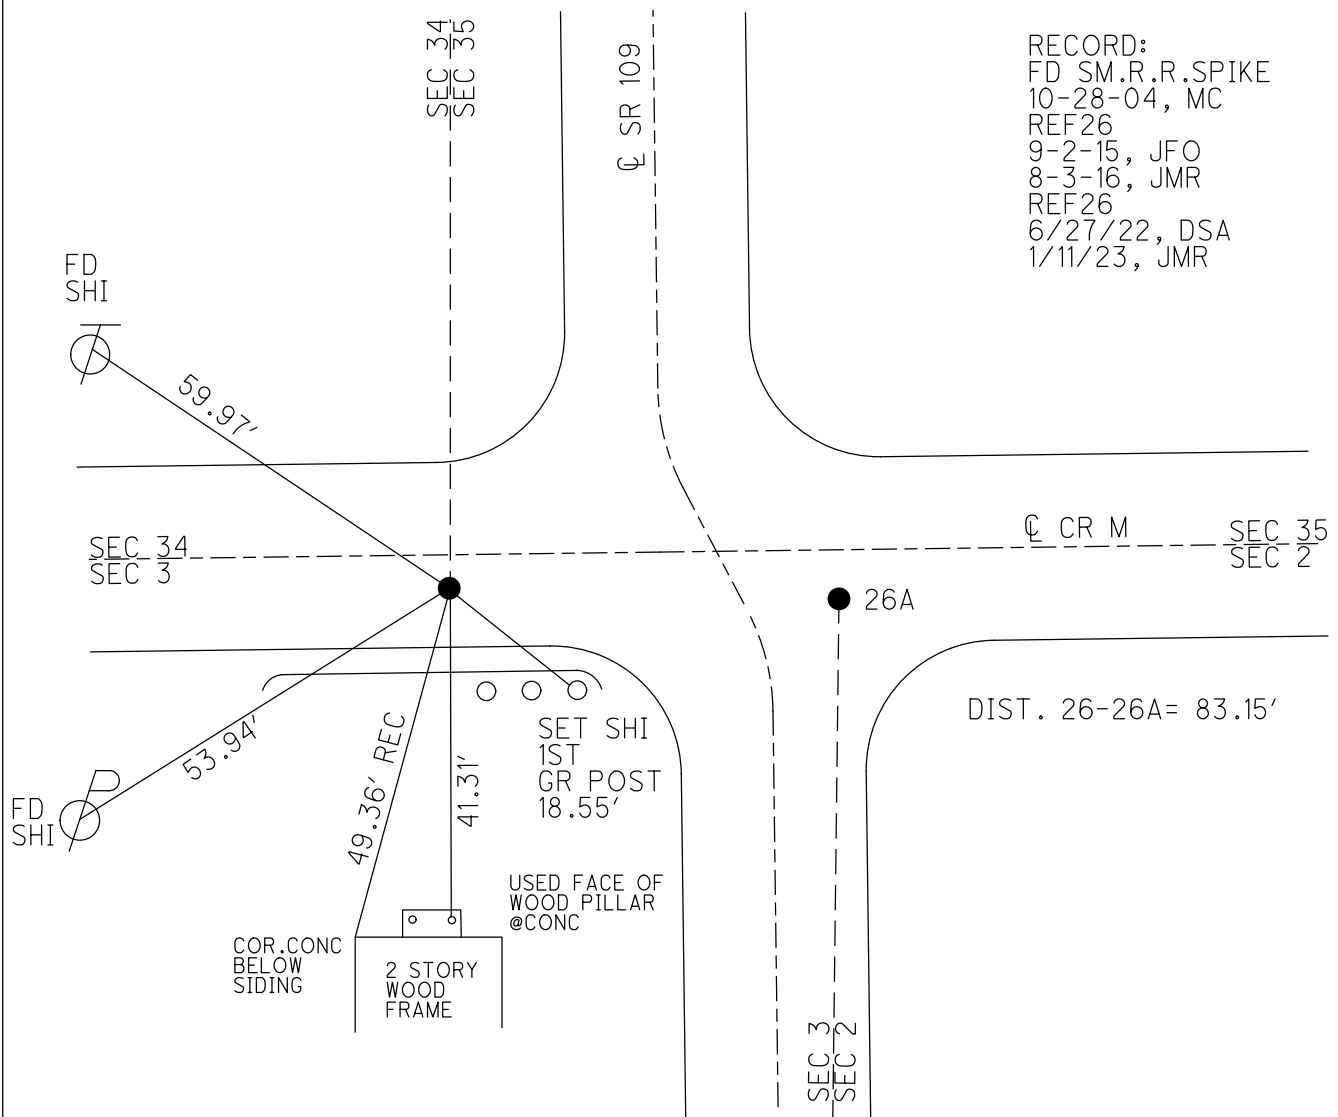

O.D.O.T. DISTRICT 2 SURVEY OFFICE (USE ONLY)

PERSONNEL _____ **REFERENCE NO.** 26 **SHEET** 13 **OF** 38
NOTES RHOADES **DATE** 9-3-15 **ROUTE** SR 109
H.C. O'DONNELL **WEATHER** CLEAR **COUNTY** HENRY
R.C. RHOADES **TEMP.** 88°F **TOWNSHIP** MONROE
SECTION 3
T 4 **N** **R** 7 **E**

TYPE MONUMENT SM. RR. SPIKE
~~ON SURFACE~~ - BELOW 2"
LEFT - ℄ PAV'T - ~~RIGHT~~ 83.1'
5.0' **TO** S **EDGE PAVEMENT**
S.L.M. 638+17

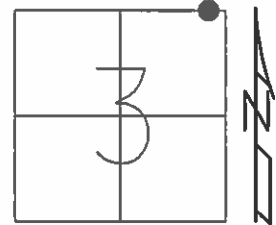


Grid: Northing: 613990.0988 **Easting:** 1546109.2607

RECORD:
 NOT COVERED
 10-28-04, MC

DIST. 26-26A= 83.15'

FD SM. RR. SPIKE
 GPS, REF 26
 9-2-15, JFO

NOT COVERED
 8-3-16, JMR

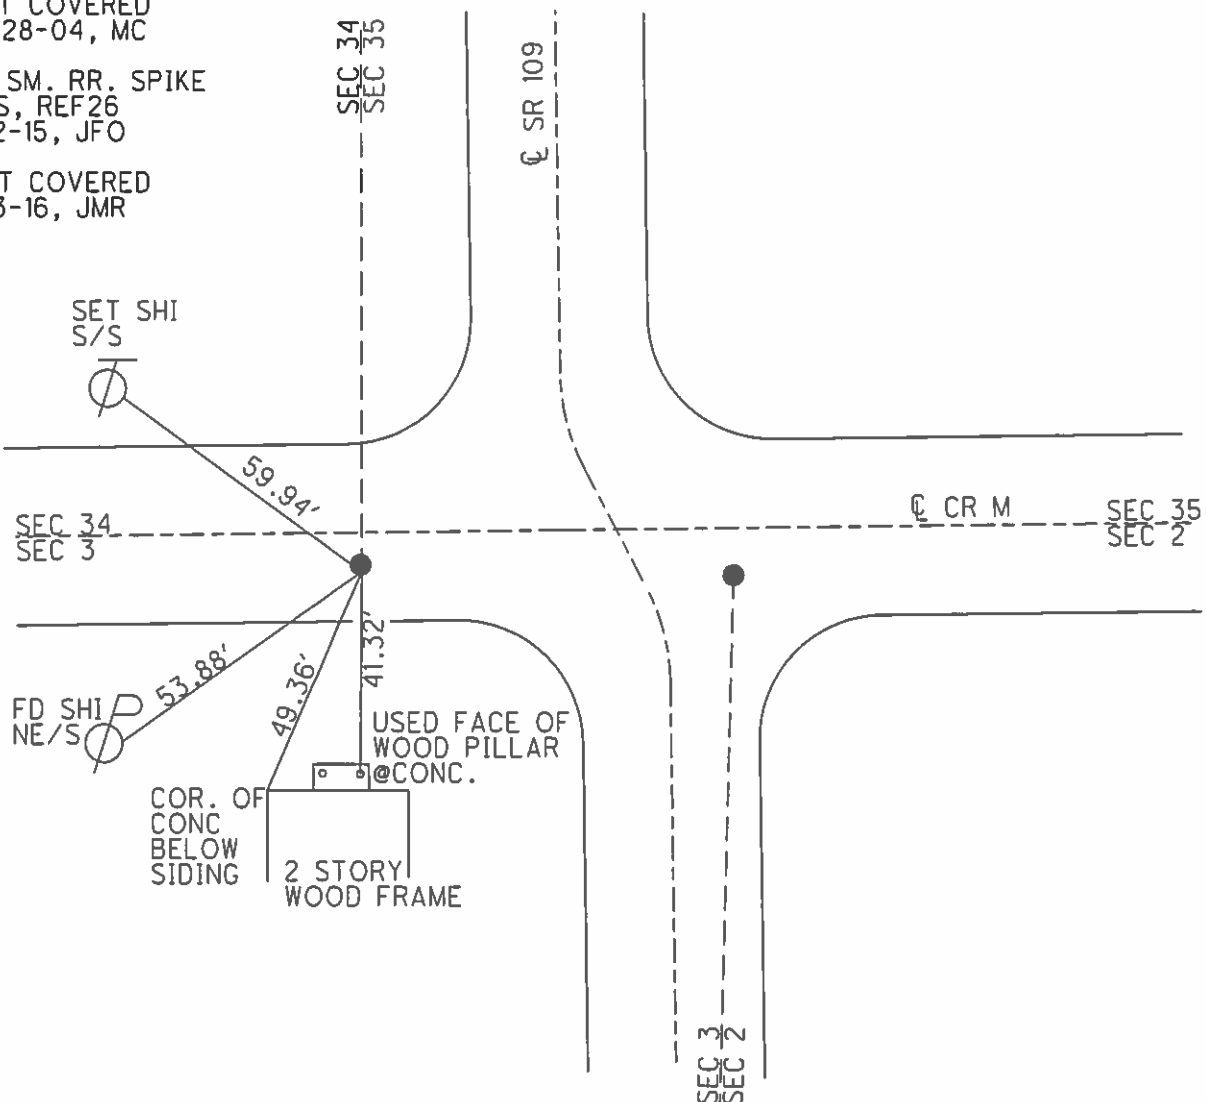

O.D.O.T. DISTRICT 2 SURVEY OFFICE

PERSONNEL

REFERENCE NO. 26

SHEET 12 OF 23

NOTES CANTERBURY

H.C. BARNHISEL

R.C. HOOKE

DATE 8/31/04

WEATHER SUN

TEMP. +70°

ROUTE SR 109

COUNTY HENRY

TOWNSHIP MONROE

SECTION 2, 3, 34, 35

T 4 N R 7 E

PT "A"

PT "B"

TYPE MONUMENT LG R.R. SPK.

P.K./WASHER

ON SURFACE - BELOW 2" DOWN

SURFACE

LEFT - & PAW'T. - RIGHT 83.1' LT &



19' RT &

PT "A" 5.0' TO S. EDGE PAVEMENT 3.3' S. OF CO. RD.

0.5' S. OF CO. RD. "M"

S.L.M. 638+17

638+17

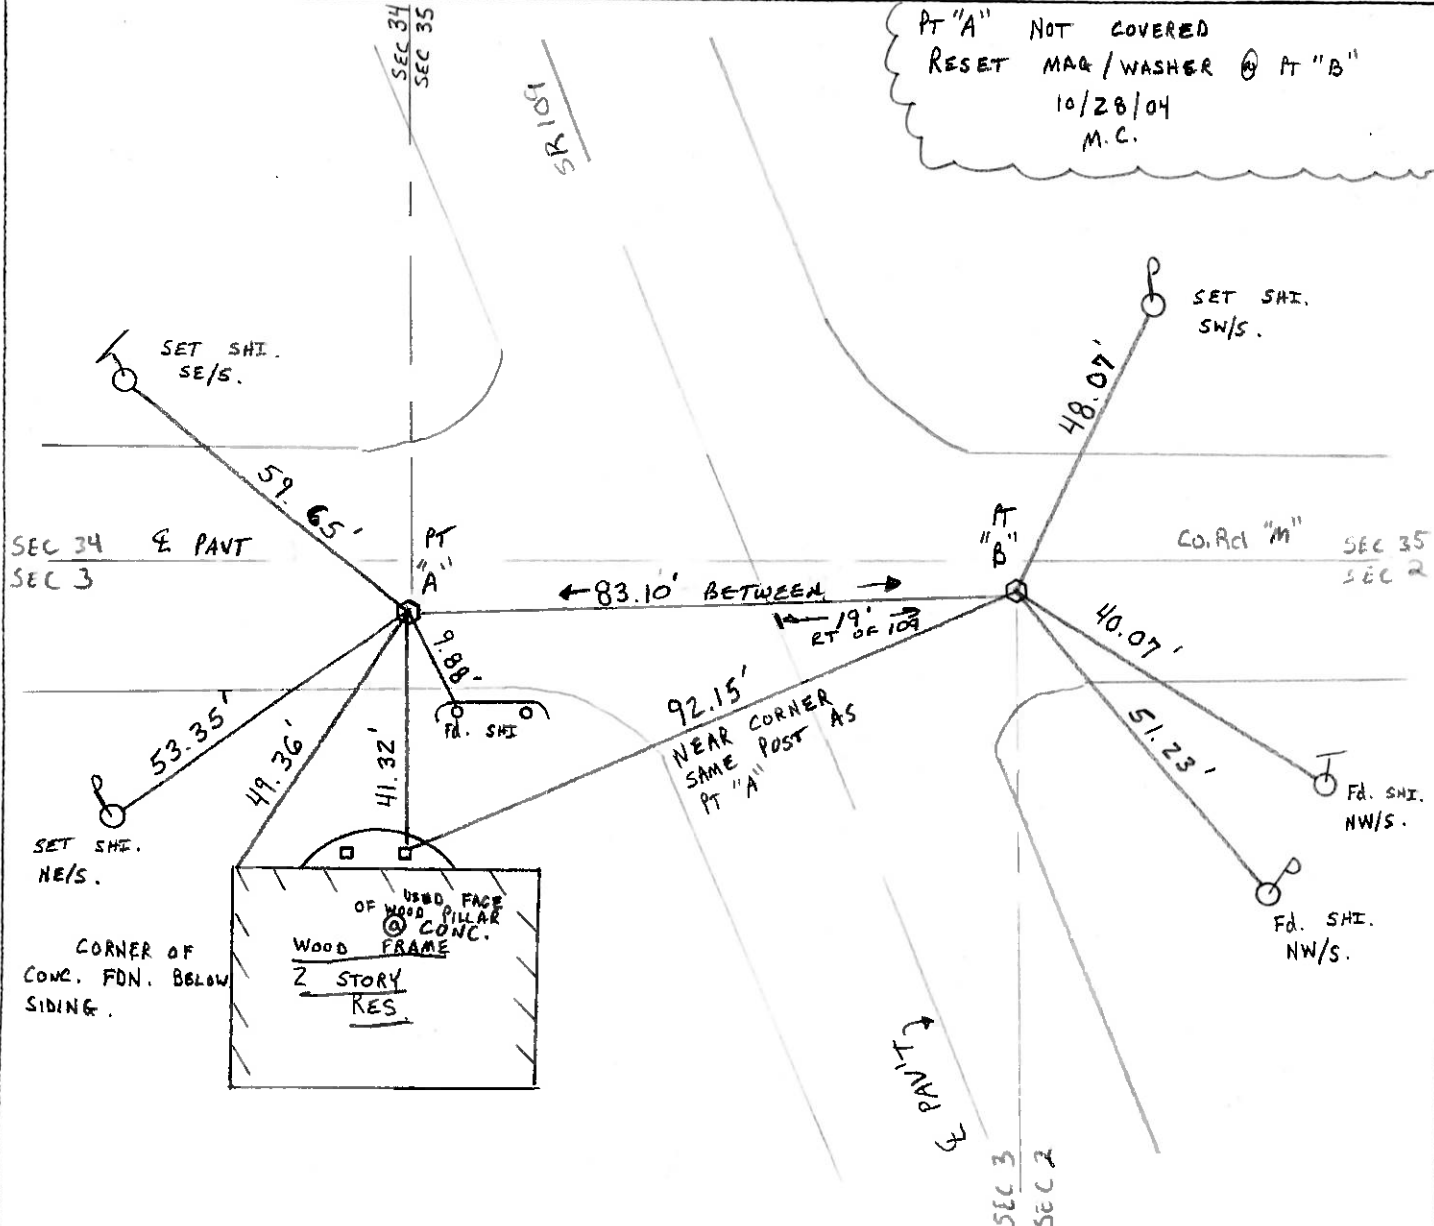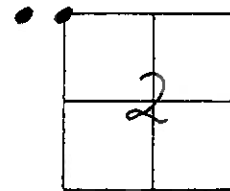

O.D.O.T. DISTRICT 2 SURVEY OFFICE

PERSONNEL

REFERENCE NO. 26

SHEET OF

NOTES BARNHISEL

H.C. VAN DUSEN

R.C. BARNHISEL

DATE 8-13-23

WEATHER SUNNY

TEMP. +80° F

ROUTE SR 109

COUNTY HENRY

TOWNSHIP MONROE

SECTION 2, 3, 34, 35

T 4 N R 7 E


TYPE MONUMENT LG. RR/SPK.

ON SURFACE - BELOW YES


LEFT - & PAV'T. - RIGHT PT. A 3.3 PT. B 1.5 CO. RD. M"

PT. A 5.0 TO RT. EDGE PAVEMENT

S.L.M. 638 + 0 6

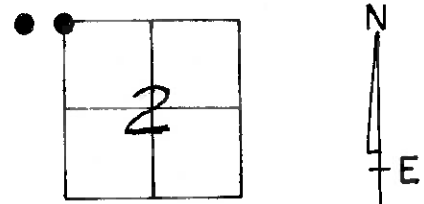

PT "A" WAS NOT COVERED
SET PK & WASHER @ PT. "B"
8-27-23
MB

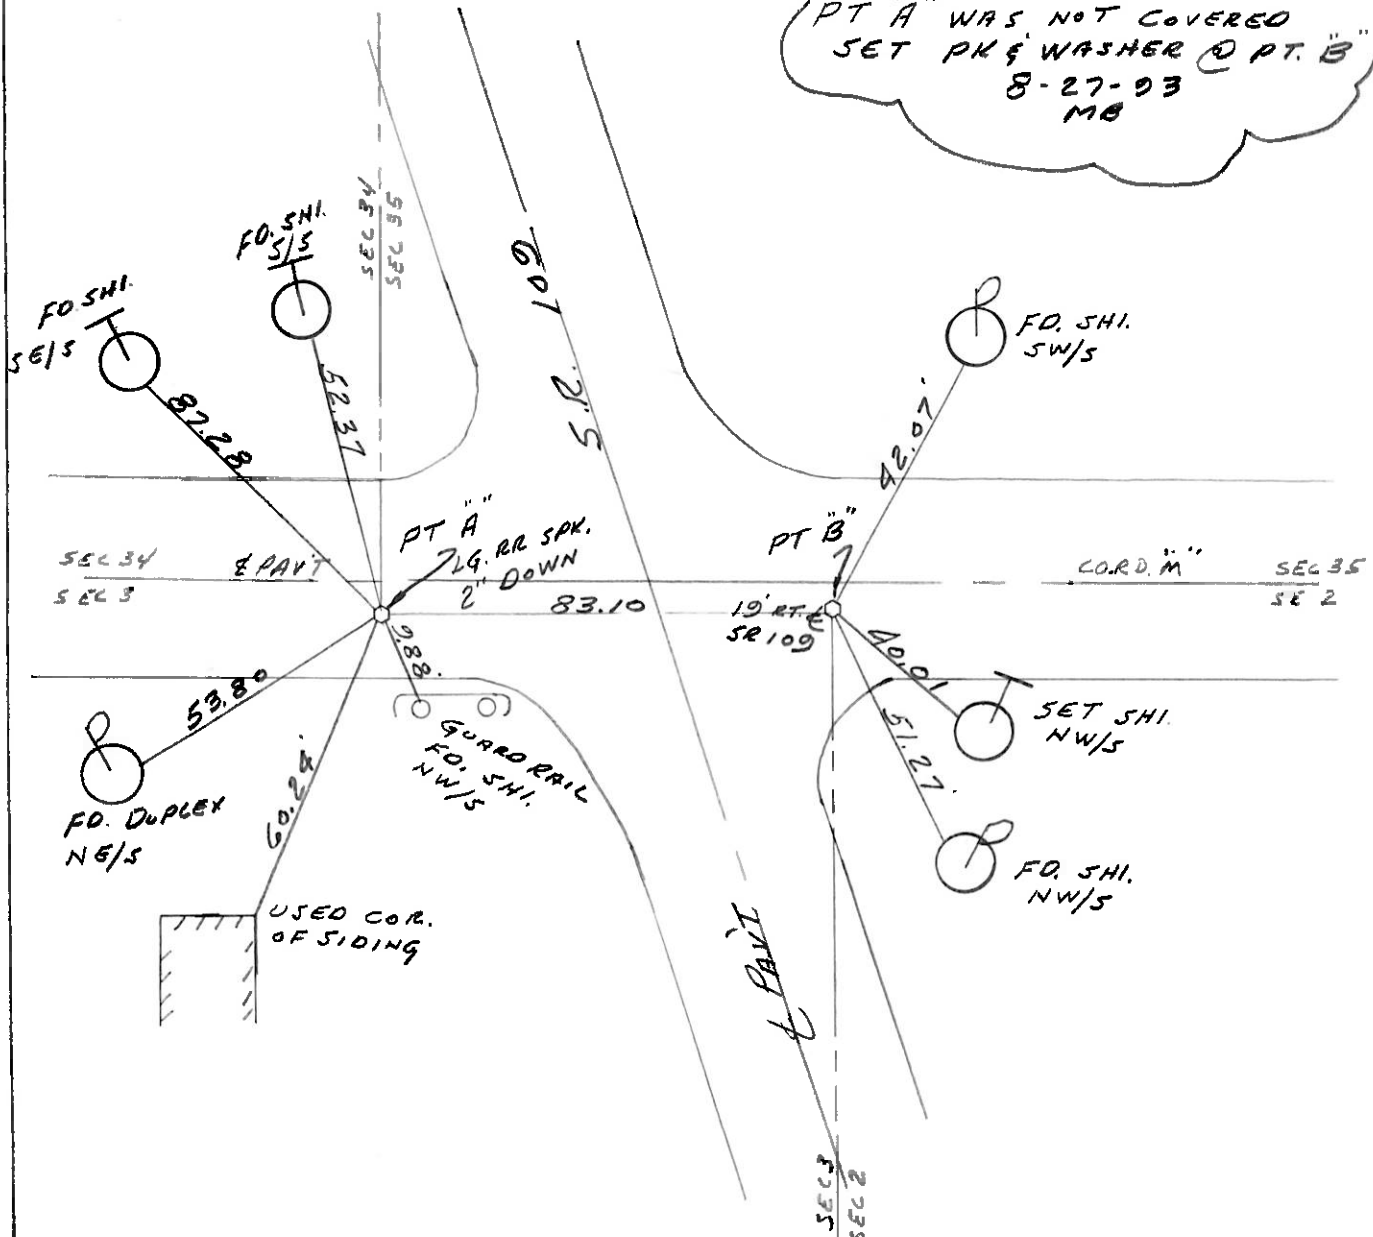

O.D.O.T. DISTRICT 2 SURVEY OFFICE

PERSONNEL

REFERENCE NO. 26

SHEET ____ OF ____

NOTES Baenbise

H.C. Hoffman

R.C. Loehrke

DATE 4-8-85

WEATHER Cloudy - Flurries

TEMP. + 35°

ROUTE 109

COUNTY Henry

TOWNSHIP MonroeSECTION 2

T 4 N R 7 E

TYPE MONUMENT Lg RR/spk



ON SURFACE - ~~BELOW~~ ✓

~~LEFT~~ - C PAN'T. - RIGHT Pt "A" 3.5 Pt "B" 1.5

5.3 TO R+ EDGE PAVEMENT

S.L.M. 637 + 54


Co Rd "M"

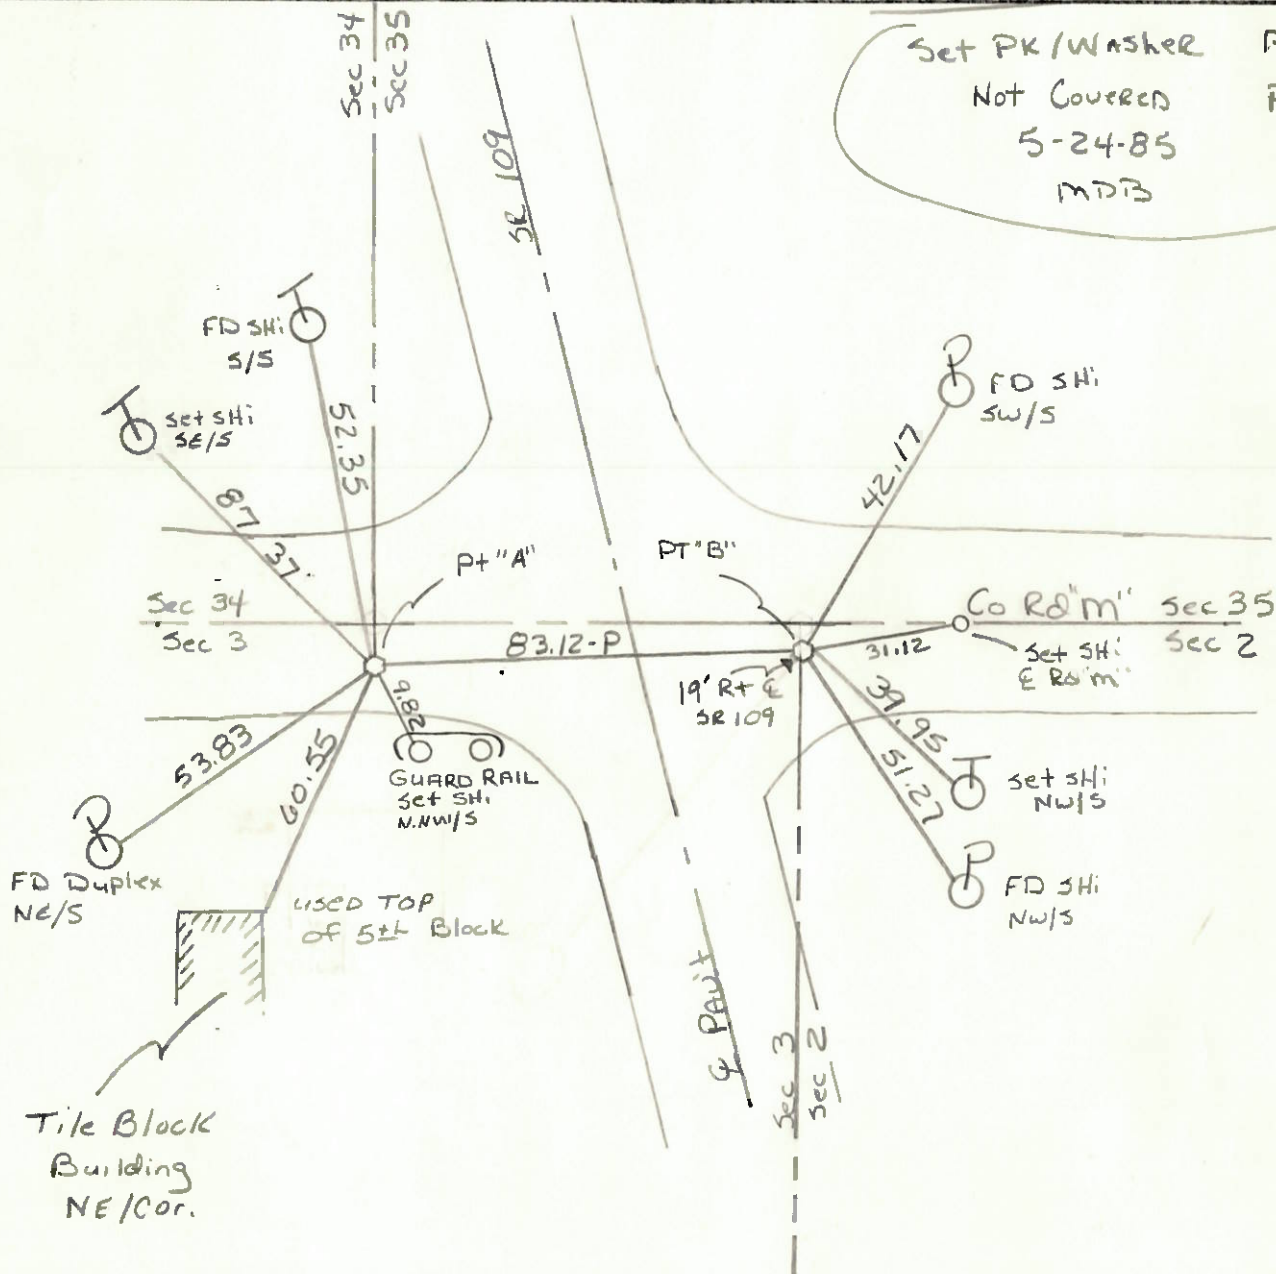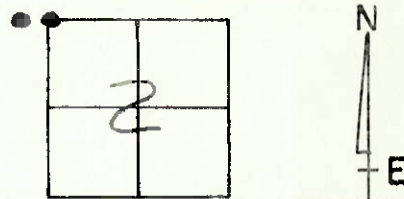

COUNTY HENRY S.R. 109
TOWNSHIP MONROE
SECTION 2

SHEET No. 1 OF 2
T 1 N 7 E

26

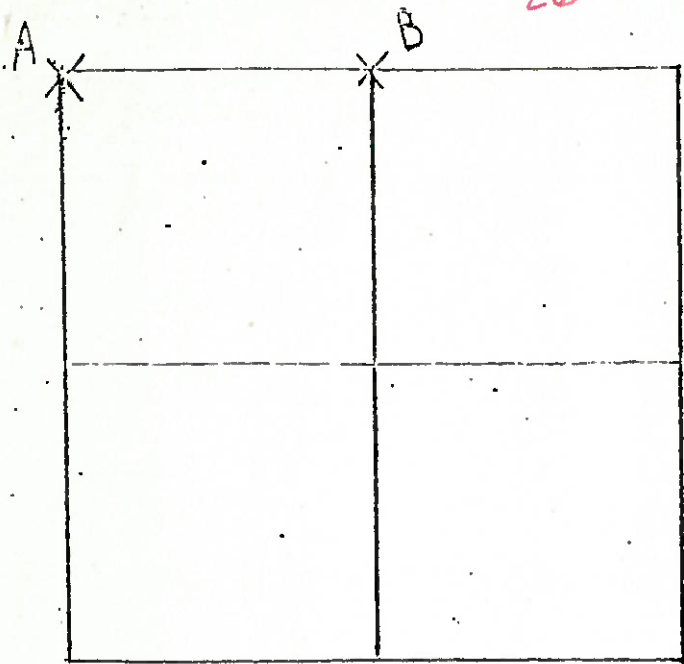

7-3-79 R.W. G.M. J.J.

A - FOUND P.K. NAIL ON
SURFACE 1.04' SOUTH OF NW
P.O.T. OVER SANDSTONE OVER
CORNERSTONE (8" X 12" X 15") 23"
BELOW ROAD SURFACE. REMOVED
P.K. FROM BOLT AND CORNERSTONE
PLACED CENTER PUNCHED P.K.
SPIKE ON SURFACE OVER HIGH

POINT OF STONE. SET P.K.'S 6' N. & W.

42.17' N.E. TO SHINER S.W./S

51.26' S.E. TO SHINER N.W./S

54.17' W.S.W. TO "+" TOP 24" DIA CONCRETE PIPE

83.09' W. TO S.W. CORNER SECTION 35 HARRISON TWP.

6-29-79

R.W. G.M.

B - CORNER LOST; RE-ESTABLISHED BY SETTING CENTER
PUNCHED P.R. SPIKE ON SOUTH LINE OF SEC 35 HARRISON
TWP. AT PROPORTED DISTANCE BETWEEN SW POST & S.E.
CORNER SECTION 35 HARRISON TWP. P.K.'S SET 6' S. & W.
67.89' W.N.W. TO "+" CONCRETE BASE FOR FENCE POST
82.13' E.S.E. TO DUPLEX N/S
59.02' W.S.W. TO "+" S.W. WINGWALL

PERSONNEL	TITLE	PERSONNEL	TITLE
-----------	-------	-----------	-------

BURNSIDE

SMITH

Tom sic

MEAD

COUNTY HENRICH

DATE 9-16-76

S. R. 109

WEATHER CLOUDY-SHOWER

SEC.

TEMP. +68°

DESCRIPTION REF. CONTROL POINTS (MALINTA NORTH)

JOB NO.

LEFT

CENTER LINE

RIGHT

