

PERSONNEL

SHEET 21 OF 25

ROUTE	SR 109
COUNTY	HENRY
TOWNSHIP	MONROE
SECTION	2

T_4_N R_7_E

ON SURFACE - BELOW _____ ON


_____TO_____EDGE PAVEMENT

34	35
3	2

GEOID: 18

EASTING: 1546192.3745EASTING: 181056.493

RECORD:
SET MAG/WASHER
10-28-04, MC
FD MAG/WASHER
REFA26
9-2-15, JFO
8-3-16, JMR
REFA26
6/27/22, DSA
1/11/23, JMR
SET MAG/WASHER
10/7/24, TDN

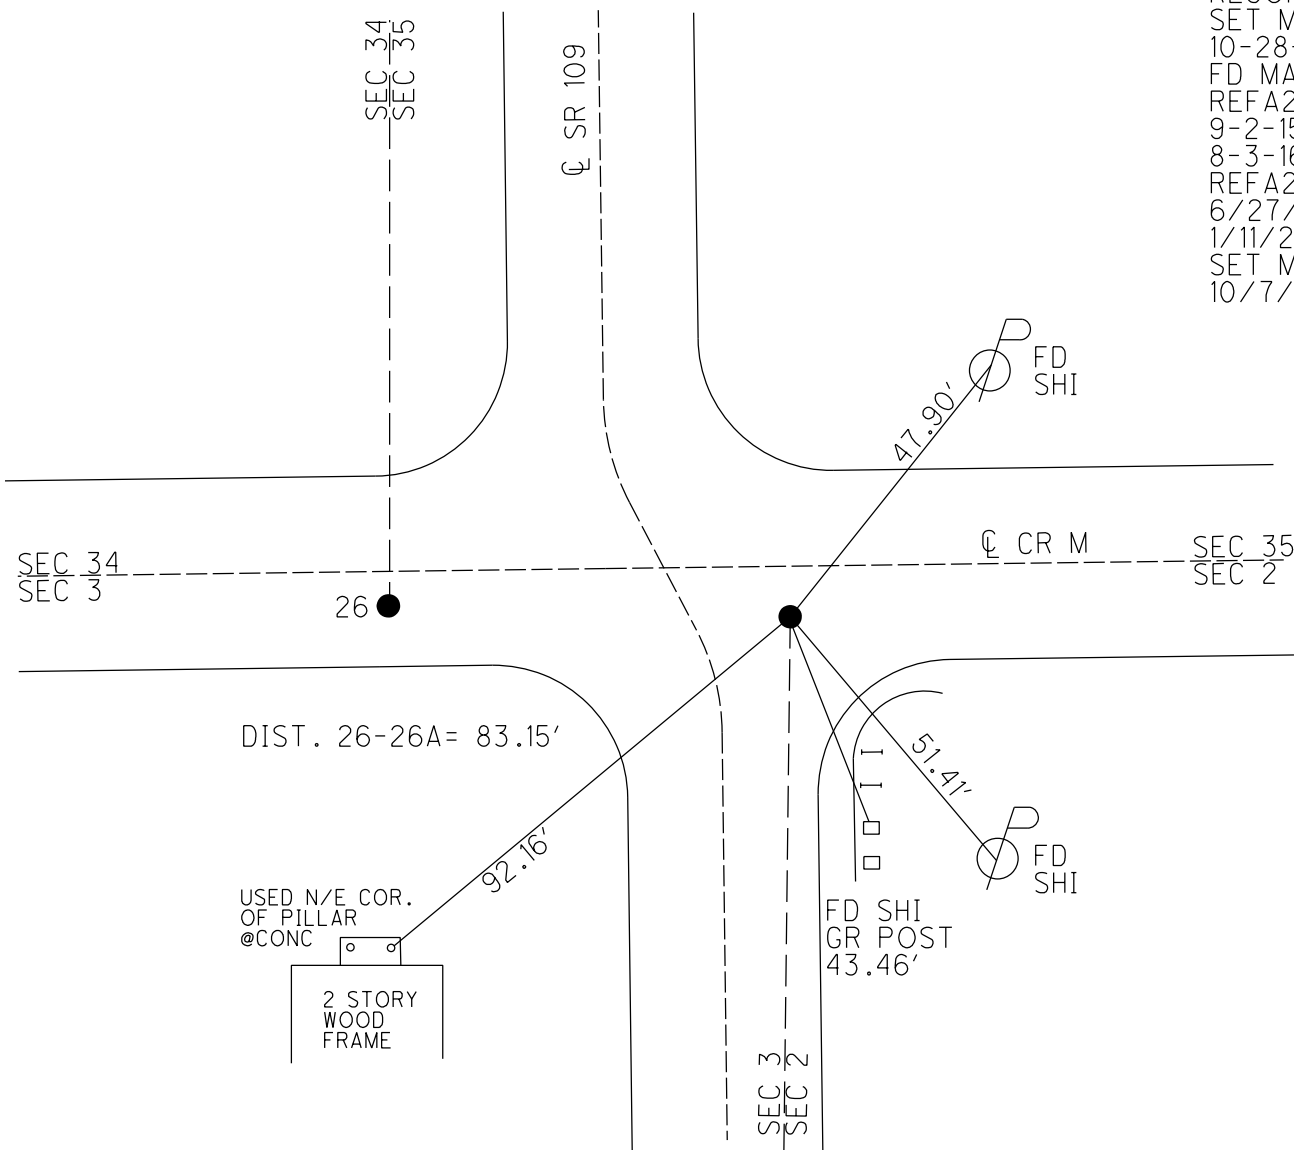

O.D.O.T. DISTRICT 2 SURVEY OFFICE (USE ONLY)

PERSONNEL

REFERENCE NO. 26 A

SHEET 14 OF 36

NOTES RHOADES

DATE 6/27/22

ROUTE SR 109

H.C. AUBLE

WEATHER SUNNY

COUNTY HENRY

R.C. RHOADES

TEMP. 67°

TOWNSHIP MONROE

SECTION 2

DWG BY RHOADES PID PAVETRAIN

T 4 N R 7 E

TYPE MONUMENT MAG/WASHER

ON SURFACE - ~~BELOW~~ ON

OFFSET Q PAVEMENT 19' ~~LT~~ : RT

0.5' TO S EDGE PAVEMENT


STATION: 637+82

HORZ.DATUM: NAD83 2011


GEOID: NAVD88 2018

GRID: NORTHING: 613988.724

EASTING: 1546192.375

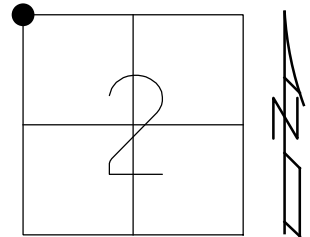

RECORD:
SET MAG/WASHER
10-28-04, MC
FD MAG/WASHER
REFA26
9-2-15, JFO
8-3-16, JMR
REFA26
6/27/22, DSA
1/11/23, JMR

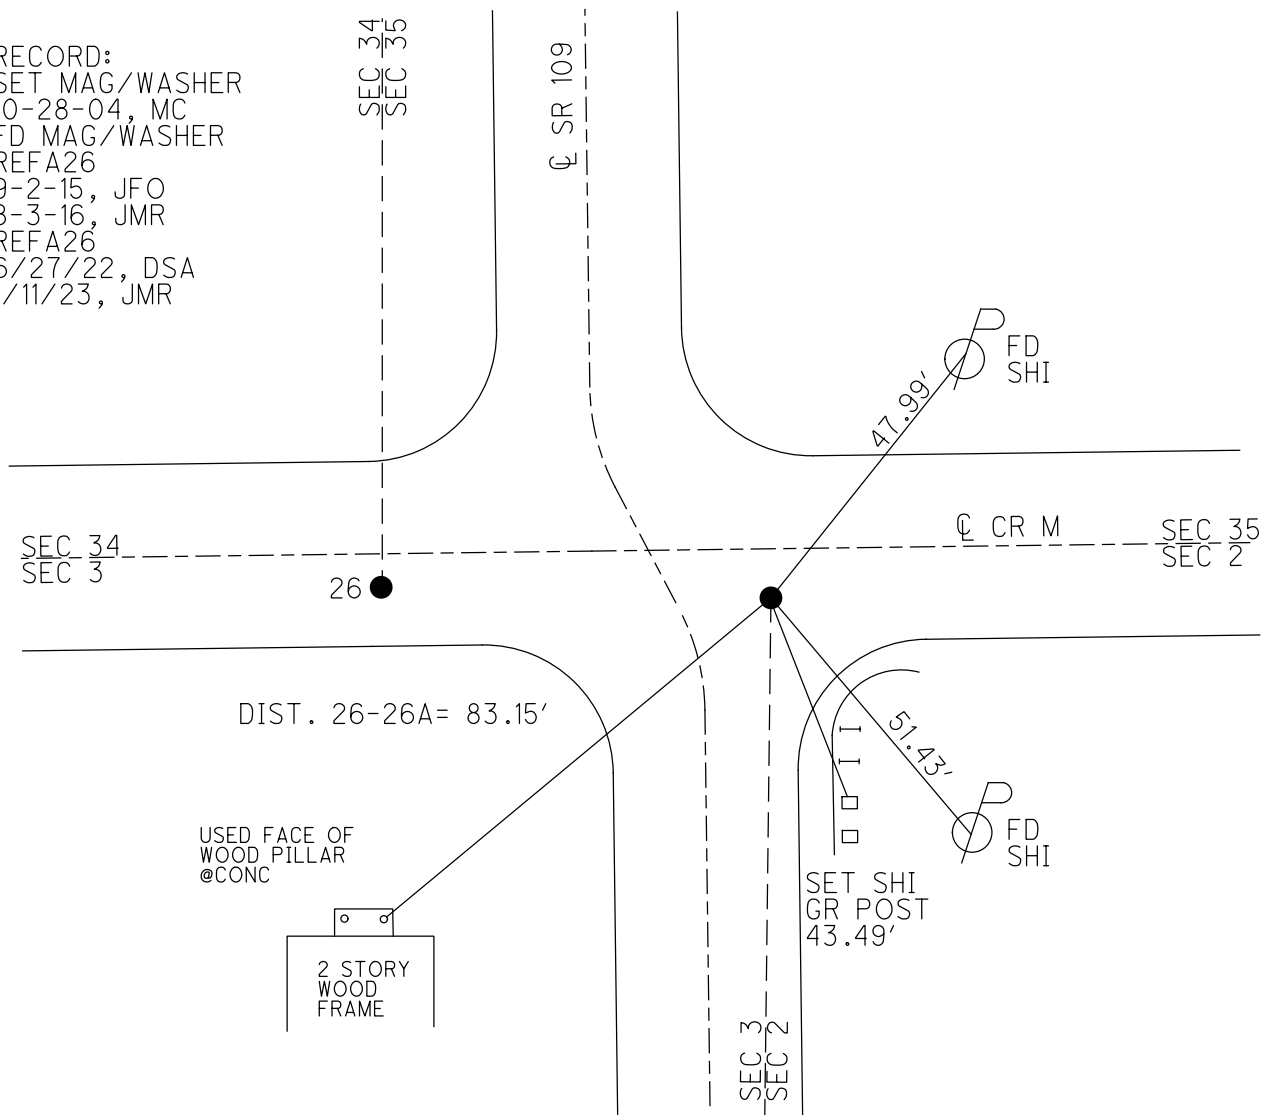


O.D.O.T. DISTRICT 2 SURVEY OFFICE (USE ONLY)

PERSONNEL _____ REFERENCE NO. 26 A SHEET 14 OF 38
NOTES RHOADES DATE 9-3-15 ROUTE SR 109
H.C. O'DONNELL WEATHER CLEAR COUNTY HENRY
R.C. RHOADES TEMP. 88°F TOWNSHIP MONROE
SECTION 2
T 4 N R 7 E

TYPE MONUMENT PK/WASHER
ON SURFACE - ~~BELOW~~ ON
~~LEFT~~ - Q PAV'T - RIGHT 19'
0.5' TO S EDGE PAVEMENT
S.L.M. 638+17

Grid: Northing: 613988.7243 Easting: 1546192.3745

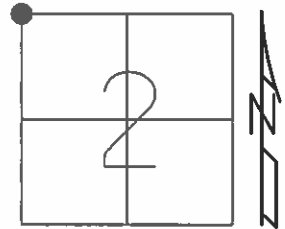


RECORD:
SET MAG/WASHER
10-28-04, MC

FD MAG/WASHER
GPS, REFA26
9-2-15, JFO

NOT COVERED
8-3-16, JMR

DIST. 26-26A= 83.15'

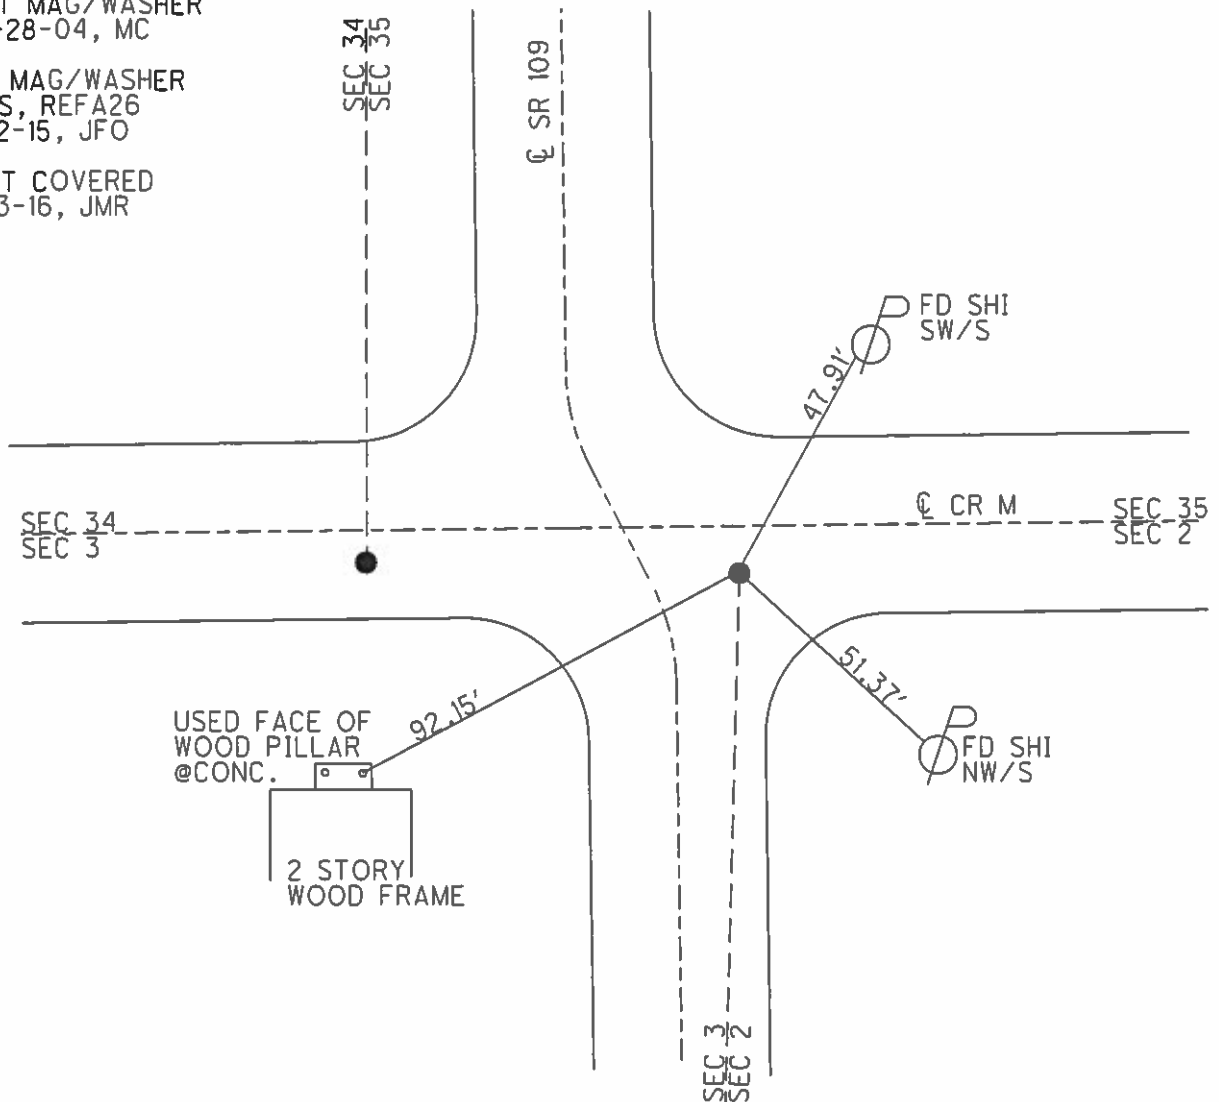

O.D.O.T. DISTRICT 2 SURVEY OFFICE

PERSONNEL

REFERENCE NO. 26

SHEET 12 OF 23

NOTES CANTERBURY

H.C. BARNHISEL

R.C. HOOKE

DATE 8/31/04

WEATHER SUN

TEMP. +70°

ROUTE SR 109

COUNTY HENRY

TOWNSHIP MONROE

SECTION 2, 3, 34, 35

T 4 N R 7 E

PT "A"

PT "B"

TYPE MONUMENT LG R.R. SPK.

P.K./WASHER

ON SURFACE - BELOW 2" DOWN

SURFACE

LEFT - & PAW'T. - RIGHT 83.1' LT &



19' RT &

PT "A" 5.0' TO S. EDGE PAVEMENT 3.3' S. OF CO. RD.

0.5' S. OF CO. RD. "M"

S.L.M. 638+17

638+17

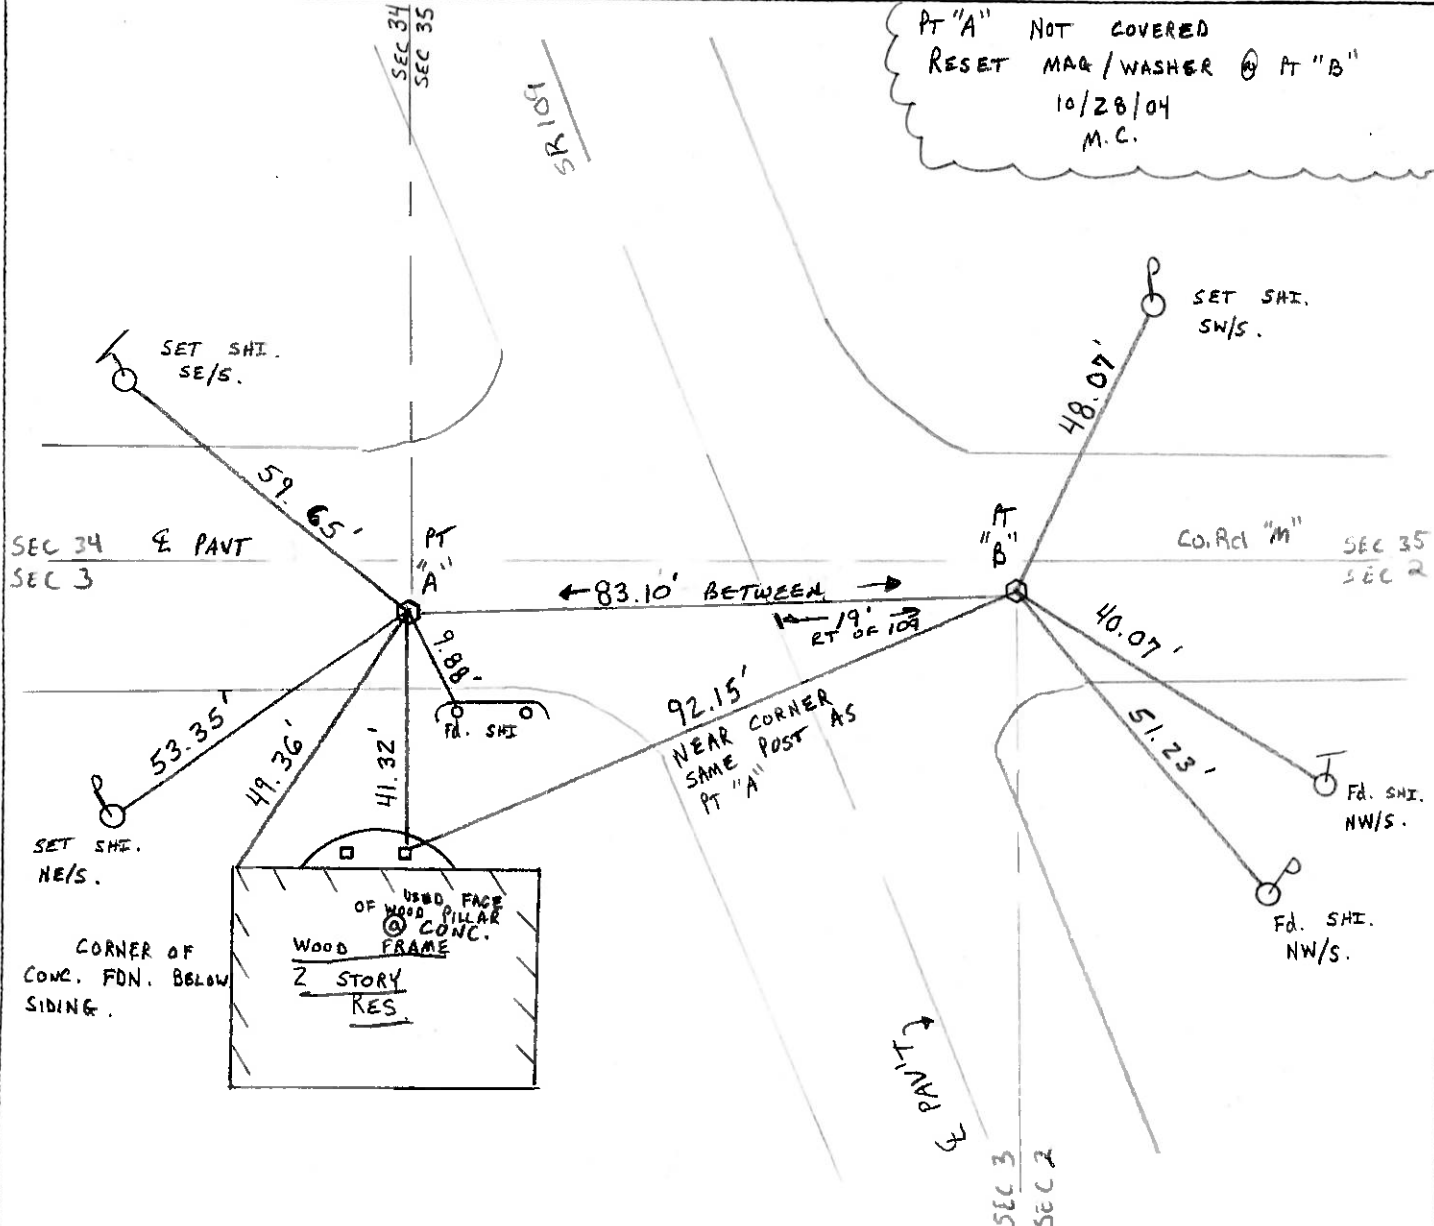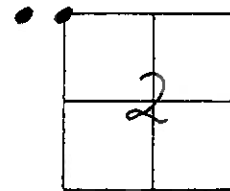

O.D.O.T. DISTRICT 2 SURVEY OFFICE

PERSONNEL

REFERENCE NO. 26

SHEET OF

NOTES BARNHISEL

H.C. VAN DUSEN

R.C. BARNHISEL

DATE 8-13-23

WEATHER SUNNY

TEMP. +80° F

ROUTE SR 109

COUNTY HENRY

TOWNSHIP MONROE

SECTION 2, 3, 34, 35

T 4 N R 7 E


TYPE MONUMENT LG. RR/SPK.

ON SURFACE - BELOW YES


LEFT - & PAV'T. - RIGHT PT. A 3.3 PT. B 1.5 Co. RD. M

PT. A 5.0 TO RT. EDGE PAVEMENT

S.L.M. 638 + 0.6

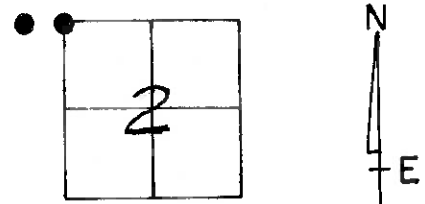

PT "A" WAS NOT COVERED
SET PK & WASHER @ PT. "B"
8-27-23
MB

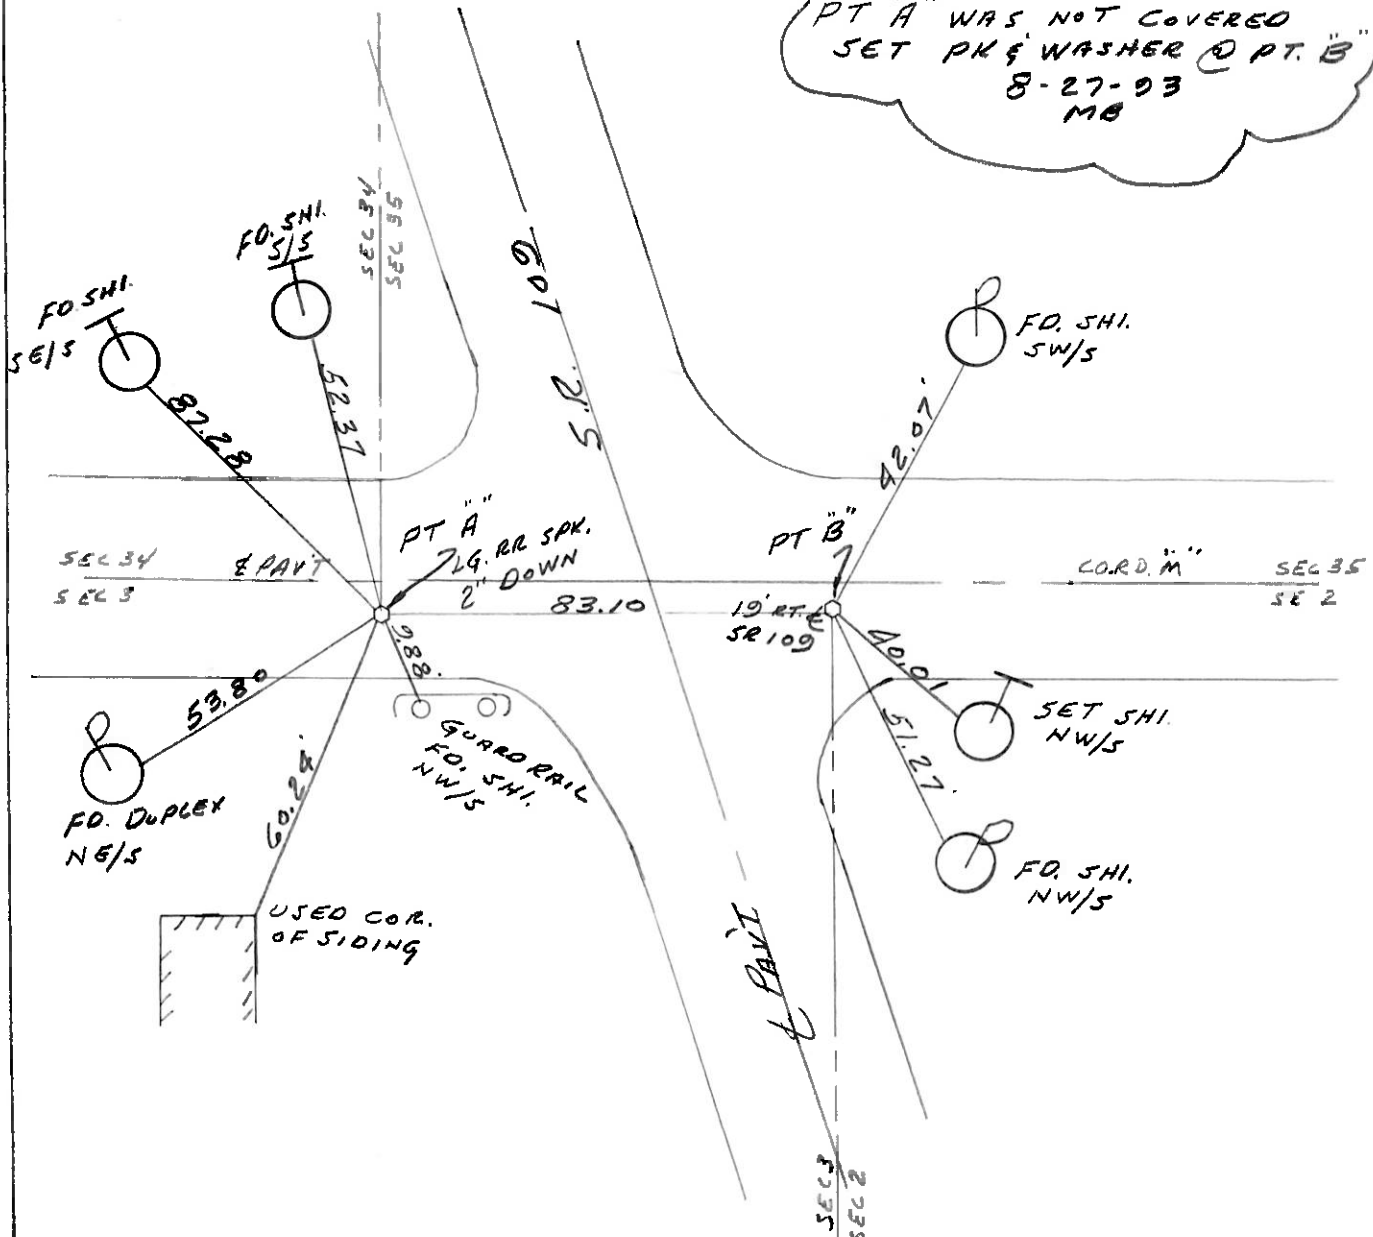

O.D.O.T. DISTRICT 2 SURVEY OFFICE

PERSONNEL

REFERENCE NO. 26

SHEET OF

NOTES Baehisel

H.C. Hoffman

R.C. Loehrke

DATE 4-8-85

WEATHER Cloudy - Flurries

TEMP. +35°

ROUTE 109

COUNTY Henry

TOWNSHIP Monroe

SECTION 2

T 4 N R 7 E

TYPE MONUMENT Lg RR/SPK


ON SURFACE - BELOW ✓

LEFT - CL PAV'T. - RIGHT Pt "A" 3.5 Pt "B" 1.5

5.3 TO R+ EDGE PAVEMENT

S.L.M. 637+54

Co Rd "M"

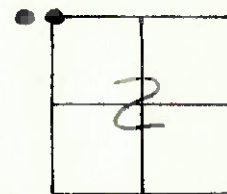

Set PK/Washer Pt "B"
Not Covered Pt "A"
5-24-85
MDTB

