

O.D.O.T. DISTRICT 2 SURVEY OFFICE (USE ONLY)

PERSONNEL

REFERENCE NO. 28

SHEET 21 OF 25

NOTES NIESE

DATE 10/7/24

ROUTE SR 109

H.C. MILLER

WEATHER SUNNY

COUNTY HENRY

R.C. PRESTON-COLVIN

TEMP. 52°

TOWNSHIP HARRISON

SECTION 35

DWG BY BARRIERE PID 99587

T 5 N R 7 E

TYPE MONUMENT MAG NAIL/WASHER

ON SURFACE - BELOW ON

OFFSET Q PAVEMENT LT : RT

TO EDGE PAVEMENT

STATION: 619+09

HORIZ.DATUM: OHIO LDP (HENRY)


GEOID: 18

GRID: NORTHING: 619288.5271


EASTING: 156202.2864

LDP: NORTHING: 475929.881

EASTING: 180969.188

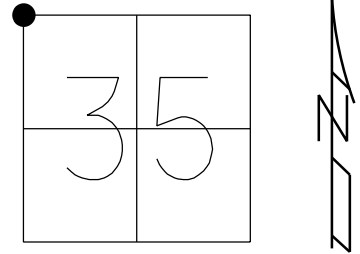

RECORD:
SET MAG/WASHER
10-28-04, MC
FD MAG/WASHER
REF28
9-1-15, JFO
8-3-16, JMR
REF28
6/27/22, DSA
1/11/23, JMR
SET MAG/WASHER
10/7/24, JAM

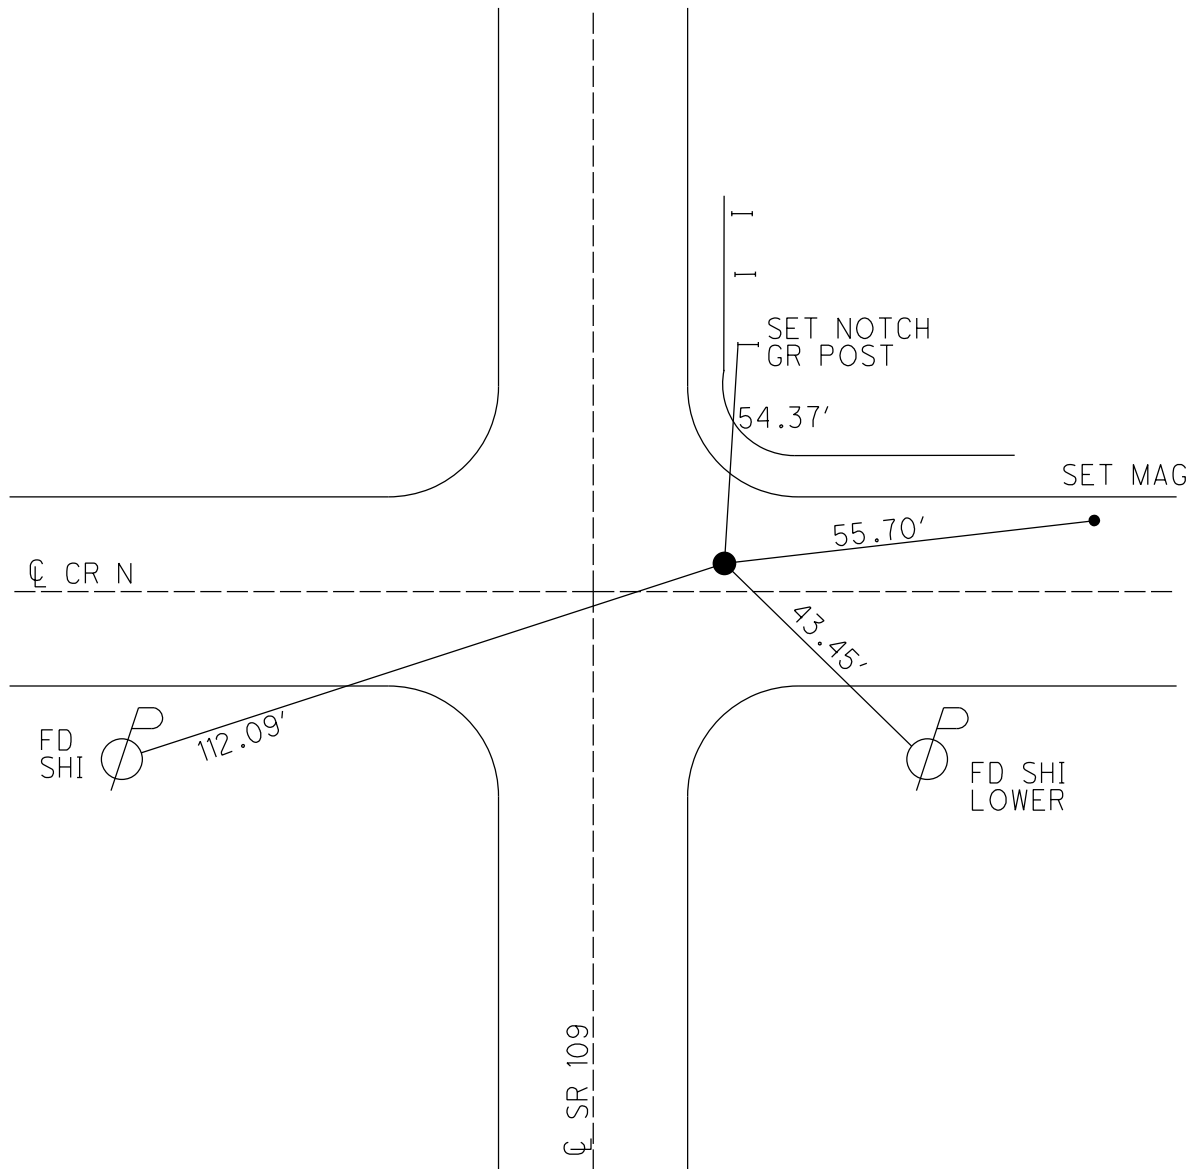

O.D.O.T. DISTRICT 2 SURVEY OFFICE (USE ONLY)

PERSONNEL

REFERENCE NO. 28

SHEET 16 OF 36

NOTES RHOADES

DATE 6/27/22

ROUTE SR 109

H.C. AUBLE

WEATHER SUNNY

COUNTY HENRY

R.C. RHOADES

TEMP. 67°

TOWNSHIP HARRISON

SECTION 35

DWG BY RHOADES

PID PAVETRAIN

T 5 N R 7 E

TYPE MONUMENT MAG/WASHER

ON SURFACE - ~~BELOW~~ ON

OFFSET 8' LT : RT

2' TO RT EDGE PAVEMENT


STATION: 691+15.2

HORIZ.DATUM: NAD83 2011


GEOID: NAVD88 2018

GRID: NORTHING: 619288.527

EASTING: 156202.286

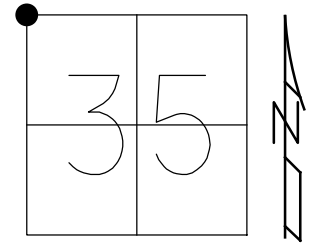

RECORD:
SET MAG/WASHER
10-28-04, MC
FD MAG/WASHER
REF28
9-1-15, JFO
8-3-16, JMR
REF28
6/27/22, DSA
1/11/23, JMR

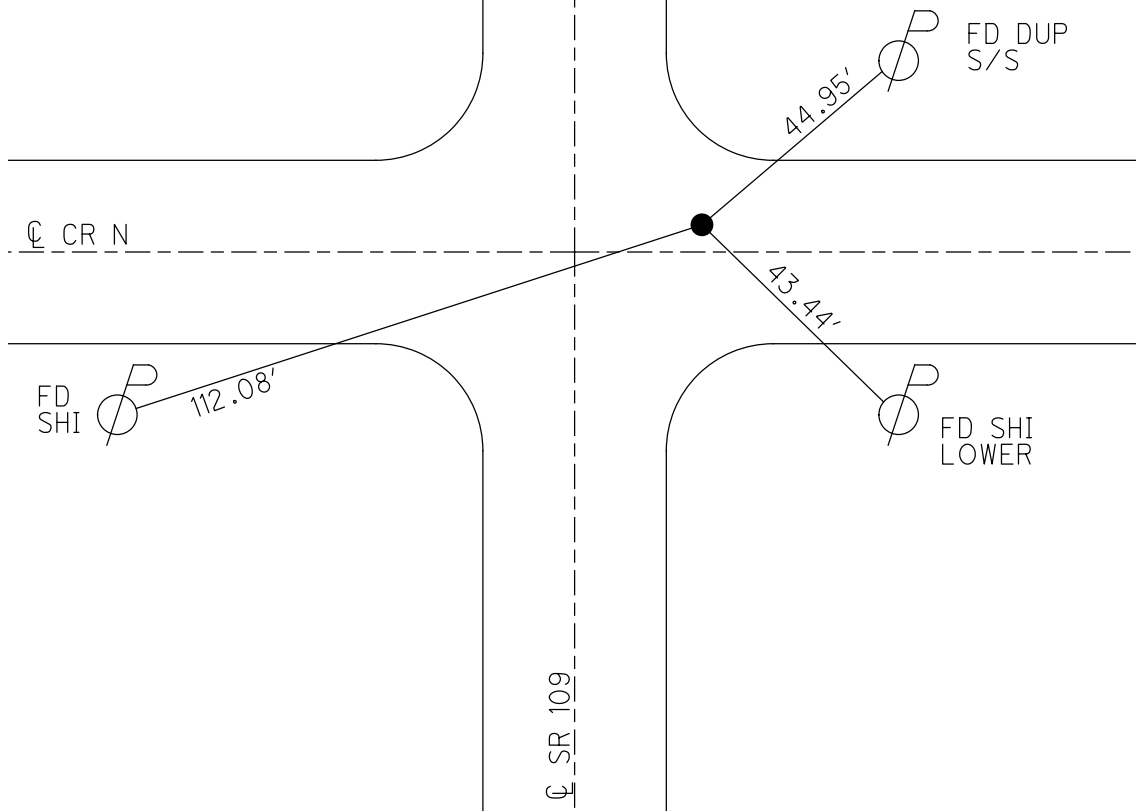

O.D.O.T. DISTRICT 2 SURVEY OFFICE (USE ONLY)

PERSONNEL

REFERENCE NO. 28

SHEET 16 OF 39

NOTES RHOADES

DATE 9-3-15

ROUTE SR 109

H.C. O'DONNELL

WEATHER CLEAR

COUNTY HENRY

R.C. RHOADES

TEMP. 88°F

TOWNSHIP HARRISON

SECTION 35

T 5 N R 7 E

TYPE MONUMENT MAG/WASHER


ON SURFACE - ~~BELOW~~ ON

~~LEFT~~ - CL PAV'T - RIGHT 8.0'

2.0' TO RT EDGE PAVEMENT

S.L.M. 691+09


Grid: Northing: 619288.5271 Easting: 156202.2864

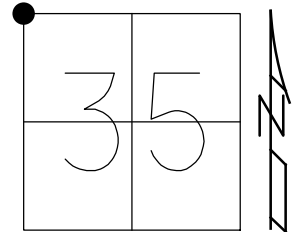

RECORD:
SET MAG/WASHER
10-28-04, MC

FD MAG/WASHER
GPS, REF28
9-1-15, JFO

NOT COVERED
8-3-16, JMR

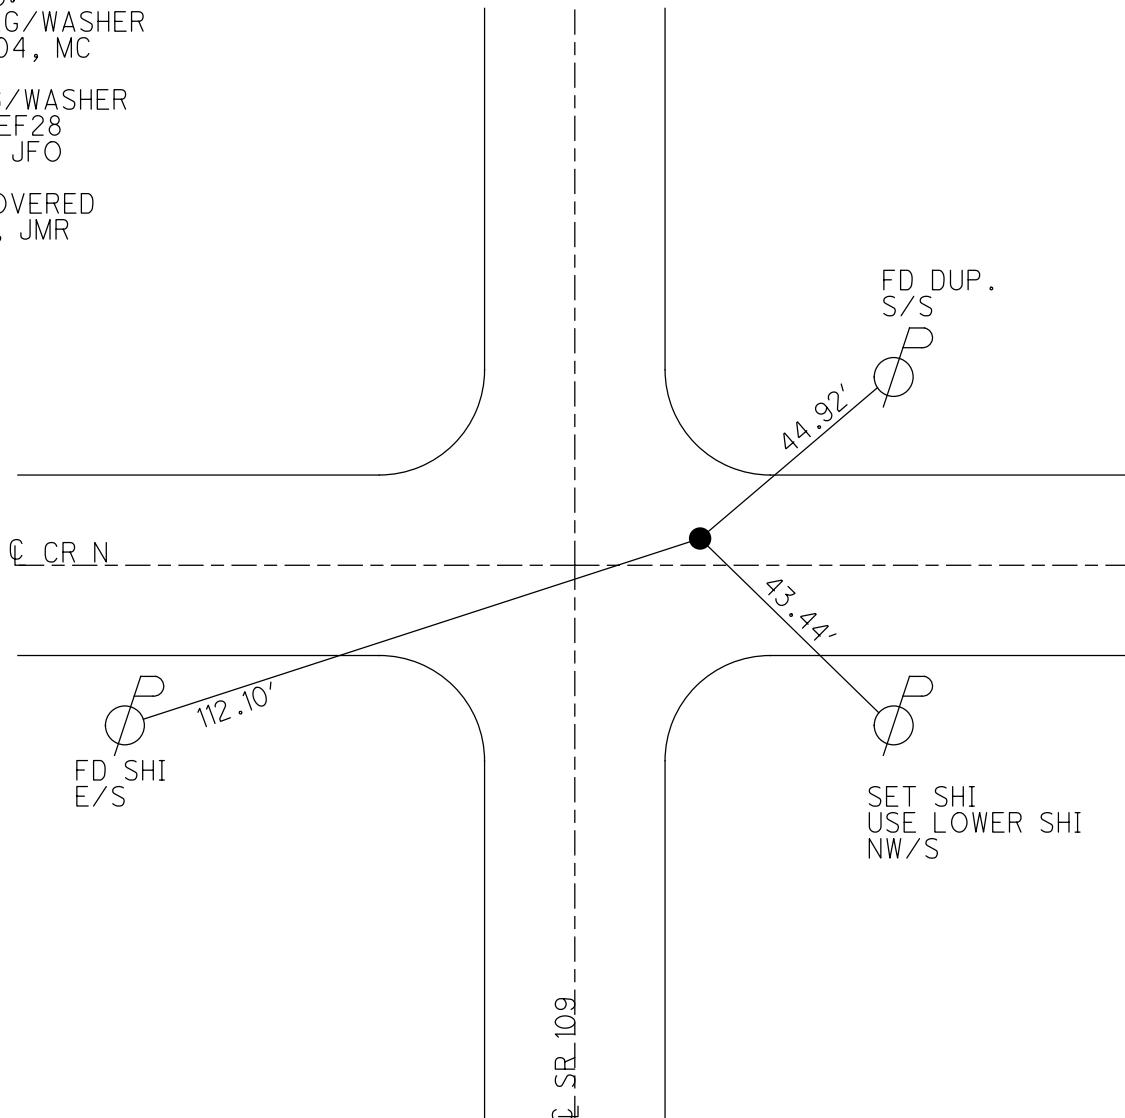

O.D.O.T. DISTRICT 2 SURVEY OFFICE

PERSONNEL

REFERENCE NO. 28

SHEET 14 OF 23

NOTES CANTERBURY

H.C. BARNHISEL

R.C. HOOVER

DATE 8-31-04

WEATHER SUN

TEMP. + 75°

ROUTE 109

COUNTY HENRY

TOWNSHIP HARRISON

SECTION 35

T5 N R 7 E


TYPE MONUMENT P.K. / WASHER

ON SURFACE - BELOW SURFACE

~~LEFT~~ - & PAV'T. - RIGHT 8.0'

2.0' TO RT. EDGE PAVEMENT 1' NORTH OF & EAST


S.L.M. 691 + 09


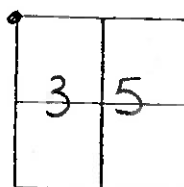


RESET MAG/WASHER

10/28/04

M.C.

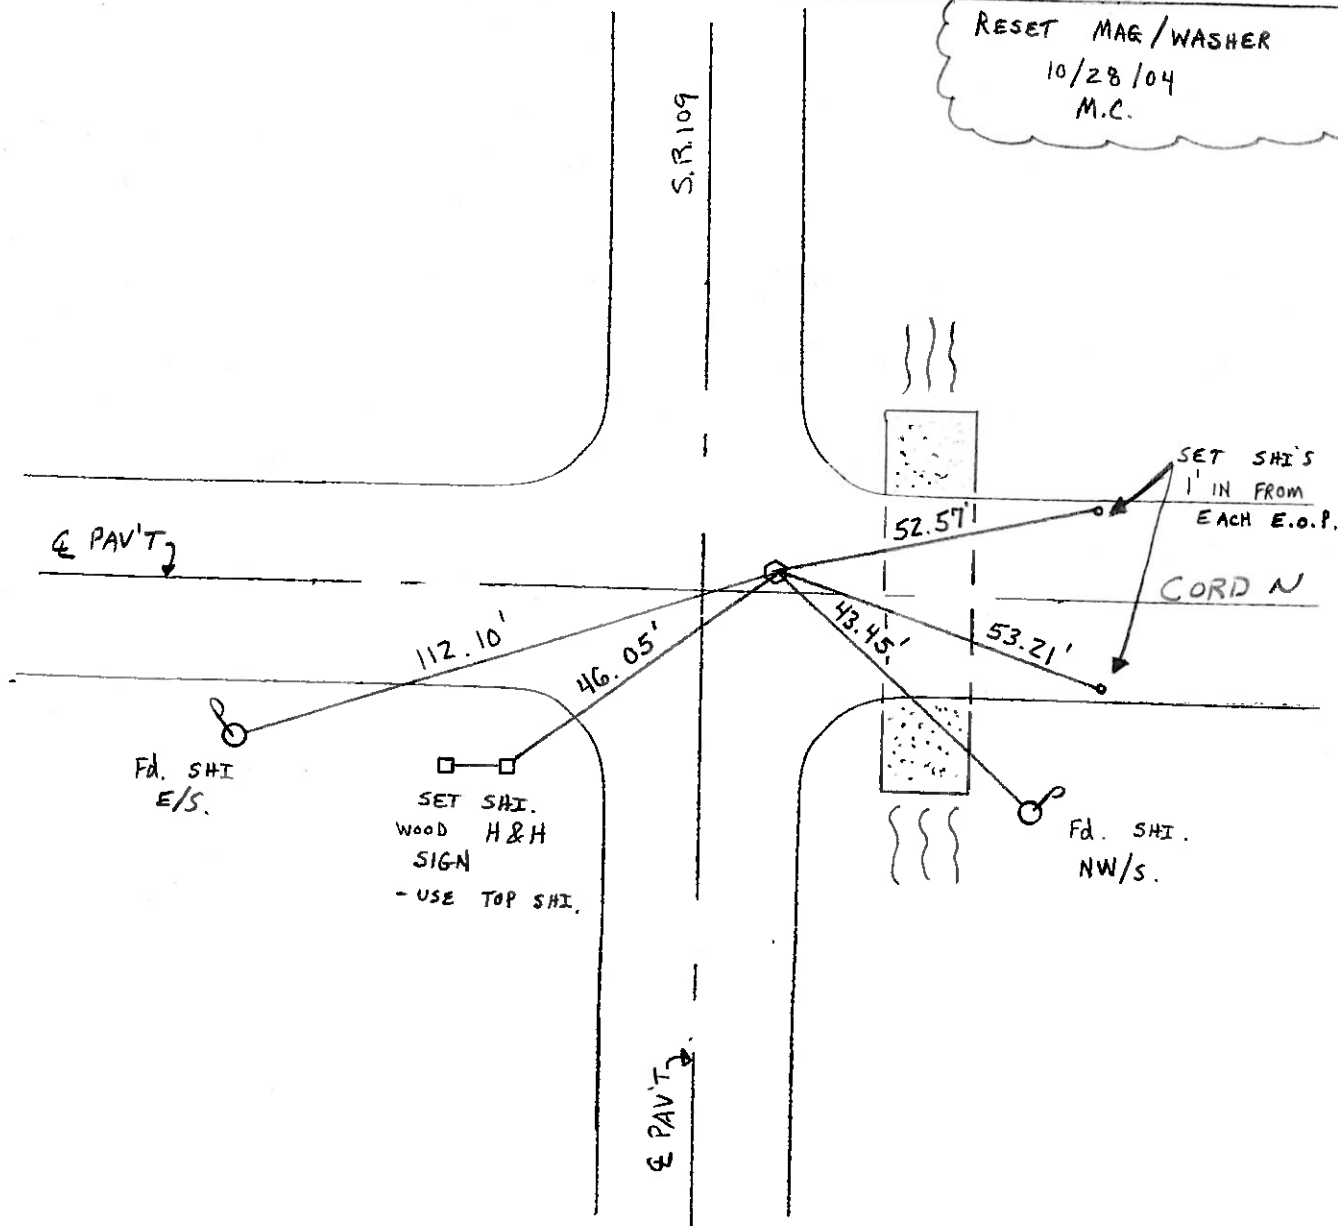

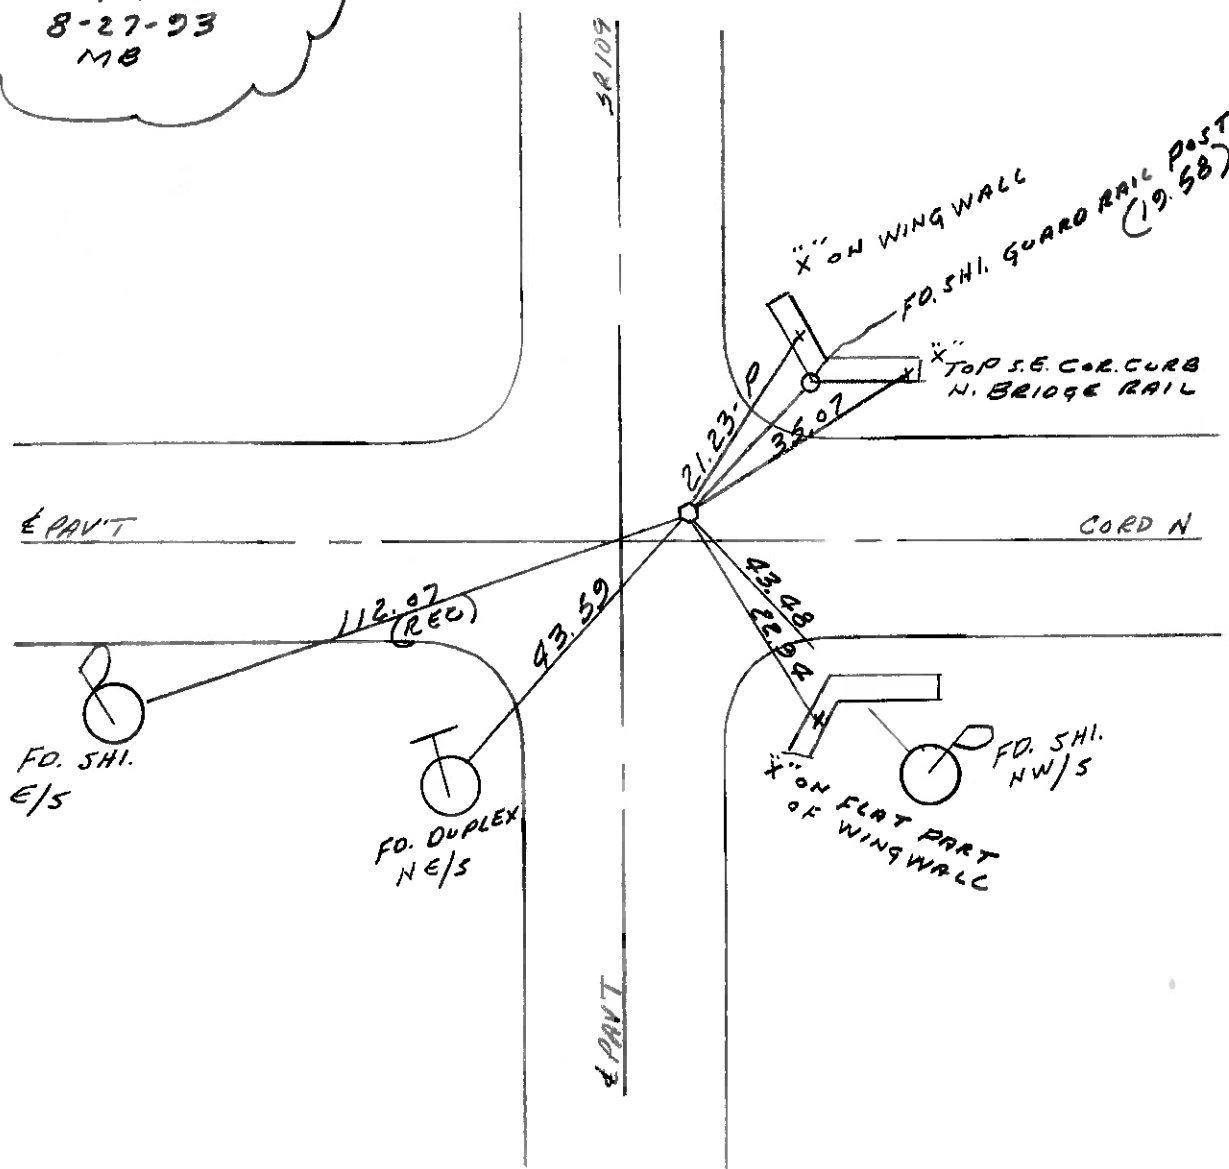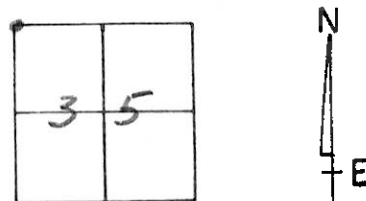

O.D.O.T. DISTRICT 2 SURVEY OFFICE

PERSONNEL

REFERENCE NO. 28

SHEET OF

NOTES BARNHISEL

H.C. Hoffman

R.C. Loehrke

DATE 4-8-85

WEATHER cloudy

TEMP. +350

ROUTE 109

COUNTY Henry

TOWNSHIP Harrison

SECTION 35

T 5 N R 7 E



TYPE MONUMENT Lg RR/spk Punch hole

ON SURFACE - BELOW ✓

LEFT - CL PAW'T. - RIGHT 8.0

2.0 TO Rt EDGE PAVEMENT

S.L.M. 690+62

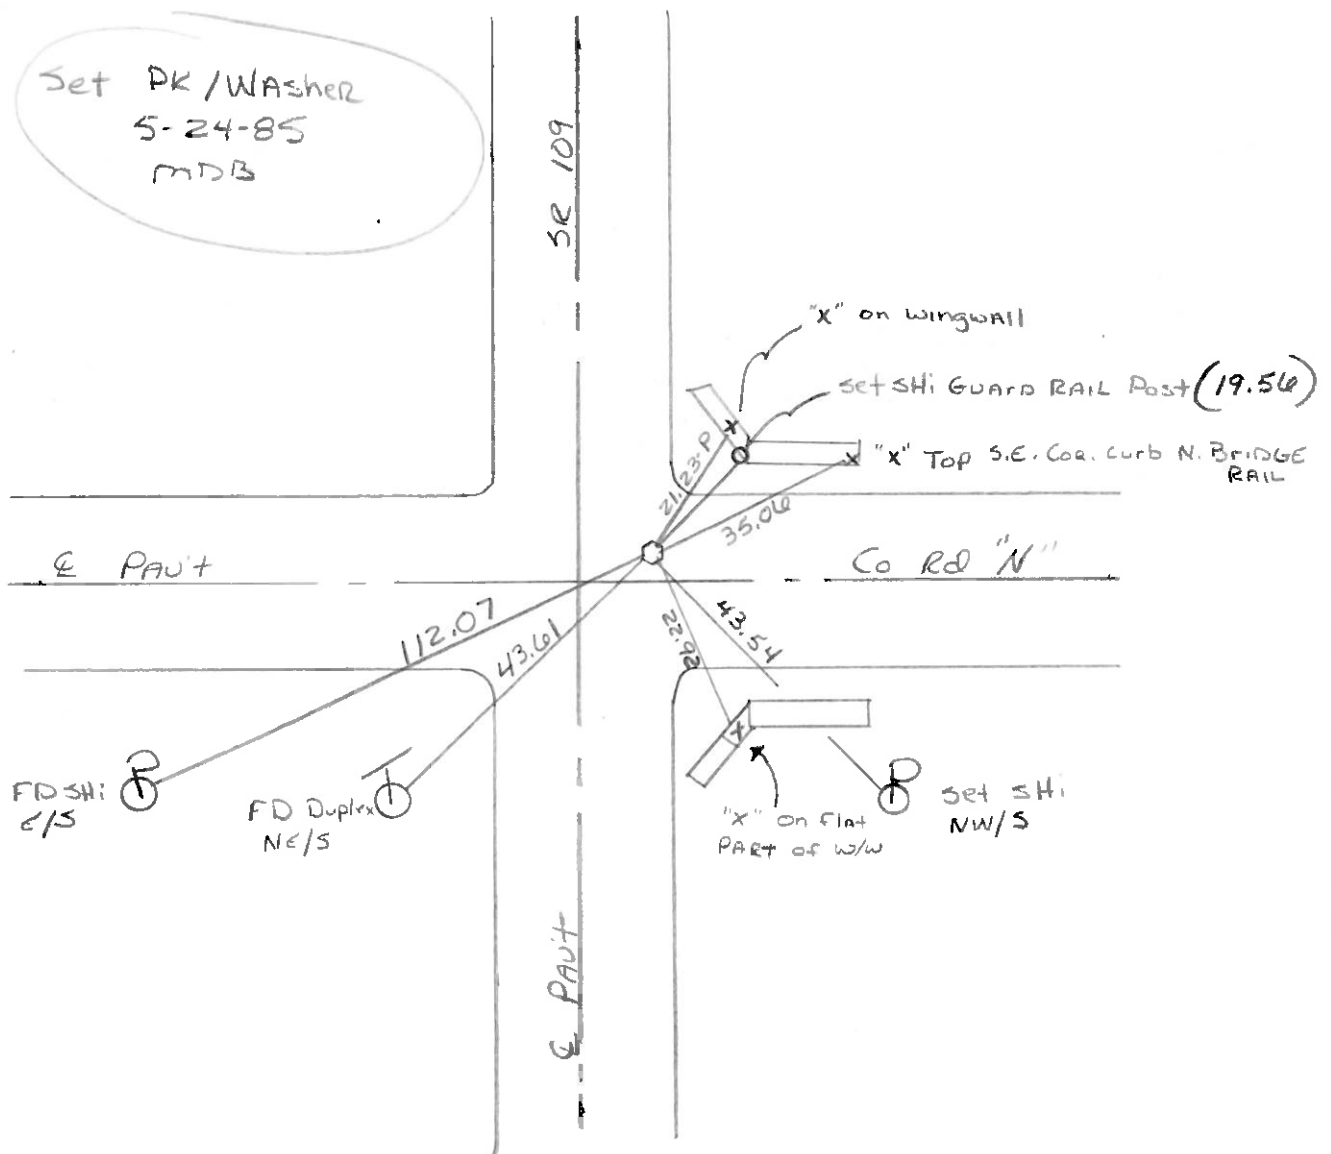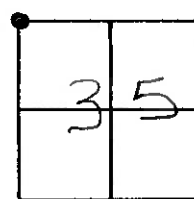

ODOT DISTRICT 2 SURVEY OFFICE

SHEET _____ OF _____

County Henry S.R. 109

Township Harrison

Section 35

T5N, R7E

Personnel Hoffman


Lochke

Hauscholder


Date 6-1-82

Weather cloudy

Temp. +72°

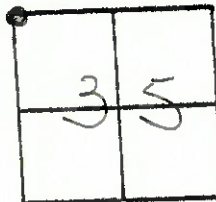

Fd R.R. spk @ surface set by County
7.7' Rt. of & part S.R. 109
0.8' North of & part Co. Rd. "N"

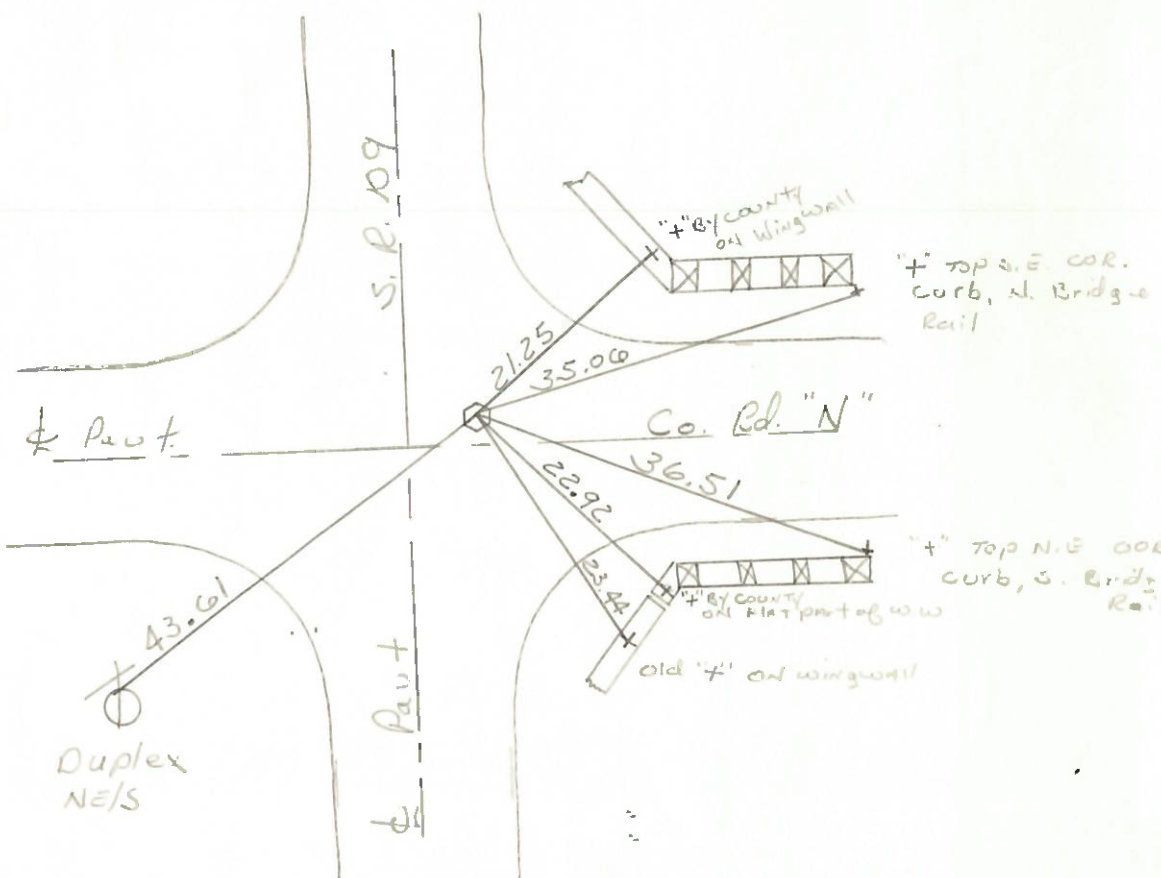

PERSONNEL TITLE PERSONNEL TITLE

BURNSIDE

SMITH

BOWERS

MEAD

COUNTY HENRY

DATE 9-17-76

S. R. 109

WEATHER Cloudy - Showe

SEC. W 1/4 Post SEC. 35

TEMP. +65°

DESCRIPTION REF TO CONTROL POINTS

LEFT

CENTER LINE

RIGHT

JOB NO.

