

O.D.O.T. DISTRICT 2 SURVEY OFFICE (USE ONLY)

PERSONNEL

REFERENCE NO. 29

SHEET 21 OF 25

NOTES NIESE DATE 10/7/24
H.C. MILLER WEATHER SUNNY
R.C. PRESTON-COLVIN TEMP. 52°

ROUTE SR 109
COUNTY HENRY
TOWNSHIP HARRISON
SECTION 26
T 5 N R 7 E

DWG BY BARRIERE PID 99587

TYPE MONUMENT MAG NAIL/WASHER

ON SURFACE - BELOW ON

OFFSET $\varnothing$ PAVEMENT LT : RT


 TO EDGE PAVEMENT

STATION: 619+09


HORIZ.DATUM: OHIO LDP (HENRY) GEOID: 18

GRID: NORTHING: 619288.5271 EASTING: 156202.2864

LDP: NORTHING: 475929.881 EASTING: 180969.188

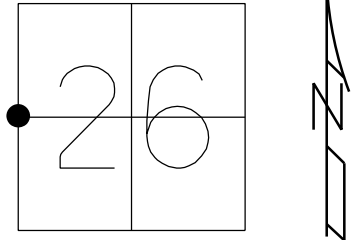

RECORD:
SET MAG/WASHER
10-28-04, MC
FD MAG/WASHER
REF29
9-1-15, JFO
8-3-16, JMR
REF29
6/27/22, DSA
1/11/23, JMR
SET MAG/WASHER
10/7/24, TDN

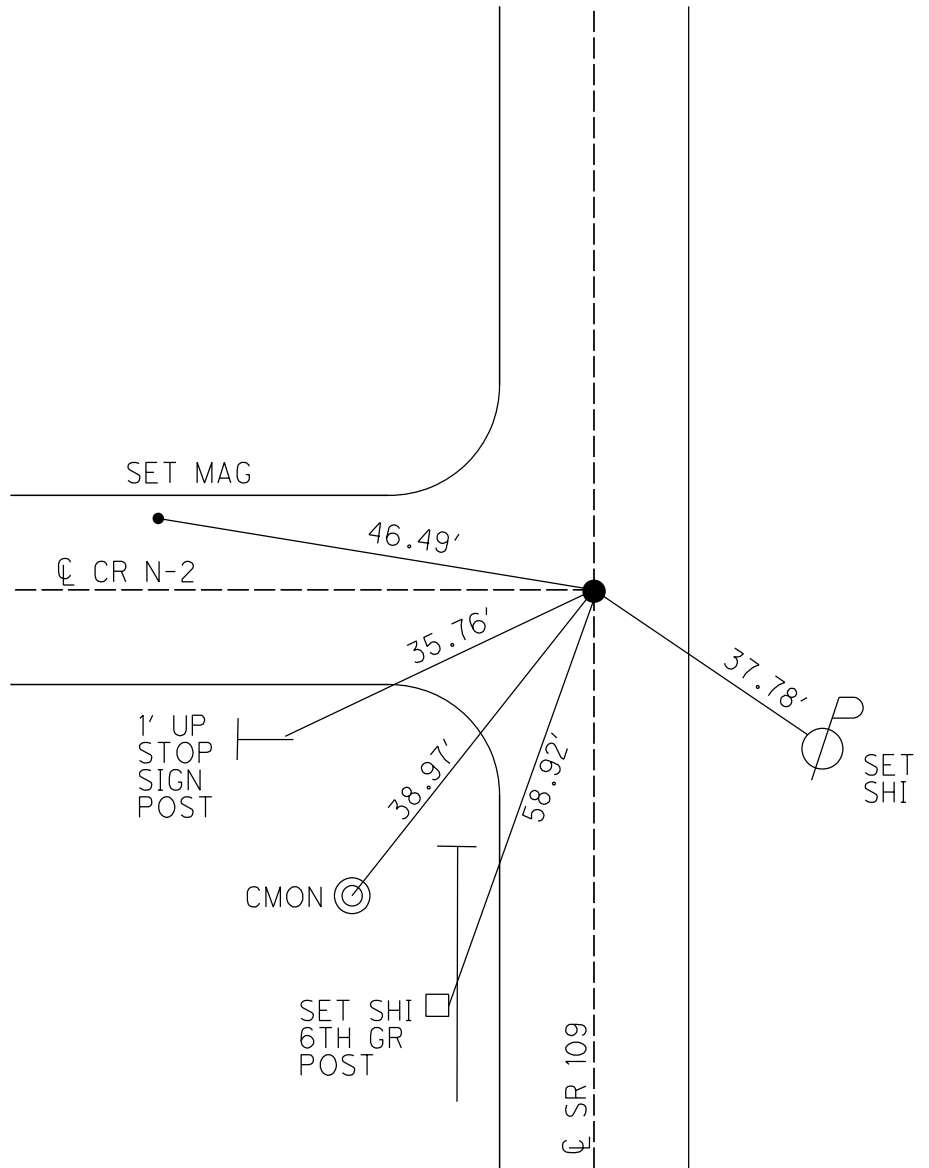

O.D.O.T. DISTRICT 2 SURVEY OFFICE (USE ONLY)

PERSONNEL

REFERENCE NO. 29

SHEET 17 OF 36

NOTES RHOADES

DATE 6/27/22

ROUTE SR 109

H.C. AUBLE

WEATHER SUNNY

COUNTY HENRY

R.C. RHOADES

TEMP. 67°

TOWNSHIP HARRISON

SECTION 35

DWG BY RHOADES

PID PAVETRAIN

T 5 N R 7 E

TYPE MONUMENT MAG/WASHER

ON SURFACE - ~~BELOW~~ ON

OFFSET Q PAVEMENT ON LT : RT

9.9' TO RT EDGE PAVEMENT


STATION: 717+55.2

HORZ.DATUM: NAD83 2011


GEOID: NAVD88 2018

GRID: NORTHING: 621932.633

EASTING: 1546250.299

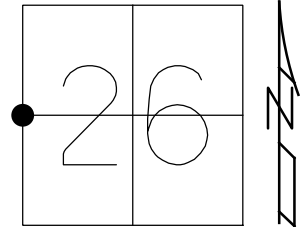

RECORD:
SET MAG/WASHER
10-28-04, MC
FD MAG/WASHER
REF29
9-1-15, JFO
8-3-16, JMR
REF29
6/27/22, DSA
1/11/23, JMR

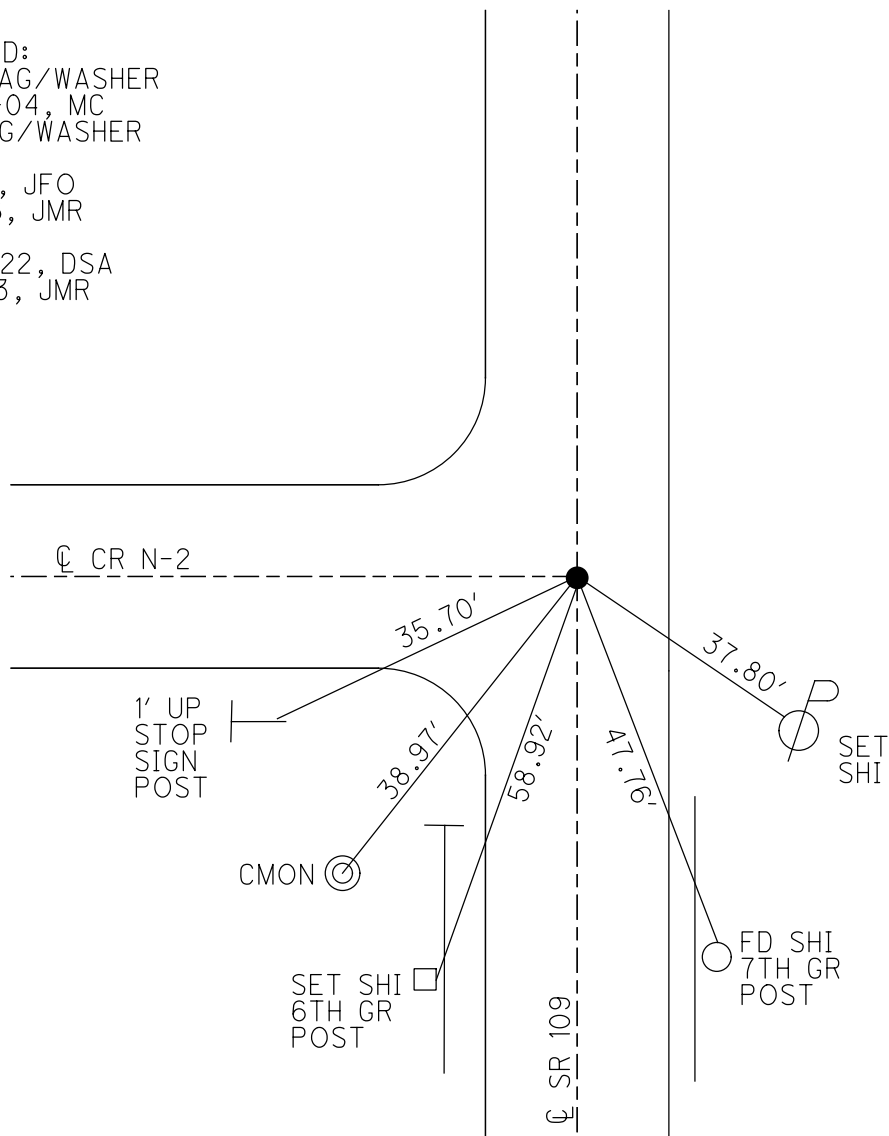


O.D.O.T. DISTRICT 2 SURVEY OFFICE (USE ONLY)

PERSONNEL _____ REFERENCE NO. 29 SHEET 17 OF 38
NOTES RHOADES DATE 9-3-15 ROUTE SR 109
H.C. O'DONNEELL WEATHER CLEAR COUNTY HENRY
R.C. RHOADES TEMP. 88°F TOWNSHIP HARRISON
SECTION 35
T 5 N R 7 E

TYPE MONUMENT MAG/WASHER
ON SURFACE - ~~BELOW~~ ON
LEFT - CL PAV'T - RIGHT ON
9.9' TO RT EDGE PAVEMENT
S.L.M. 717+44


Grid: Northing: 621932.6331 Easting: 1546250.2991

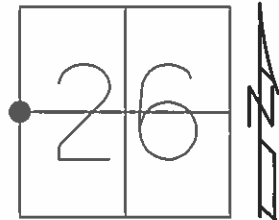

RECORD:
SET MAG/WASHER
10-28-04, MC

FD MAG/WASHER
GPS, REF29
9-1-15, JFO

NOT COVERED
8-3-16, JMR

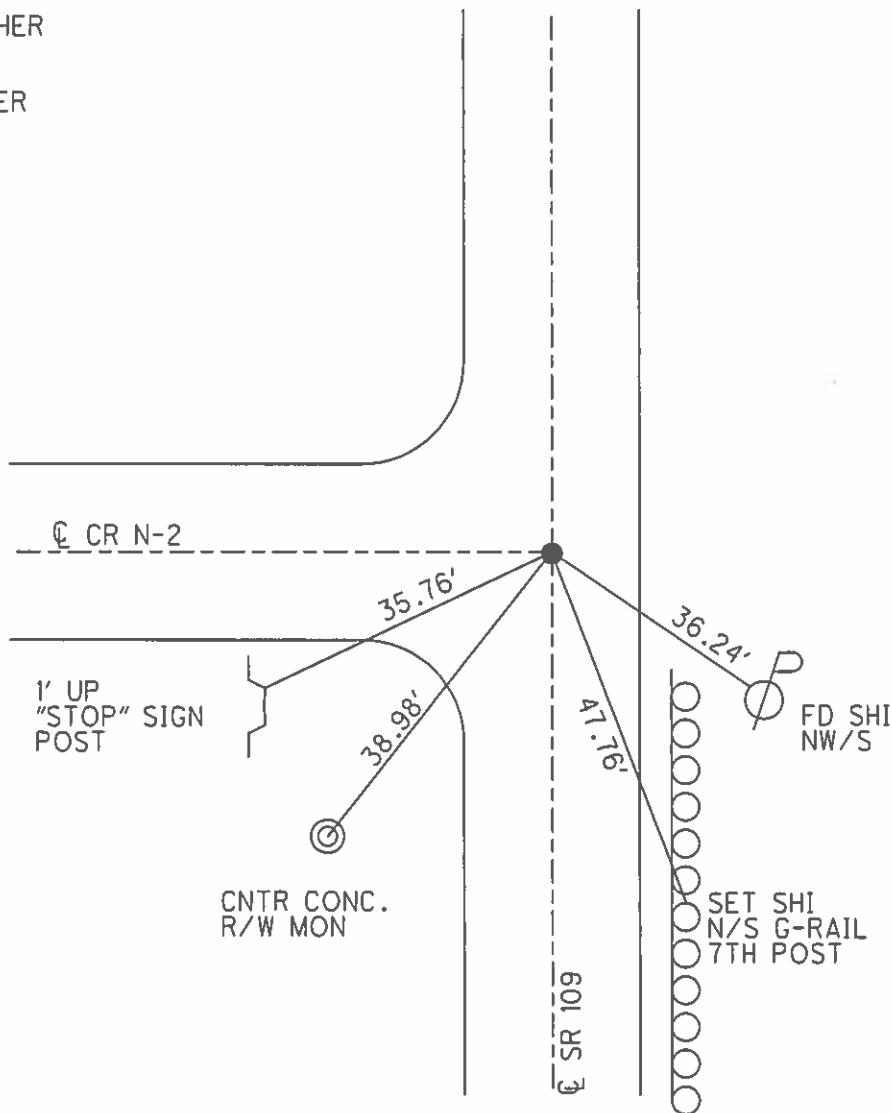

O.D.O.T. DISTRICT 2 SURVEY OFFICE

PERSONNEL

REFERENCE NO. 29

SHEET 15 OF 23

NOTES CANTERBURY

H.C. BARNHISEL

R.C. HOOKE

DATE 8-31-04

WEATHER SUN

TEMP. +75°

ROUTE SR 109

COUNTY HENRY

TOWNSHIP HARRISON

SECTION 26

T S N R T E


TYPE MONUMENT P.K. / WASHER

ON SURFACE - BELOW SURFACE


LEFT - & PAV'T. - RIGHT ON & BOTH

9.9' TO RT. EDGE PAVEMENT

S.L.M. 717 + 44

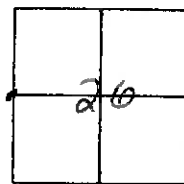

RESET MAR/WASHER
10/28/04
M.C.

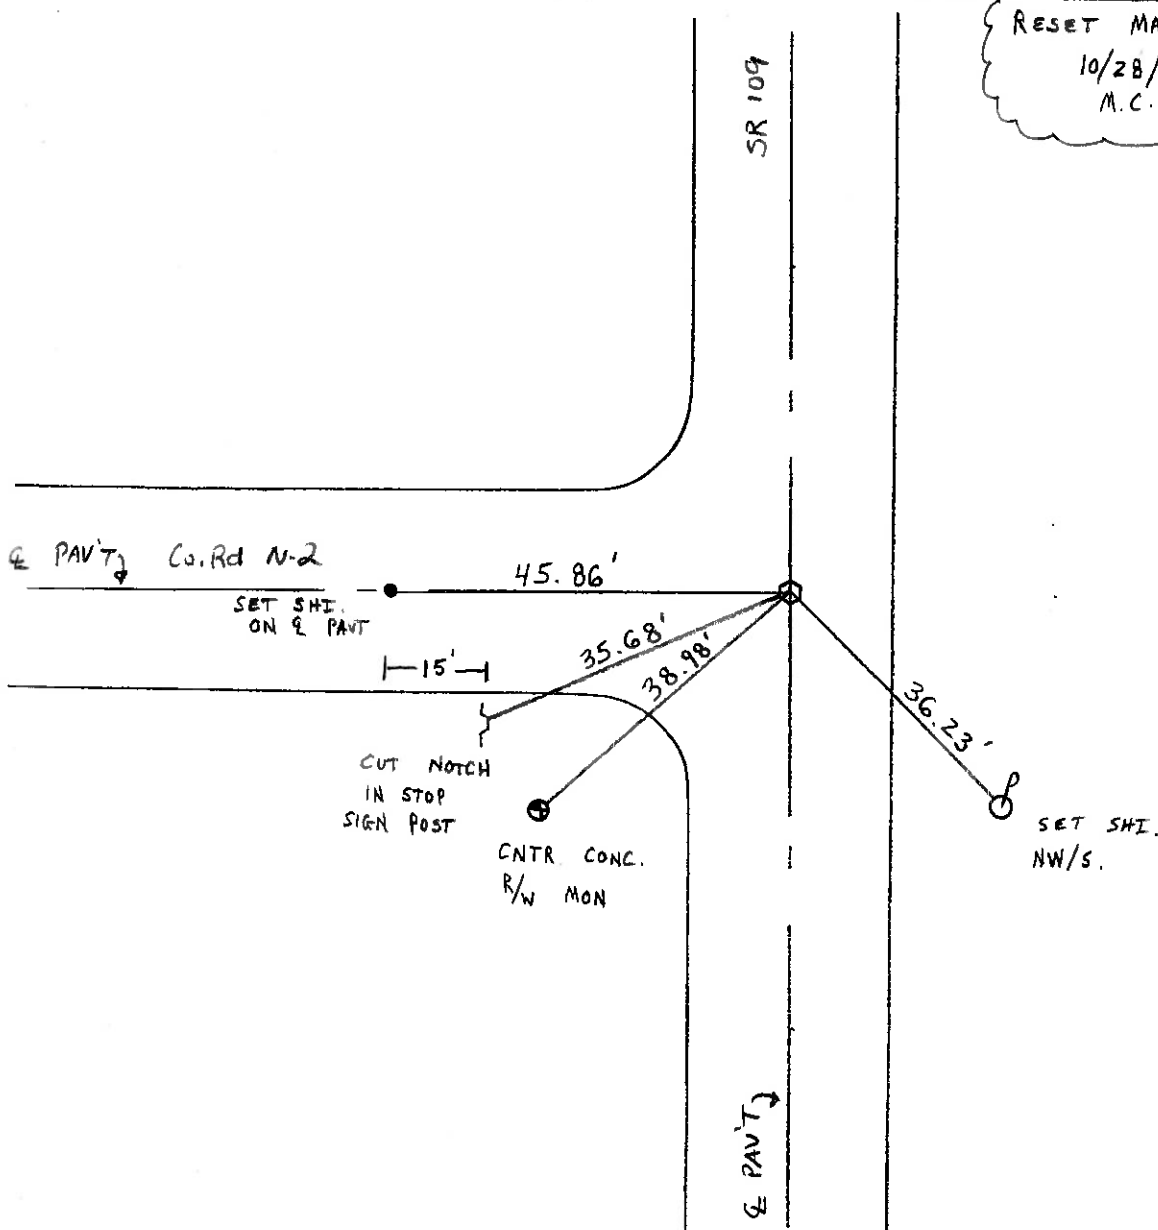

O.D.O.T. DISTRICT 2 SURVEY OFFICE

PERSONNEL

REFERENCE NO. 29

SHEET OF

NOTES BARNHISEL

H.C. VAN DUSEN

R.C. BARNHISEL

DATE 8-13-93

WEATHER SUNNY

TEMP. +80°F

ROUTE SR 109

COUNTY HENRY

TOWNSHIP HARRISON

SECTION 26

T5 N R 7 E



TYPE MONUMENT LG. RR/SPK.

ON SURFACE - BELOW YES

LEFT - & PAV'T. - RIGHT YES

10.2 TO RT. EDGE PAVEMENT

S.L.M. 717+43

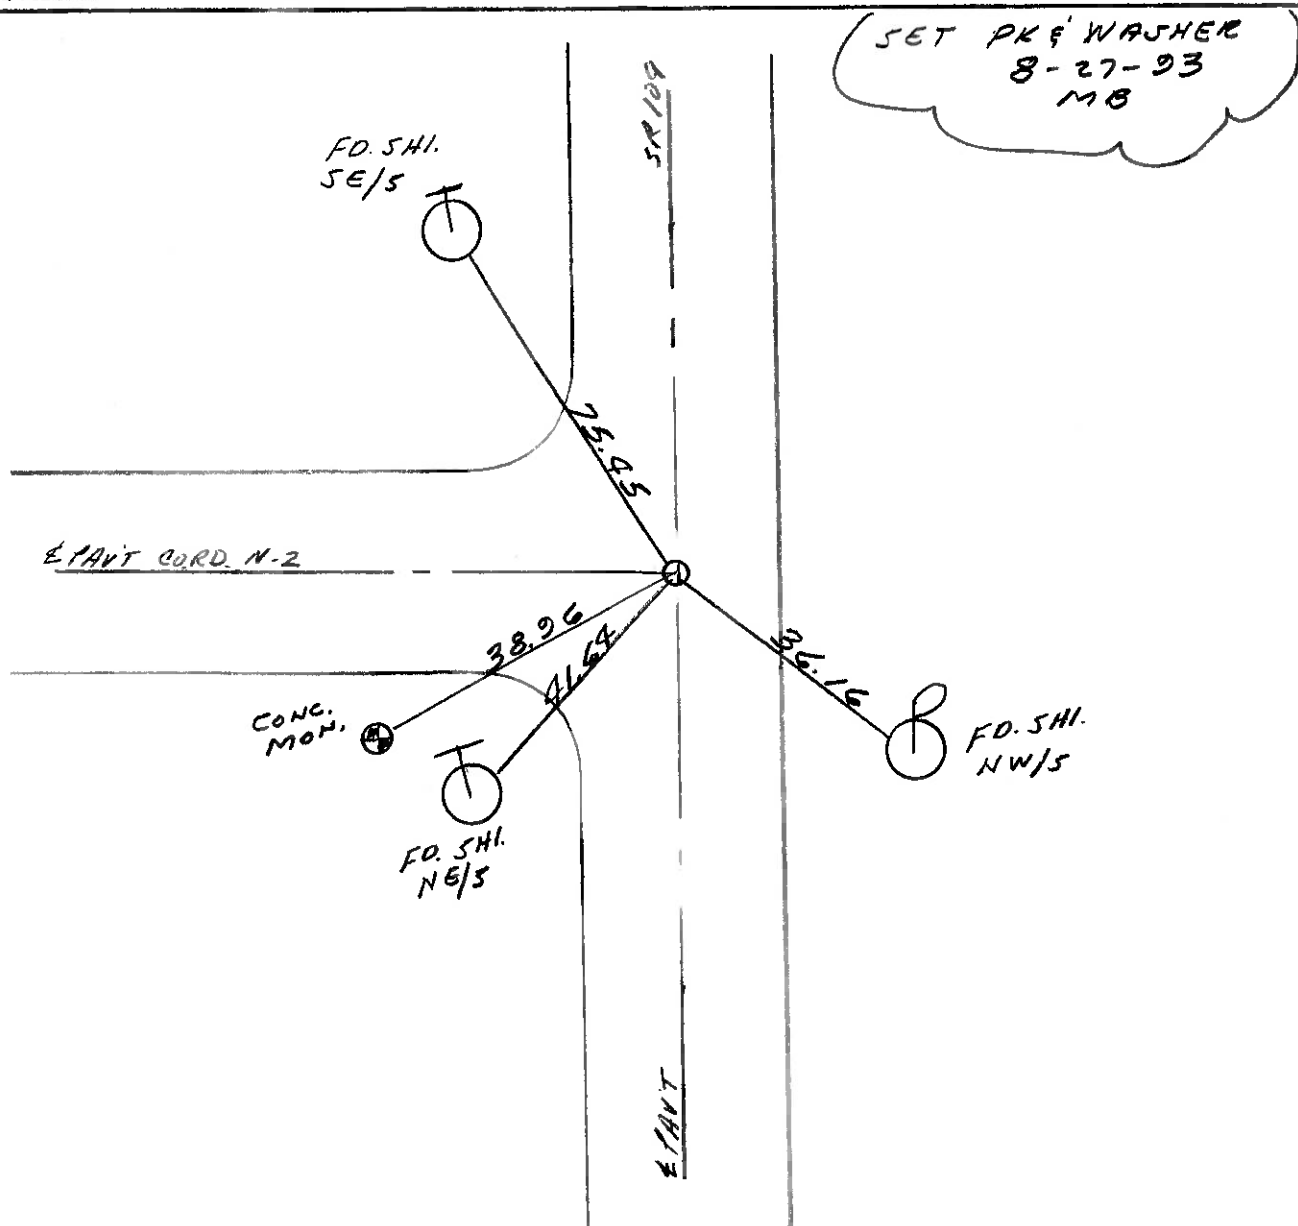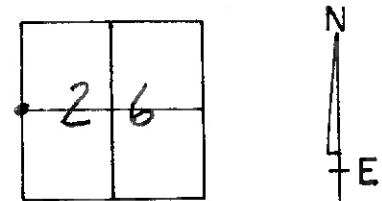

O.D.O.T. DISTRICT 2 SURVEY OFFICE

PERSONNEL

REFERENCE NO. 29

SHEET OF

NOTES Barnhiser

H.C. Hoffman

R.C. Loehrke

DATE 4-8-85

WEATHER cloudy

TEMP. +35°

ROUTE 109

COUNTY Henry

TOWNSHIP Harrison

SECTION 26

T 5 N R 7 E



TYPE MONUMENT Lg RR/SPK

ON SURFACE - BELOW ✓

LEFT-℄ PAV'T. - RIGHT 0.6

10. TO Rt EDGE PAVEMENT

S.L.M. 717+06

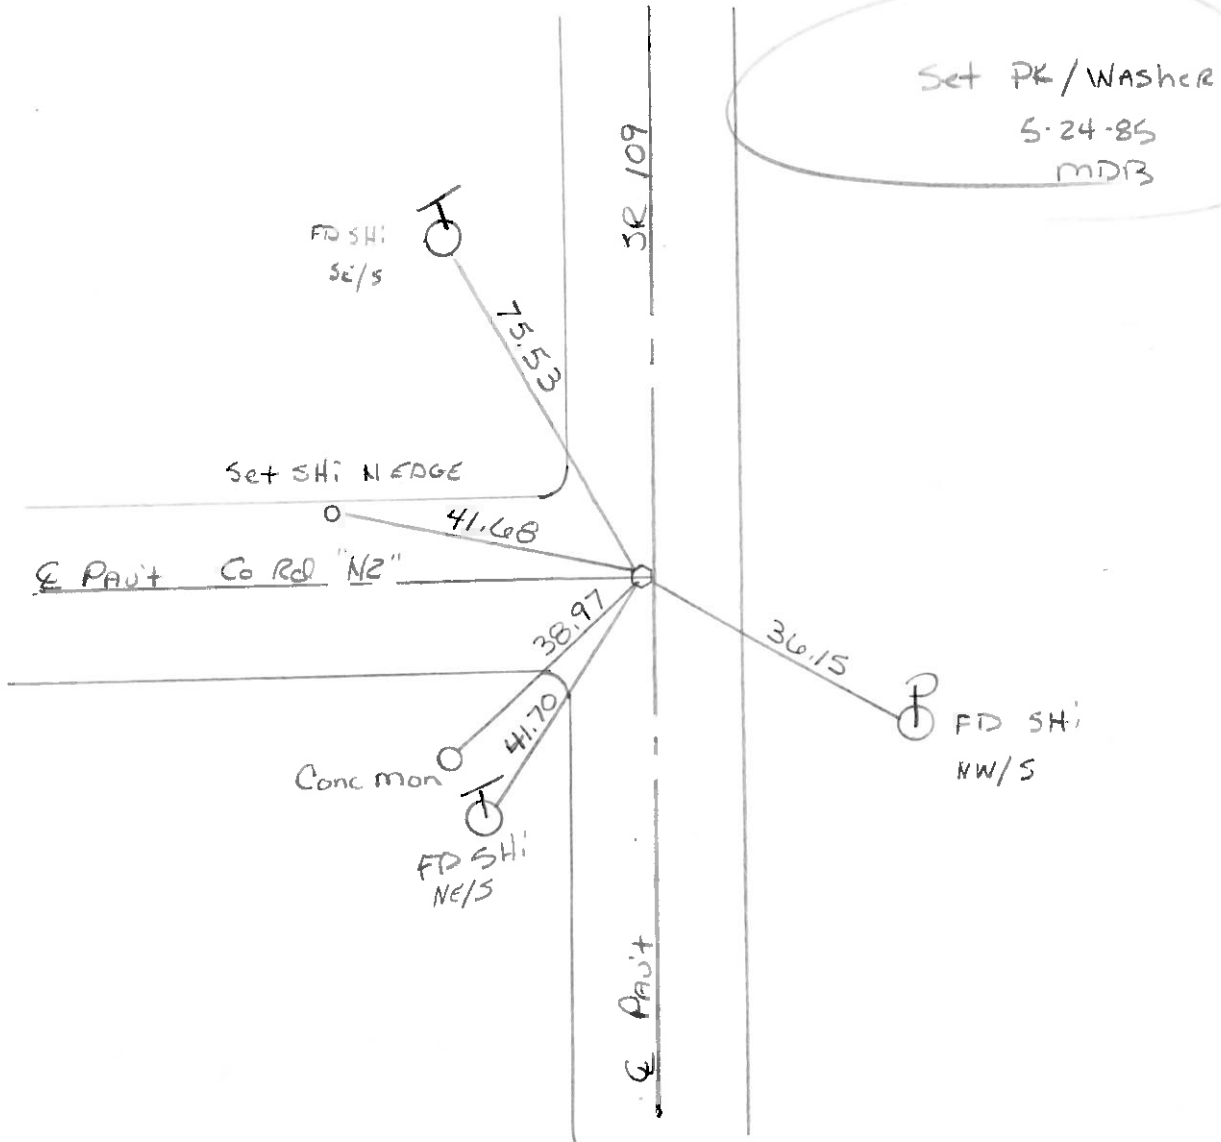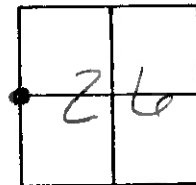

ODOT. DISTRICT 2 SURVEY OFFICE

SHEET _____ OF _____

County Henry S.R. 109

Township Harrison

Section 26

T5N, R7E

Personnel Hoffman

Loehrke


Householder

#29


Date 6-1-82

Weather cloudy

Temp. +72°

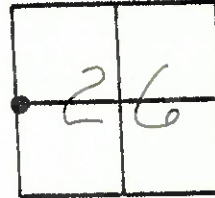

Fd. R.R. Spk 1" Below surface; set by County
0.6' West of & Post S R 109
on & Co. Rd "N-2"

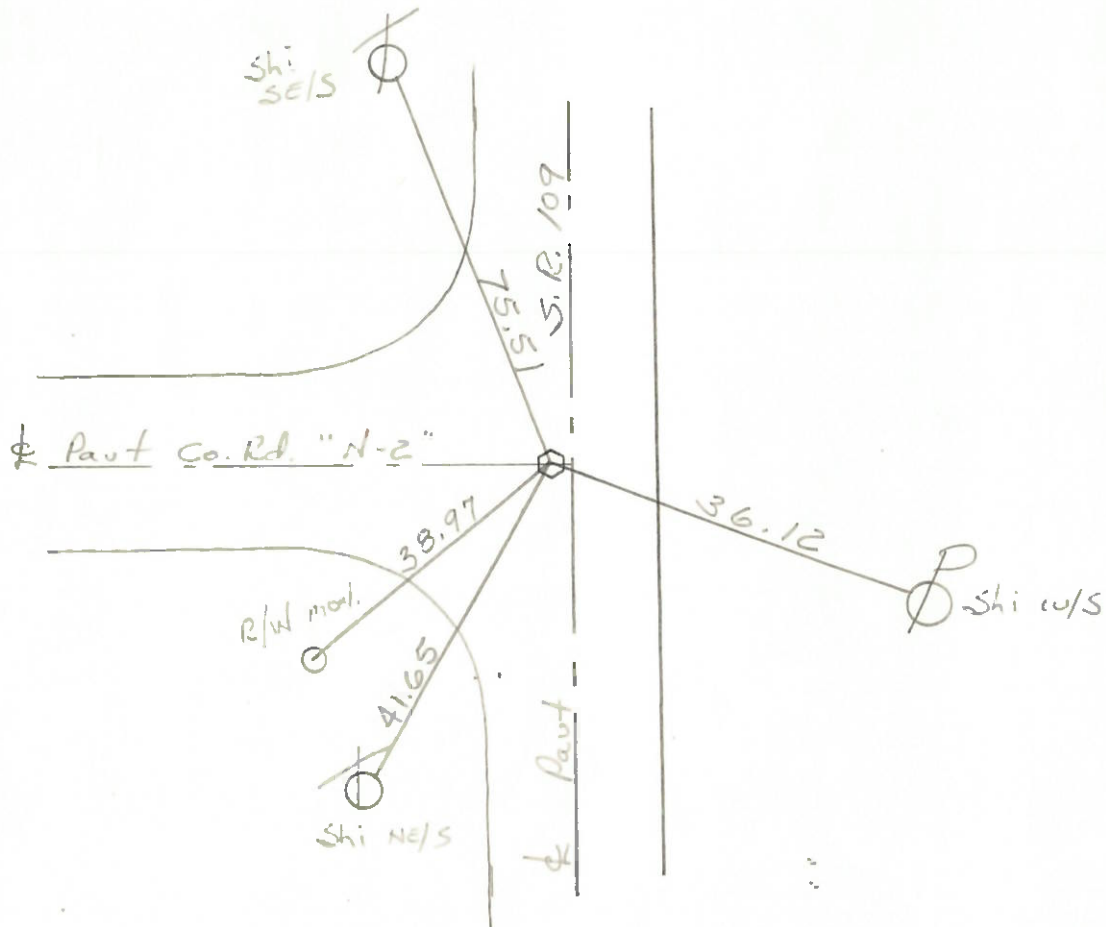

PERSONNEL	TITLE	PERSONNEL	TITLE
BURNSIDE			
SMITH			
BOWERS			
MEAD			

COUNTY HENRY DATE 9-17-76
S. R. 109 WEATHER CLOUDY
SEC. _____ TEMP. +65°

DESCRIPTION	LEFT	CENTER LINE	RIGHT	JOB NO.
REF. TO CONTROL POINTS				

LEFT

CENTER LINE

RIGHT

