

O.D.O.T. DISTRICT 2 SURVEY OFFICE (USE ONLY)

PERSONNEL

REFERENCE NO. 30

SHEET 18 OF 36

NOTES HOFFMAN

DATE 3-19-84

ROUTE SR 109

H.C. BARNHISEL

WEATHER OVERCAST

COUNTY HENRY

R.C. HOUSEHOLDER

TEMP. 30°F

TOWNSHIP HARRISON

LOEHRKE

SECTION 26

T 5 N R 7 E

TYPE MONUMENT PK NAIL


ON SURFACE - ~~BELOW~~ ON

LEFT - ℄ PAV'T - RIGHT ON


- TO - EDGE PAVEMENT

S.L.M. 743+95

Grid: Northing: - Easting: -

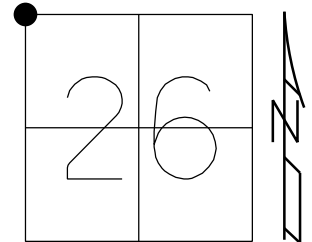

RECORD:
SET SM RR SPIKE
6-20-88 SWH
SET MAG/WASHER
4-21-03, DCH
FD MAG/WASHER
REF30
12/7/21, DSA

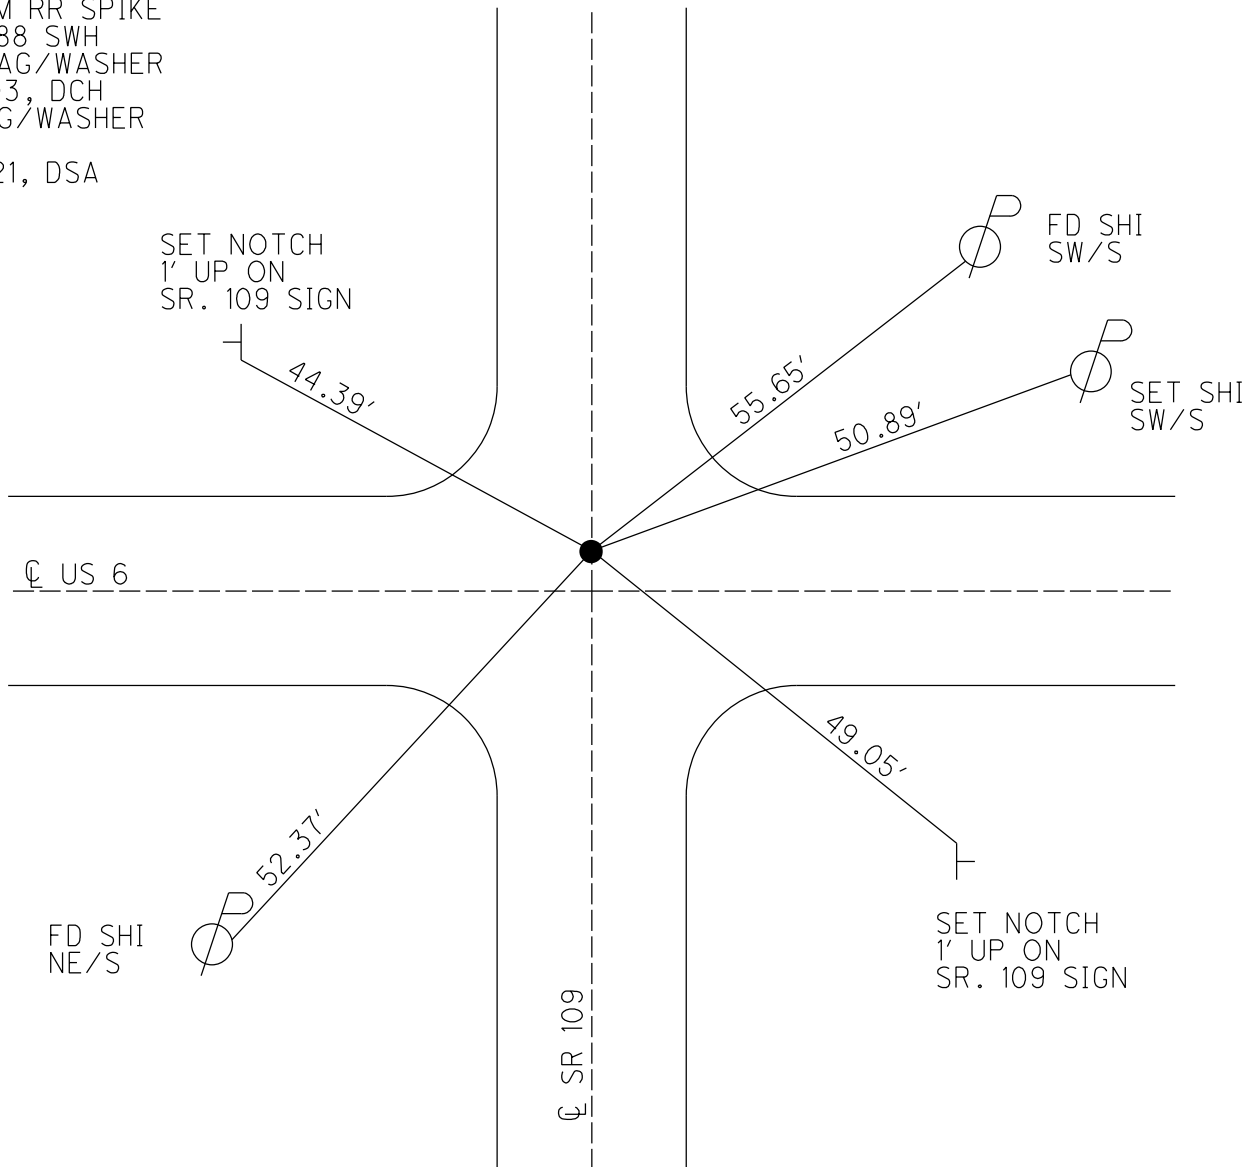

O.D.O.T. DISTRICT 2 SURVEY OFFICE (USE ONLY)

PERSONNEL

REFERENCE NO. 30

SHEET 18 OF 38


NOTES HOFFMAN
H.C. BARNHISEL
R.C. HOUSEHOLDER
LOEHRKE

DATE 3-19-84
WEATHER OVERCAST
TEMP. 30°F

ROUTE SR 109
COUNTY HENRY
TOWNSHIP HARRISON
SECTION 26
T 5 N R 7 E


TYPE MONUMENT PK NAIL
ON SURFACE - ~~BELOW~~ ON
LEFT - ℄ PAV'T - RIGHT ON
- TO - EDGE PAVEMENT
S.L.M. 743+95

Grid: Northing: - Easting: -

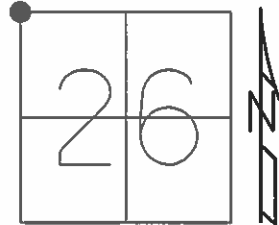

RECORD:
SET SM RR SPIKE
6-20-88 SWH

SET MAG/WASHER
4-21-03, DCH

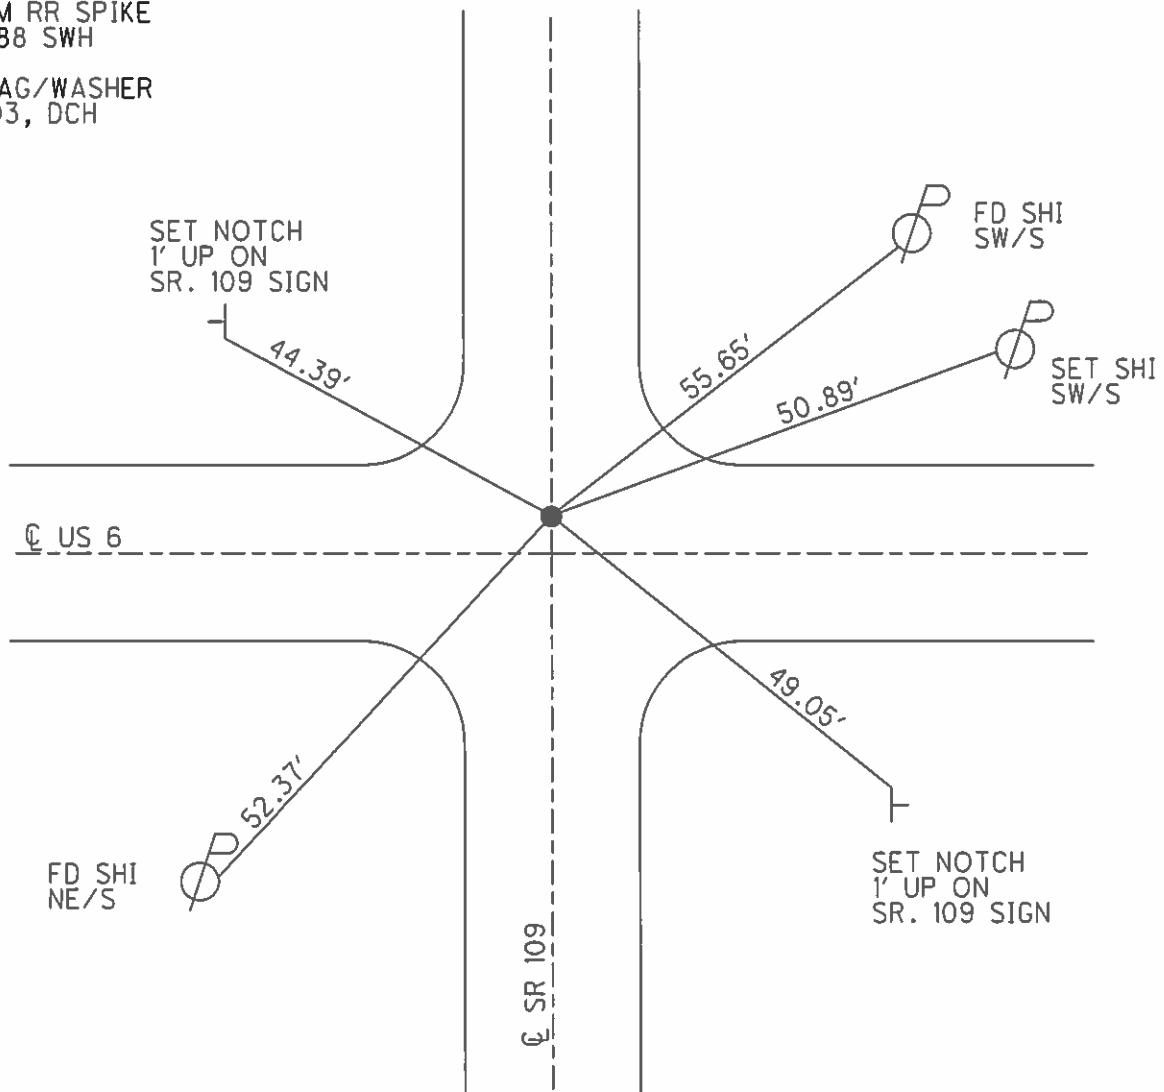

ODOT DISTRICT 2 SURVEY OFFICE

SHEET 16 OF 23

County HENRY S.R. 109 & U.S. 6

Township HARRISON

Section 26

TSN, R7E

Personnel HOFFMAN

Date 3-19-84

Weather OVERCAST

Temp. +30°


#30 - SR 109

LOSHAK

#45 - US 6

HOUSEHOLDER R.C.

BARNHART H.C.

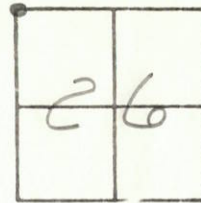


Fd P.K. Nail @ Surface

ON & PAUT SR 109

1.0' N. of & PAUT US 6

SR 109 SLM = 743 + 95

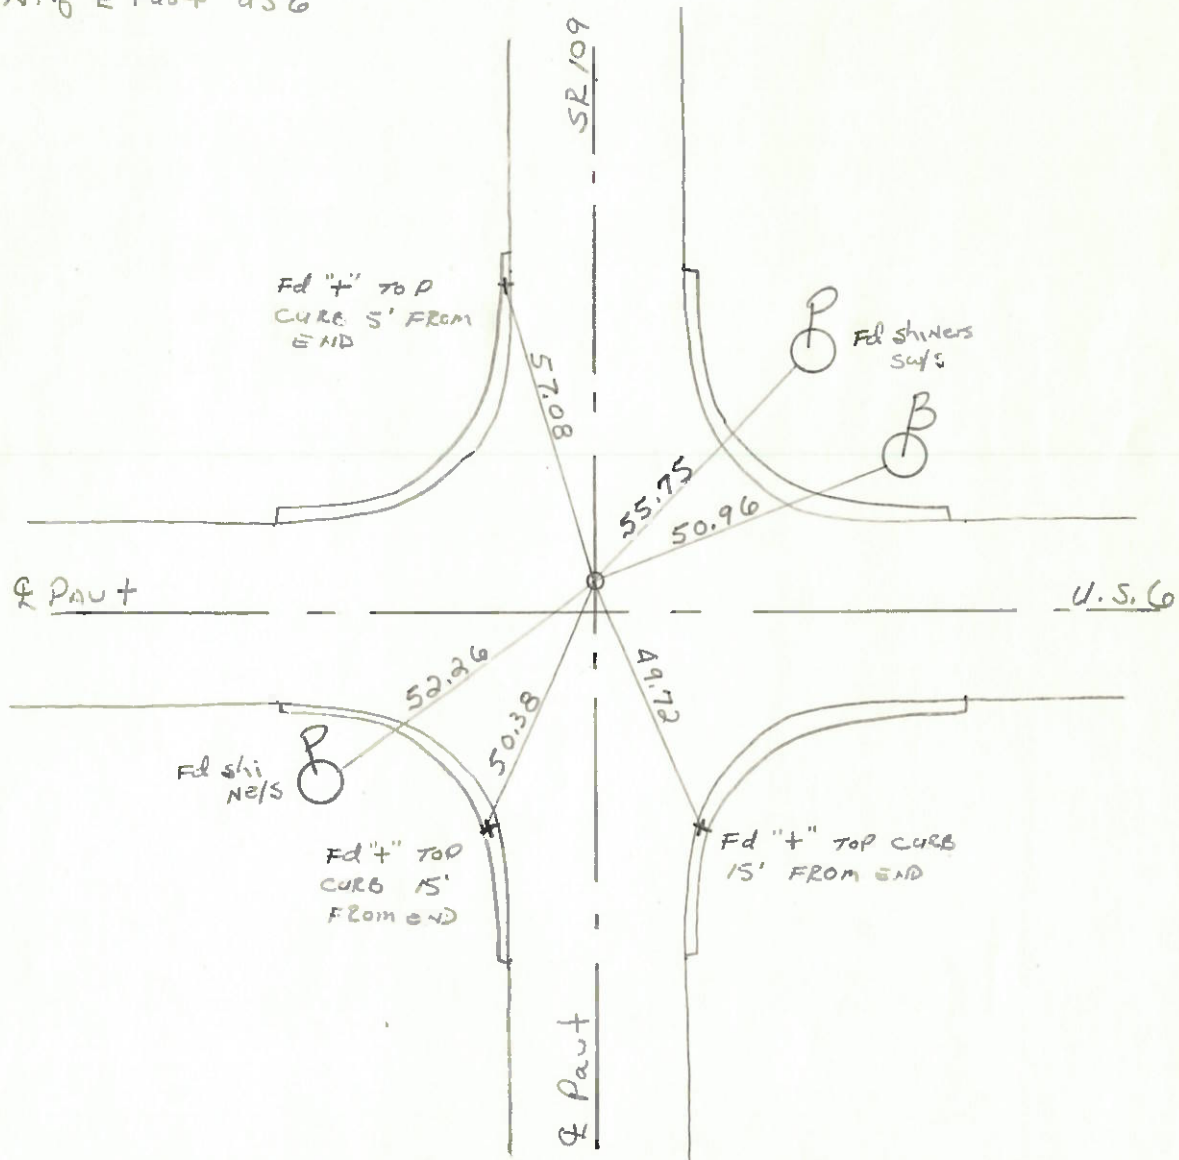

Q.D.O.T. DISTRICT 2 SURVEY OFFICE

SHEET _____ OF _____

County HENRY S.R. 109 E U.S. 6

Date 6-1-82

Township HARRISON


Weather cloudy

Section 26

Temp. +72°

T5N, R7E

Personnel HOFFMAN

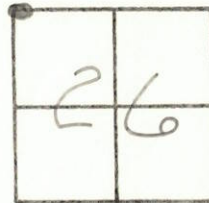

#45-U.S. 6

#30-S.R. 109

Fd. P.K. on surface

on & Pavt S.R. 109

1.0' North of & Pavt U.S. 6

