

O.D.O.T. DISTRICT 2 SURVEY OFFICE (USE ONLY)

PERSONNEL

REFERENCE NO. 30 A

SHEET 19 OF 36

NOTES RHOADES

DATE 9/3/15

ROUTE SR 109

H.C. O'DONNELL

WEATHER CLEAR

COUNTY HENRY

R.C. RHOADES

TEMP. 88°

TOWNSHIP HARRISON

DWG BY RHOADES

PID PAVTRAIN

SECTION 23

T 7 N R E

TYPE MONUMENT MAG/WASHER

ON SURFACE - ~~BELOW~~ ON

OFFSET Q PAVEMENT ON LT : RT

9.7' TO LT EDGE PAVEMENT


STATION: 757+16

HORZ.DATUM: NAD83 2011

GEOID: NAVD88 2018

GRID: NORTHING: 625899.104

EASTING: 1546338.985

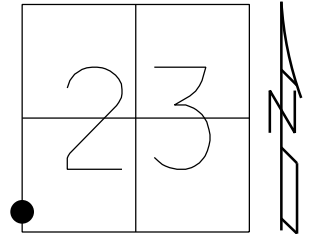

RECORD:
SET MAG/WASHER
10-29-04, D.H
FD MAG/WASHER
REFA30
9-1-15, JFO
8-3-16, JMR
FD MAG/WASHER
REFA30
6/16/21, TDN
10/5/21, JFO
FD MAG/WASHER
REFA30
12/7/21, DSA

FD SHI
SE/S

30.84'

37.58'

FD SHI
W/S

95.49'

103.29'

FD CUT NOTCH
1' UP E.POST
STOP AHEAD SIGN

FD SHI
N/S WITNESS
POST



O.D.O.T. DISTRICT 2 SURVEY OFFICE (USE ONLY)

PERSONNEL

REFERENCE NO. 30 A

SHEET 19 OF 39

NOTES RHOADES

DATE 9/3/15

ROUTE SR 109

H.C. O'DONNELL

WEATHER CLEAR

COUNTY HENRY

R.C. RHOADES

TEMP. 88°

TOWNSHIP HARRISON

SECTION 23

DWG BY RHOADES PID PAVTRAIN

T N R E

TYPE MONUMENT MAG/WASHER

ON SURFACE - ~~BELOW~~ ON

OFFSET Q PAVEMENT ON LT : RT

9.7' TO LT EDGE PAVEMENT


STATION: 757+16

HORZ.DATUM: NAD83 2011

GEOID: NAVD88 2018

GRID: NORTHING: 625899.104

EASTING: 1546338.985

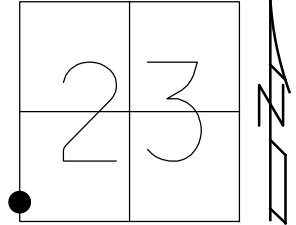

RECORD:
SET MAG/WASHER
10-29-04, D.H
FD MAG/WASHER
REFA30
9-1-15, JFO
8-3-16, JMR
FD MAG/WASHER
REFA30
6/16/21, TDN
10/5/21, JFO

FD SHI
SE/S

30.84'

37.58'

FD SHI
W/S

95.49'

103.29'

FD CUT NOTCH
1' UP E.POST
STOP AHEAD SIGN

FD SHI
N/S WITNESS
POST




O.D.O.T. DISTRICT 2 SURVEY OFFICE (USE ONLY)

PERSONNEL _____ REFERENCE NO. 30 A SHEET 19 OF 38
NOTES RHOADES DATE 9-3-16 ROUTE SR 109
H.C. O'DONNELL WEATHER CLEAR COUNTY HENRY
R.C. RHOADES TEMP. 88°F TOWNSHIP HARRISON
SECTION 23
T 5 N R 7 E

TYPE MONUMENT MAG/WASHER
ON SURFACE - ~~BELOW~~ ON
LEFT - ℄ PAV'T - RIGHT ON
9.7' TO LT EDGE PAVEMENT
S.L.M. 757+16

Grid: Northing: 625899.1166 Easting: 1546338.9579

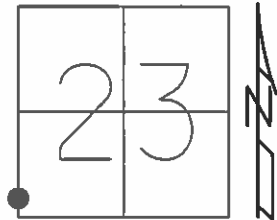


RECORD:
SET MAG/WASHER
10-29-04, D.H

FD MAG/WASHER
GPS, REFA30
9-1-15, JFO

UNCOVERED
8-3-16, JMR

FD CUT NOTCH
1' UP E.POST
STOP AHEAD SIGN

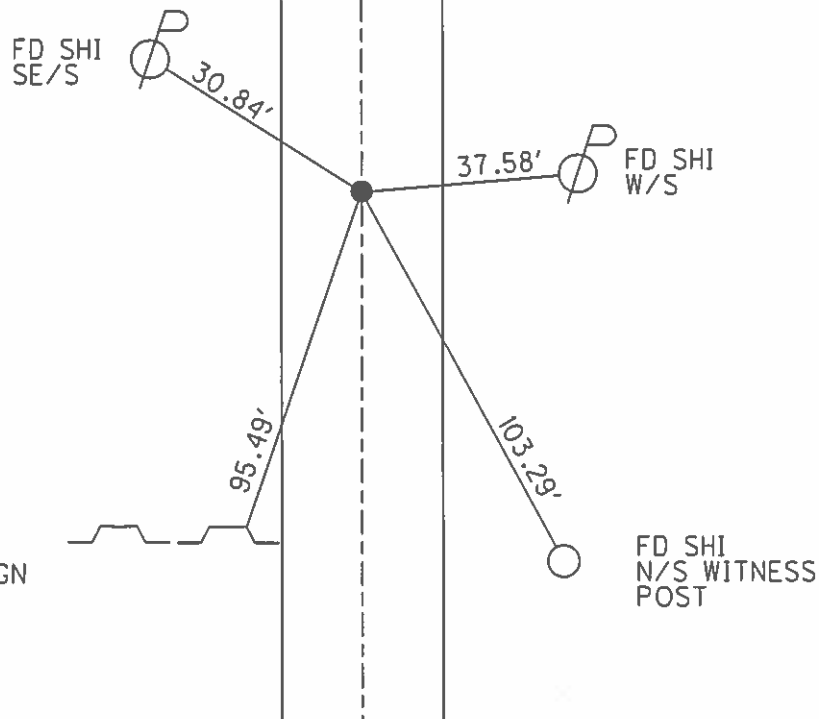

O.D.O.T. DISTRICT 2 SURVEY OFFICE

PERSONNEL

REFERENCE NO. 30-A

SHEET 17 OF 23

NOTES CORDES

H.C. BARNHISEL

R.C. HOOKE

DATE 8/27/04

WEATHER OVERCAST

TEMP. + 80°

ROUTE 109

COUNTY HENRY

TOWNSHIP HARRISON

SECTION 23

T5 N R 7 E

CANTERBURY - DRAWING


TYPE MONUMENT P.K. / WASHER

ON SURFACE - BELOW SURFACE


LEFT- & PAV'T. - RIGHT 0.5' LT &

9.7 TO LT. EDGE PAVEMENT

S.L.M. 757 + 16

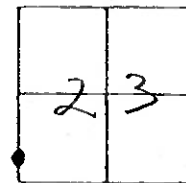

RESET MAG/WASHER
10/29/04
D.H.

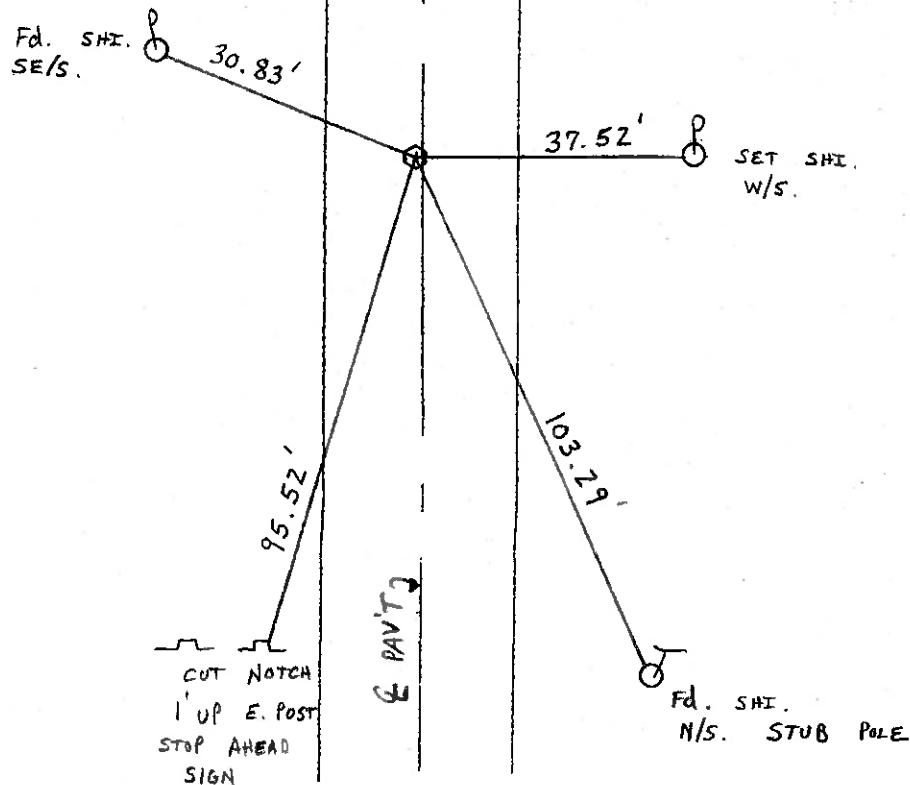

O.D.O.T. DISTRICT 2 SURVEY OFFICE

PERSONNEL _____

REFERENCE NO. _____

SHEET _____ OF _____

NOTES BARNHISEL

H.C. " "

R.C. HOFFMAN

DATE 9-25-90

WEATHER Clear - Windy

TEMP. +70°

ROUTE 109

COUNTY Henry

TOWNSHIP HARRISON

SECTION 23

T 5 N R 7 E


TYPE MONUMENT P.K. NAIL & Washer

ON SURFACE - BELOW YES


~~LEFT~~ - PAV'T. - RIGHT YES

9.9 TO LT EDGE PAVEMENT

S.L.M. 757+16

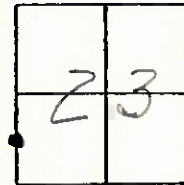

Set P.K. & Washer
10-4-90
MB

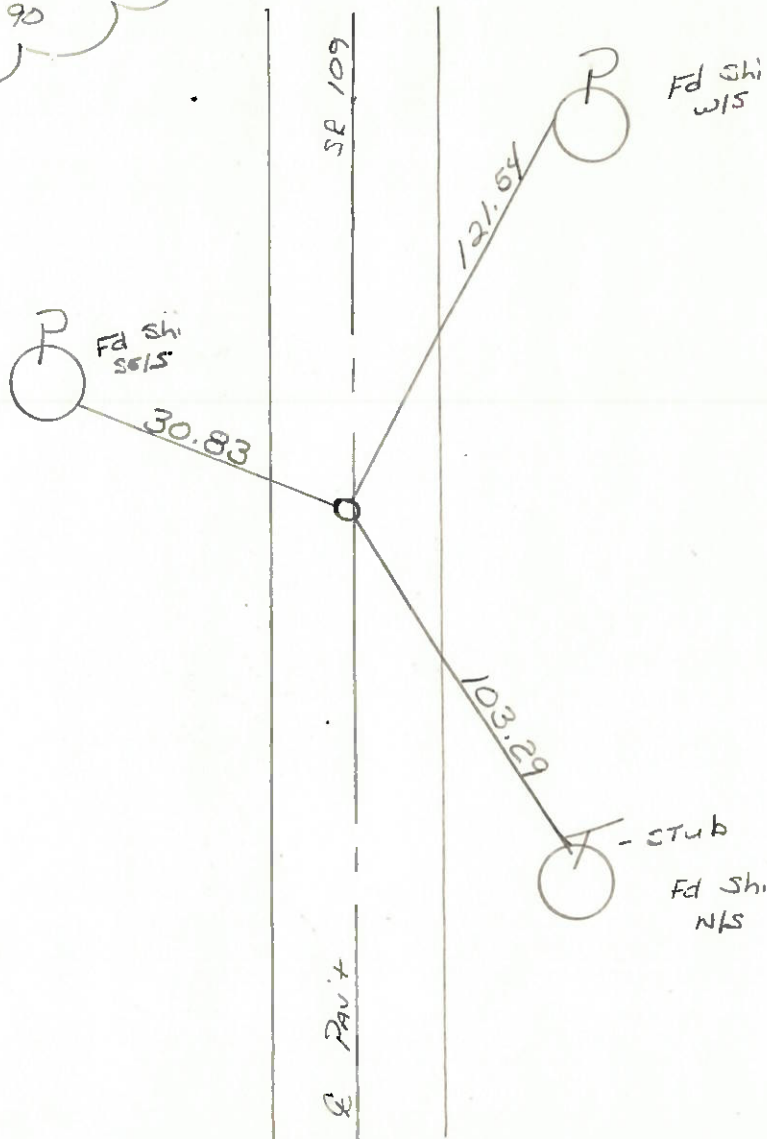

ODOT DISTRICT 2 SURVEY OFFICE

SHEET _____ OF _____

County HENRY S.R. 109

Township HARRISON

Section 23

T5N, R7E

Personnel HOFFMAN

LOEHRS


HOUSEHOLDER R.C.

BARNHISEL H.C.

Date 3-19-84

Weather OVERCAST


Temp. +30

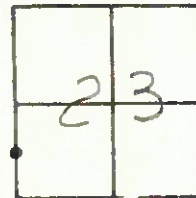

Fd R.P. spk 1" below surface
on & put
8.9' to Lt. EP
9.2' to Rt. EP

SLM 757 +18

SET PK/WASHER
8-23-84
SWH

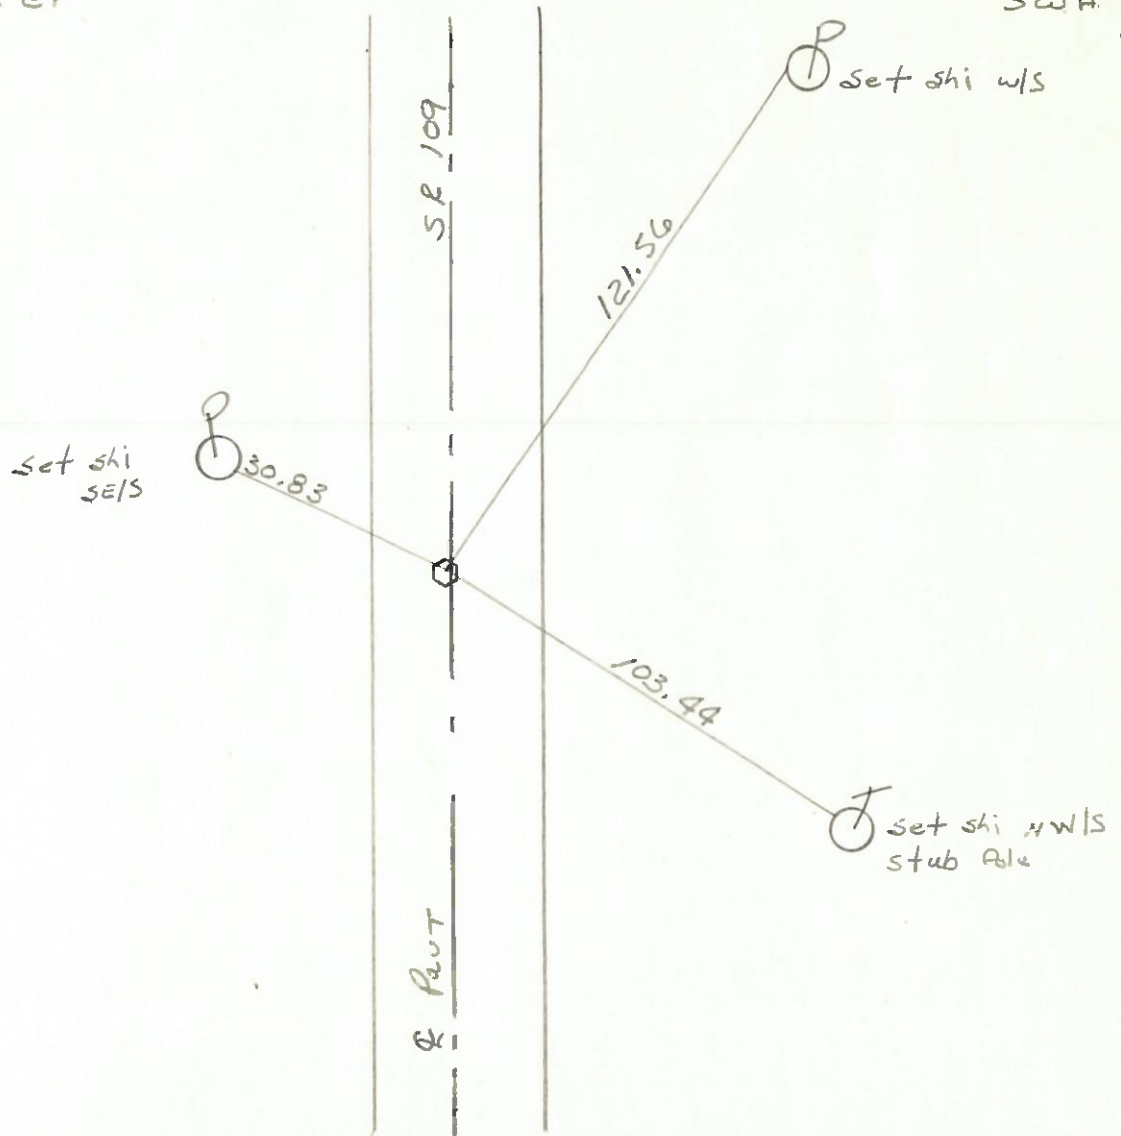

QDOT DISTRICT 2 SURVEY OFFICE

SHEET _____ OF _____

County HENRY S.R. 109

Date 3-19-84

Township HARRISON

Weather OVERCAST

Section 23

Temp. +30


T5N, R7E

Personnel HOFFMAN

LOEHKE

HOUSEHOLDER R.C.

BARNHISEL H.C.

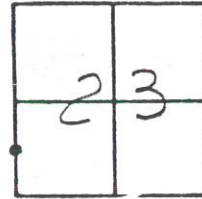

P.K. NAIL
Fd R.B. SPK 1" below surface

SLM 757 +18 16

on & put ✓

9.9 8.9' to Lt. EP

9.2 7.2' to Rt. EP

SET PK/WASHER

8-23-84

SWH

Set shi
SE/S

30.83

SP 109

& put

54
121.56

27.55

T-Hub

103.44
39

Set shi w/s

Set shi NW/S
Stub Ale