

O.D.O.T. DISTRICT 2 SURVEY OFFICE (USE ONLY)

PERSONNEL

REFERENCE NO. 32

SHEET 22 OF 39

NOTES RHOADES

DATE 9/3/15

ROUTE SR 109

H.C. O'DONNELL

WEATHER CLEAR

COUNTY HENRY

R.C. RHOADES

TEMP. 88°

TOWNSHIP HARRISON

DWG BY RHOADES PID PAVTRAIN

SECTION 23

T 5 N R 7 E

TYPE MONUMENT MAG/WASHER

ON SURFACE - ~~BELOW~~ ON

OFFSET 6' Q PAVEMENT LT : ~~RT~~

- TO - EDGE PAVEMENT


STATION: 796+79

HORZ.DATUM: NAD83 2011

GEOID: NAVD88 2018

GRID: NORTHING: 629863.161

EASTING: 1546421.292

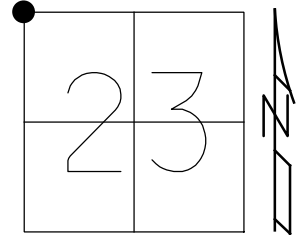

SHARON
METHODIST
CHURCH SIGN

TOP OF 4TH
BRICK UP
SOUTH COR. OF
CHURCH SIGN

69.45'

RECORD:
SET MAG/WASHER
10-29-04, DH
FD MAG SHANK
REF32
9-1-15, JFO
8-3-16, JMR
FD MAG/WASHER
REF32
6/16/21, TDN
10/5/21, JFO

Q CR P

34.87'

FD DUPLEX
SE/S

39.29'

FD
SHI


Q SR 109

O.D.O.T. DISTRICT 2 SURVEY OFFICE (USE ONLY)

PERSONNEL _____ REFERENCE NO. 32 SHEET 22 OF 38

NOTES RHOADES DATE 9-3-15 ROUTE SR 109
H.C. O'DONNELL WEATHER CLEAR COUNTY HENRY
R.C. RHOADES TEMP. 88°F TOWNSHIP HARRISON
SECTION 23
T 5 N R 7 E

TYPE MONUMENT MAG/WASHER
ON SURFACE - ~~BELOW~~ ON _____
LEFT - Q PAV'T - ~~RIGHT~~ 6.0'
- TO - EDGE PAVEMENT
S.L.M. 796+79

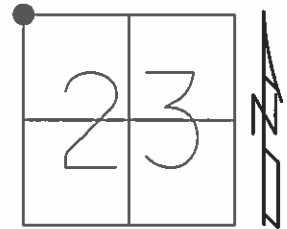


Grid: Northing: 629863.1833 Easting: 1546421.3330

RECORD:
SET MAG/WASHER
10-29-04, DH

FD SHANK
GPS, REF32
9-1-15, JFO

NOT COVERED
8-3-16, JMR

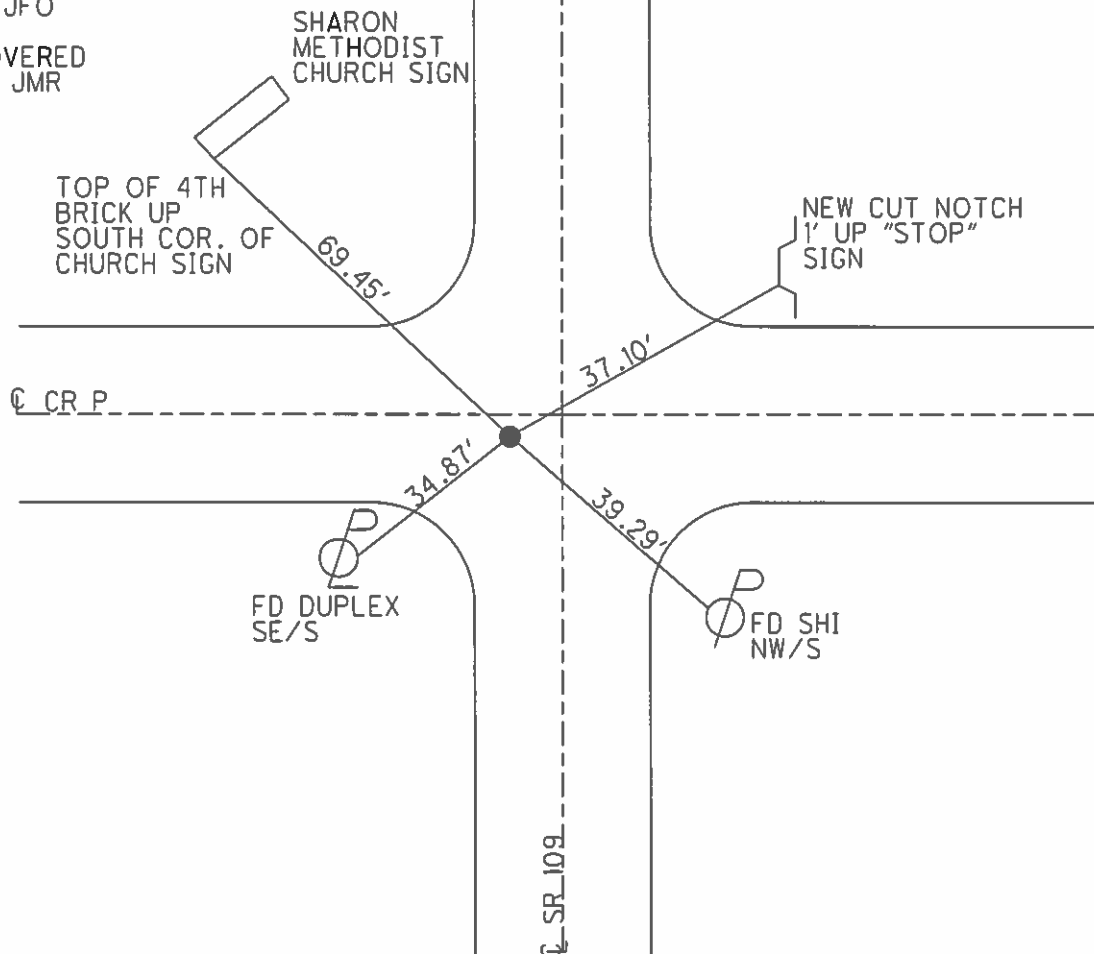

O.D.O.T. DISTRICT 2 SURVEY OFFICE

PERSONNEL

NOTES CORDES
H.C. BARNHISEL
R.C. HOOVER
MC - DRAWING


REFERENCE NO. 32

SHEET 20 OF 23

DATE 8/27/04
WEATHER OVERCAST
TEMP. + 80°

ROUTE 109
COUNTY HENRY
TOWNSHIP HARRISON
SECTION 23
T5 N R 7 E

TYPE MONUMENT P.K. / WASHER
ON SURFACE - BELOW SURFACE
LEFT - PAV'T. - RIGHT 6.0' LT &
TO EDGE PAVEMENT
S.L.M. 796 + 79

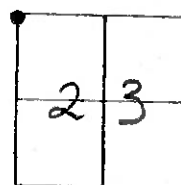

RESET MAG/WASHER
10-29-04
D.H.

4TH BRICK
UP SOUTH
COR. OF CHURCH
SIGN

SHARON HOUSTON
CHURCH

69.50'

S.R. 109

CUT NOTCH 1' UP
STOP SIGN POST

E PAV'T.

Co Rd "P"

36.30'

37.10'

39.27'

Fd. SHI.
NE/S.

Fd. SHI.
NW/S.

E PAV'T.

O.D.O.T. DISTRICT 2 SURVEY OFFICE

PERSONNEL

REFERENCE NO. 32

SHEET OF

NOTES BARNHISEL

H.C.

R.C. HOFFMAN

DATE 9-25-90

WEATHER clear - windy

TEMP. +70°

ROUTE 109

COUNTY HENRY

TOWNSHIP HARRISON

SECTION 23

T 5 N R 7 E



TYPE MONUMENT PK NAIL & Washer

ON SURFACE - BELOW YES

LEFT - & PAV'T. - RIGHT 5.5

- TO - EDGE PAVEMENT 2.8 S. OF & PAVT Co. Rd

S.L.M. 796 + 79

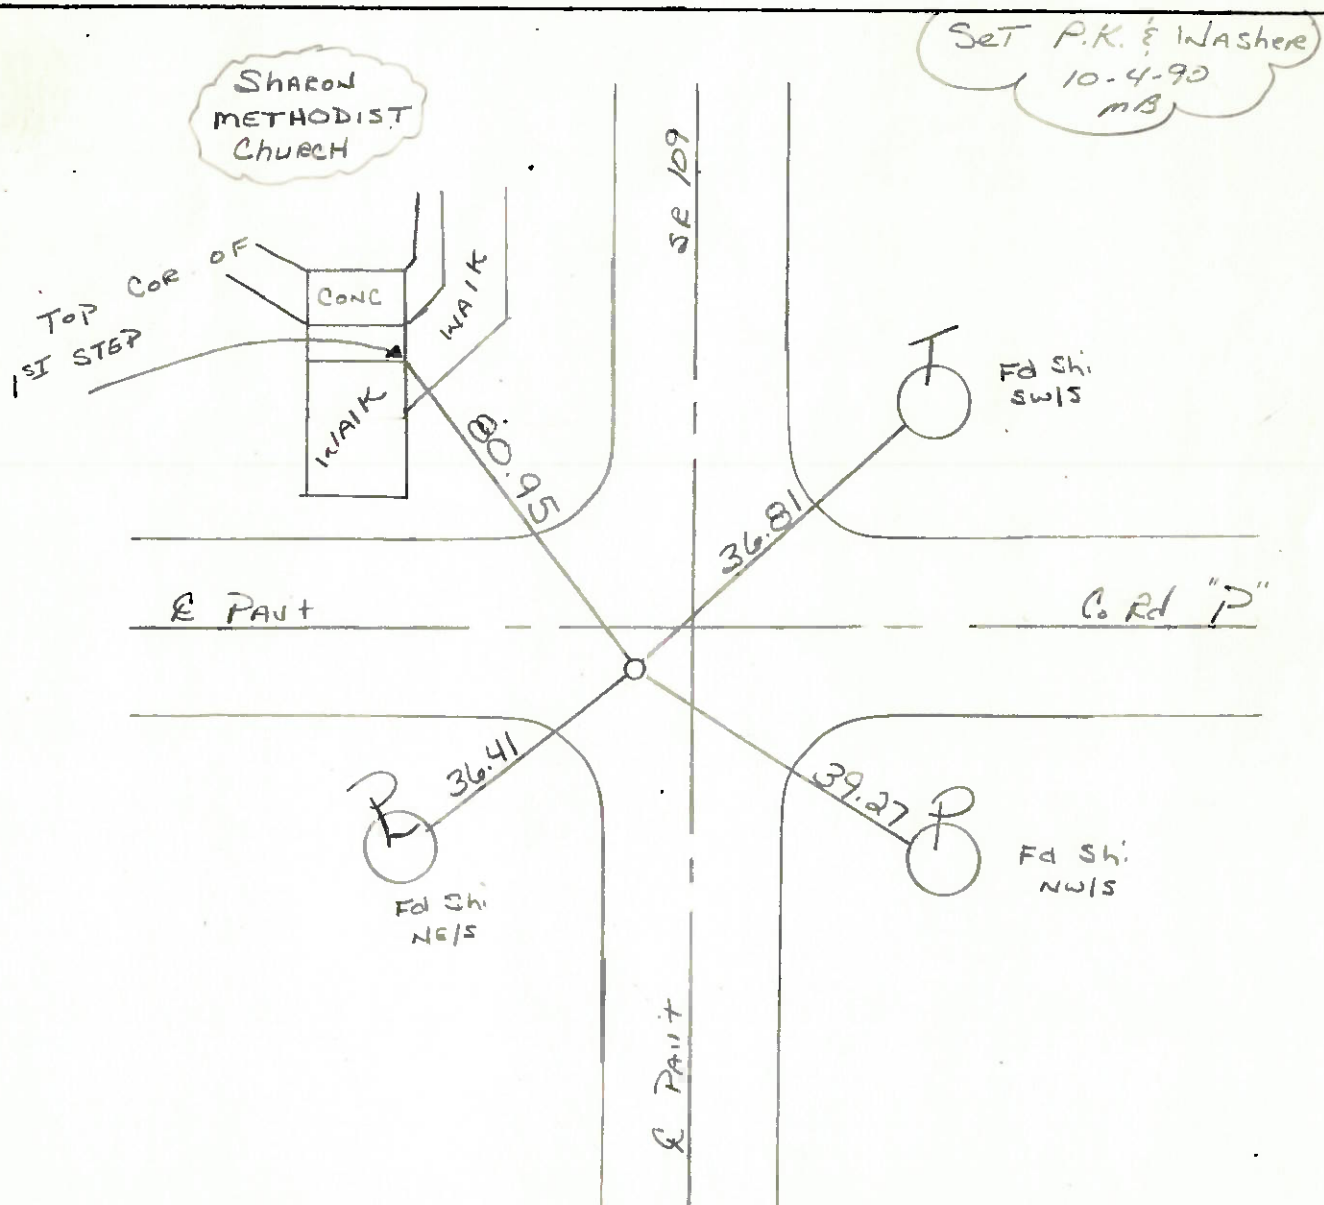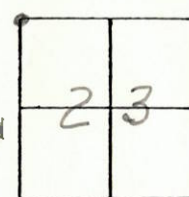


County HENRY S.R. 109Township HARRISONSection 23

T5N, R1E

Personnel HOFFMANLOSHREEHOUSEHOLDER R.C.BARNHISEL H.C.Date 3-19-84Weather OVERCASTTemp. +30°

#32

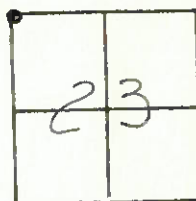

Fd R.R. SPR / CTR PUNCH @ SURFACE

SLM 796 + 84

6.0' LT. of & PAUT SR 109

2.8' SOUTH of & PAUT Co. Rd. "P"

SET PK/WASHER

B-23-84

S.W.H.

SHALON.
METHODIST
CHURCH

USE SE/COR STEP

1/2 WAY DOWN

80.96

SR 109

& PAUT

Co. Rd "P"

36.82

39.28

P 36.51

Set shi NW/S

P

Set shi NW/S

& PAUT

Date 3-19-84

Weather OVERCAST

Temp. +30°

T5N, R7E


Personnel HOFFMAN

$$L_0 \in H R K \in$$

Householder R.C.

BARNHISEL H.C.

#32

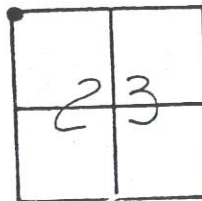

Fd R.R. SPR / CTR PUNCH @ SURFACE

SLM $796 + 84$


5.5
~~6.0~~ LT. of ♀ PAUT SR109

SET PR/WASHER

2.8' south of the Pawt Co. Rd. "P"


8-23-84

S.W.H.

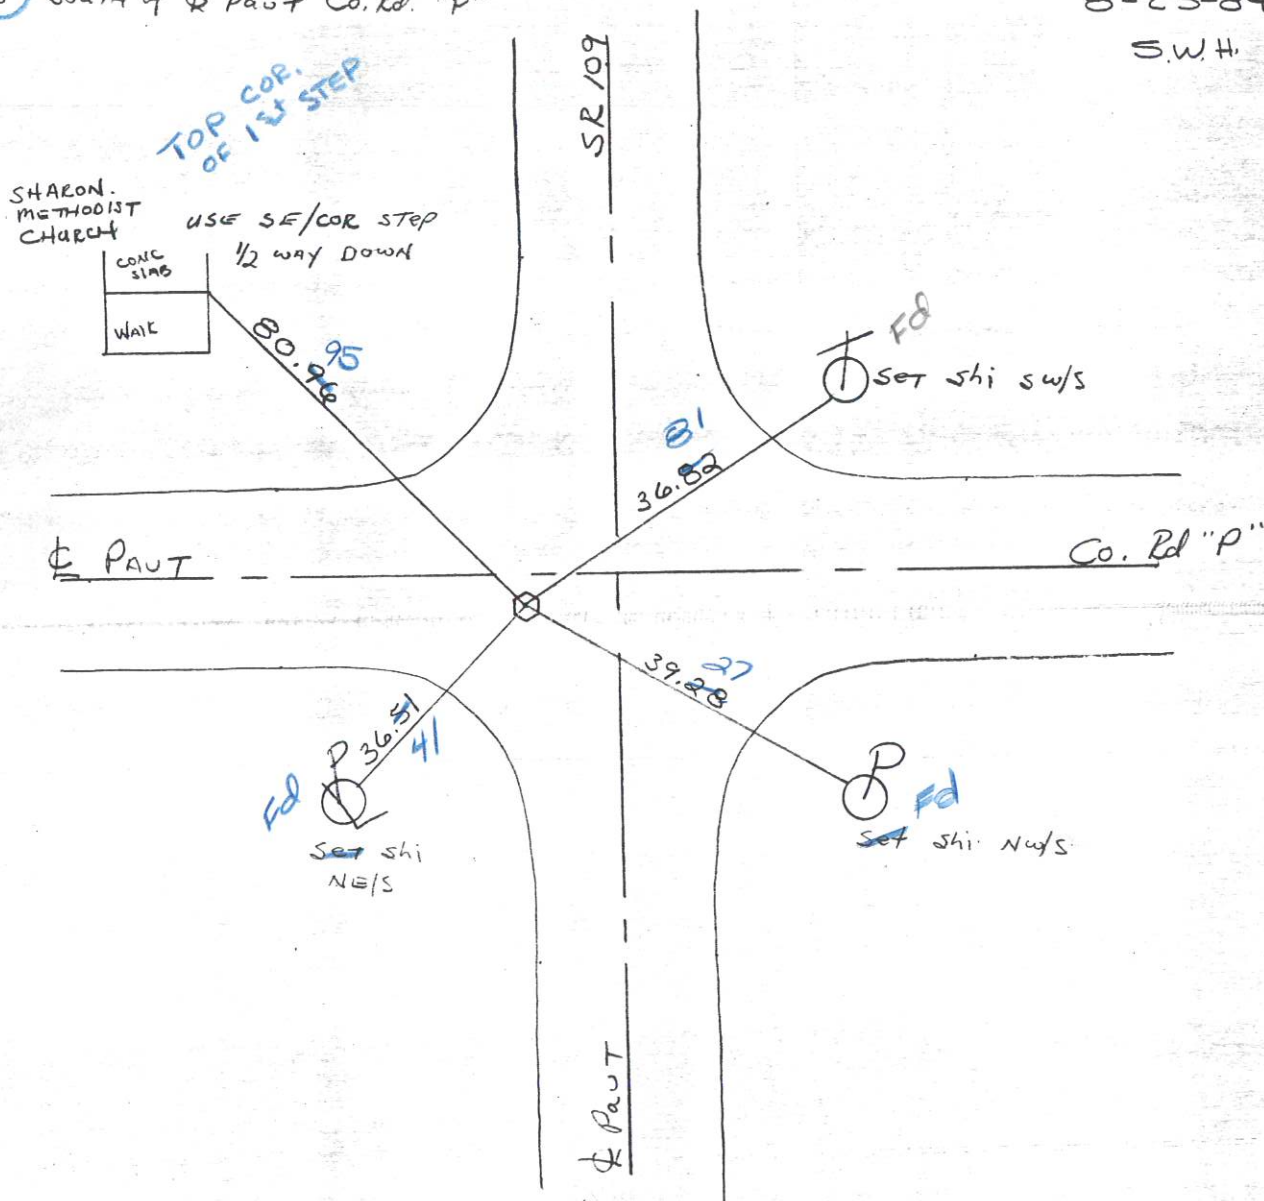

23 HARRISON TOWNSHIP

Section 23 Town N. Range E.

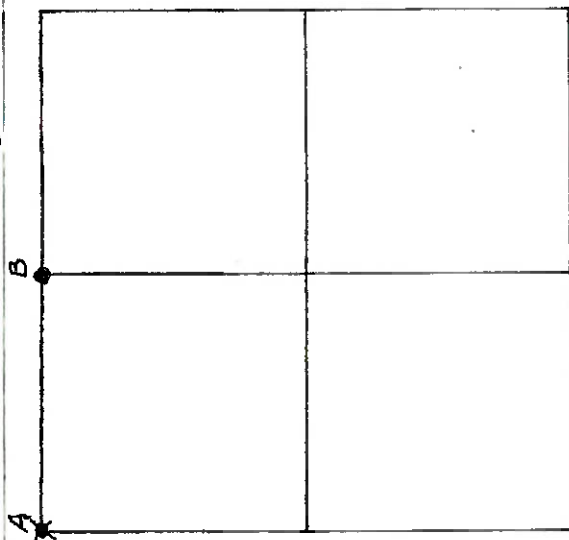

A { Sept. 1973 Paul Westhoven
 Found stone - placed I. Pin. Top over stone
 69.85 NE to SW cor. Grange Bldg. (Wood cor.)
 76.46 NW to SE cor. 10" Conc. Sidewalk.
 80.57 SW to Spt. 1, 5 D
 55.5 W of E. Pavement
 6.0' N & E to P.K.'s in Fave

B
 {
 Sept. 1973 Paul Westhoven & H. H. Hering
 Found Iron Pipe Survey Vol. 1, Page 579
 Placed Iron Pin inside pipe
 4500 N/E to P.K. S/E 1/8
 2834 N/E to P.K. S/E 1/8
 24.87 N/E to "X" w/drill hole on ctr. Hdwl.
 19.53 SE to "X" w/drill hole on ctr. Hdwl.
 2.0' to Nails S & W SW