

O.D.O.T. DISTRICT 2 SURVEY OFFICE (USE ONLY)

PERSONNEL

REFERENCE NO. 33

SHEET 23 OF 39

NOTES CORDES

DATE 8/27/04

ROUTE SR 109

H.C. BARNHISEL

WEATHER OVERCAST

COUNTY HENRY

R.C. HOOKE

TEMP. 80°

TOWNSHIP HARRISON

SECTION 14

DWG BY RHOADES

PID PAVTRAIN

T 5 N R 7 E

TYPE MONUMENT MONBOX W/1" IPIN

ON SURFACE - ~~BELOW~~ ON

OFFSET Q PAVEMENT 8' LT : ~~RT~~

2.8' TO LT EDGE PAVEMENT


STATION: 823+36

HORZ.DATUM: NAD83 2011


GEOID: NAVD88 2018

GRID: NORTHING: 632521.639

EASTING: 1546479.074

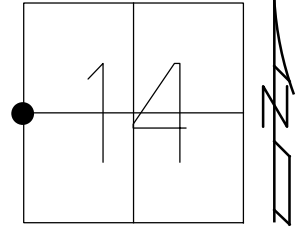


RECORD:
FD MON BOX
REF33
9-1-15, JFO
8-3-16, JMR
FD MONBOX
SHOT TOP
REF33
6/16/21, JMR
10/5/21, JFO

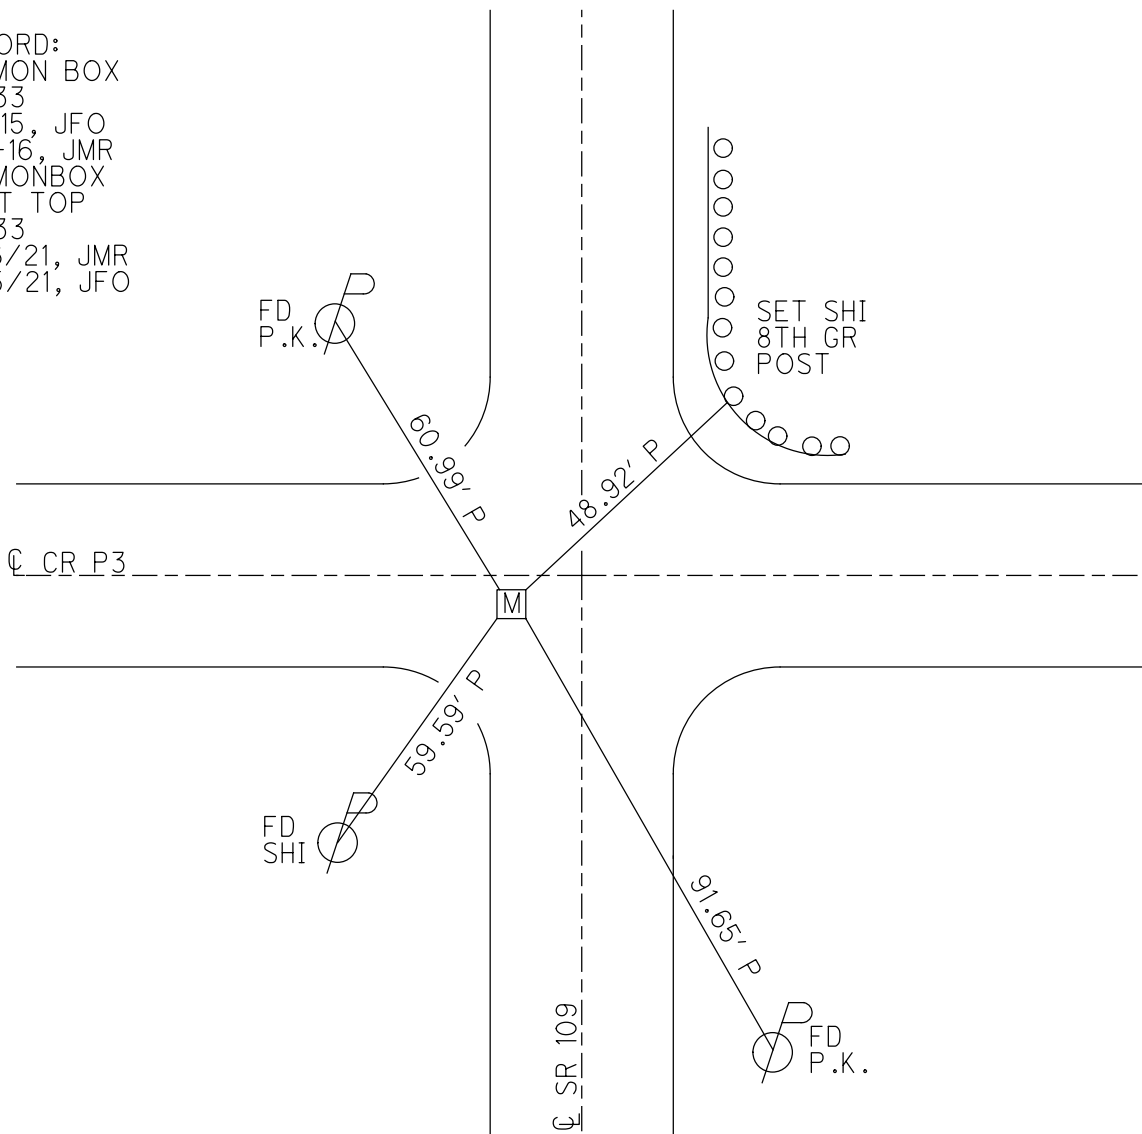

O.D.O.T. DISTRICT 2 SURVEY OFFICE (USE ONLY)

PERSONNEL _____ REFERENCE NO. 33 SHEET 23 OF 38
NOTES CORDES DATE 8-27-04 ROUTE SR 109
H.C. BARNHISEL WEATHER OVERCAST COUNTY HENRY
R.C. HOOKE TEMP. 80°F TOWNSHIP HARRISON
SECTION 14
T 5 N R 7 E


TYPE MONUMENT MON BOX W/ 1 PIN
ON SURFACE - ~~BELOW~~ ON _____
LEFT - ℄ PAV'T - ~~RIGHT~~ 8.0'
2.8' TO LT EDGE PAVEMENT
S.L.M. 823+36

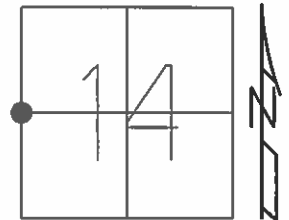

Grid: Northing: 632521.6532 Easting: 1546479.0929

RECORD:
FD MON BOX
GPS, MONREF33
9-1-15, JFO

NOT COVERED
POOR CONDITION
8-3-16, JMR

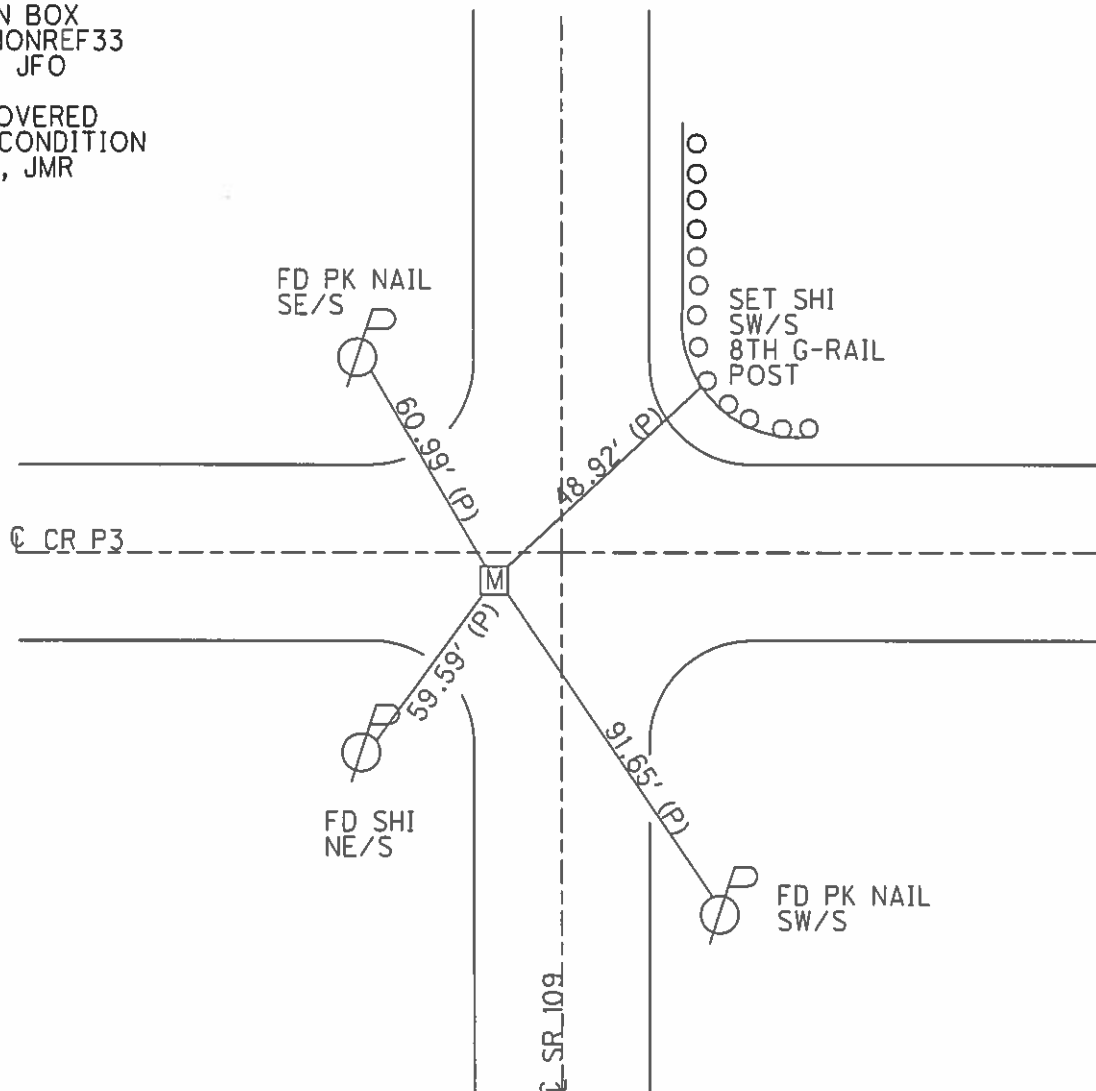

O.D.O.T. DISTRICT 2 SURVEY OFFICE

PERSONNEL

REFERENCE NO. 33

SHEET 21 OF 23

NOTES CORDES

H.C. BARNHISEL

R.C. HOOKE

DATE 8-27-04

WEATHER OVERCAST

TEMP. + 80°

ROUTE 109

COUNTY HENRY

TOWNSHIP HARRISON

SECTION 14

T 5 N R 7 E



TYPE MONUMENT Mon Box / I Pin

ON SURFACE - BELOW SURFACE

LEFT - ¢ PAV'T. - RIGHT 8.0' LT 2

2.8 TO LT. EDGE PAVEMENT 1.5' S. OF CO. RD "P-3"

S.L.M. 823+36

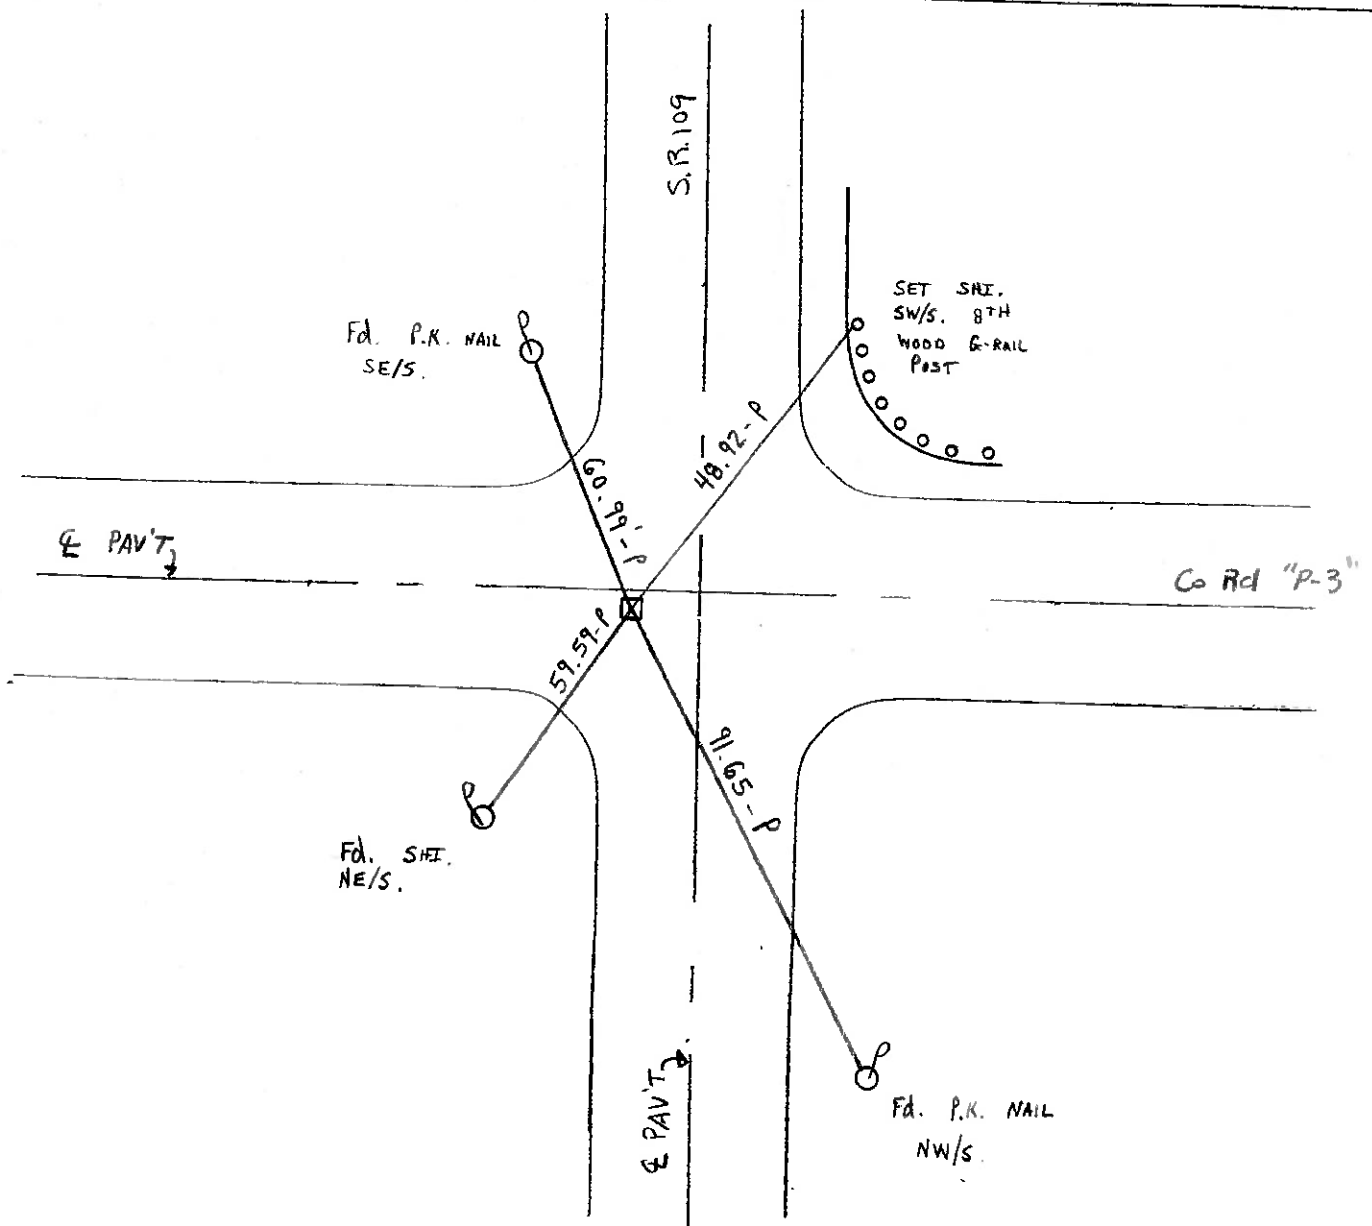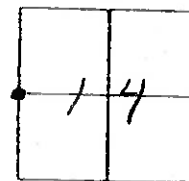

O.D.O.T. DISTRICT 2 SURVEY OFFICE

PERSONNEL

REFERENCE NO. 33

SHEET OF

NOTES BARNHISEL

H.C. " "

R.C. HOFFMAN

DATE 9-25-90

WEATHER clear - WINDY

TEMP. +70°

ROUTE 109

COUNTY HENRI

TOWNSHIP HARRISON

SECTION 14

T. 5 N R. 7 E


TYPE MONUMENT mon. Box

ON SURFACE - BELOW yes


LEFT - ℄ PAV'T. - RIGHT 7.2

— TO — EDGE PAVEMENT 1.5 S. OF ℄ Co. Rd "P-3"

S.L.M. 823+36

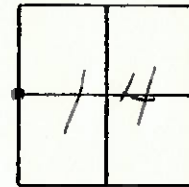

NOTE: Did not open Box,
measured to ctr of lid.

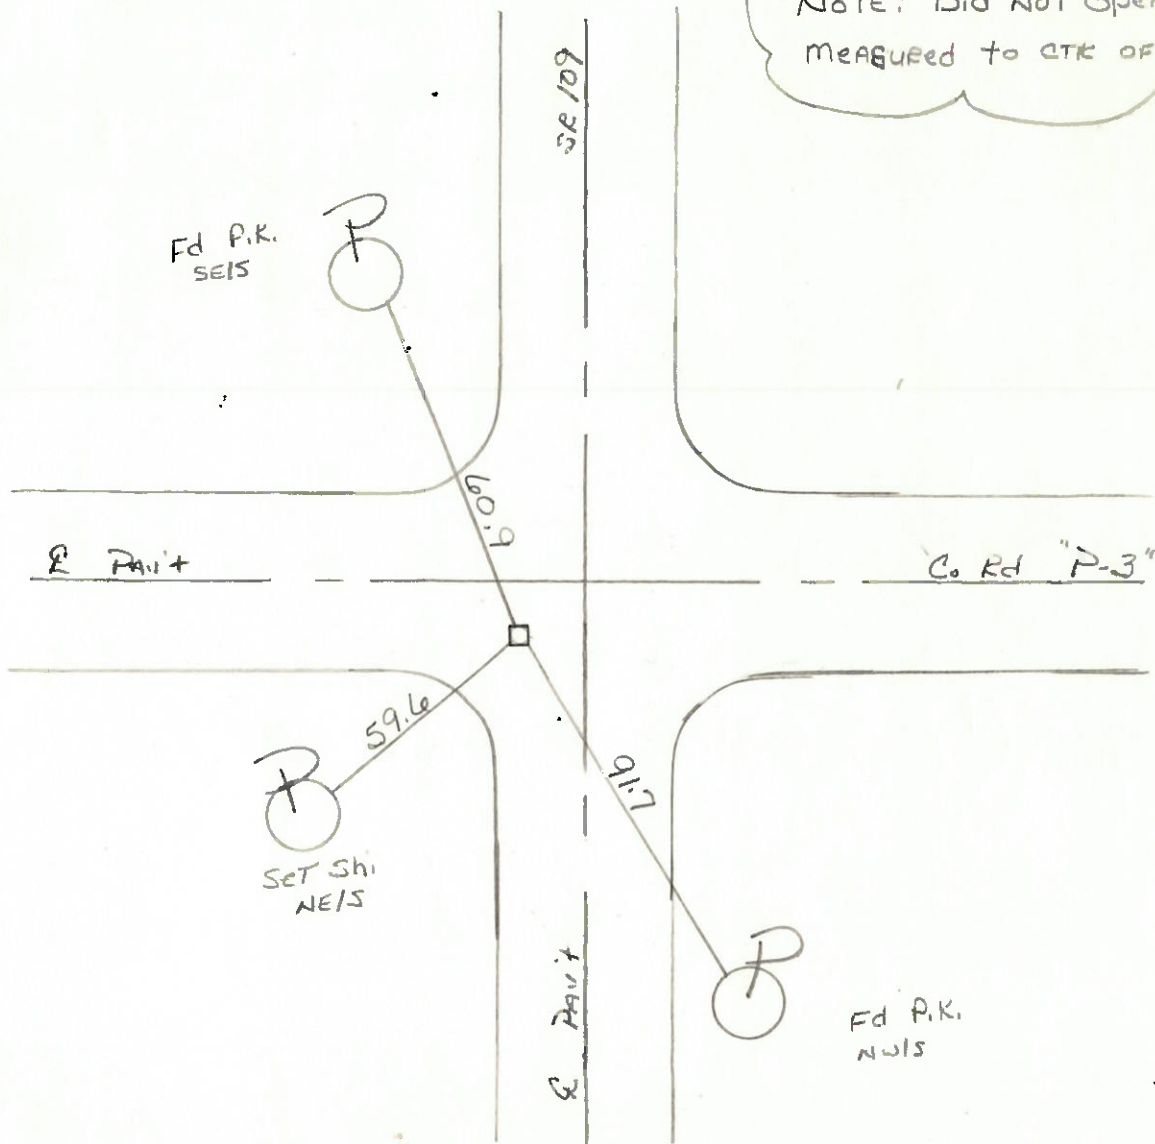

Q.D.O.T. DISTRICT 2 SURVEY OFFICE

SHEET _____ OF _____

County HENRY S.R. 109

Township HARRISON

Section 14

TSN, R7E

Personnel HOFFMAN

LOEHRKE

HOUSEHOLDER R.C.


33

BARNHISEL H.C.

Date 3-19-84

Weather OVERCAST

Temp. +30°

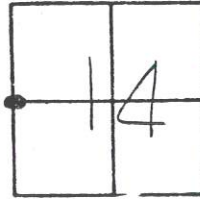

Fd 1/2" pipe 1" below surface

S.L.M. = 823+43 36

Set By P. WestHouard

SET PK/WASHER


8-23-84

S.W.H.

7.2 7.5 Lt. & Part SR 109

1.5 3.0 South & Part Co. Rd "P-3" EAST

MEASURED TO CTR OF LID

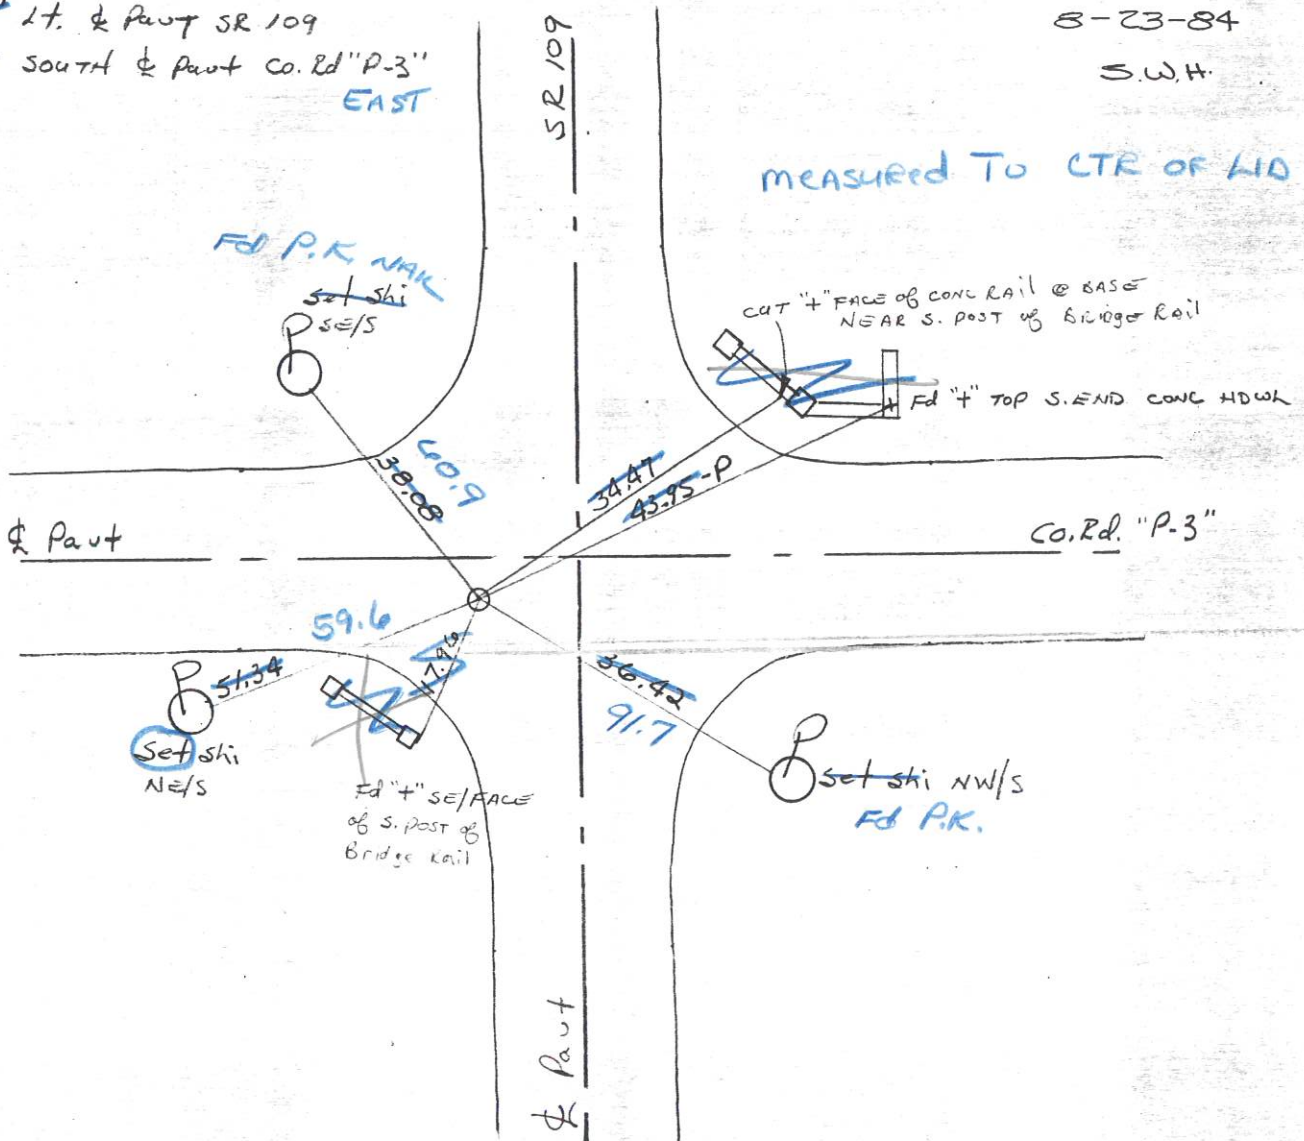

QDOT DISTRICT 2 SURVEY OFFICE

SHEET _____ OF _____

County HENRY S.R. 109

Township HARRISON

Section 14

TSN, RTE

Personnel HOFFMAN

LOUHRKE


33 HOUSEHOLDER R.C.

BARNHISEL H.C.

Date 3-19-84

Weather OVERCAST

Temp. +30°

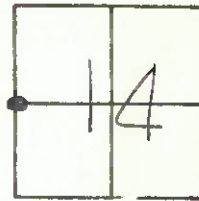

Fcd $\frac{1}{2}$ " pipe 1" below surface

set by R. Westhouse

7.5' Lt. & Part SR 109


3.0' south & part Co. Rd "P-3"

S.L.M. = 823+43

SET PK/WASHER

8-23-84


S.W.H.

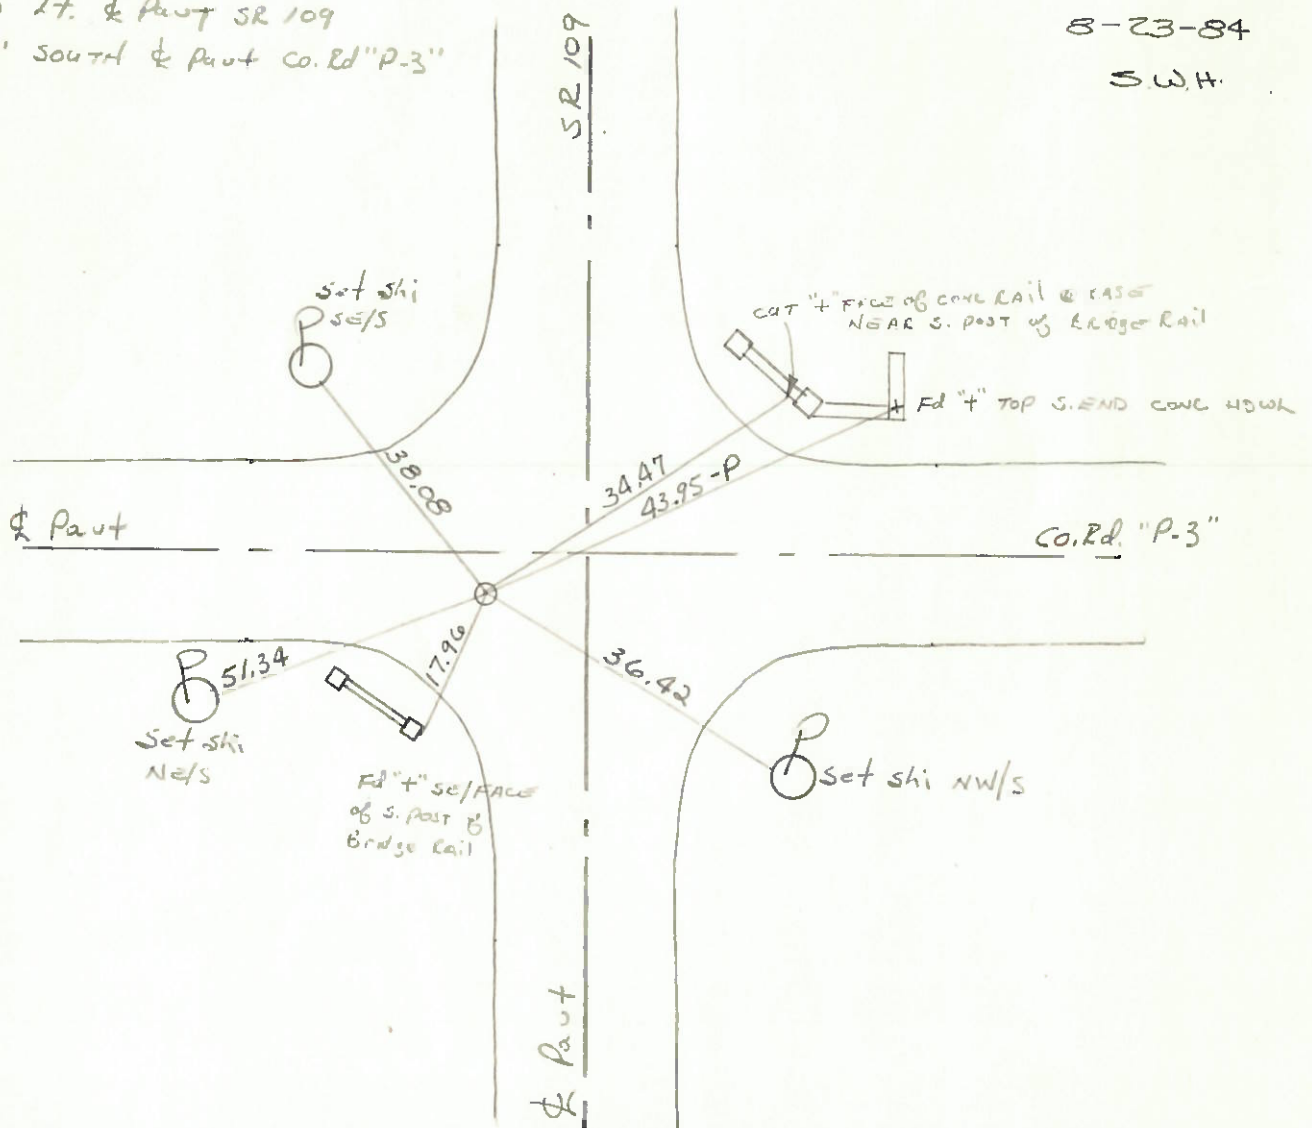

SHEET # 7-B 33

14 HARRISON TOWNSHIP

Section 14 Town N. Range E.

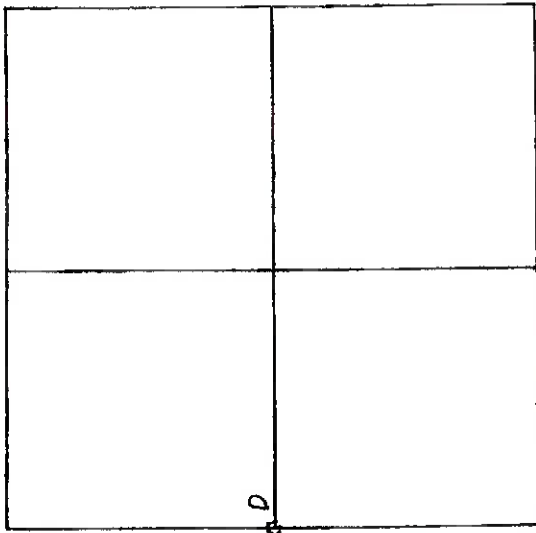

Sept. 1973 Paul Westhoven
Cor. established in Westhoven
placed 12" x 3 1/2" Iron Pipe w/ PK on Bridge Floor
1-02 SW 4th & Drill Hole on East end East Post
Bridge Rail West side S.R. 10
34.53 ENE to "X" & drill hole SW's southerly on 1-5
Bridge Rail East side S.R. #109
38.66 SE to P.K. SW's P
38.98 NW to P.K. NE's P
51.61 SW to P.K. SE's P
P.K's 2' S & W