

O.D.O.T. DISTRICT 2 SURVEY OFFICE (USE ONLY)

PERSONNEL

REFERENCE NO. 34

SHEET 24 OF 39

NOTES RHOADES

DATE 9/3/15

ROUTE SR 109

H.C. O'DONNELL

WEATHER CLEAR

COUNTY HENRY

R.C. RHOADES

TEMP. 88°

TOWNSHIP HARRISON

SECTION 14

DWG BY RHOADES

PID PAVTRAIN

T 5 N R 7 E

TYPE MONUMENT MAG/WASHER

ON SURFACE - ~~BELOW~~ ON

OFFSET CL PAVEMENT ON LT : RT

9.2' TO LT EDGE PAVEMENT


STATION: 849+80

HORZ.DATUM: NAD83 2011

GEOID: NAVD88 2018

GRID: NORTHING: 635168.377

EASTING: 1546536.930

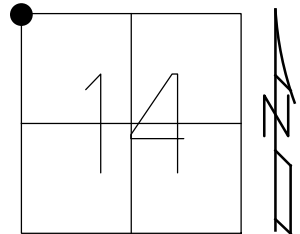

RECORD:

SET MAG/WASHER

9-15-04, MC

FD MAG/WASHER

REFB30

9-1-15, JFO


8-3-16, JMR

FD MAG/WASHER

REF34

6/16/21, TDN

10/5/21, JFO

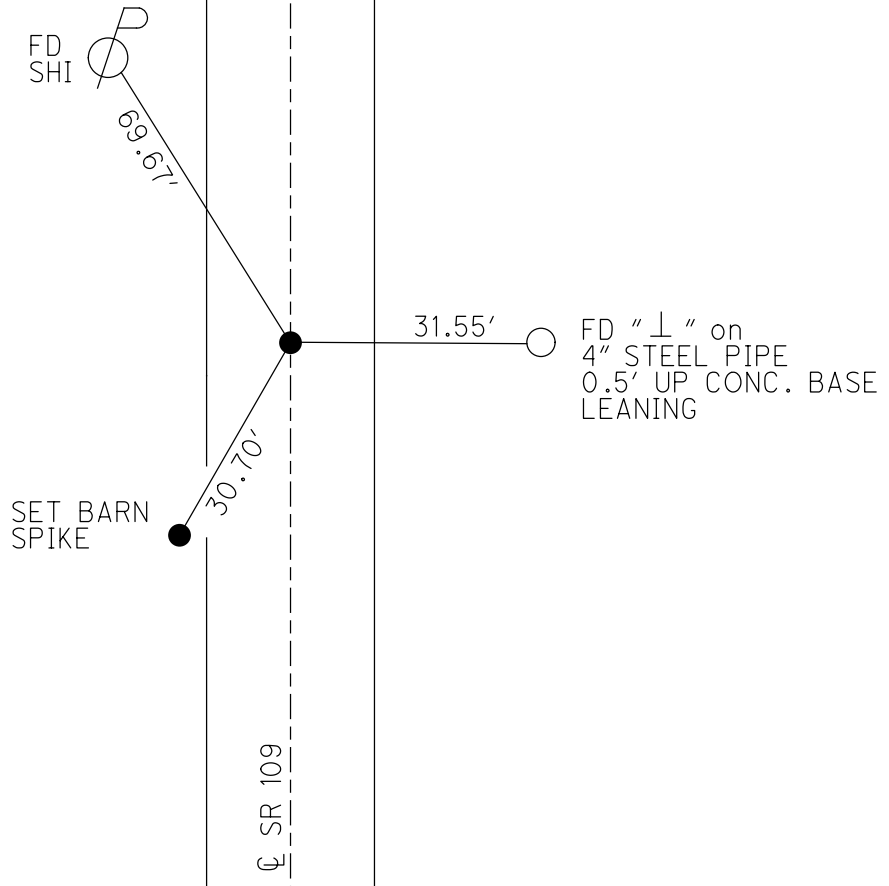

O.D.O.T. DISTRICT 2 SURVEY OFFICE (USE ONLY)

PERSONNEL

REFERENCE NO.

34

SHEET

24

OF 38

NOTES RHOADES

DATE 9-3-15

ROUTE SR 109

H.C. O'DONNELL

WEATHER CLEAR

COUNTY HENRY

R.C. RHOADES

TEMP. 88°F

TOWNSHIP HARRISON

SECTION 14

T 5 N R 7 E

TYPE MONUMENT MAG/WASHER


ON SURFACE - ~~BELOW~~ ON

LEFT - Q PAV'T - RIGHT ON

9.2' TO LT EDGE PAVEMENT

S.L.M. 849+80

Grid: Northing: 635168.3748 Easting: 1546536.9299

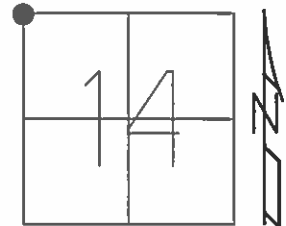

RECORD:

SET MAG/WASHER
9-15-04, MC

FD MAG/WASHER
GPS, REFB30
9-1-15, JFO

UNCOVERED
8-3-16, JMR

FD SHI
SE/S

69.67'

31.55'

FD "1" on
4" STEEL PIPE
0.5' UP CONC. BASE

SET BARN
SPK 3'
OFF EP

30.70'

Q SR 109

O.D.O.T. DISTRICT 2 SURVEY OFFICE

PERSONNEL

REFERENCE NO. 34

SHEET 22 OF 23

NOTES CORDES

H.C. BARNHISEL

R.C. HOOGER

MC - DRAWING

DATE 8/27/04

WEATHER OVERCAST

TEMP. + 80°

ROUTE 109

COUNTY HENRY

TOWNSHIP HARRISON

SECTION 14

T 5 N R 7 E


TYPE MONUMENT P.K. / WASHER

ON SURFACE - BELOW SURFACE


LEFT - Q PAV'T. - RIGHT 1.3' LT Q

9.2 TO LT. EDGE PAVEMENT

S.L.M. 849 + 80

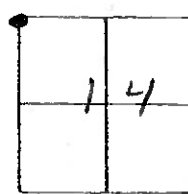

RESET MAG/WASHER
9/15/04
M.C.

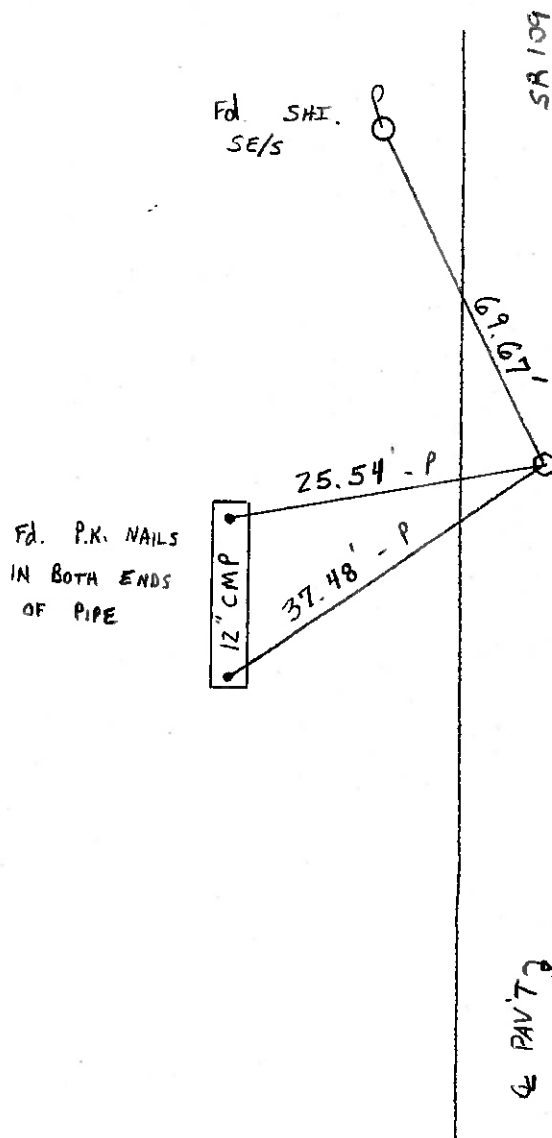

O.D.O.T. DISTRICT 2 SURVEY OFFICE

PERSONNEL

REFERENCE NO. 34

SHEET OF

NOTES BAENHISEL

H.C. " "

R.C. HOFFMAN

DATE 9-25-90

WEATHER clear-Windy

TEMP. +70°

ROUTE 109

COUNTY HENRY

TOWNSHIP HARRISON

SECTION 14

T 5 N R 7 E

TYPE MONUMENT P.K. & Washer

ON SURFACE - BELOW yes

LEFT- & PAV'T. - RIGHT 0.3

10.2 TO - EDGE PAVEMENT

S.L.M. 849 + 80



Set P.K. & Washer
10-4-90
MB

Set Sh
SEIS

69.71

S.G. 109

25.60-P

31.60

4" STEEL COR. POST
LEANING TO THE EAST.
USED CTR PUNCH hole
0.92 up from CONC.
BASE

FD P.K.'S
IN BOTH
ENDS OF
PIPE

12" Cmp

37.49-P

E PAVT

ODOT DISTRICT 2 SURVEY OFFICE

SHEET _____ OF _____

County HENRY S.R. 109

Township HARRISON

Section 14

T5N, R7E

Personnel HOFFMAN

LOHRKE

HOUSEHOLDER R.C.

BARNHISEL H.C.

#34

Date 3-19-84

Weather OVERCAST

Temp. +30°



Fd R.R. SPK/CTR PUNCH @ SURFACE

SLM 849+90

1.5' LT. of & PAUT


8.0' TO LT. EP

10.1' TO RT. EP

SET PK/WASHER

8-23-84

S.W.H.

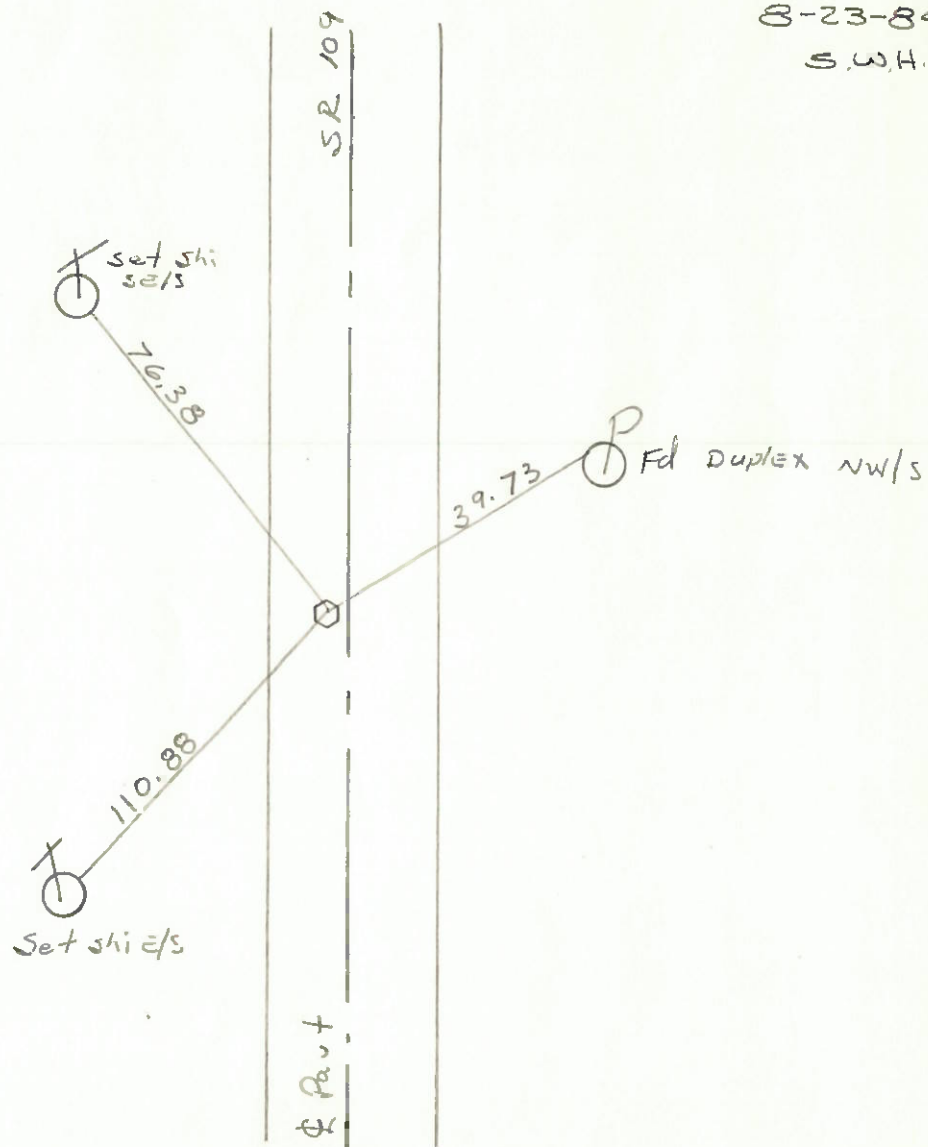

ODDOT DISTRICT 2 SURVEY OFFICE

SHEET _____ OF _____

County HENRY S.R. 109

Township HARRISON

Section 14

T5N, R7E

Personnel HOFFMAN

LOEHRKE

HOUSEHOLDER R.C.


BARNHISEL H.C.

#34

Date 3-19-84

Weather OVERCAST

Temp. +30°

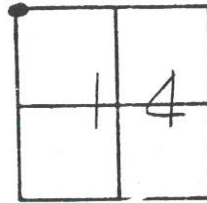

Fd R.R. SPK/CTR PUNCH @ SURFACE


SLM 849+90 80

0.3 15' LT. of & PAUT
10.2 8.0' TO LT. EP.
10.1' TO RT. EP.

SET PK/WASHER

8-23-84

S.W.H.

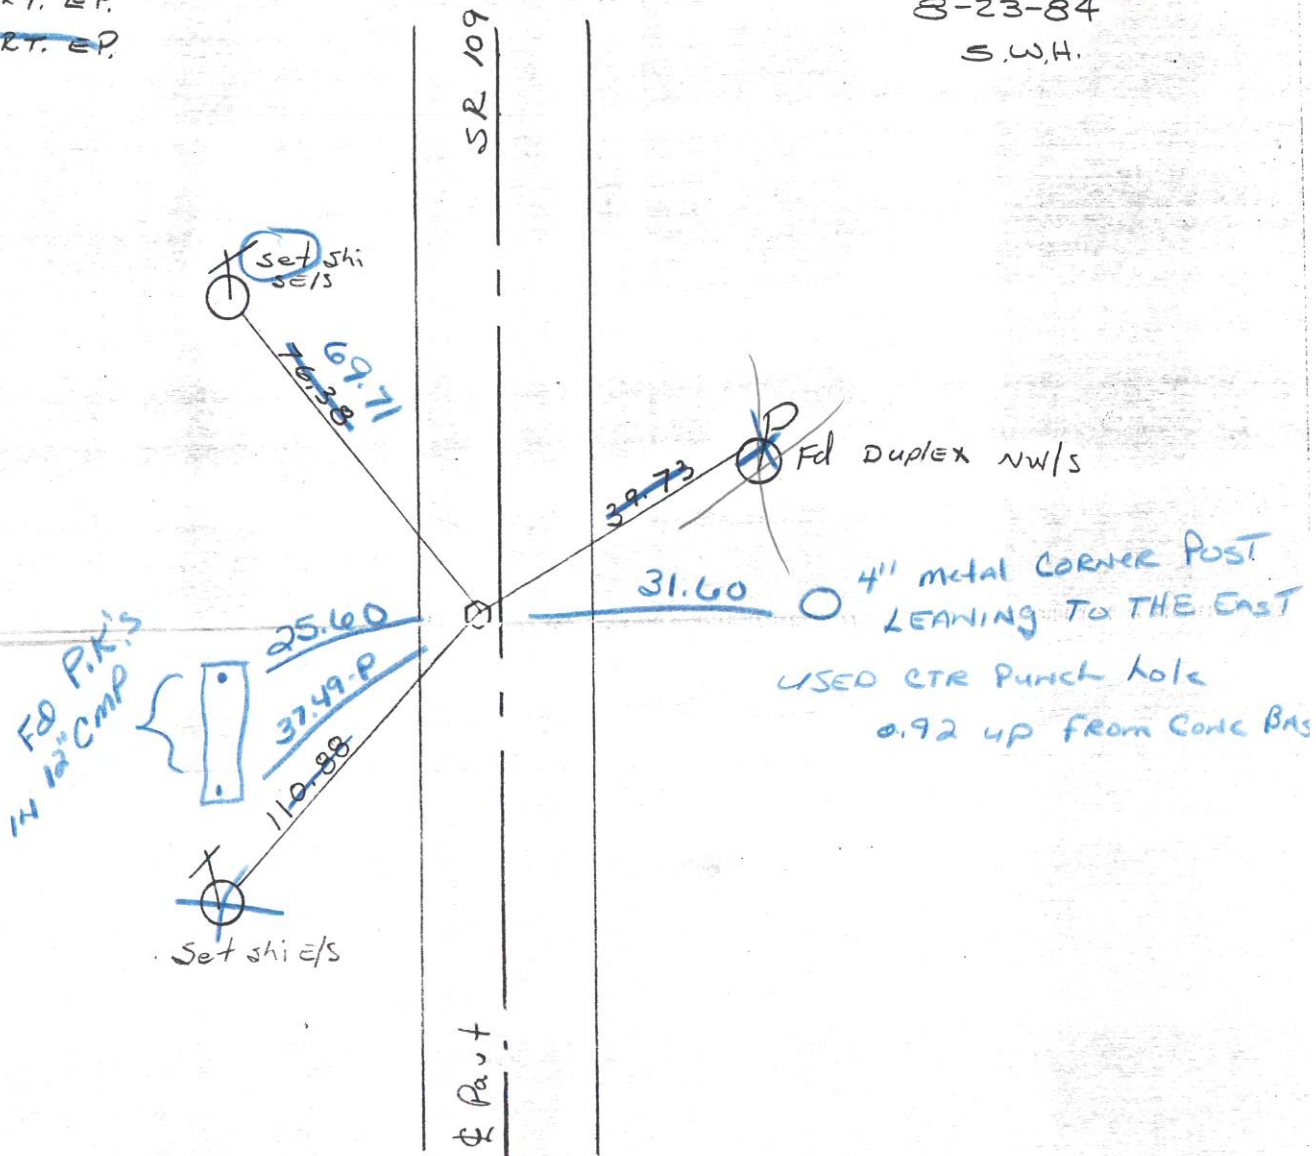

PERSONNEL	TITLE	PERSONNEL	TITLE	COUNTY	DATE	WEATHER	TEMP.	JOB NO.
Townsic				HENRY	DEC. 14, 1973	Fair	22°	
Neuser				S. R. 109				
Grinata				SEC.				
Janys								

