

O.D.O.T. DISTRICT 2 SURVEY OFFICE (USE ONLY)

PERSONNEL

REFERENCE NO. 35

SHEET 25 OF 39

NOTES RHOADES

DATE 9/3/15

ROUTE SR 109

H.C. O'DONNELL

WEATHER CLEAR

COUNTY HENRY

R.C. RHOADES

TEMP. 88°

TOWNSHIP HARRISON

DWG BY RHOADES

PID PAVTRAIN

SECTION 11

T 5 N R 7 E

TYPE MONUMENT MAG/WASHER

ON SURFACE - ~~BELOW~~ ON

OFFSET Q PAVEMENT ON LT : RT

10.4' TO LT EDGE PAVEMENT


STATION: 862+98

HORIZ.DATUM: NAD83 2011

GEOID: NAVD88 2018


GRID: NORTHING: 636487.549

EASTING: 1546569.567

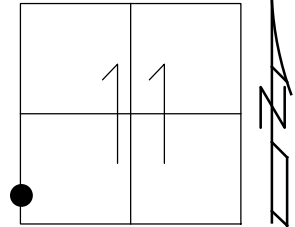

RECORD:
SET MAG/WASHER
9-15-04, MC
FD MAG/WASHER
REFB30
9-1-15, JFO
8-3-16, JMR
FD MAG/WASHER
REF35
6/16/21, TDN
10/5/21, JFO

FD "+"
12" STEEL PIPE

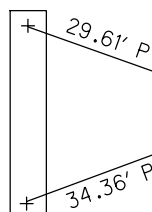

Q SR 109

FD CUT NOTCH
1' UP
STOP SIGN


126.25'

O.D.O.T. DISTRICT 2 SURVEY OFFICE (USE ONLY)

PERSONNEL	REFERENCE NO.	<u>35</u>	SHEET	<u>25</u>	OF	<u>38</u>
NOTES	<u>RHOADES</u>	DATE	<u>9-3-15</u>	ROUTE	<u>SR 109</u>	
H.C.	<u>O'DONNELL</u>	WEATHER	<u>CLEAR</u>	COUNTY	<u>HENRY</u>	
R.C.	<u>RHOADES</u>	TEMP.	<u>88°F</u>	TOWNSHIP	<u>HARRISON</u>	
				SECTION	<u>11</u>	
				T	<u>5</u>	N
				R	<u>7</u>	E

TYPE MONUMENT MAG/WASHER
ON SURFACE - ~~BELOW~~ ON
LEFT - CL PAV'T - RIGHT ON
10.4' TO LT EDGE PAVEMENT
S.L.M. 862+98

Grid: Northing: 636487.6246 Easting: 1546569.5753

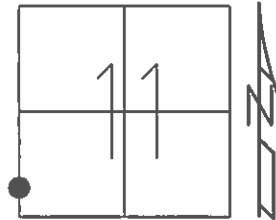


RECORD:
SET MAG/WASHER
9-15-04, MC

FD MAG/WASHER
GPS, REF830
9-1-15, JFO

UNCOVERED
8-3-16, JMR

12" STEEL PIPE
CUT "+"
ON EACH END

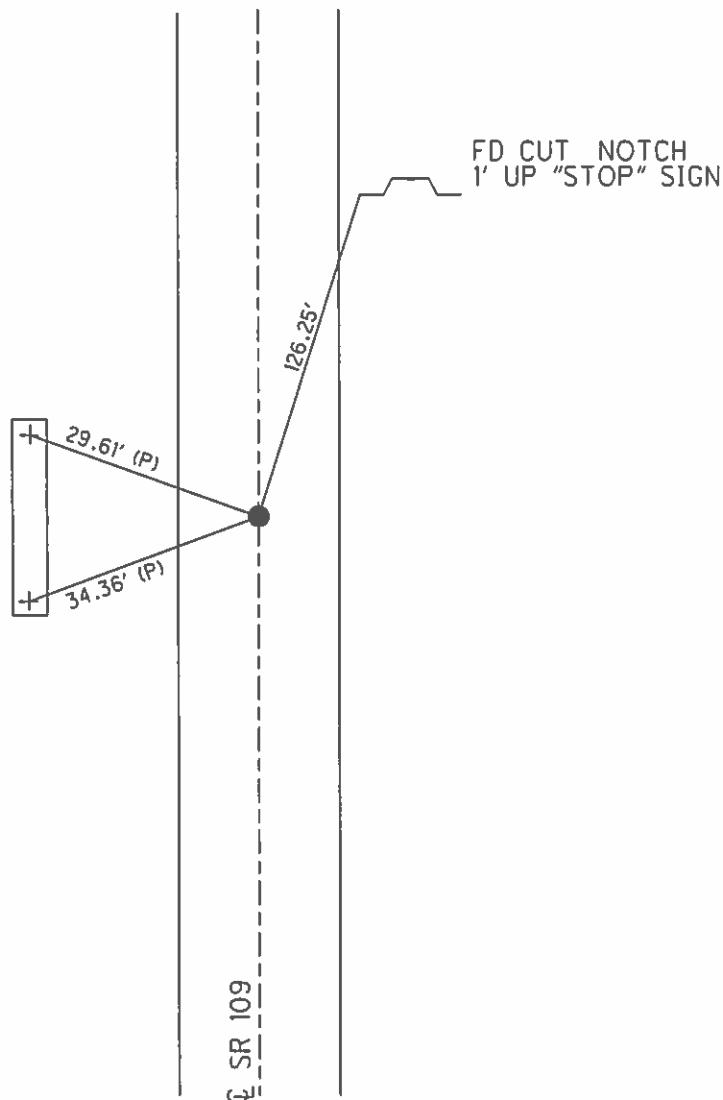

O.D.O.T. DISTRICT 2 SURVEY OFFICE

PERSONNEL

REFERENCE NO. 35

SHEET 23 OF 23

NOTES CORDES

H.C. BARNHISEL

R.C. HOOKE

DATE 8/27/04

WEATHER OVERCAST

TEMP. + 80°

ROUTE 109

COUNTY HENRY

TOWNSHIP HARRISON

SECTION 11

T S N R 7 E


TYPE MONUMENT P.K. / WASHER

ON SURFACE - BELOW SURFACE

~~LEFT~~ - & PAV'T. - RIGHT ON E

10.4 TO LT. EDGE PAVEMENT

S.L.M. 862 + 98

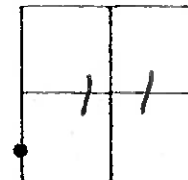


RESET MAG/WASHER

9/15/04

M.C.

CUT NOTCH 1' UP
E. LEG OF STOP AHEAD SIGN

12" STEEL
PIPE CUT "+"
ON EACH END

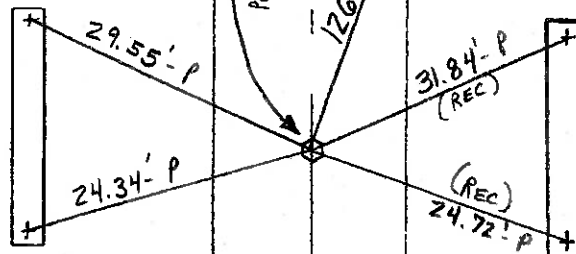

12" CMP W/PK NAILS
IN EACH END

PAV'T.

O.D.O.T. DISTRICT 2 SURVEY OFFICE

PERSONNEL

REFERENCE NO. 35

SHEET OF

NOTES BARNHISEL

H.C. " "

R.C. HOFFMAN

DATE 9-25-90

WEATHER CLEAR-WINDY

TEMP. +70°

ROUTE 109

COUNTY HENRY

TOWNSHIP HARRISON

SECTION 11

T 5 N R 7 E



TYPE MONUMENT P.K. & Washer

ON SURFACE - ~~BELOW~~ yes


LEFT - ~~C~~ PAV'T. - RIGHT yes

10.6 TO LT EDGE PAVEMENT

S.L.M. 862 + 99

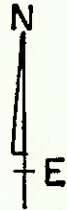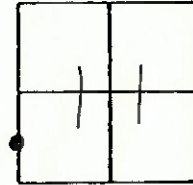

Set P.K. & Washer
10-4-90
mB

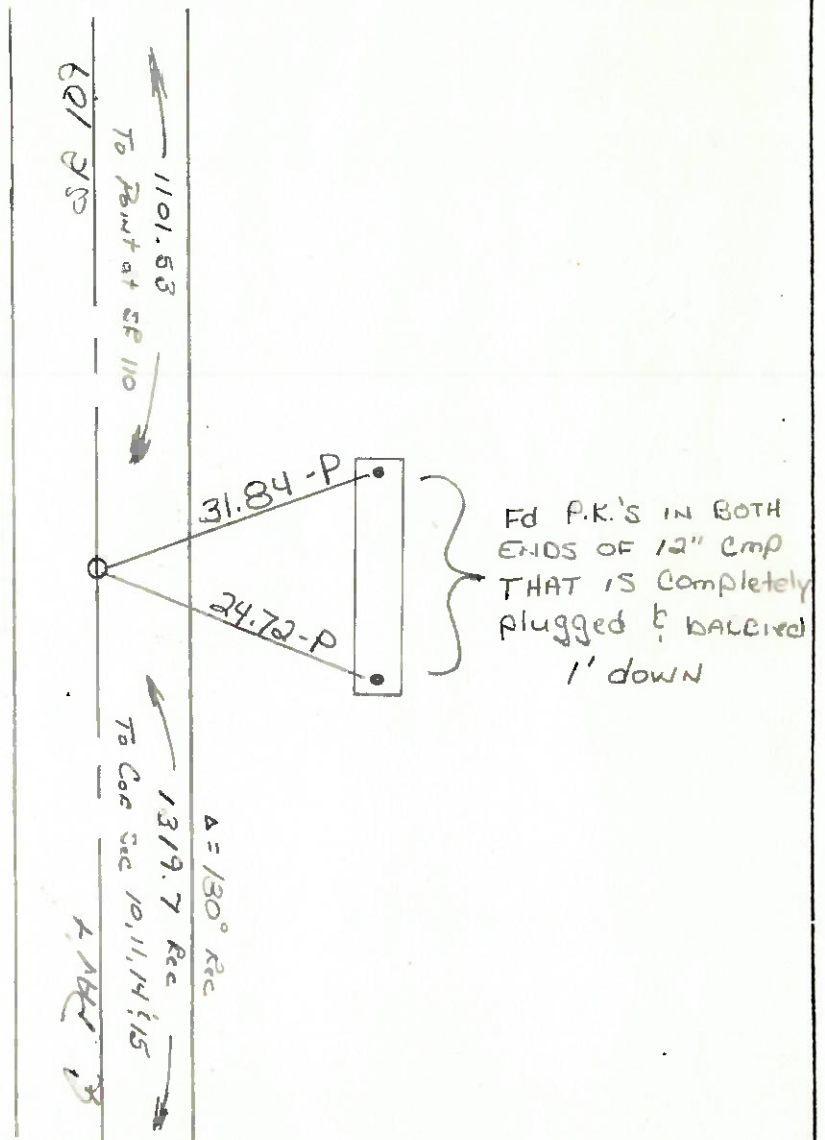


Q.D.O.T. DISTRICT 2 SURVEY OFFICE

SHEET _____ OF _____

County HENRY S.R. 109Township HARRISONSection 11

TSN, R7E

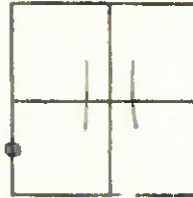
Personnel HOFFMANLOENRUE#35 HOUSEHOLDER R.C.BARNHISEL H.C.Date 3-19-84Weather OVERCASTTemp. +30°Fd $\frac{3}{4}$ " IRON PIPE 2" Below Surface

0.5' Lt. of & PAUT

8.8' TO Lt. EP.

9.4' TO RT. EP

SLM = 863 + 09

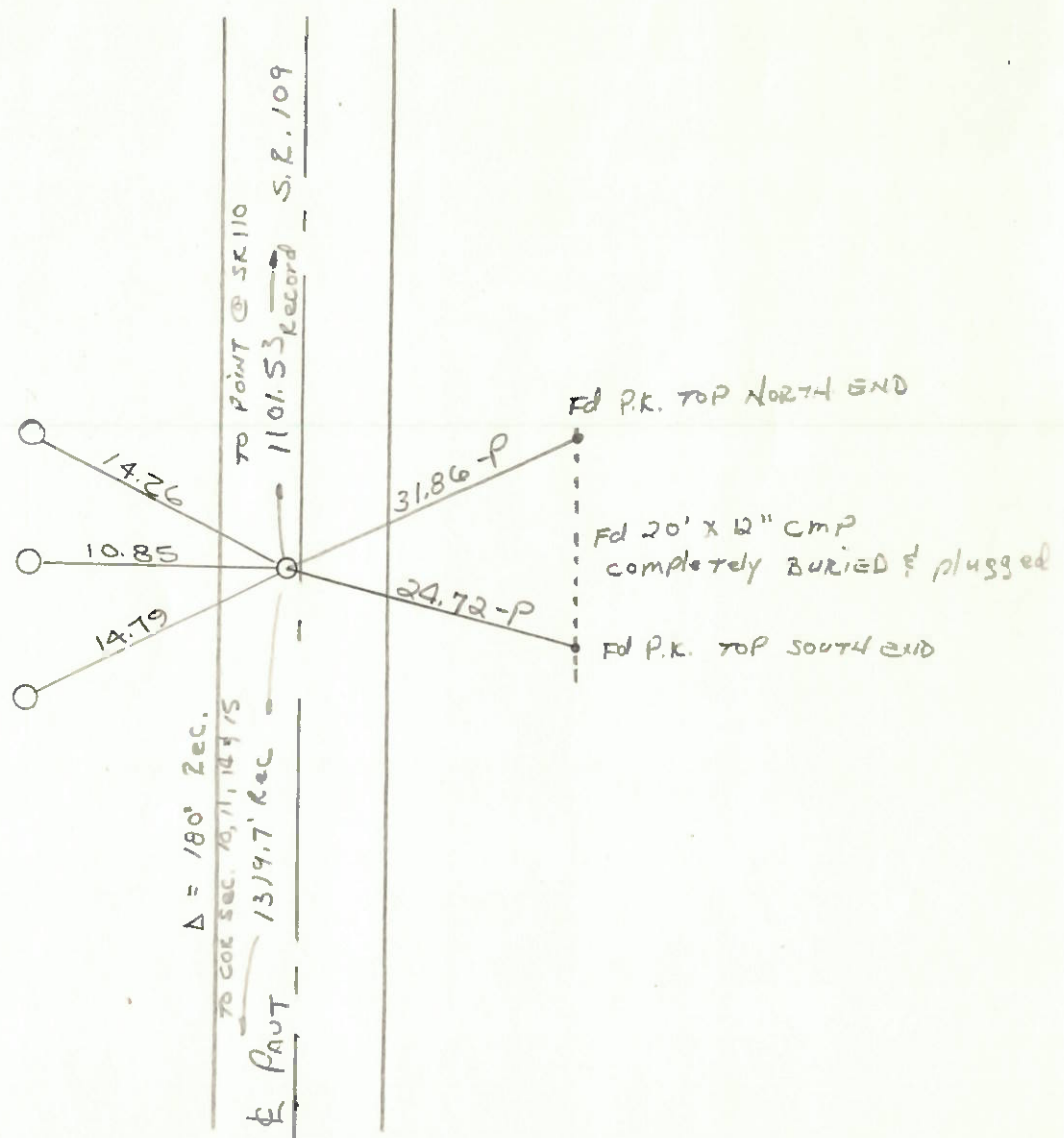No ^{OTHER} REF. TIES IN AREA.

ODDOT DISTRICT 2 SURVEY OFFICE

SHEET _____ OF _____

County HENRY S.R. 109

Township HARRISON

Section 11

TSN, RZE

Personnel HOFFMAN

LOEHRE


#35 HOUSEHOLDER R.C.

BARNHISEL H.C.

Date 3-19-84

Weather OVERCAST

Temp. +30°

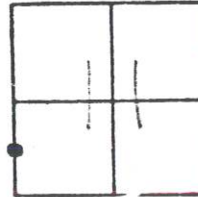


Fd $\frac{3}{4}$ " IRON PIPE 2" Below Surface

SLM = ~~863+09~~
862+99

OTHER
NO REF. TIES IN AREA.

ON 0.5' LT. of & PAUT
10.16 8.8' TO LT. EP.
9.4' TO RT. EP

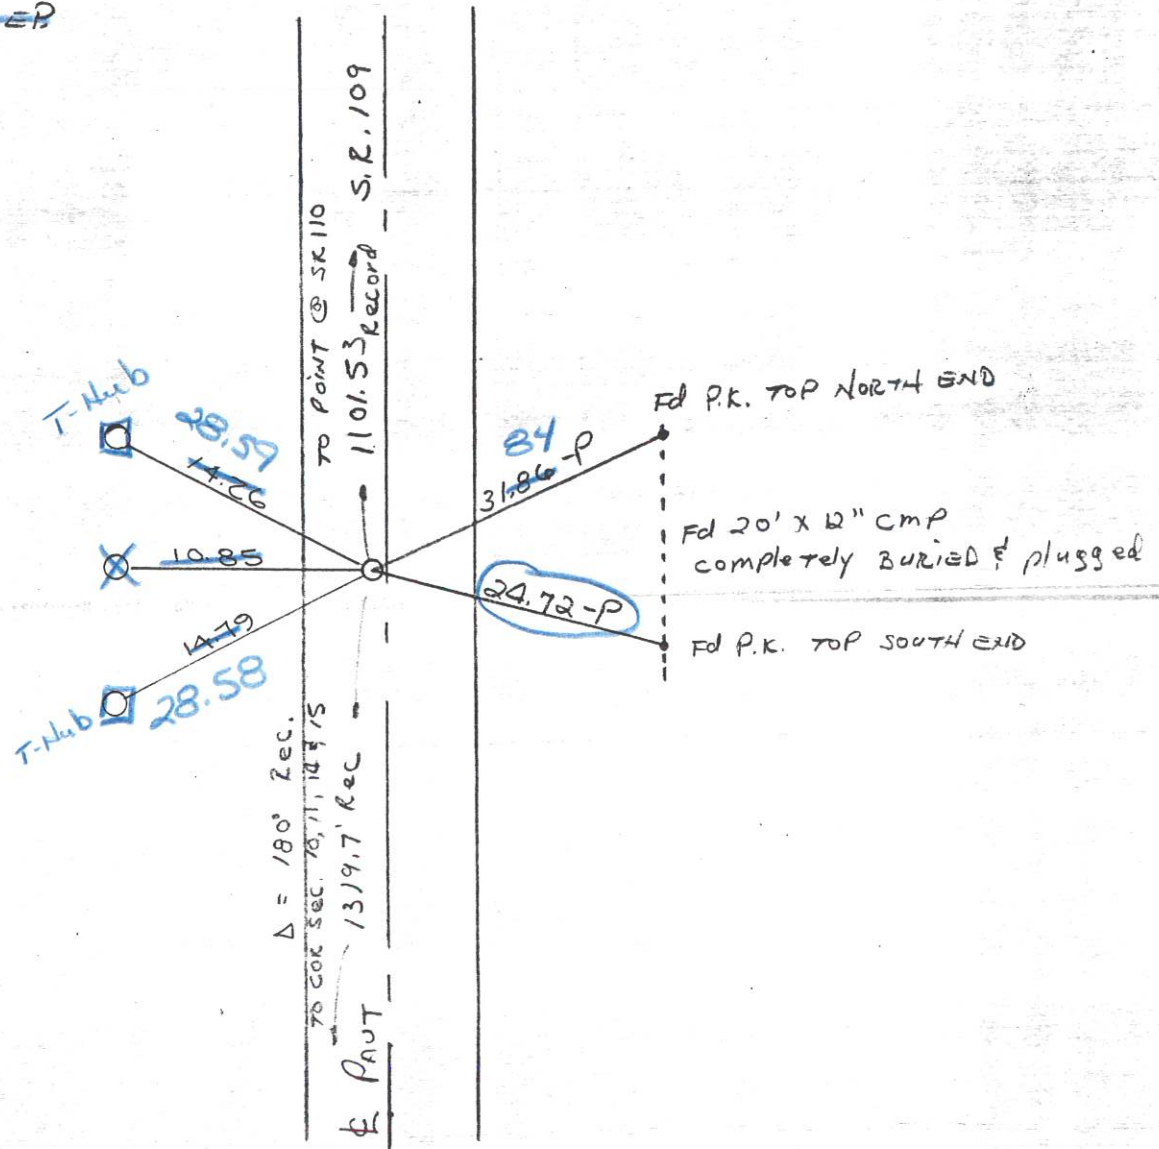

PERSONNEL TITLE PERSONNEL TITLE

COUNTY HENRYDATE DEC. 14, 1973TomsicNeuserVanyaCeranataS. R. 109

WEATHER

SEC.

TEMP. 32°

DESCRIPTION

LEFT

CENTER LINE

RIGHT

JOB NO.

