

O.D.O.T. DISTRICT 2 SURVEY OFFICE (USE ONLY)

PERSONNEL

REFERENCE NO. 36

SHEET 26 OF 36

NOTES ASTON

DATE 2/9/24

ROUTE SR 109

H.C. NIESE

WEATHER BREEZY

COUNTY HENRY

R.C. ASTON

TEMP. 54°

TOWNSHIP HARRISON

SECTION 11

DWG BY RHOADES

PID 94321

T 5 N R 7 E

TYPE MONUMENT MAG/WASHER

ON SURFACE - ~~BELOW~~ ON

OFFSET CL PAVEMENT ON LT : RT

10.4' TO N EDGE PAVEMENT


STATION: 874+11.76

HORZ.DATUM: NAV83 2011

GEOID: NAVD88 2018

GRID: NORTHING: 637588.508


EASTING: 1546596.833

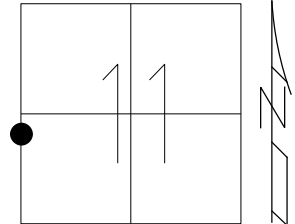

RECORD: P.I
STA= 280+41.65
 $\Delta = 0^\circ 30'$ RT
D = $0^\circ 10'$
T = 150'
L = 300'
E = 0.38'
R = 34,377.48
SET P.K./WASHER
10-11-90, MB
FD MAG NAIL
REF12
8-3-16, JMR
FD 3/4" IPIPE
4" DOWN
REF36
6/16/21, TDN
8/17/23, TDN
SET MAG/WASHER
2/9/24, TDN

W¹/₄ POST SEC 11

NOTE: REF 12 SR 110

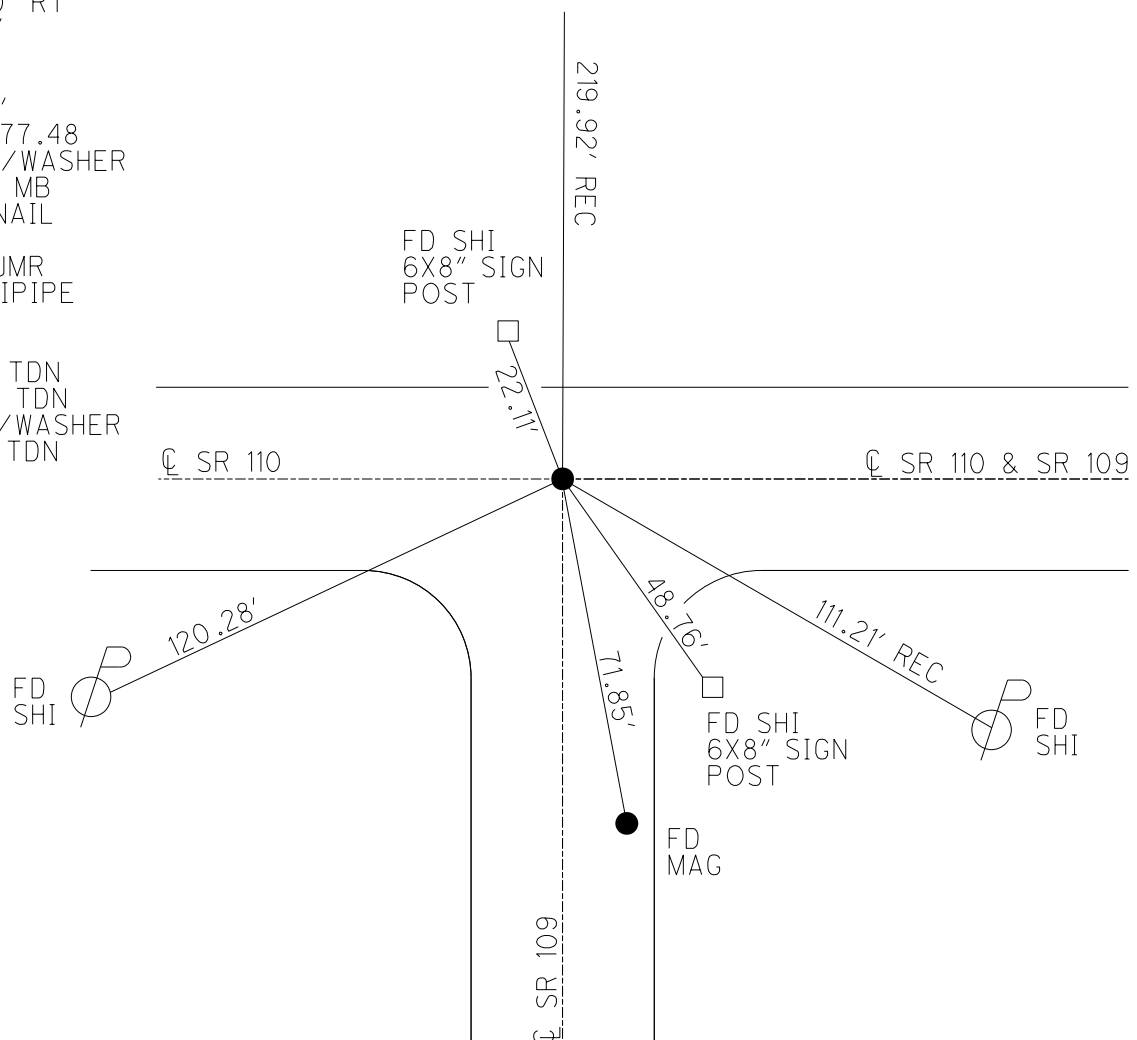

O.D.O.T. DISTRICT 2 SURVEY OFFICE (USE ONLY)

PERSONNEL

REFERENCE NO. 36

SHEET 26 OF 39

NOTES RHOADES

DATE 8/31/15

ROUTE SR 109

H.C. O'DONNELL

WEATHER FAIR

COUNTY HENRY

R.C. RHOADES

TEMP. 76°

TOWNSHIP HARRISON

SECTION 11

DWG BY RHOADES

PID PAVTRAIN

T 5 N R 7 E

TYPE MONUMENT MAG NAIL

ON SURFACE - ~~BELOW~~ ON

OFFSET CL PAVEMENT 1' LT : ~~RT~~

10.4' TO N EDGE PAVEMENT


STATION: 874+02

HORZ.DATUM: NAV83 2011


GEOID: NAVD88 2018

GRID: NORTHING: 637588.512

EASTING: 1546596.837

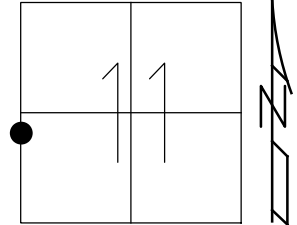


RECORD: P.I
STA= 280+41.65
 $\Delta = 0^\circ 30' \text{ RT}$
 $D = 0^\circ 10'$
 $T = 150'$
 $L = 300'$
 $E = 0.38'$
 $R = 34,377.48$
SET P.K./WASHER
10-11-90, MB
FD MAG NAIL
REF12
8-3-16, JMR
FD 3/4" IPIPE
4" DOWN
REF36
6/16/21, TDN

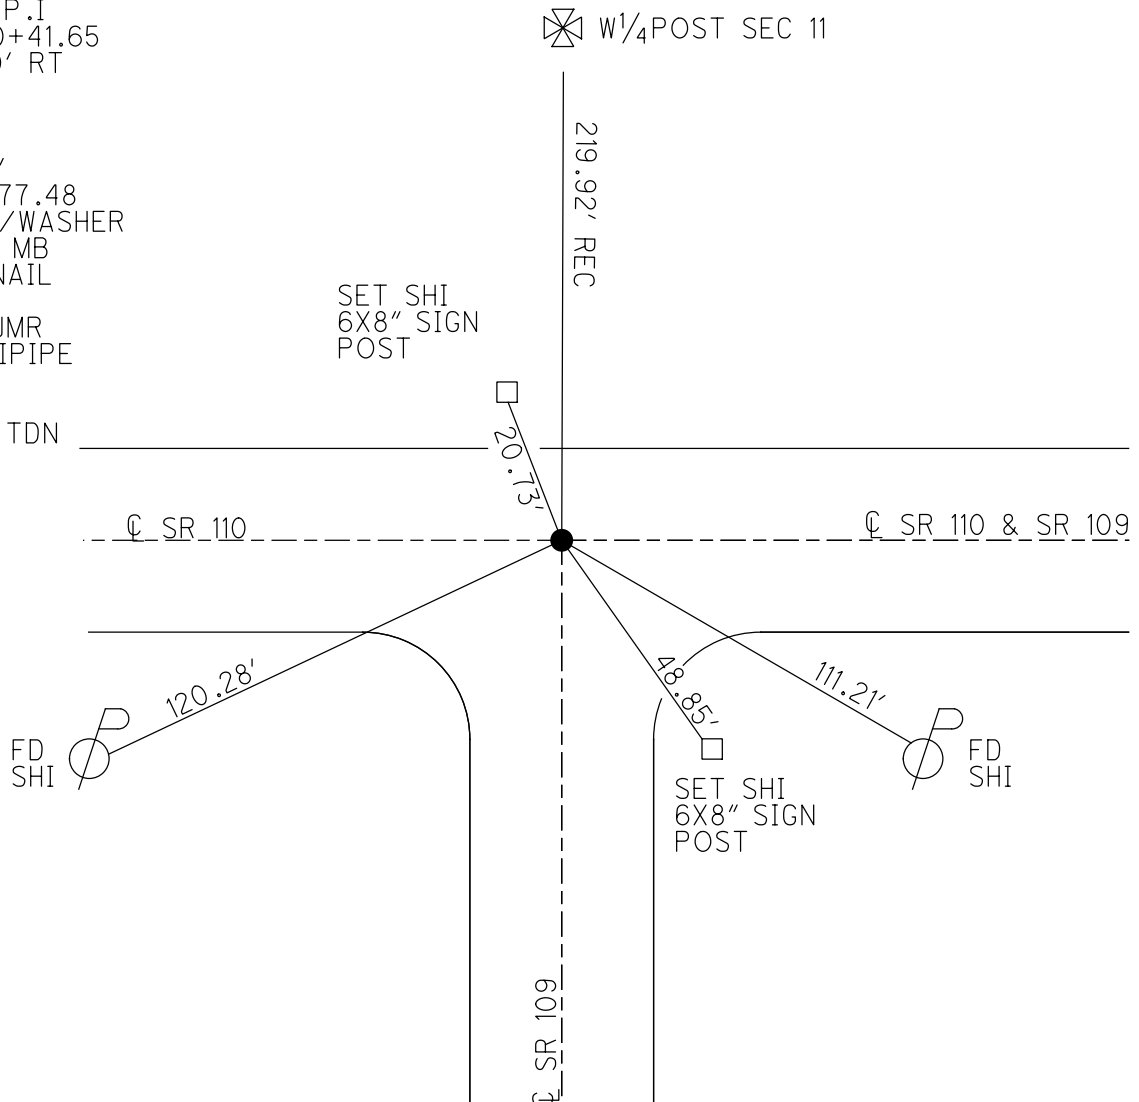

O.D.O.T. DISTRICT 2 SURVEY OFFICE (USE ONLY)

PERSONNEL	REFERENCE NO. <u>36</u>	SHEET <u>26</u> OF <u>38</u>
NOTES <u>RHOADES</u>	DATE <u>8-31-15</u>	ROUTE <u>SR 109</u>
H.C. <u>O'DONNELL</u>	WEATHER <u>FAIR</u>	COUNTY <u>HENRY</u>
R.C. <u>RHOADES</u>	TEMP. <u>76°F</u>	TOWNSHIP <u>HARRISON</u>
		SECTION <u>11</u>
		T <u>5</u> N R <u>7</u> E

TYPE MONUMENT MAG NAIL
 ON SURFACE - ~~BELOW~~ ON
 LEFT - Q PAV'T - ~~RIGHT~~ 1'
10.4' TO N EDGE PAVEMENT
 S.L.M. 874+02

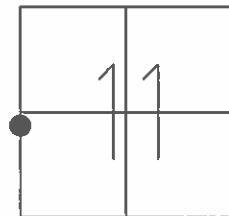

Grid: Northing: 637588.6766 Easting: 1546596.8230


RECORD:
 P.I. STA.=280+41.65
 $\Delta=0^{\circ}30'RT$
 $D=0^{\circ}10'$
 $T=150'$
 $L=300'$
 $E=0.38'$
 $R=34,377.48$

SR 109 874+11.8
1984

SET PK/WASHER
10-11-90, MB

FD MAG NAIL
GPS, REF12

NOT COVERED
8-3-16, JMR

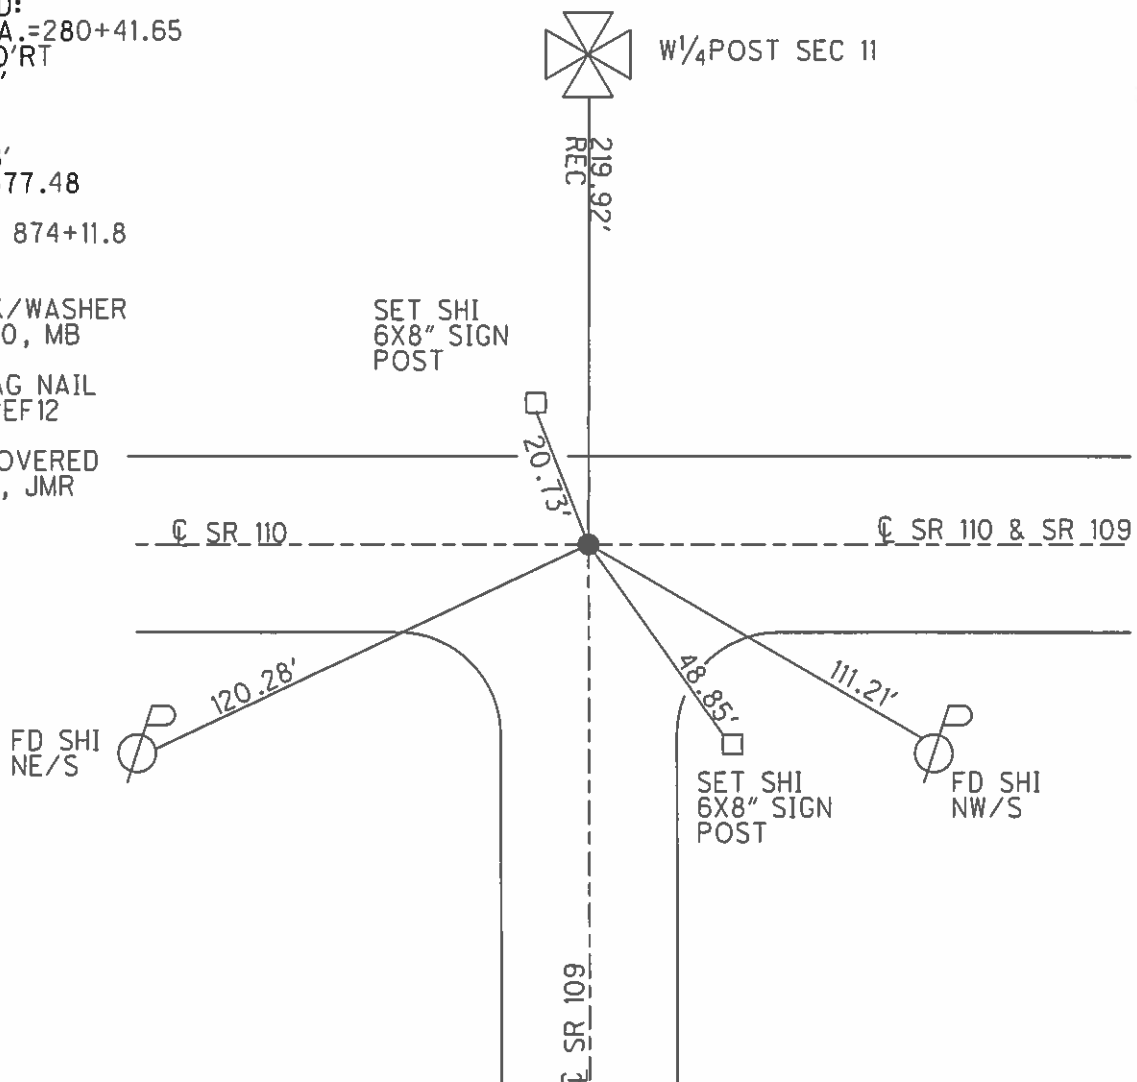

O.D.O.T. DISTRICT 2 SURVEY OFFICE

PERSONNEL

REFERENCE NO. 36 ⁻¹⁰⁹

SHEET OF

NOTES HOMAN

H.C. ROUSOS

R.C. BEAUMONT

DATE 8/13/02

WEATHER SUNNY

TEMP. 75°

ROUTE 109 @ 110

COUNTY HENRY

TOWNSHIP HARRISON

SECTION 11

T 5 N R 2 E



TYPE MONUMENT SM. RR. SPK

~~ON SURFACE~~ BELOW 2" BELOW

~~LEFT & PAV'T. - RIGHT~~ BOTH

10.4 TO N EDGE PAVEMENT

S.L.M. SR 109 - 874+02 SR 110 - 275+06

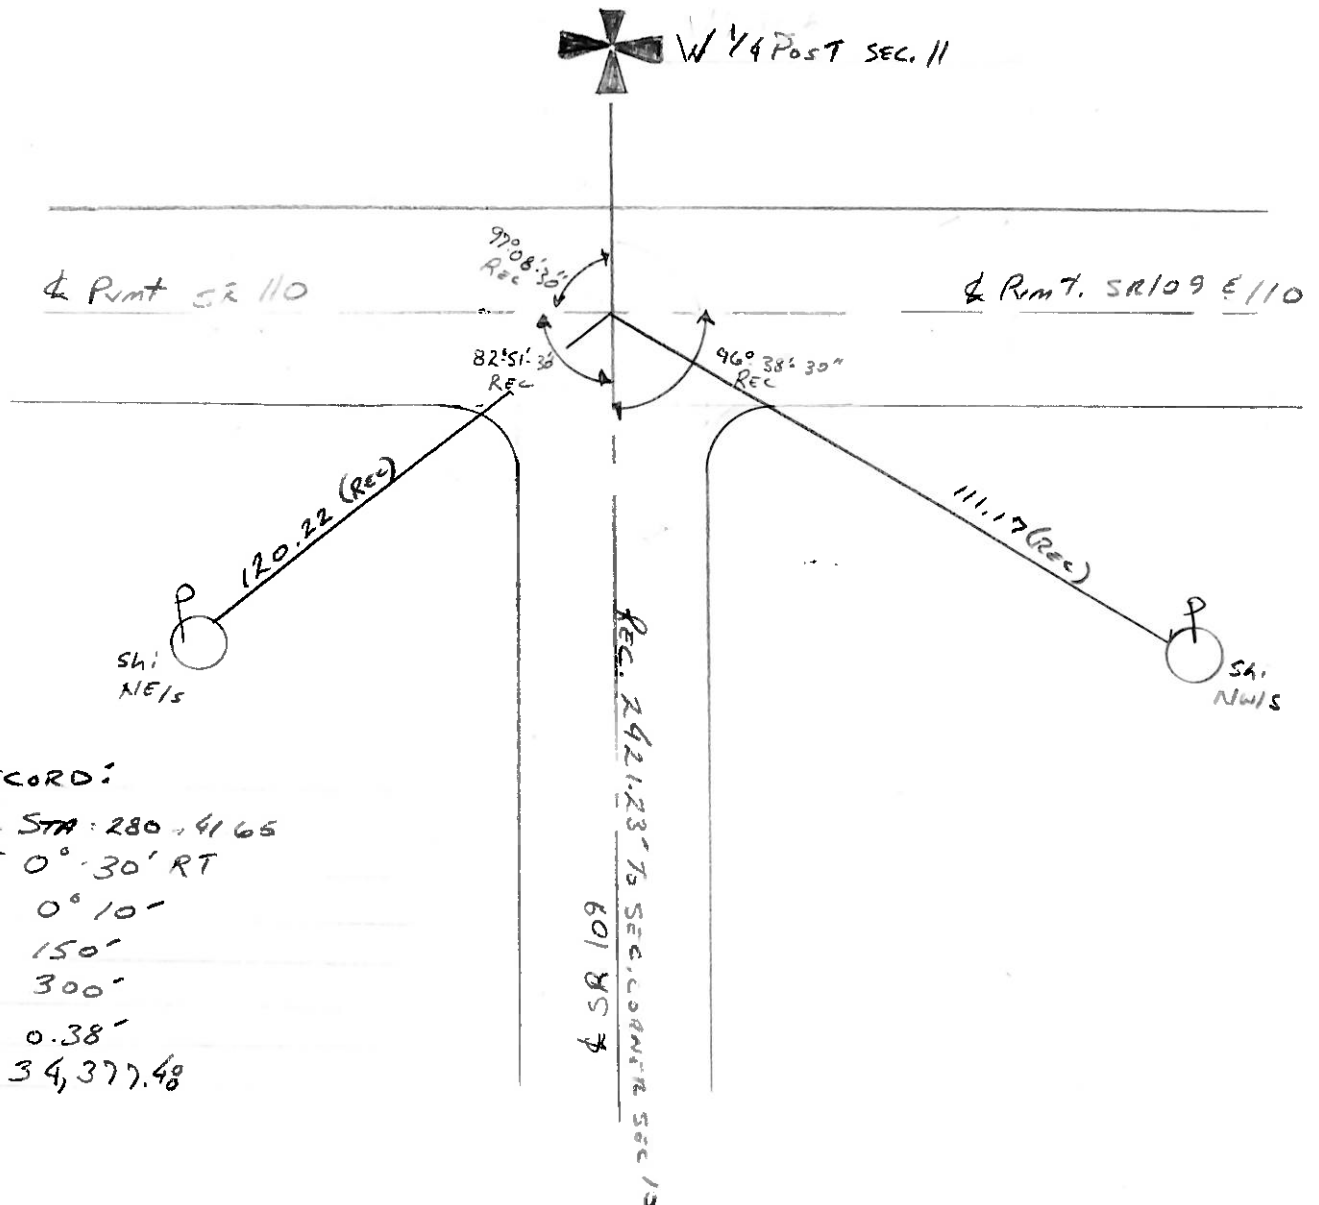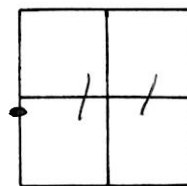

RECORD:

PI. STA: 280+41.65

$\Delta = 0^\circ 30' RT$

$D = 0^\circ 10'$

$T = 150'$

$L = 300'$

$E = 0.38'$

$R = 34,377.48$

O.D.O.T. DISTRICT 2 SURVEY OFFICE

PERSONNEL

REFERENCE NO. 36-107 SHEET 1 OF 9

NOTES BARNHISEL

H.C. _____

R.C. HOFFMAN

DATE 9-28-90

WEATHER Clear

TEMP. +65°

ROUTE 109 @ 110

COUNTY HENRY

TOWNSHIP HARRISONSECTION 11

T S N R 7 E



TYPE MONUMENT Sm RR Spk

ON SURFACE - ~~BELOW~~ yes

LEFT - & PAN'T - RIGHT BOTH

10.4 TO N. EDGE PAVEMENT

S.L.M. SE 109-874+02 SE 110-275+06

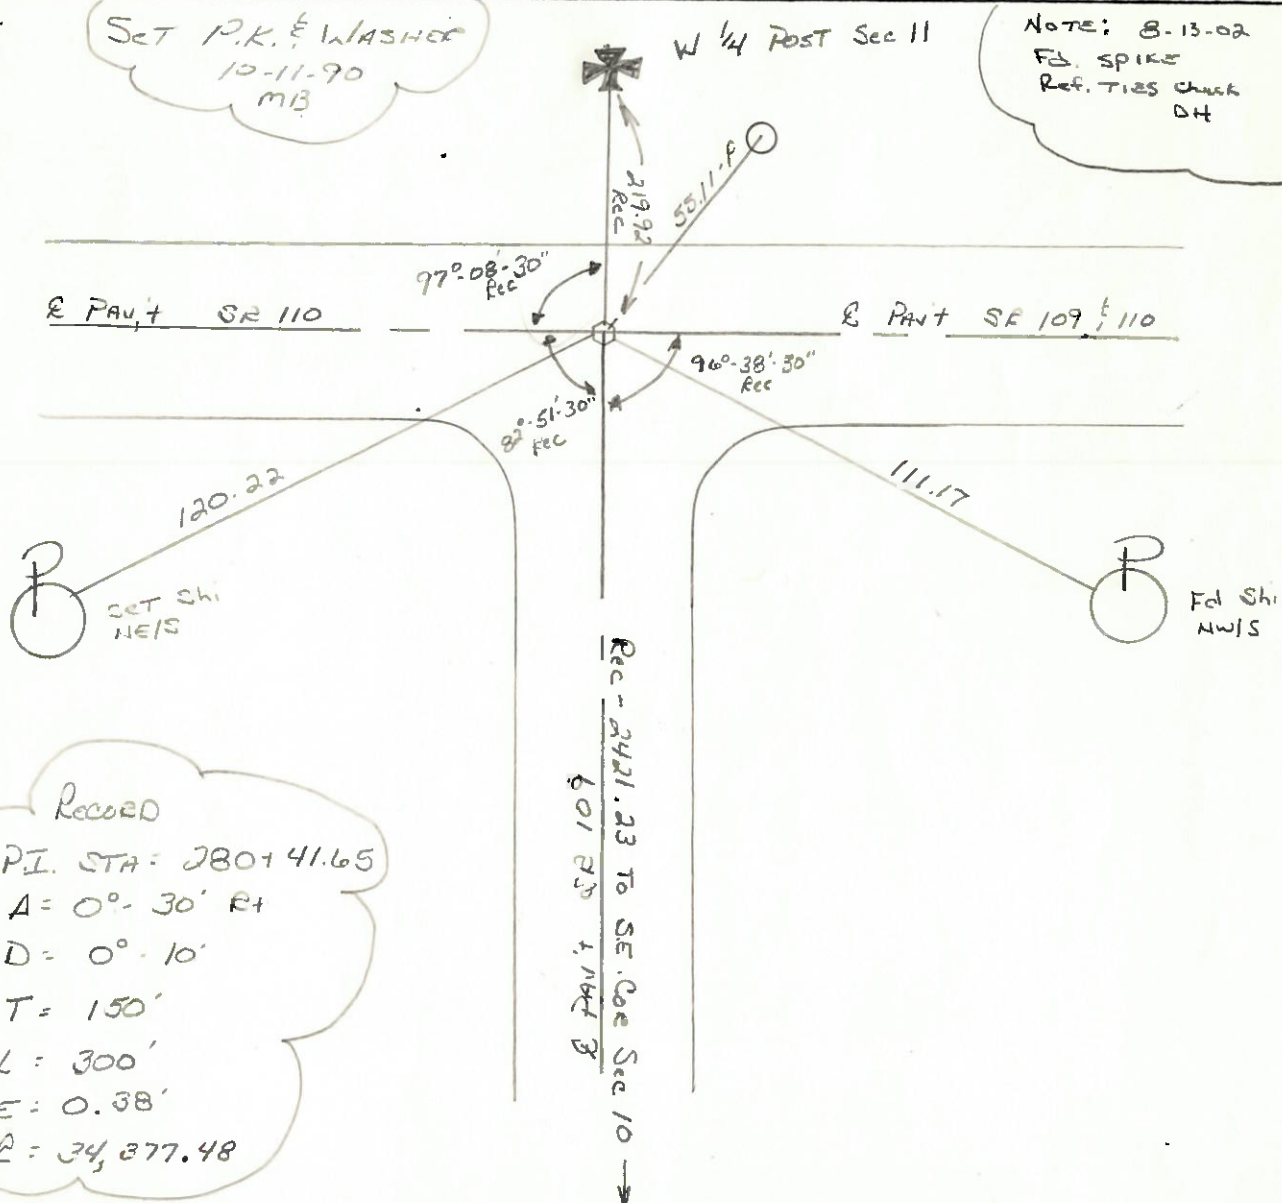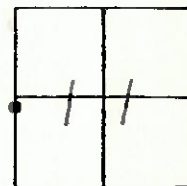

ODOT DISTRICT 2 SURVEY OFFICE

SHEET _____ OF _____

County HENRY S.R. 109 @ 110

Township HARRISON

Section 11

T5N, R7E

Personnel HOFFMAN

LOEHKE

HOUSEHOLDER R.C.


BARNHISEL H.C.

#36-109

Date 3-19-84

Weather OVERCAST

Temp. +30°

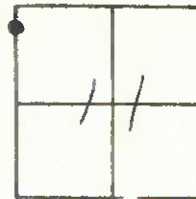

Fd $\frac{3}{4}$ " I. Pipe 2" below surface
ON & BOTH PAVEMENTS
10.4' TO N.E.P.


SLM SR 110 275+18

SLM SR 109 874+11.8

SET SMALL RR SPIKE

8-23-84

S.W.H.

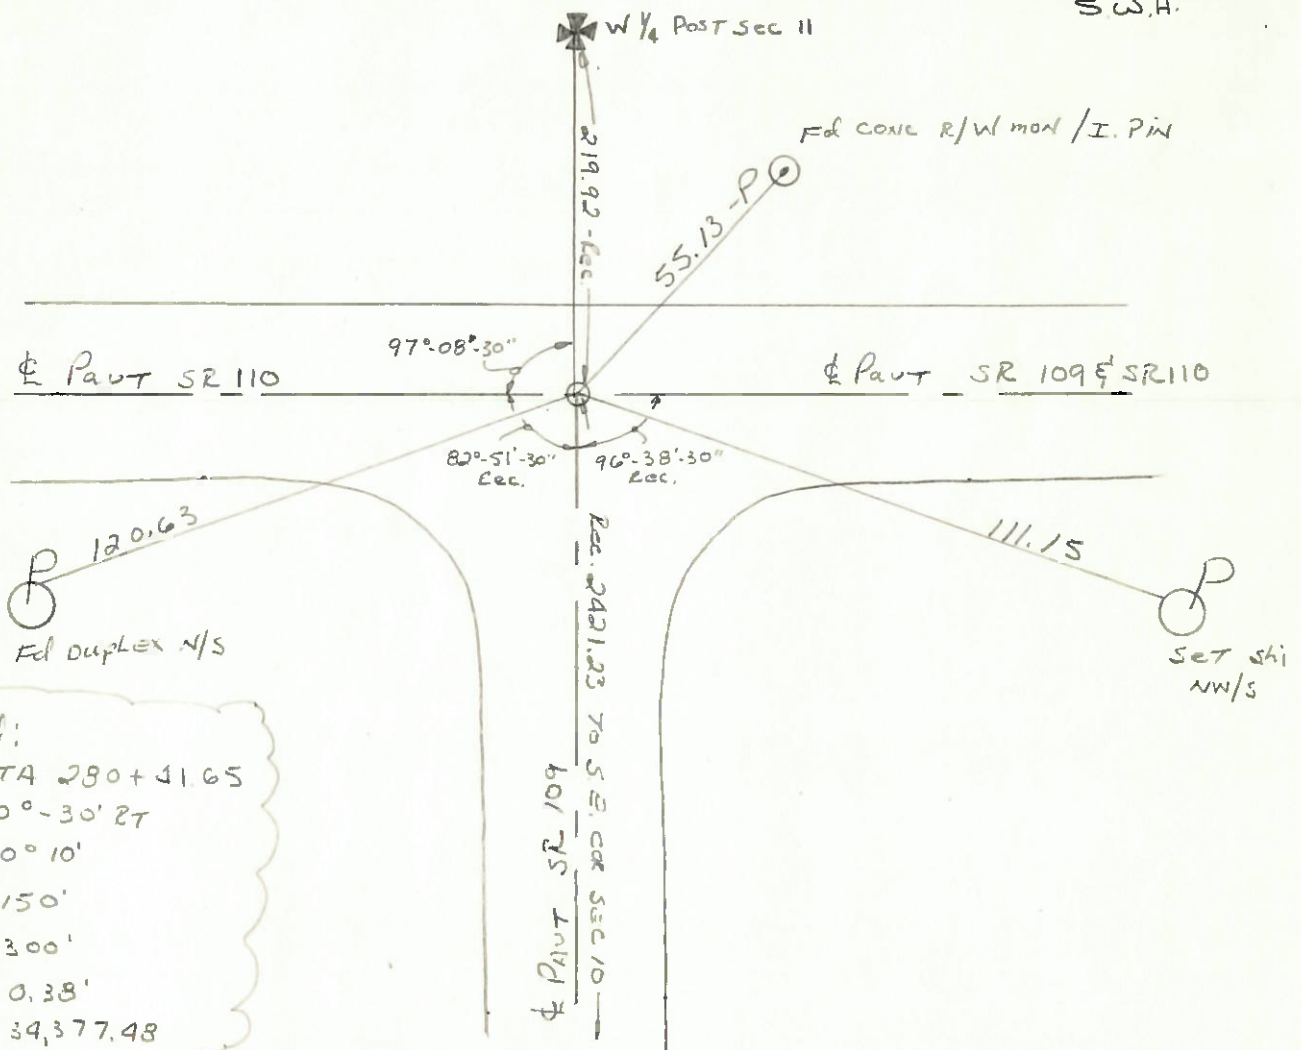

Record:

P.I. STA 290+41.65

$\Delta = 0^\circ-30'-27''$

$D = 0^\circ 10'$

$T = 150'$

$L = 300'$

$E = 0.38'$

$R = 34,377.48$

SHEET _____ OF _____

Date 3-19-84

Weather OVERCAST

Temp. +30°

24

LOEHRIKE

Householder R.C.

BARNHISEL H. C.

#36-109

SLM 52110 275 + 18 06

SLM SR 109 874 + ~~11.8~~ 02


ON ϕ BOTH PAVEMENTS

10.4' to $N. \in P_i$

SET SMALL RR SPIKE

8-23-84

S.W.H.

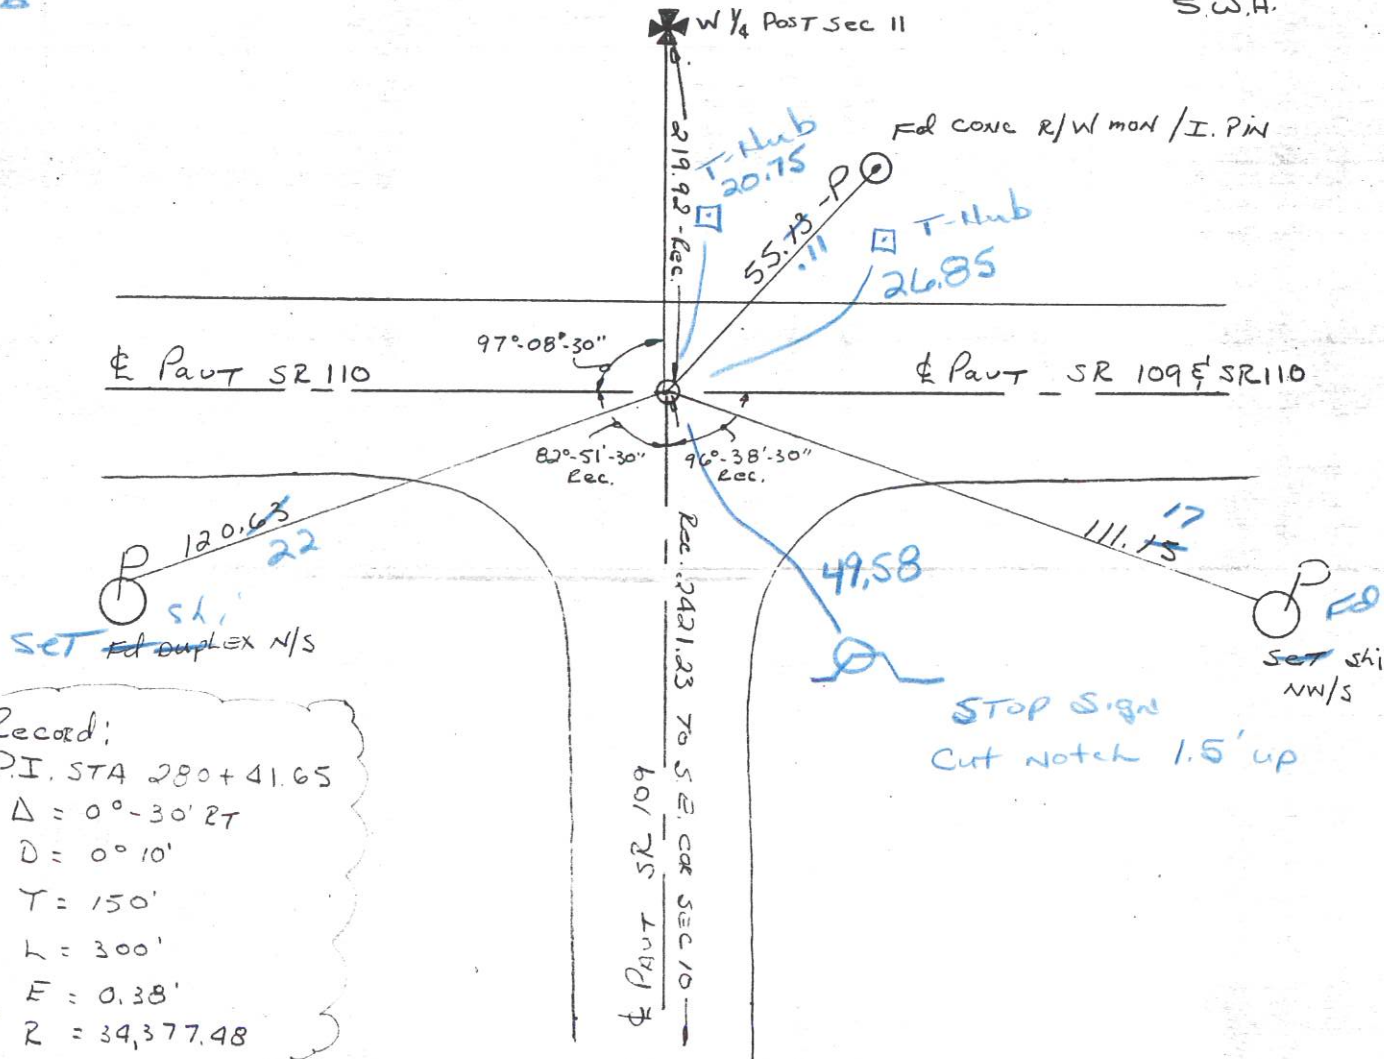

PERSONNEL TITLE PERSONNEL TITLE

COUNTY HENRYDATE DEC. 14, 1973TomsicNeuserVanyaCeranataS. R. 109

WEATHER

SEC.

TEMP. 32°

DESCRIPTION

LEFT

CENTER LINE

RIGHT

JOB NO.

