

O.D.O.T. DISTRICT 2 SURVEY OFFICE (USE ONLY)

PERSONNEL

REFERENCE NO. 36 A

SHEET 27 OF 36

NOTES BARNHISEL DATE 9/28/90

H.C. BARNHISEL WEATHER CLEAR

R.C. HOFFMAN TEMP. 65°

ROUTE SR 109

COUNTY HENRY

TOWNSHIP HARRISON

SECTION 11

DWG BY RHOADES PID PAVETRAIN

T 5 N R 7 E

TYPE MONUMENT P.K./WASHER

ON SURFACE - ~~BELOW~~ ON


OFFSET $\odot$ PAVEMENT ON LT : RT

10.7' TO RT EDGE PAVEMENT

STATION: 883+78±


HORIZ.DATUM: _____ GEOID: _____

GRID: NORTHING: _____ EASTING: _____

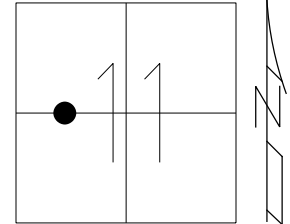

RECORD: P.O.T.
FD P.K.NAIL
SET P.K./WASHER
10-11-90, MB
D.N.F.
TIES CROSS
8-13-02, DCH
D.N.F.
12/20/21, DSA

NOTE: REF 12A SR 110

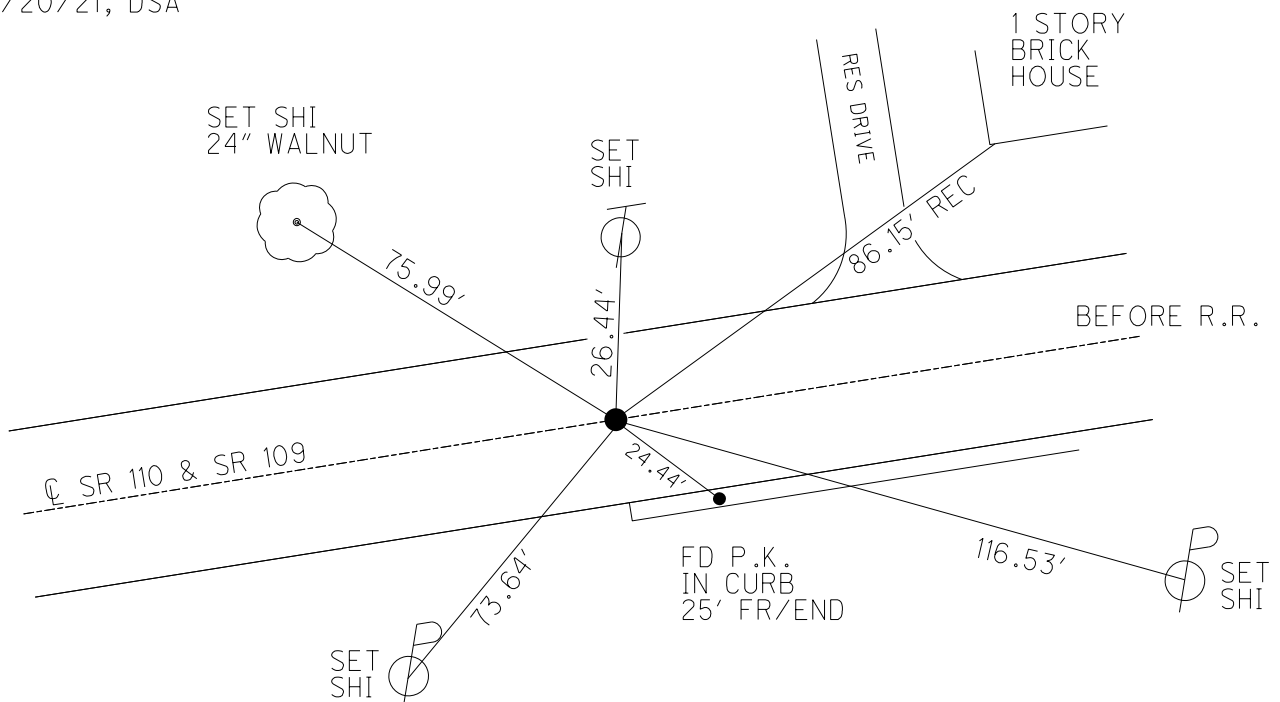

O.D.O.T. DISTRICT 2 SURVEY OFFICE

PERSONNEL _____

REFERENCE NO. _____

SHEET _____ OF _____

NOTES Homan

H.C. Ransom

R.C. Beaumont

DATE 8-13-02

WEATHER Sunny

TEMP. 80°F

ROUTE 109 & 110

COUNTY HENRY

TOWNSHIP HARRISON

SECTION 11

T.S. N R. 2 E


TYPE MONUMENT PK WASHER

ON SURFACE - BELOW YES

~~LEFT~~ - PAV'T. - ~~RIGHT~~ YES

TO EDGE PAVEMENT

S.L.M. _____

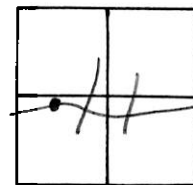

Record:
P.O.T.
Fwd PK Nail

10-11-90
Set PK/washer
M.B.

SET S4,
SW/S

26.30

RES. DRIVE

86.15
(REC)

SW CORNER
BRICK
1 STP

SR 109 + SR 110

93.64

FWD S4,
NE/S

116.53


FWD S4,
W/S

O.D.O.T. DISTRICT 2 SURVEY OFFICE (USE ONLY)

PERSONNEL	REFERENCE NO. <u>36 A</u>	SHEET <u>27</u> OF <u>38</u>	
NOTES <u>BARNHISEL</u>	DATE <u>9-28-90</u>	ROUTE <u>SR 109</u>	
H.C. <u>BARNHISEL</u>	WEATHER <u>CLEAR</u>	COUNTY <u>HENRY</u>	
R.C. <u>HOFFMAN</u>	TEMP. <u>65°F</u>	TOWNSHIP <u>HARRISON</u>	
		SECTION <u>11</u>	
		T <u>5</u> N R <u>7</u> E	

TYPE MONUMENT PK/WASHER
 ON SURFACE - ~~BELOW~~ ON
 LEFT - ℄ PAV'T - RIGHT ON
10.7' TO RT EDGE PAVEMENT
 S.L.M. 883+78

Grid: Northing: - _____ Easting: - _____

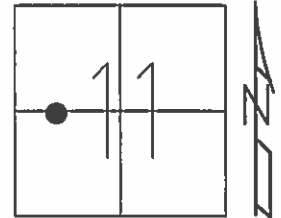


RECORD:
 POT
 FD PK NAIL

NOTE: BEFORE R.R.

SET PK/WASHER
 10-11-90, MB

REF TIES CROSS
 NO NAIL FD
 8-13-02, DH

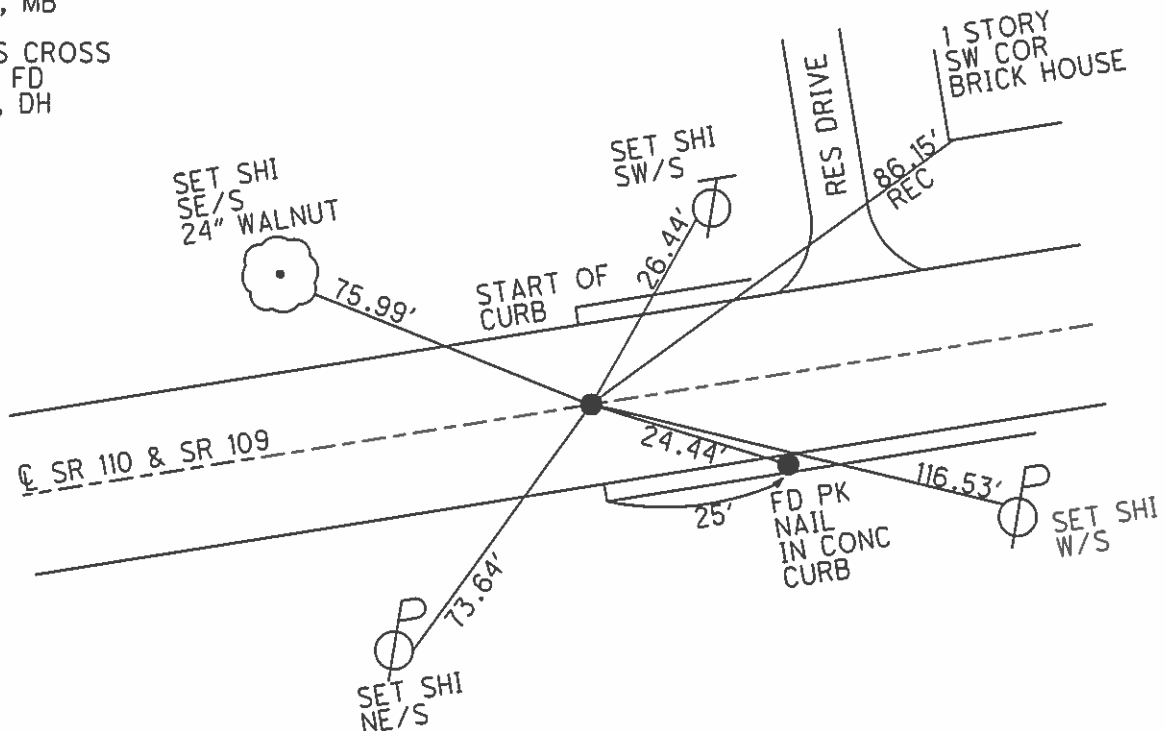

O.D.O.T. DISTRICT 2 SURVEY OFFICE

PERSONNEL

REFERENCE NO. 36A

SHEET 2 OF 9

NOTES BARNHISEL

H.C. " "

R.C. HOFFMAN

DATE 9-28-90

WEATHER Clear

TEMP. +65°

ROUTE 109 & 110

COUNTY HENRY

TOWNSHIP HARRISON

SECTION 11

T 5 N R 7 E


TYPE MONUMENT P.K. & Washer

ON SURFACE - BELOW yes

LEFT - & PAV'T. - RIGHT yes

10.7 TO RT EDGE PAVEMENT

S.L.M. 883+78

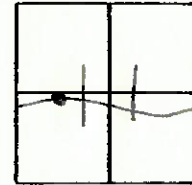


Record: P.O.T.
Fd PK NAIL

Set P.K. & Washer
10-11-90
mB

Note:
Ref. Ties close
No Nail Fd.
D.H.
8-13-02

S.W. COR
BEICK
1-5 1/2 House

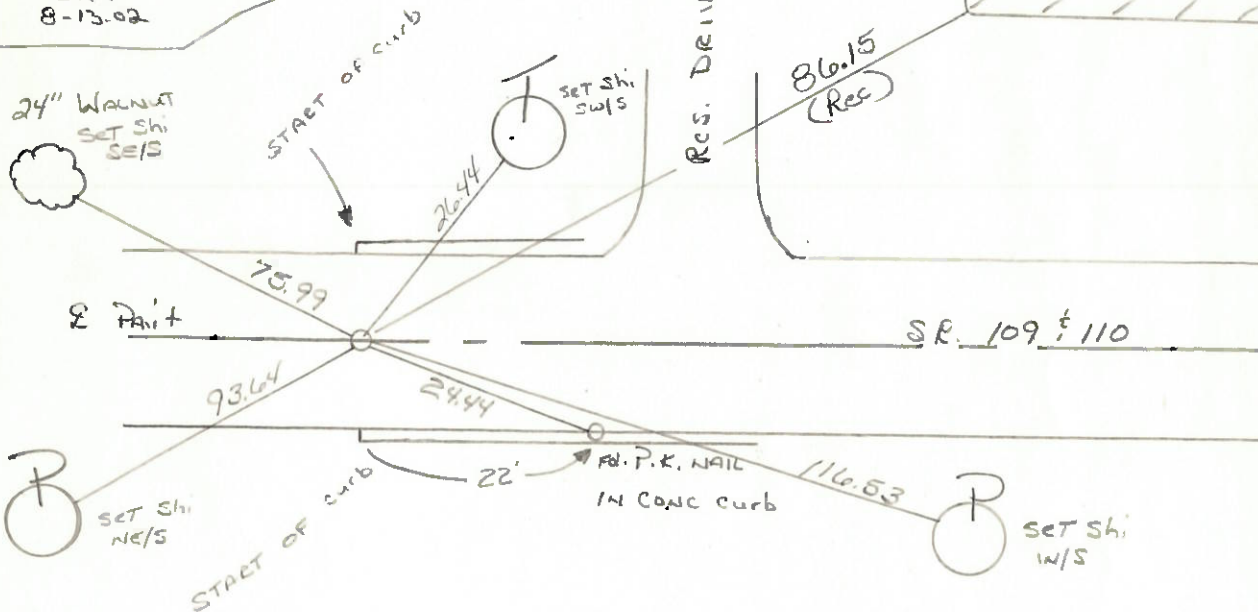

SHEET _____ OF _____

Date 3-23-84

Weather Clear

Temp. +25°

LEONARD

Householder

BARNHISEL

Die Not-Finanz-point

SL14 383 + 10

SET PK./WASHE


8-24-84

S.W. COR
Brick
Eas

$$0 \sim \in P_{AVT}$$

10.3 To L+EP

10.7 T₀ R₁ EP

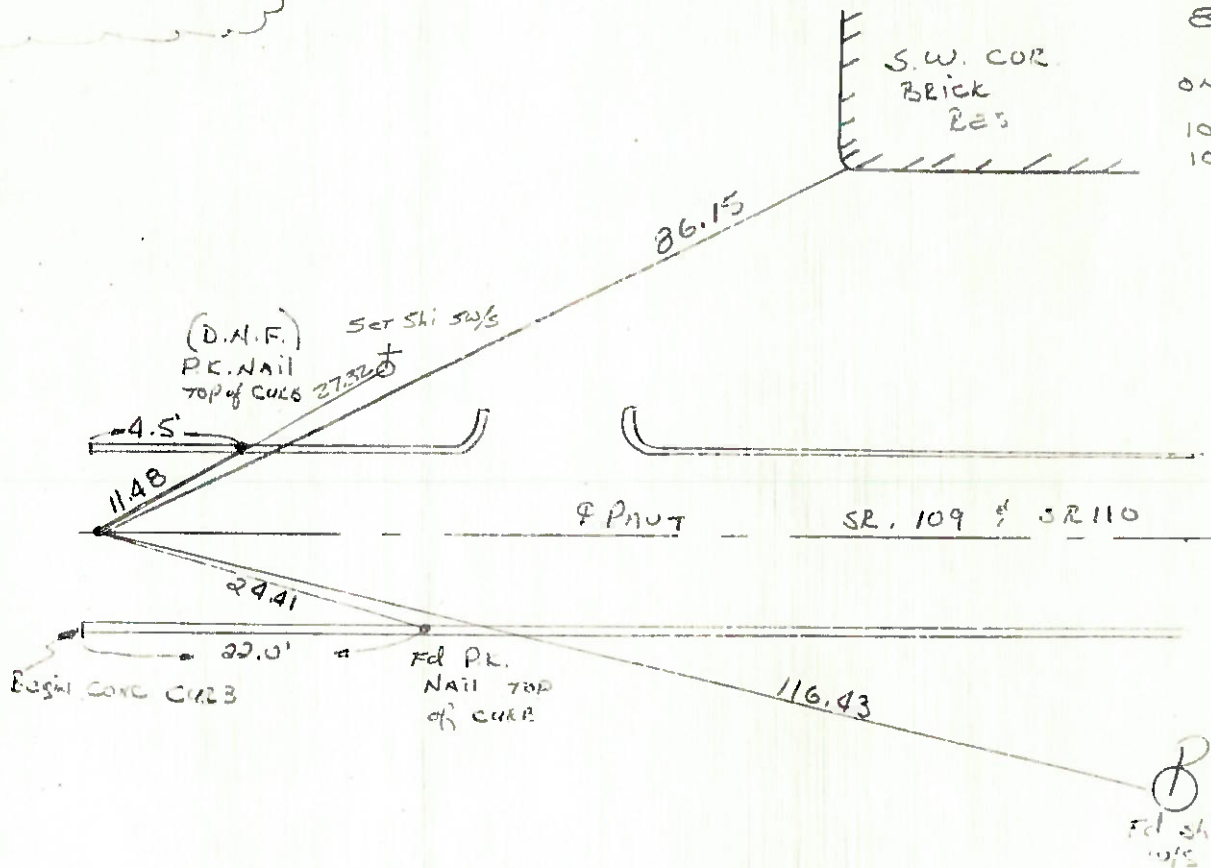

Q.D.O.T. DISTRICT 2 SURVEY OFFICE

SHEET _____ OF _____

County HENRY S.R. 109 & 52110

Township HARRISON

Section 11

TSN, RSE

Personnel HOFFMAN

LOEHRKE


HOUSEHOLDER

BARNHISEL

Date 3-23-84

Weather Clear

Temp. +25°

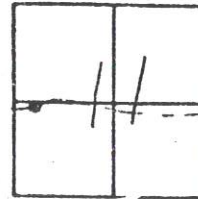

Record: P.O.T.
Fcl P.K. Nail

DID NOT FIND POINT

SLM 883+90 78

SET P.K./WASHER

8-24-84

ON & PAVT

10.3 TO L+EP

10.7 TO R+EP

S.W. COR.
BRICK
RES

86.15

SET NEW
26.44

SET SHI SW/S

(D.N.F.)

P.K. NAIL

TOP of CURB

4.5'

11.48

& Pnut

SR. 109 & 52110

24.41

22.01

Begin CONC CURB

Fcl P.K.
NAIL TOP
of CURB

116.45 53

SET Fcl shi
w/s

set 24" Walnut

75.99

93.64

B

P