

O.D.O.T. DISTRICT 2 SURVEY OFFICE (USE ONLY)

PERSONNEL

REFERENCE NO. 36 C

SHEET 29 OF 36

NOTES BARNHISEL

DATE 9/28/90

ROUTE SR 109

H.C. BARNHISEL

WEATHER CLEAR

COUNTY HENRY

R.C. HOFFMAN

TEMP. 65°

TOWNSHIP HARRISON

SECTION 11

DWG BY RHOADES PID CHIP SEAL

T 5 N R 7 E

TYPE MONUMENT P.K./WASHER

ON SURFACE - ~~BELOW~~ ON

OFFSET Q PAVEMENT 5.9' LT : ~~RT~~

6.1' TO LT EDGE PAVEMENT


STATION: 887+71.94

HORZ. DATUM: _____

GEOID: _____


GRID: NORTHING: _____

EASTING: _____

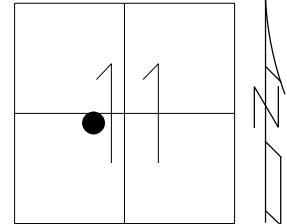

RECORD: P.I.
 $\Delta=9^{\circ}36'$ RT
 FD P.K./WASHER
 9/28/90, MB
 SET P.K./WASHER
 10-11-90, MB
 D.N.F.
 8/31/15, JFO

NOTE: REF 13 A SR 110

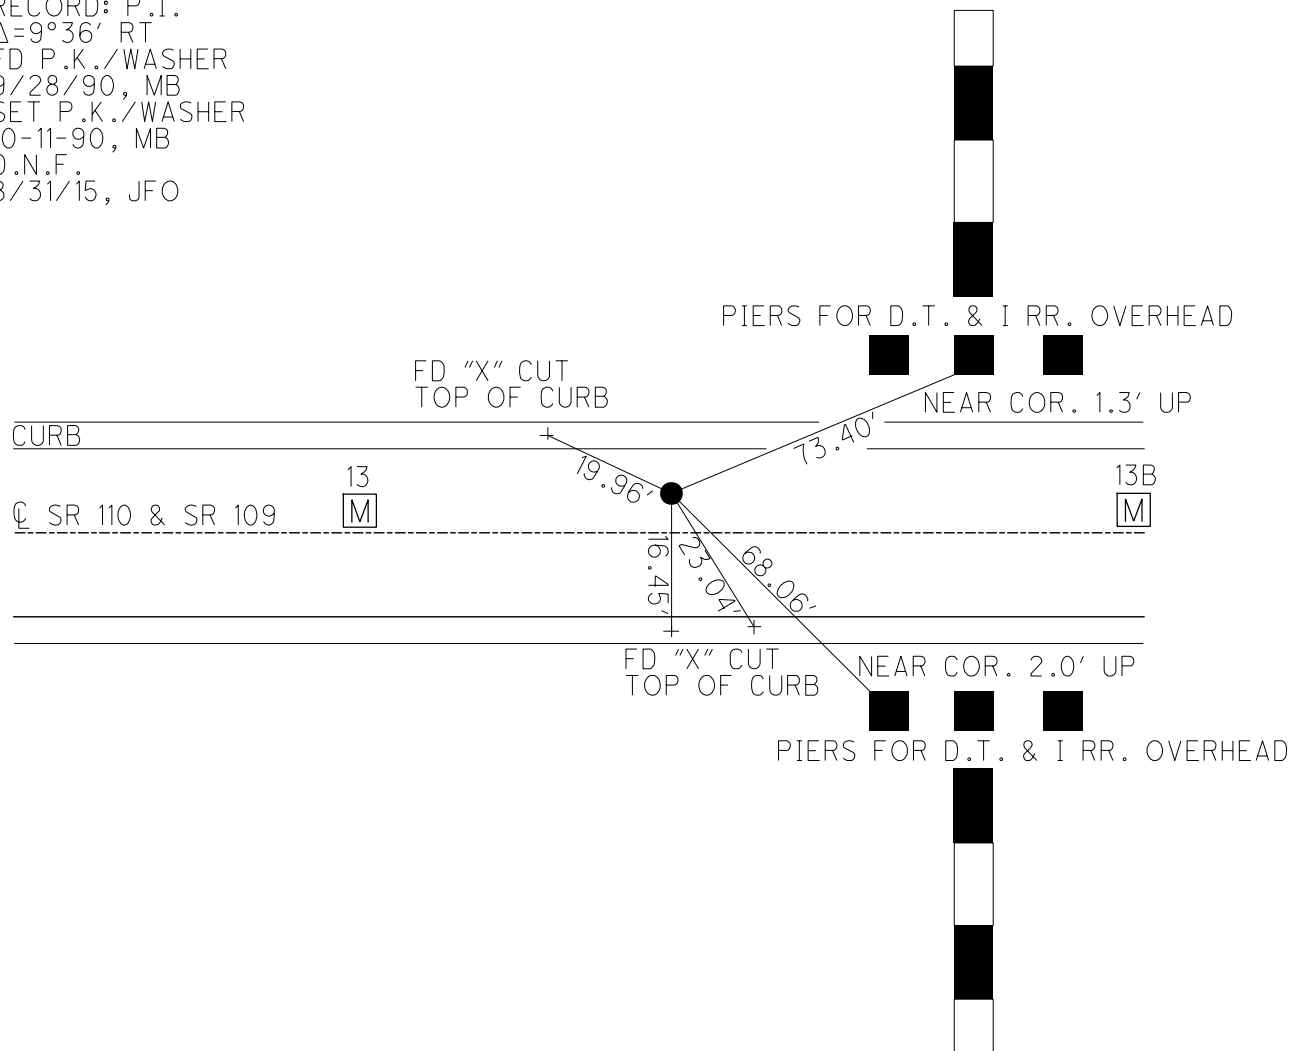

O.D.O.T. DISTRICT 2 SURVEY OFFICE

PERSONNEL

REFERENCE NO. 13/SR.110

SHEET _____ OF _____

NOTES HOMAN

H.C. HOMAN

R.C. BEAUMONT

DATE 8-13-02

WEATHER SUNNY

TEMP. 80°

ROUTE 109 4110

COUNTY HENRY

TOWNSHIP HARRISON

SECTION 11

T5 N R 7 E



TYPE MONUMENT PK + WASHER

ON SURFACE - BELOW YES

LEFT - & PAV'T. - RIGHT 5.9'

6.1 TO LT. EDGE PAVEMENT

S.L.M. 887+59

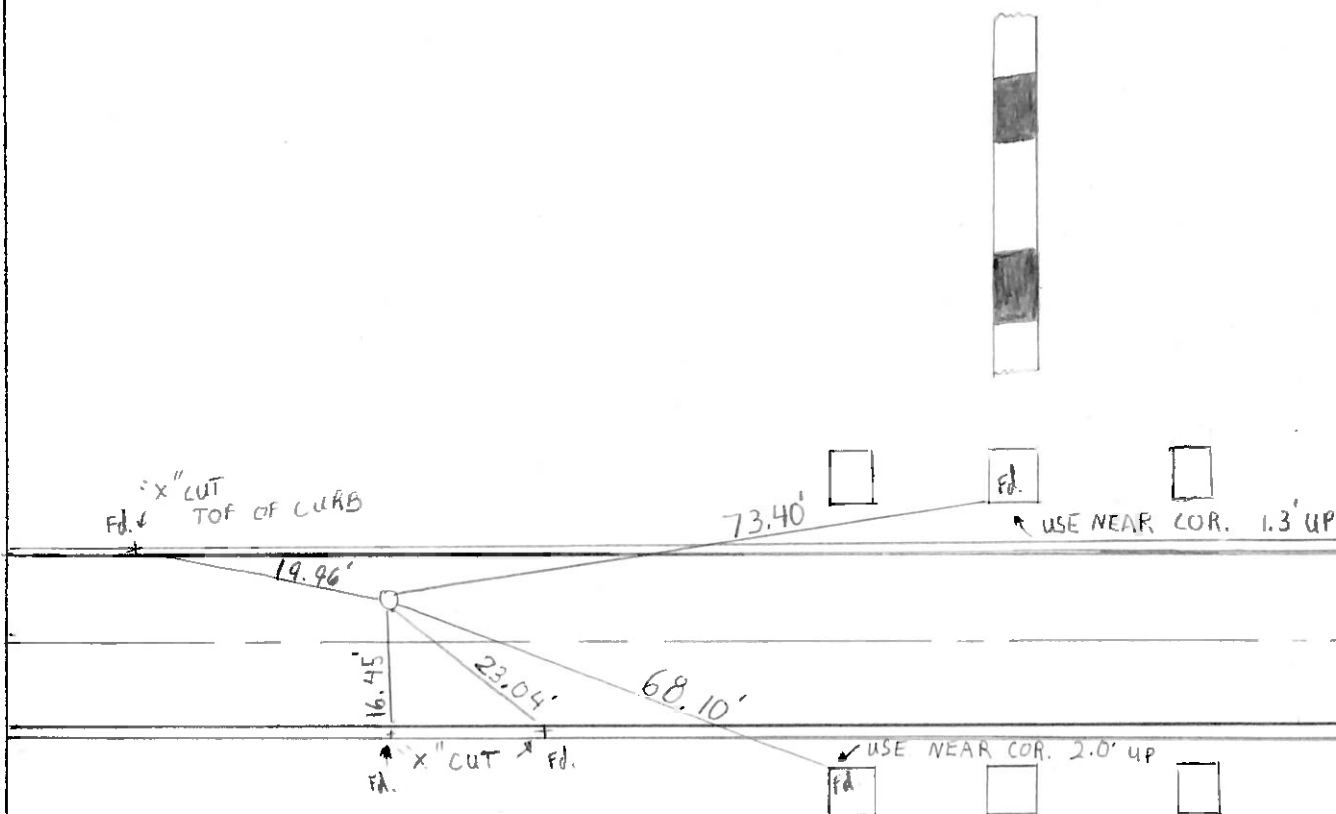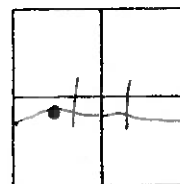

Record:

Pt.

$$\Delta = 9^{\circ} 36' \text{ RT}$$

SET P.K. NAIL 48' N. OF & PAINT

USED SPLIT ON TANGENT OF


CURB TO ESTABLISH

O.D.O.T. DISTRICT 2 SURVEY OFFICE (USE ONLY)

PERSONNEL _____ REFERENCE NO. 36 B SHEET 29 OF 38


NOTES BARNHISEL DATE 9-28-90 ROUTE SR 109
H.C. BARNHISEL WEATHER CLEAR COUNTY HENRY
R.C. HOFFMAN TEMP. 65°F TOWNSHIP HARRISON
SECTION 11
T 5 N R 7 E

TYPE MONUMENT PK/WASHER
ON SURFACE - ~~BELOW~~ ON _____
LEFT - Q PAV'T - ~~RIGHT~~ 5.9'
6.1' TO LT EDGE PAVEMENT
S.L.M. 887+59
Grid: Northing: - _____ Easting: - _____

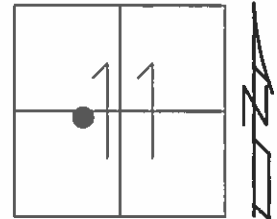

RECORD:
P.I. $\Delta=9^{\circ}36'$ RT
USED SPLIT ON TANGENT
OF CURB TO ESTABLISHED

SET PK/WASHER
10-11-90, MB

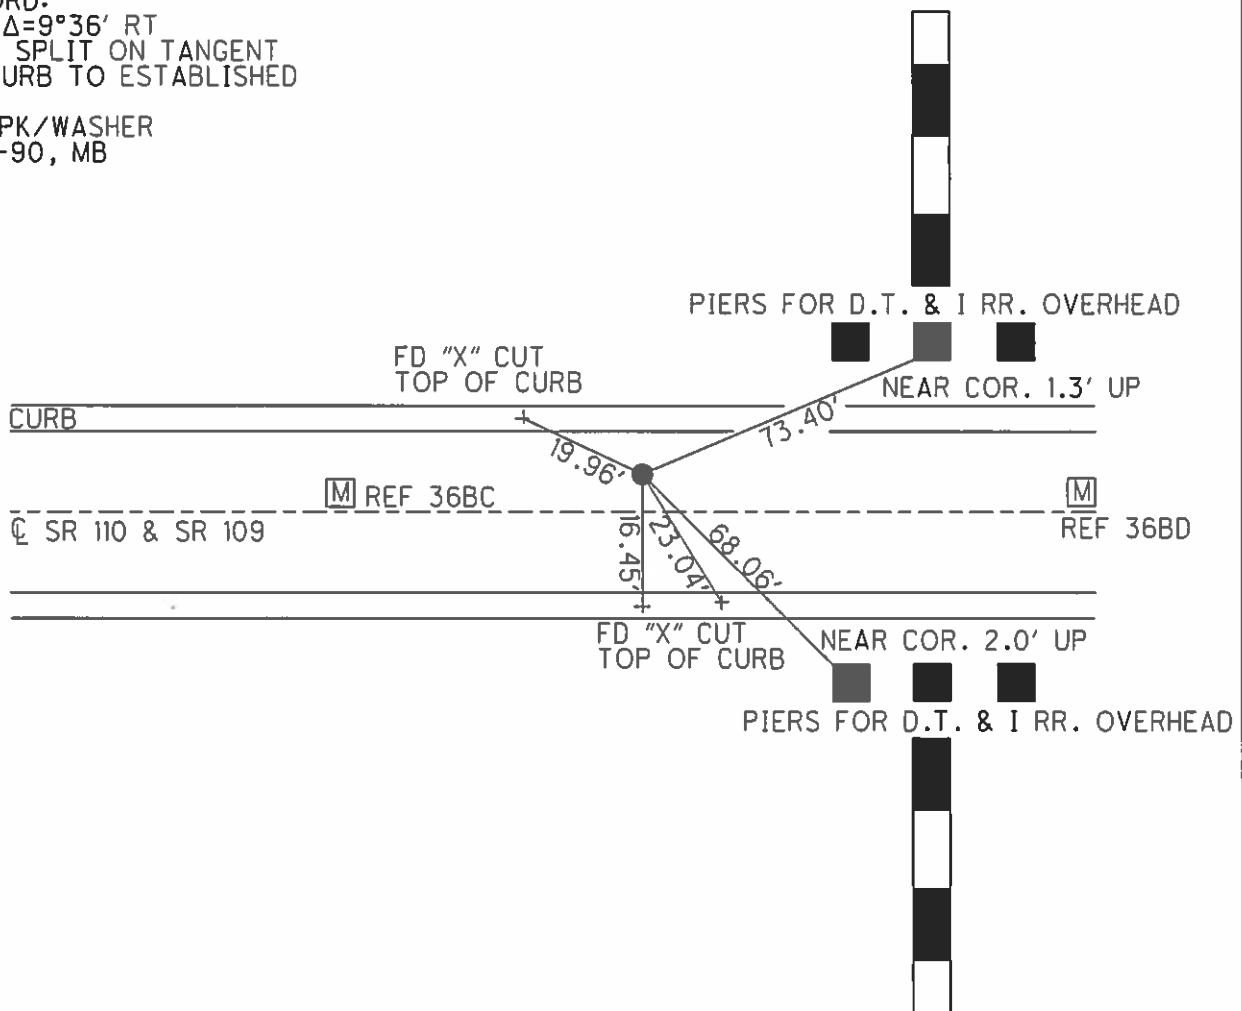

O.D.O.T. DISTRICT 2 SURVEY OFFICE

PERSONNEL

REFERENCE NO. 13/SR 110
36 B

SHEET 3 OF 9

NOTES BARNHISEL

H.C. " "

R.C. HOFFMAN

DATE 9-28-90

WEATHER clear

TEMP. +65°

ROUTE 109 & 110

COUNTY HENRY

TOWNSHIP HARRISON

SECTION 11

T 5 N R 7 E


TYPE MONUMENT PK & Washer

ON SURFACE - ~~BELOW~~ YES

LEFT- & PAV'T. - RIGHT 5.9

6.1 TO RT EDGE PAVEMENT


S.L.M. 887 + 59

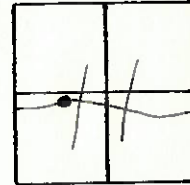

RECORD: P.I.
 $\Delta = 7^\circ 36' RT$
Set P.K. NAIL 4.8' N. of & PAVT
USED SPIT ON TARGET OF
CURB TO ESTABLISH

Set P.K. & Washer
10-11-90
MB

NOTE:
ALL TIES CROSS
No Nail Fd.
8-13-93
D.H.

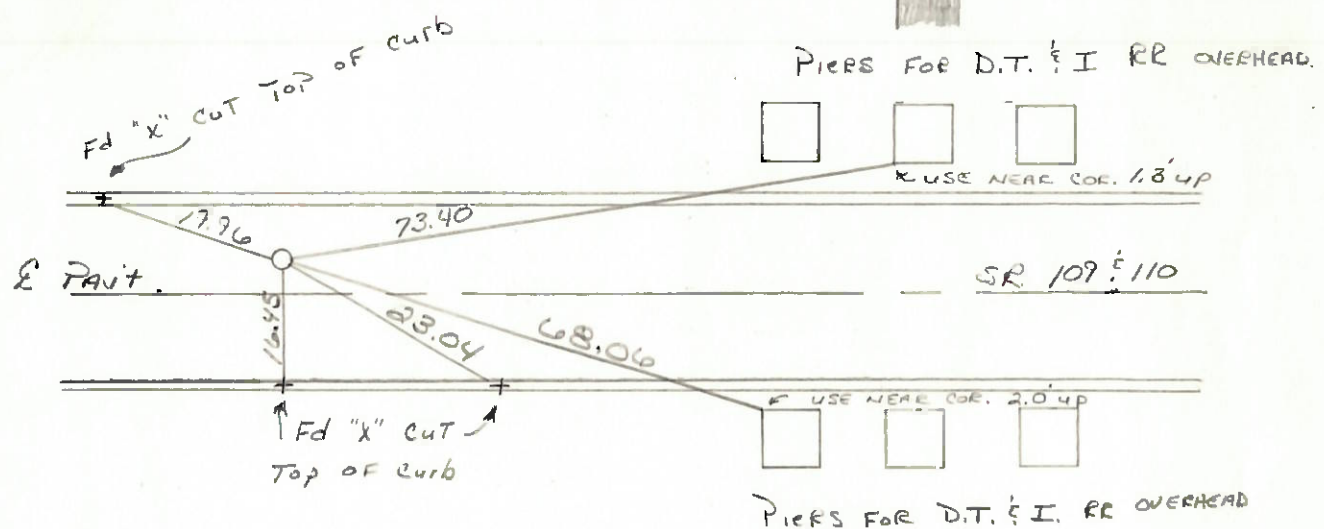

ODOT DISTRICT 2 SURVEY OFFICE

SHEET _____ OF _____

County HENRY S.R. 109 & SR 110

Township HARRISON

Section 11

T&N, RZE

Personnel HOFFMAN

LOEHKE

HOUSEHOLDER R.C.


BARNHISEL H.C.

#13 02110

Date 3-23-84

Weather Clear

Temp. +25°

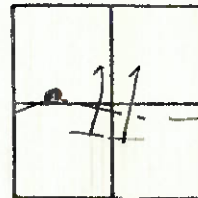

Record: P.I.
 $\Delta = 9^{\circ}-36' RT.$
 Set P.K. Nail 4.8' N. of ϕ PAUT
 USED SPLIT ON TANGENT of
 CURB TO ESTABLISH

S.L.M. 887+71.5

DID NOT FIND
 RESET AFTER PROJECT
 IS completed

SET PK/WASHER


8-24-84

S.W.H.

5.9 L+ of ϕ PAUT

6.12 to Lt EP

16.15 to Rt EP

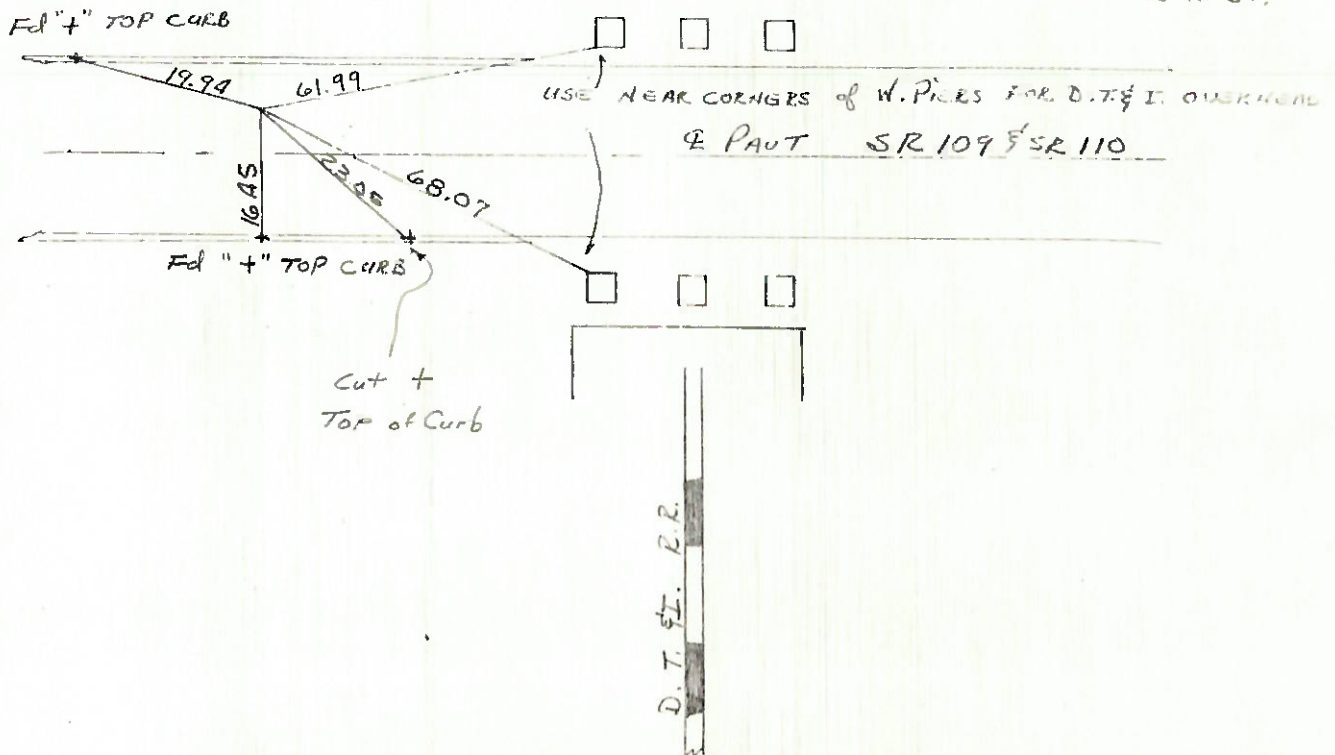

Q.D.O.T. DISTRICT 2 SURVEY OFFICE

SHEET _____ OF _____

County HENRY S.R. 109 & SR 110

Township HARRISON

Section 11

T.S.N., R.ZE

Personnel HOFFMAN

#13 SR 110

LOEBKE


HOUSEHOLDER R.C.

BARNHISEL H.C.

Date 3-23-84

Weather Clear

Temp. +25°

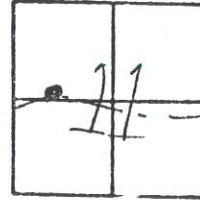

Record: P.I.
 $\Delta = 9^{\circ}-36' RT.$
 Set P.K. Nail 4.8' N. of & PAUT
 USED SPLIT ON TARGET of
 CURB TO ESTABLISH

S.L.M. 887+ ~~71.5~~ 59

DID NOT FIND
 RESET AFTER PROJECT
 IS completed

SET PR/WASHER

8-24-84

S.W.H.

5.9 Lt of & PAUT
6.12 to Lt EP FC
16.15 to Rt EP, curb

