

O.D.O.T. DISTRICT 2 SURVEY OFFICE (USE ONLY)

PERSONNEL

REFERENCE NO.

36 C

SHEET

31

OF 38

NOTES

HOMAN

DATE

8-13-02

ROUTE

SR 109

H.C.

ROUSOS

WEATHER

CLOUDY

COUNTY

HENRY

R.C.

BEAUMONT

TEMP.

80°F

TOWNSHIP

HARRISON

SECTION

11

T 5 N R 7 E

TYPE MONUMENT

PK/WASHER

ON SURFACE - ~~BELOW~~


ON

LEFT - Q PAV'T - ~~RIGHT~~ 6.3'

4' TO LT EDGE PAVEMENT


S.L.M. 899+55

Grid: Northing: - Easting: -

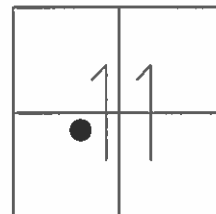

RECORD: P.I.
 $\Delta=3^{\circ}17'30''$ RT

SET MAG/WASHER
9-20-02, DCH

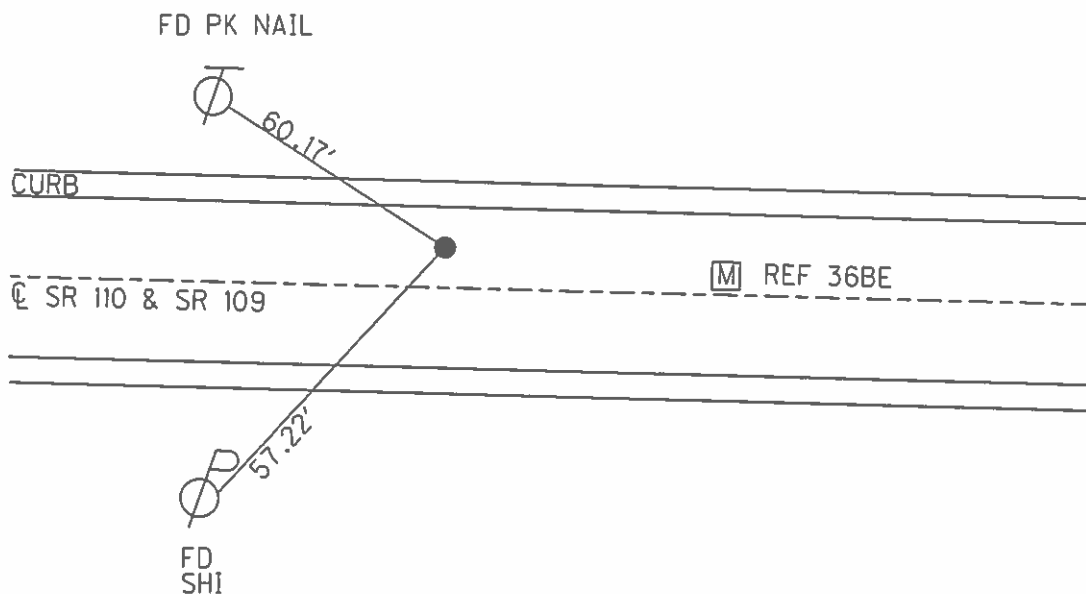

O.D.O.T. DISTRICT 2 SURVEY OFFICE

PERSONNEL

REFERENCE NO. 36C

SHEET 4 OF 9

NOTES HOMAN

DATE 8-13-02

ROUTE S.R. 109

H.C. ROUSOS

WEATHER CLOUDY

COUNTY HENRY

R.C. BEAUMONT

TEMP. 80

TOWNSHIP HARRISON

SECTION 11

T 5 N R 7 E


TYPE MONUMENT PK & WASHER

ON SURFACE - ~~BELOW~~ ON

LEFT - ~~Q PAVT~~ - ~~RIGHT~~ 6.3'

4' TO LT EDGE PAVEMENT

S.L.M. 899+55

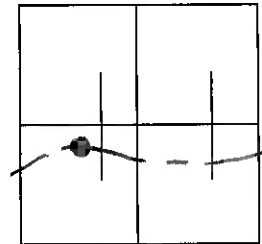

RECORD P.I.

$\Delta = 3^{\circ} 17' 30''$ RT

SET MAG NAIL

& WASHER

9-20-02

DCH

Fd
PK Nail

60.17'

Q PAVT

Q S.R. 109 & 110

57.22'

P
Fd Sh
NE/S

O.D.O.T. DISTRICT 2 SURVEY OFFICE

PERSONNEL

REFERENCE NO. _____

SHEET _____ OF _____

NOTES BARNHISEL

H.C. " " "

R.C. HOFFMAN

DATE 9-28-90

WEATHER CLEAR

TEMP. +65°

ROUTE 109 & 110

COUNTY HENRY

TOWNSHIP HARRISON

SECTION 11

T 5 N R 7 E


TYPE MONUMENT P.K. & Washer

ON SURFACE - BELOW yes

LEFT- & PAV'T. - RIGHT 6.3


4.1 TO LT EDGE PAVEMENT

S.L.M. 899+55

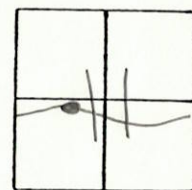

RECORD: P.I.
Δ = 30° = 17' 30" RT

Set P.K. & Washer
10-11-90
mB

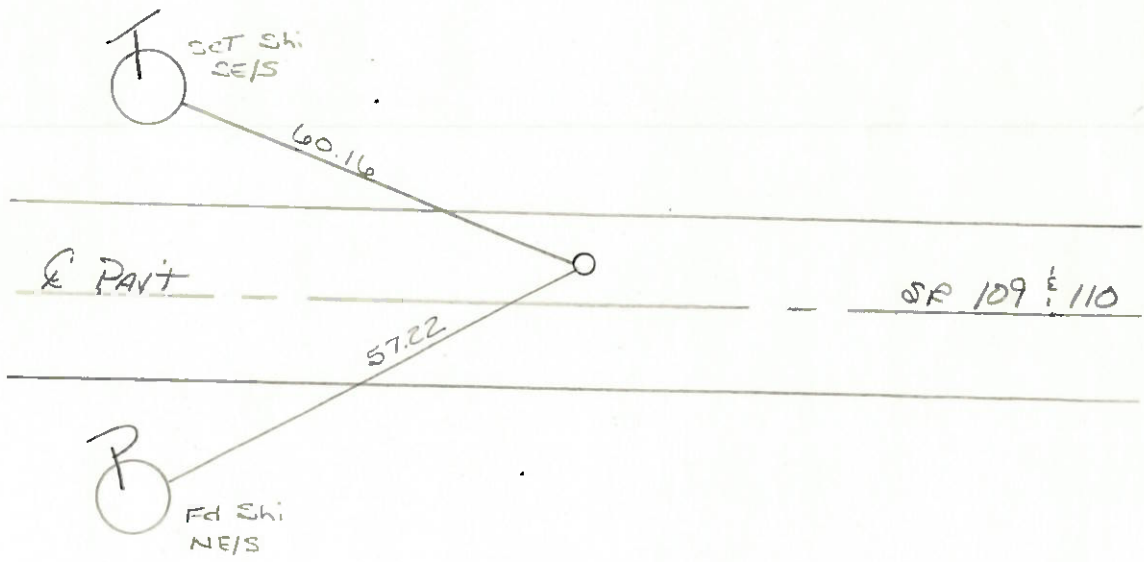

ODOT. DISTRICT 2 SURVEY OFFICE

SHEET _____ OF _____

County HENRY S.R. 109 & SR 110

Date 3-23-84

Township HARRISON

Weather clear

Section 11

Temp. +25°


TSN, RZE

Personnel HOFFMAN

LOEHRKE

HOUSEHOLDER

BARNHISEL

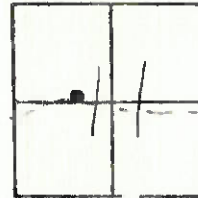

Fd P.K. Nail 1" Below Surface

S.L.M. 899+69

6.2' Lt of & Post

2.4' to Lt. EP

15.4' to Rt. EP

Record: P.I.

$\Delta = 3^\circ - 17' - 30'' R$

SET PK/WASHER

8-24-84

S.W.H.

Fd shi
LE/S



57.84

SR 109 & SR 110

& Post

Fd shi
NE/S



57.22

Q.D.O.T. DISTRICT 2 SURVEY OFFICE

SHEET _____ OF _____

County HENRY S.R. 109 & SR 110

Township HARRISON

Section 11

TSN, RZE

Personnel HOFFMAN

LOEHKE


HOUSEHOLDER

BARNHISEL

Date 3-23-84

Weather clear

Temp. +25°

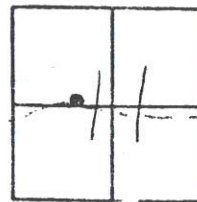

Fd P.K. Nail 1" Below Surface

S.L.M. 899 + 69 55

6.3 ~~6.2'~~ Lt. of & Pavt

4.1 ~~2.4'~~ TO Lt. EP

~~15.4'~~ TO RT. EP

Record: P.I.

$\Delta = 3^{\circ}-17'-30''$ RT.

SET PK/WASHER

8-24-84

S.W.H.

