

O.D.O.T. DISTRICT 2 SURVEY OFFICE (USE ONLY)

PERSONNEL

REFERENCE NO. 37

SHEET 32 OF 36

NOTES ASTON

DATE 5/25/23

ROUTE SR 109

H.C. AUBLE

WEATHER CLOUDY

COUNTY HENRY

R.C. MILLER

TEMP. 54°

TOWNSHIP HARRISON

DWG BY RHOADES

PID PAVETRAIN

SECTION 11

T 5 N R 7 E

TYPE MONUMENT MAG NAIL

ON SURFACE - ~~BELOW~~ ON

OFFSET CL PAVEMENT 1.7' LT : RT

9' TO RT EDGE PAVEMENT


STATION: 914+09.80

HORZ.DATUM: NAD83 2011

GEOID: NAVD88 2018


GRID: NORTHING: 637429.609

EASTING: 1550572.496

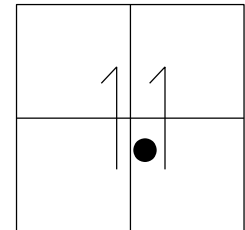


NOTE: REF 13E SR 110

RECORD: P.I.
STA. 914+09
 $\Delta = 5^\circ 45' \text{ LT}$
FD SM.R.R.SPIKE
2" DOWN
3/23/84, SWH
SET P.K./WASHER
8/24/84, SWH
FD P.K./WASHER
8/13/02, DCH
SET MAG/WASHER
12/2/02, DCH
FD HOLE
REFE13
8/31/15, JFO
SET MAG NAIL
REF13E
5/25/23, DSA
FD MAG NAIL
7-2-24, TDN

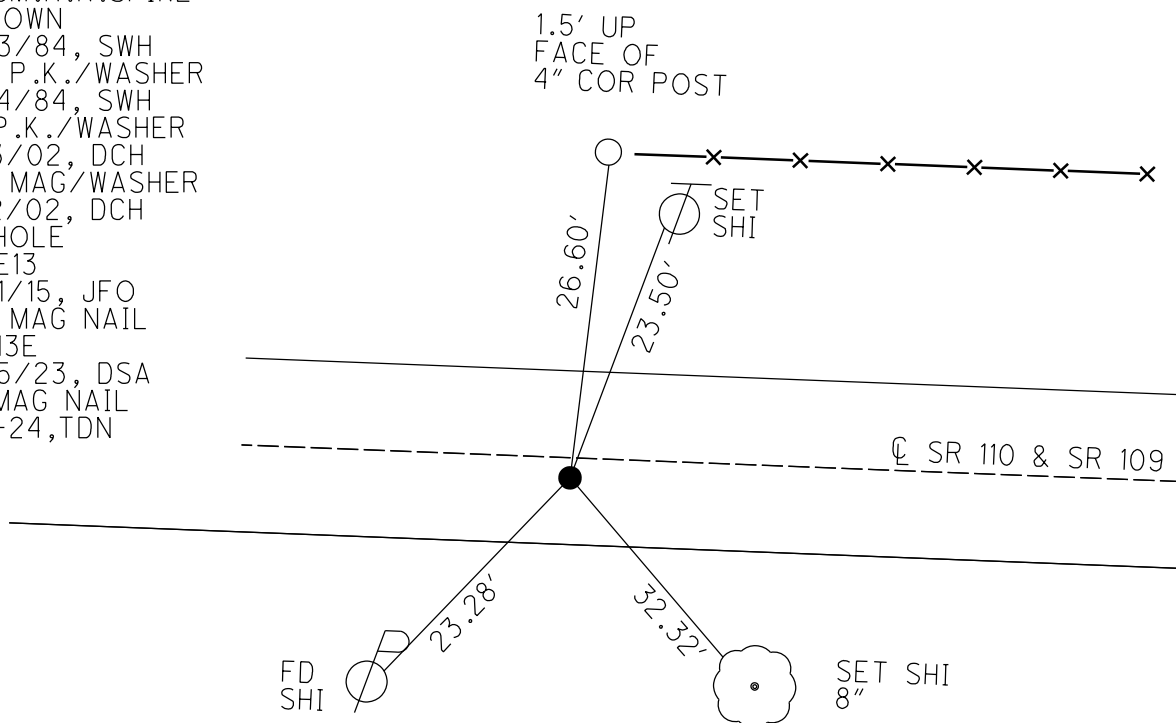


O.D.O.T. DISTRICT 2 SURVEY OFFICE (USE ONLY)

PERSONNEL	REFERENCE NO. <u>37</u>	SHEET <u>32</u> OF <u>36</u>
NOTES <u>ASTON</u>	DATE <u>5/25/23</u>	ROUTE <u>SR 109</u>
H.C. <u>AUBLE</u>	WEATHER <u>CLOUDY</u>	COUNTY <u>HENRY</u>
R.C. <u>MILLER</u>	TEMP. <u>54°</u>	TOWNSHIP <u>HARRISON</u>
		SECTION <u>11</u>
DWG BY <u>RHOADES</u>	PID <u>PAVETRAIN</u>	T <u>5</u> N R <u>7</u> E
TYPE MONUMENT <u>MAG NAIL</u>		
ON SURFACE - BELOW <u>ON</u>		
OFFSET <u>CL</u> PAVEMENT <u>1.7'</u> LT : RT		
<u>9'</u> TO <u>RT</u> EDGE PAVEMENT		
STATION: <u>914+09.80</u>		
HORZ.DATUM: <u>NAD83 2011</u>		GEOID: <u>NAVD88 2018</u>
GRID: NORTHING: <u>637429.609</u>		EASTING: <u>1550572.496</u>

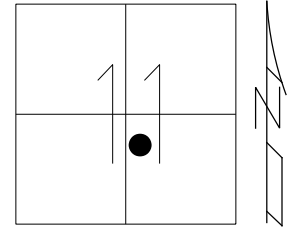

NOTE: REF 13E SR 110

RECORD: P.I.
STA. 914+09
 $\Delta = 5^\circ 45'$ LT
FD SM.R.R.SPIKE
2" DOWN
3/23/84, SWH
SET P.K./WASHER
8/24/84, SWH
FD P.K./WASHER
8/13/02, DCH
SET MAG/WASHER
12/2/02, DCH
FD HOLE
REFE13
8/31/15, JFO
SET MAG NAIL
REF13E
5/25/23, DSA

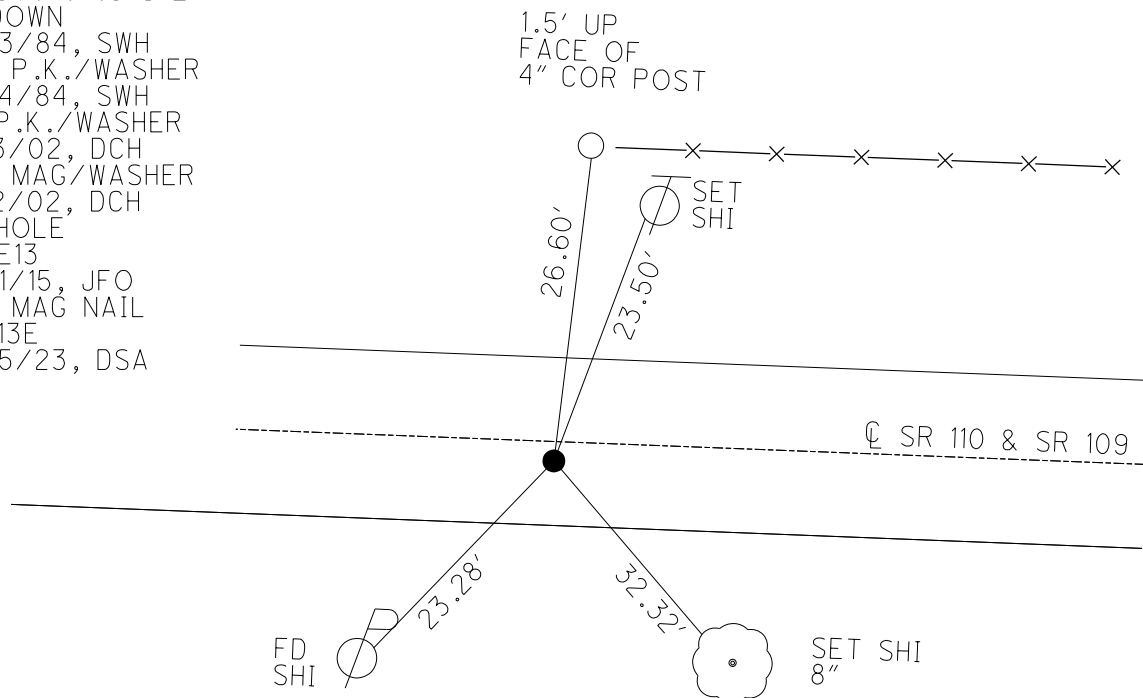


O.D.O.T. DISTRICT 2 SURVEY OFFICE (USE ONLY)

PERSONNEL _____ REFERENCE NO. 37 SHEET 33 OF 38
 NOTES HOMAN DATE 8-13-02 ROUTE SR 109
 H.C. ROUSOS WEATHER CLOUDY COUNTY HENRY
 R.C. BEAUMONT TEMP. 80°F TOWNSHIP HARRISON
 _____ SECTION 11
 _____ T 5 N R 7 E


TYPE MONUMENT PK/WASHER
 ON SURFACE - ~~BELOW~~ ON _____
~~LEFT~~ - Q PAV'T - RIGHT 1.7'
9' TO RT EDGE PAVEMENT
 S.L.M. 913+94

Grid: Northing: - _____ Easting: - _____

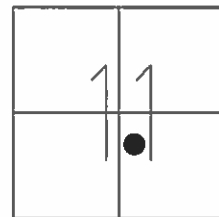

RECORD: P.I.
 $\Delta = 5^{\circ}45'00''$ LT

SET MAG/WASHER
 12-2-02, DCH

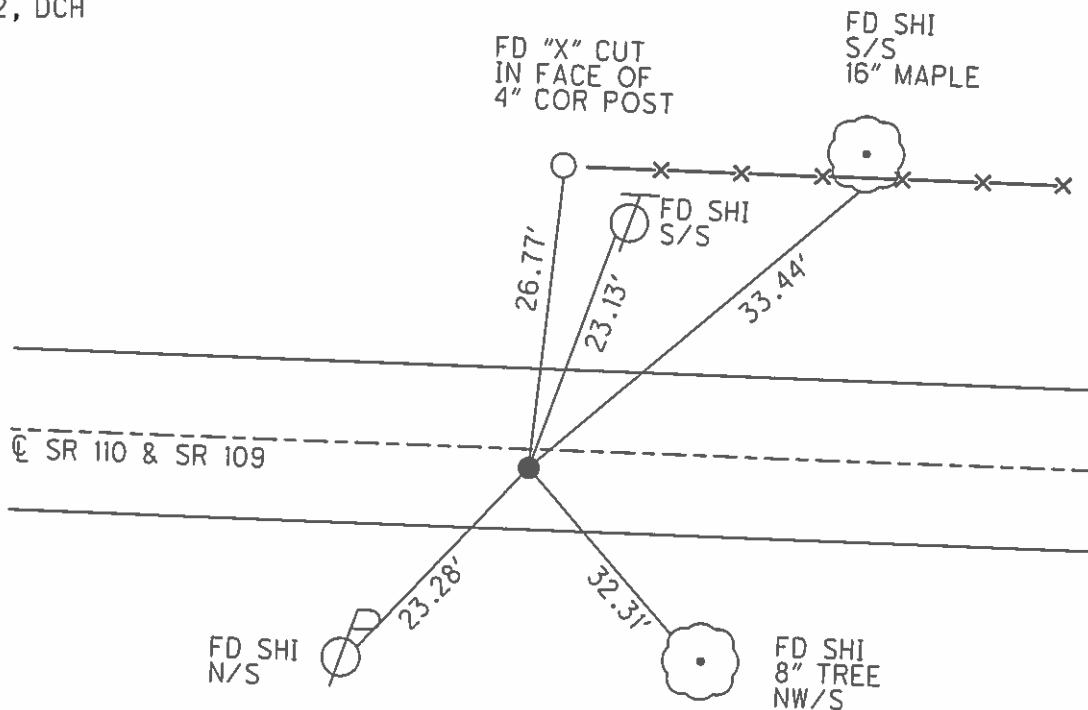

O.D.O.T. DISTRICT 2 SURVEY OFFICE

PERSONNEL

REFERENCE NO. 37

SHEET 5 OF 9

NOTES HOMAN

DATE 8-13-02

ROUTE S.R. 109

H.C. ROUSOS

WEATHER CLOUDY

COUNTY HENRY

R.C. BEAUMONT

TEMP. 80

TOWNSHIP HARRISON

SECTION 11

T 5 N R 7 E


TYPE MONUMENT PK & WASHER

ON SURFACE - ~~BELOW~~ ON

LEFT - ~~C PAVT~~ - RIGHT 1.7'


9' TO RT EDGE PAVEMENT

S.L.M. 913+94

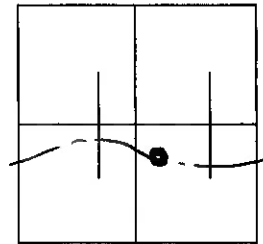

RECORD P.I.
 $\Delta = 5^{\circ} 45' 00''$ LT

SET MAG NAIL
& WASHER
12-02-02
DCH

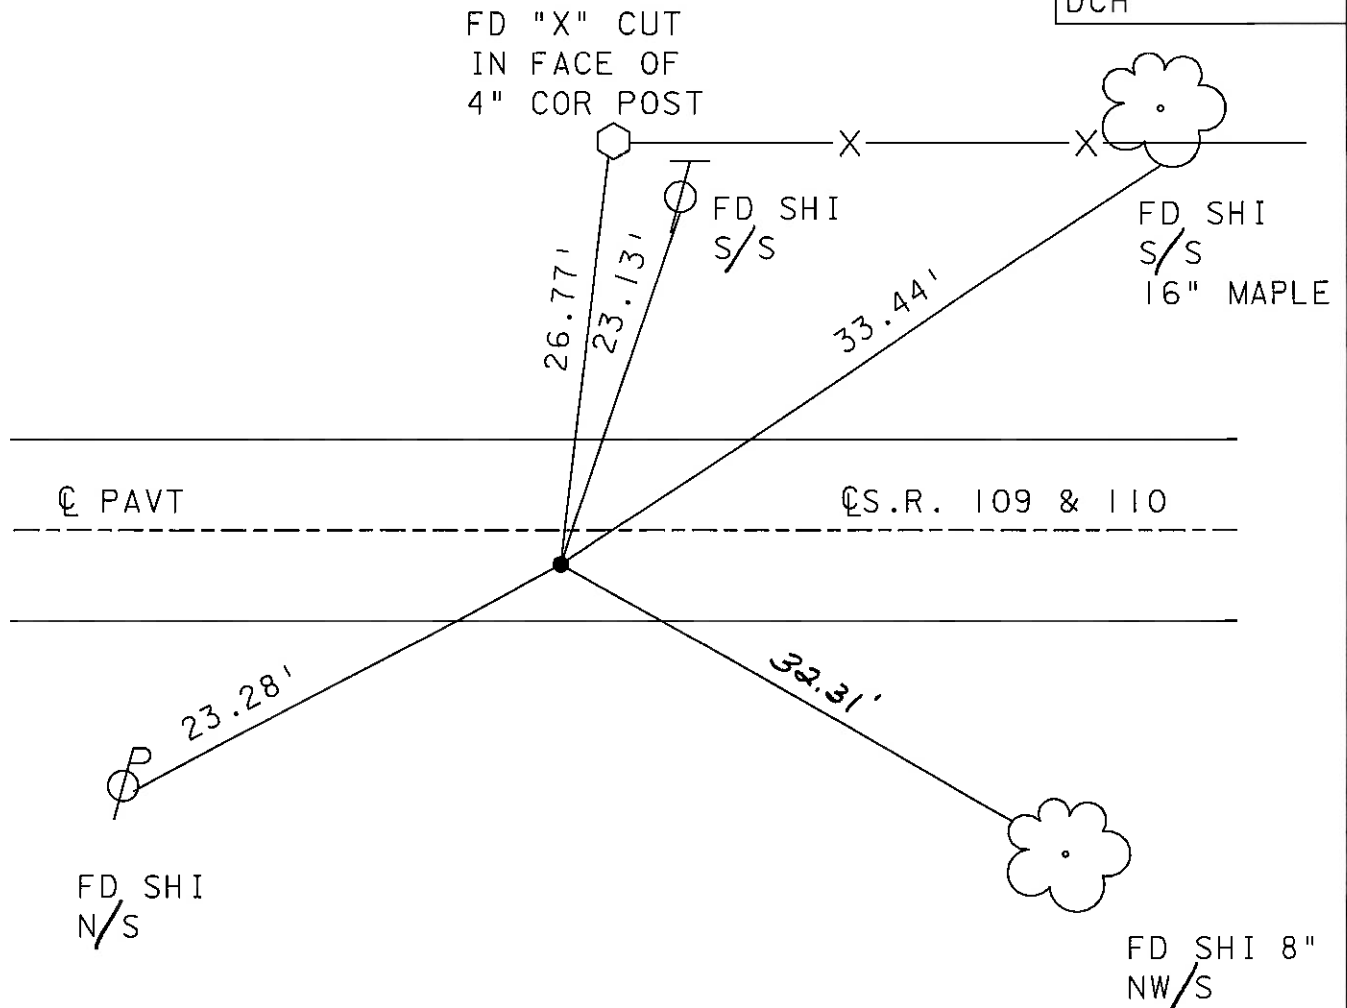

O.D.O.T. DISTRICT 2 SURVEY OFFICE

PERSONNEL

REFERENCE NO. _____

SHEET _____ OF _____

NOTES BAENHISEL

H.C. " "

DATE 9-28-90

ROUTE 109 & 110

R.C. HOFFMAN

WEATHER CLAC

COUNTY HENRY

TEMP. +65°

TOWNSHIP HARRISON

SECTION 11

T. 5 N. R. 7 E.


TYPE MONUMENT P.K. & WASHER

ON SURFACE - BELOW yes

LEFT - & PAV'T. - RIGHT 1.7

9.0 TO RT EDGE PAVEMENT

S.L.M. 9/3+94

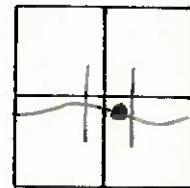

RECORD: P.I.

$\Delta = 50.45' \text{ LT}$

SET P.K. & WASHER

10-11-90


MB

Fd. "X" CUT OF FACE

4" COR. POST

Fd Shi S/S

16" maple

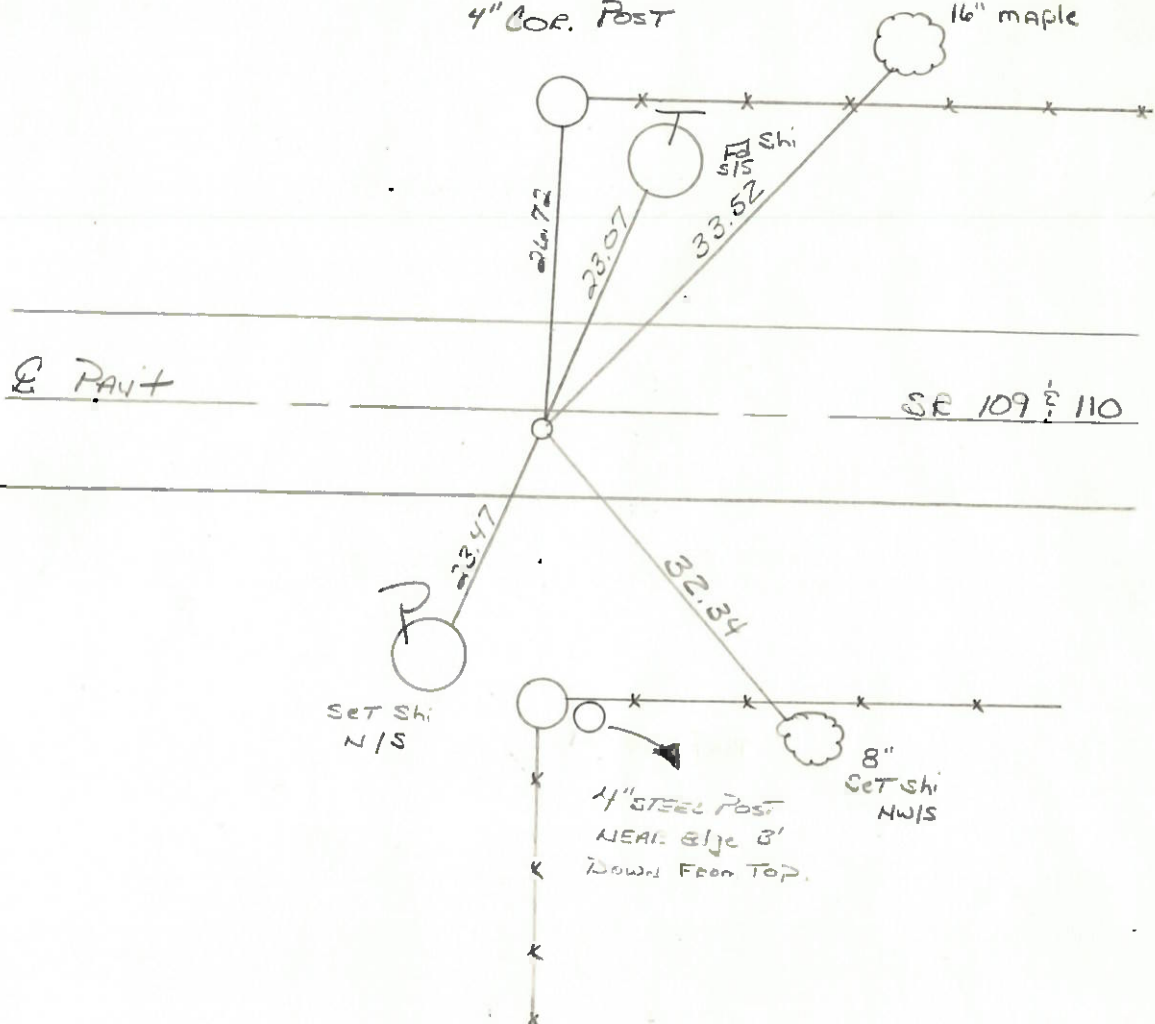

ODOT DISTRICT 2 SURVEY OFFICE

SHEET _____ OF _____

County HENRY S.R. 109 & SR 110

Township HARRISON

Section 11

TSN, RZE

Personnel HOFFMAN

LOENRKE


HOUSEHOLDER

BARWISSEL

Date 3-23-84

Weather CLEAR

Temp. +25°

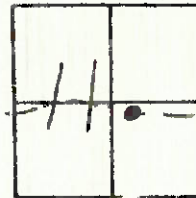

Fd. small R.R. spike 2" below surface

1.7' RT. of & Post

7.2' TO RT. EP

11.1' TO Lt. EP

SLM 914+09

Record: P.I.

$\Delta = 5^\circ - 45' 41''$

SET PK / WASHER

8-24-84

S.W.H.

