

O.D.O.T. DISTRICT 2 SURVEY OFFICE (USE ONLY)

PERSONNEL

REFERENCE NO. 38

SHEET 33 OF 36

NOTES ASTON

DATE 5/25/23

ROUTE SR 109

H.C. AUBLE

WEATHER CLOUDY

COUNTY HENRY

R.C. MILLER

TEMP. 55°

TOWNSHIP HARRISON

DWG BY RHOADES

PID PAVTRAIN

SECTION 11

T 5 N R 7 E

TYPE MONUMENT MAG/WASHER

ON SURFACE - ~~BELOW~~ ON

OFFSET Q PAVEMENT 4.9' LT : ~~RT~~

4.8' TO LT EDGE PAVEMENT


STATION: 927+22

HORIZ.DATUM: NAD83 2011

GEOID: NAVD88 2018


GRID: NORTHING: 637385.432

EASTING: 1551901.663

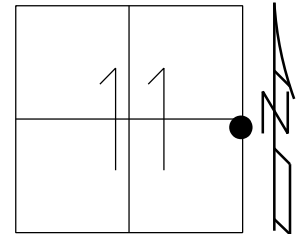

RECORD: P.I.
 $\Delta = 0^\circ 50' 26''$ RT
SET P.K./WASHER
10-11-90, MB
SET MAG/WASHER
12-2-02, DCH
SET MAG/WASHER
REF14
8-31-15, JFO
FD MAG/WASHER
REF38
6/17/21, TDN
10/5/21, JFO
FD MAG/WASHER
REF14
12/20/21, DSA
FD MAG/WASHER
7-2-24, TDN

NOTE: REF 14 SR 110

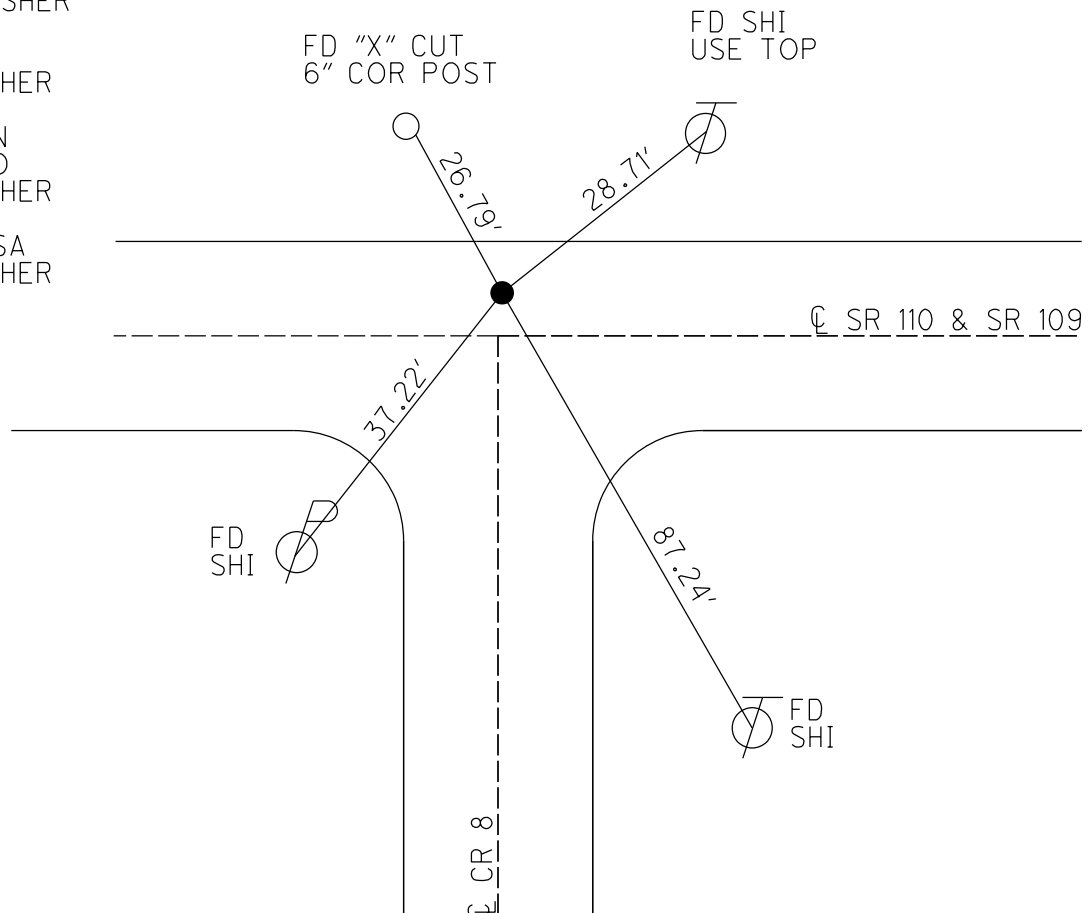

O.D.O.T. DISTRICT 2 SURVEY OFFICE (USE ONLY)

PERSONNEL

REFERENCE NO. 38

SHEET 33 OF 36

NOTES ASTON

DATE 5/25/23

ROUTE SR 109

H.C. AUBLE

WEATHER CLOUDY

COUNTY HENRY

R.C. MILLER

TEMP. 55°

TOWNSHIP HARRISON

DWG BY RHOADES

PID PAVTRAIN

SECTION 11

TYPE MONUMENT MAG/WASHER

ON SURFACE - ~~BELOW~~ ON

OFFSET Q PAVEMENT 4.9' LT : ~~RT~~

4.8' TO LT EDGE PAVEMENT


STATION: 927+22

HORIZ.DATUM: NAD83 2011

GEOID: NAVD88 2018


GRID: NORTHING: 637385.432

EASTING: 1551901.663

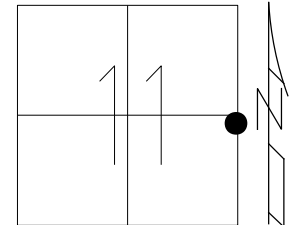

RECORD: P.I.
 $\Delta = 0^{\circ} 50' 26''$ RT
SET P.K./WASHER
10-11-90, MB
SET MAG/WASHER
12-2-02, DCH
SET MAG/WASHER
REF14
8-31-15, JFO
FD MAG/WASHER
REF38
6/17/21, TDN
10/5/21, JFO
FD MAG/WASHER
REF14
12/20/21, DSA

NOTE: REF 14 SR 110

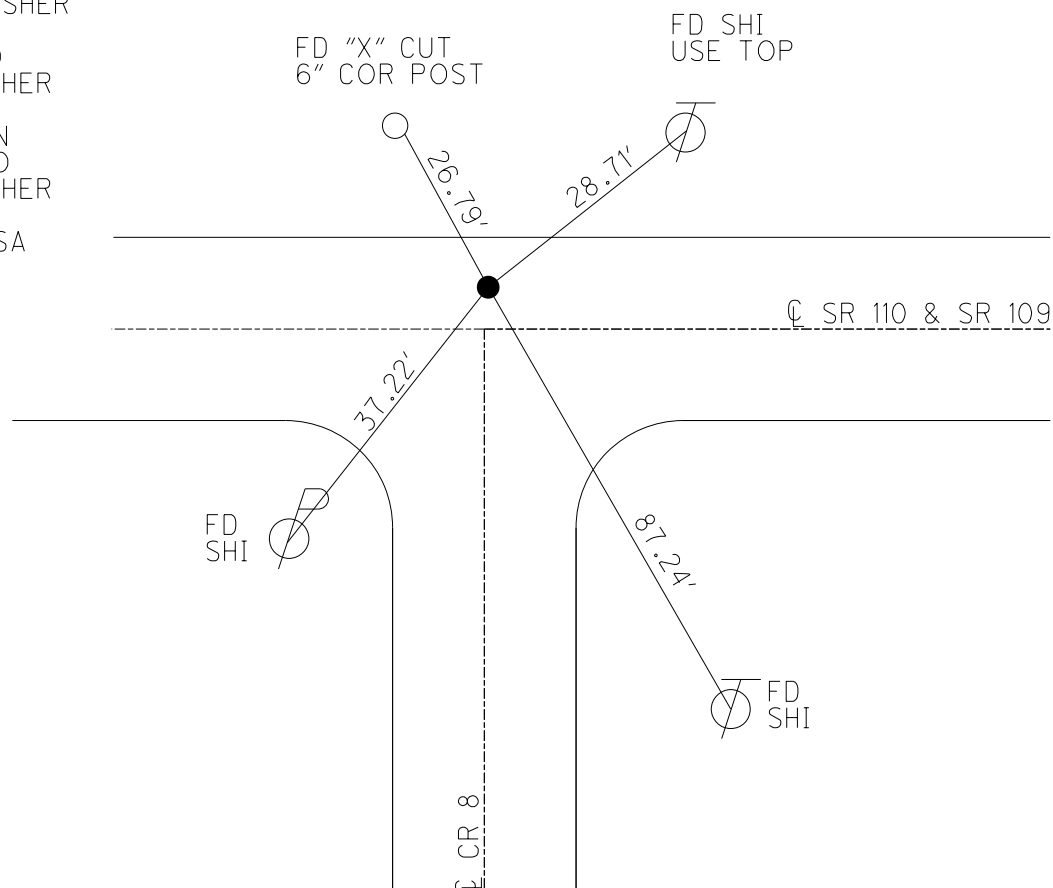

O.D.O.T. DISTRICT 2 SURVEY OFFICE (USE ONLY)

PERSONNEL

REFERENCE NO. 38

SHEET 34 OF 39

NOTES RHOADES

DATE 9/3/15

ROUTE SR 109

H.C. O'DONNELL

WEATHER FAIR

COUNTY HENRY

R.C. RHOADES

TEMP. 74°

TOWNSHIP HARRISON

SECTION 11

DWG BY RHOADES

PID PAVTRAIN

T 5 N R 7 E

TYPE MONUMENT MAG/WASHER

ON SURFACE - ~~BELOW~~ ON

OFFSET CL PAVEMENT 4.9' LT : ~~RT~~

4.8' TO LT EDGE PAVEMENT


STATION: 927+22

HORIZ.DATUM: NAD83 2011


GEOID: NAVD88 2018

GRID: NORTHING: 637385.432

EASTING: 1551901.663

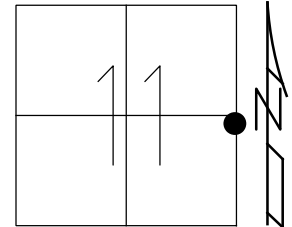

RECORD: P.I.
 $\Delta = 0^{\circ} 50' 26''$ RT
SET P.K./WASHER
10-11-90, MB
SET MAG/WASHER
12-2-02, DCH
SET MAG/WASHER
REF14
8-31-15, JFO
FD MAG/WASHER
REF38
6/17/21, TDN
10/5/21, JFO

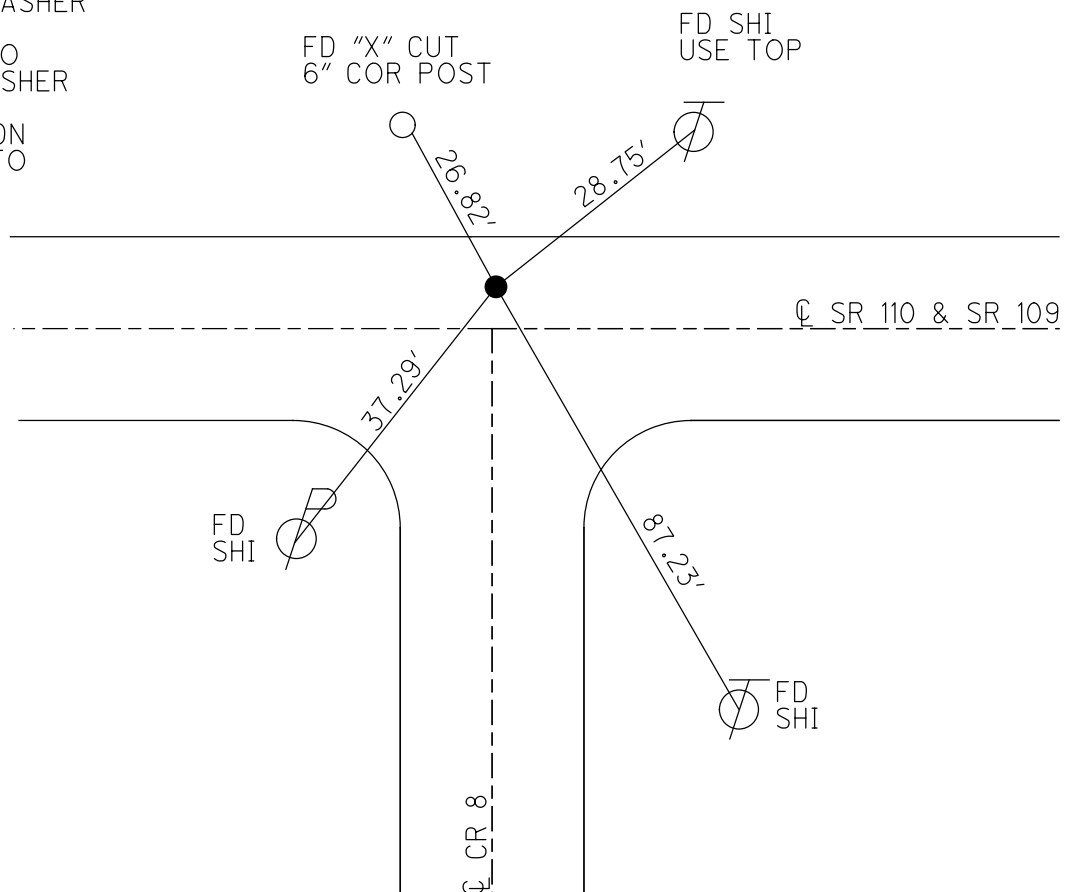


O.D.O.T. DISTRICT 2 SURVEY OFFICE (USE ONLY)

PERSONNEL _____ REFERENCE NO. 38 SHEET 34 OF 38
NOTES RHOADES DATE 9-3-15 ROUTE SR 109
H.C. O'DONNELL WEATHER FAIR COUNTY HENRY
R.C. RHOADES TEMP. 74°F TOWNSHIP HARRISON
SECTION 11
T 5 N R 7 E

TYPE MONUMENT MAG/WASHER
ON SURFACE - ~~BELOW~~ ON
LEFT - CL PAV'T - ~~RIGHT~~ 4.9'
4.8' TO LT EDGE PAVEMENT
S.L.M. 927+22

Grid: Northing: 637385.4426 Easting: 1551901.6379

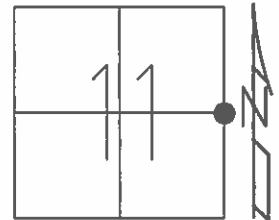


RECORD: P.I.
 $\Delta = 0^\circ 50' 26'' \text{RT}$

SET PK/WASHER
10-11-90, MB

SET MAG/WASHER
12-2-02, DCH

NOTE:
POINT DESTROYED
BY PAVING TRAIN
TIES CROSS
RESET MAG/WASHER
GPS, REF14
8-31-15, JFO

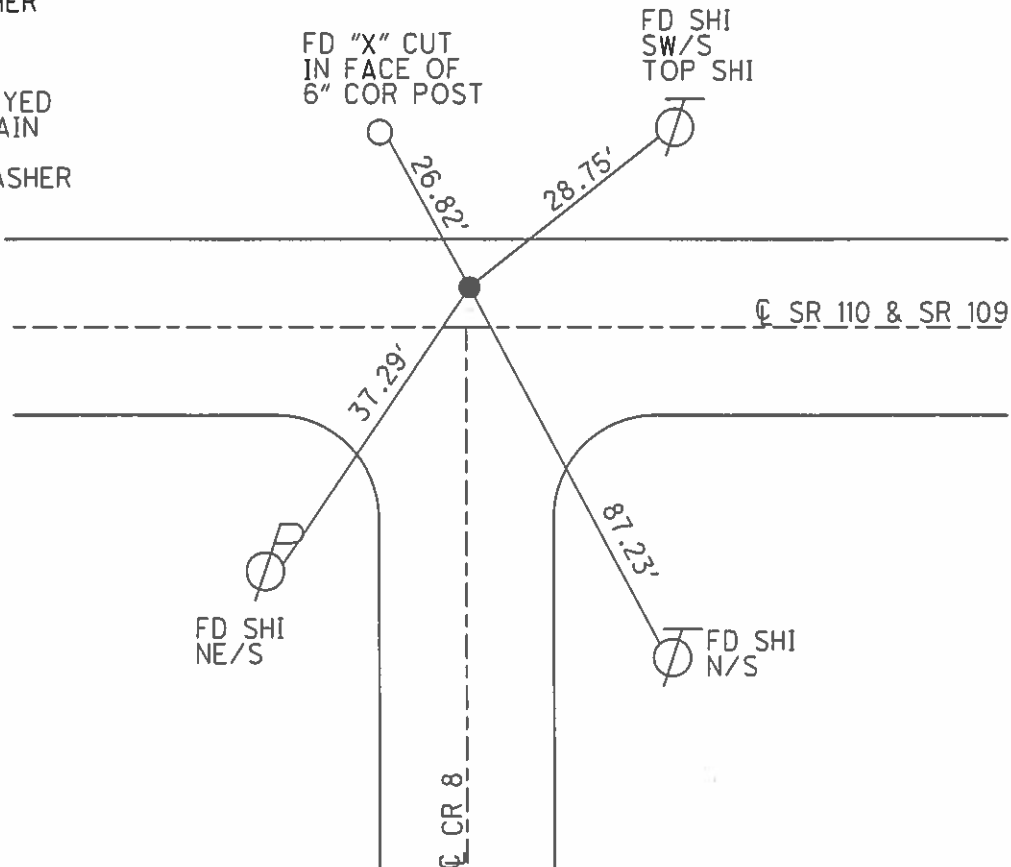

O.D.O.T. DISTRICT 2 SURVEY OFFICE

PERSONNEL


REFERENCE NO. ^{14 ON SK 110} 38 SHEET 4 OF 9

NOTES
H.C. HUMAN
R.C. ROUSOS
BEAUMONT

DATE 8-13-02
WEATHER CLOUDY
TEMP. 80

ROUTE S.R. 109
COUNTY HENRY
TOWNSHIP HARRISSON
SECTION 11
T 5 N R 7 E


TYPE MONUMENT PK & WASHER
ON SURFACE - ~~BELOW~~ ON
LEFT - ~~Q PAVT~~ - ~~RIGHT~~ 4.9'
5' TO LT EDGE PAVEMENT
S.L.M. 927+22

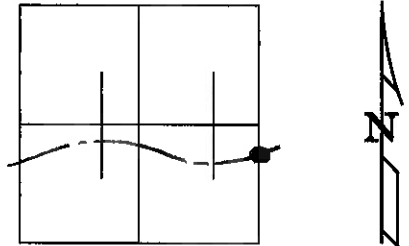

($\Delta = 5^{\circ} 26' RT$)
RECORD P.I. ?
 $\Delta = 5^{\circ} 26' 00'' LT$

SET MAG NAIL
& WASHER
12-02-02
DCH

FD "X" CUT
IN FACE OF
6" COR POST
1.5' UP

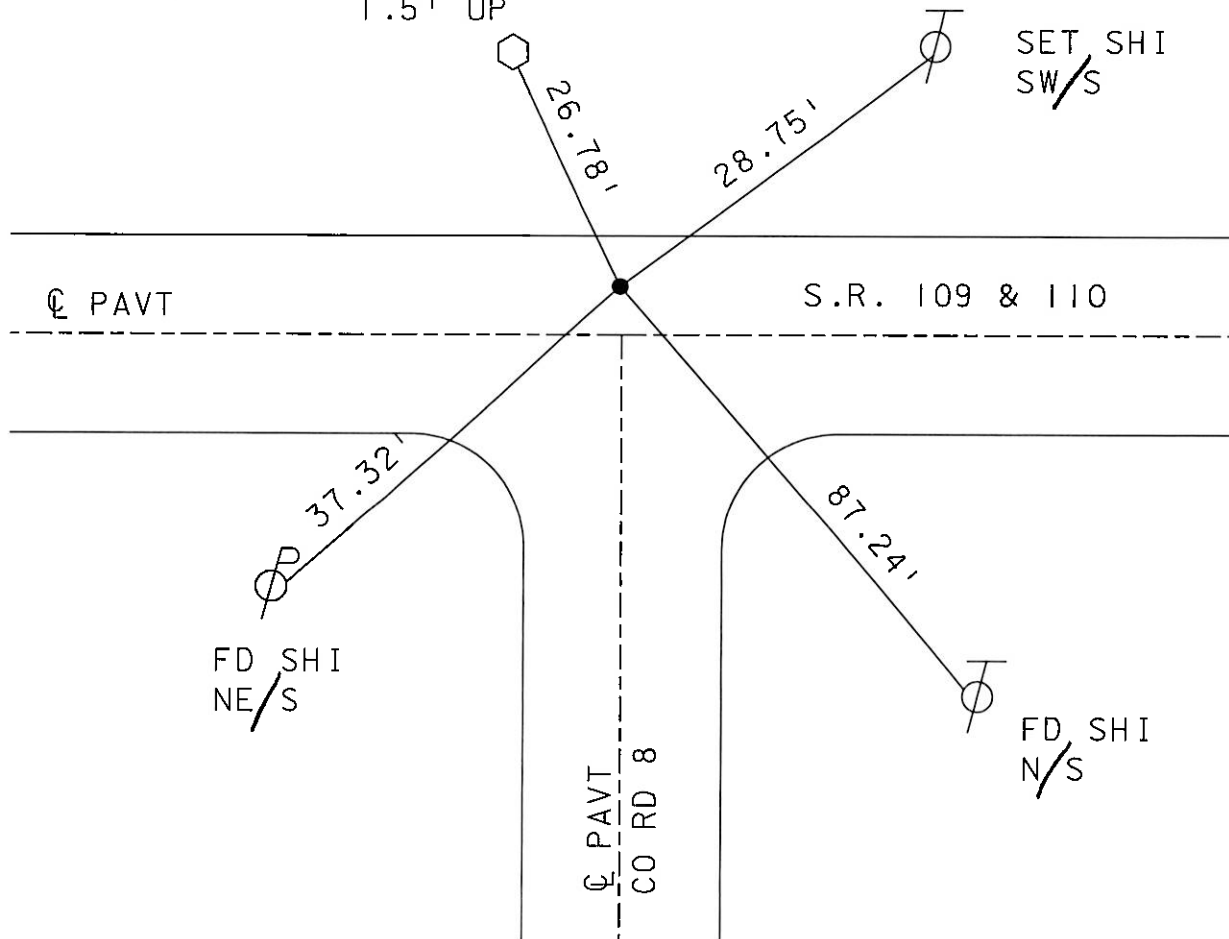

O.D.O.T. DISTRICT 2 SURVEY OFFICE

PERSONNEL

REFERENCE NO. 14/SE 110

SHEET OF

NOTES BARNHISEL

H.C.

DATE 9-28-90

ROUTE 109 & 110

R.C. HOFFMAN

WEATHER CLEAR

COUNTY HENRY

TEMP. +65°

TOWNSHIP HARRISON

SECTION 11

T. 5 N R. 7 E


TYPE MONUMENT P.K. & WASHER

ON SURFACE - BELOW YES

LEFT- & PAV'T. - RIGHT 4.9


4.8 TO LT EDGE PAVEMENT

S.L.M. 927+22

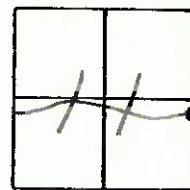

RECORD: P.I.
Δ: 50°-26' Rt

Set P.K. & WASHER
10-11-90
mB

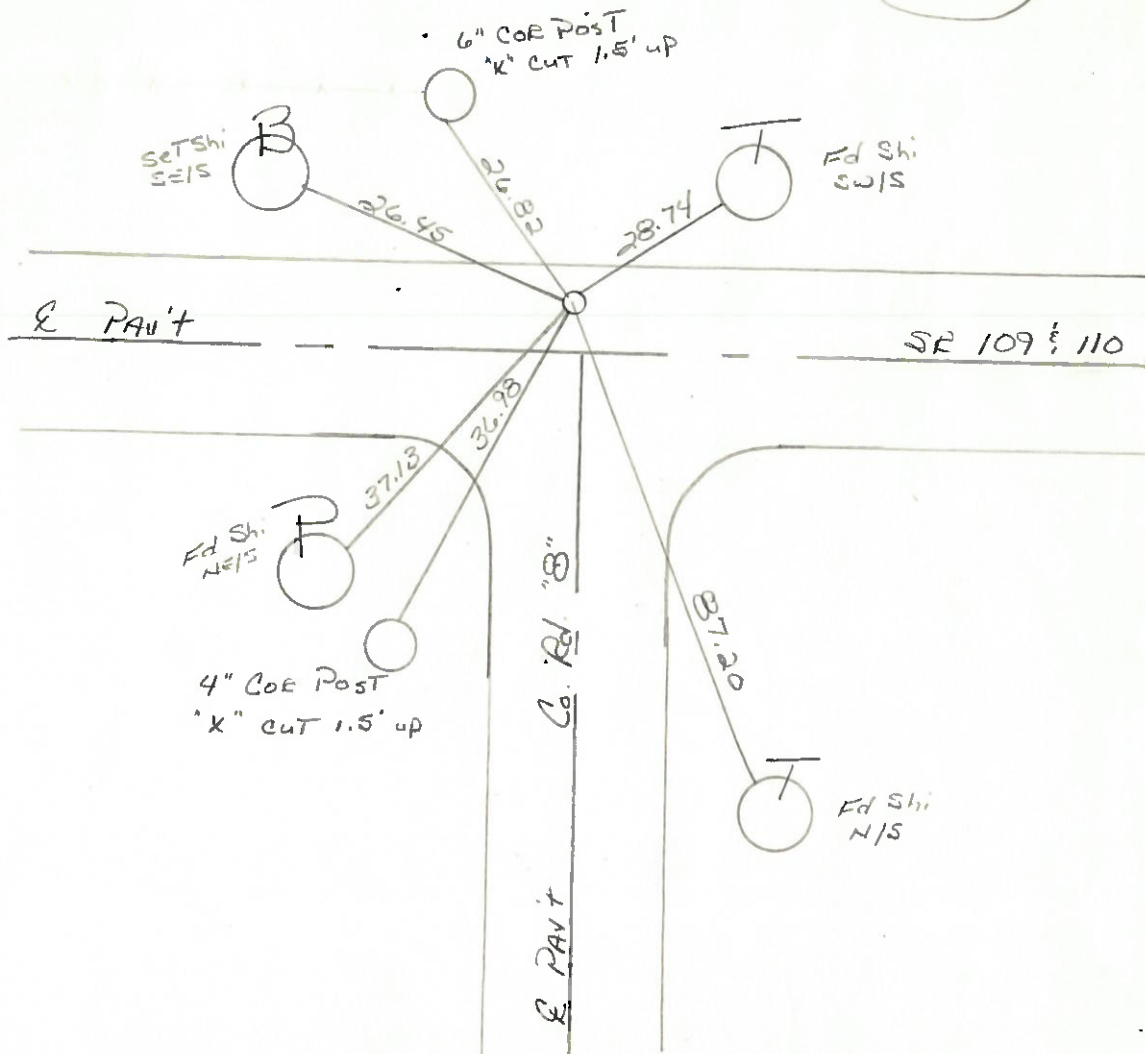

ODOT DISTRICT 2 SURVEY OFFICE

SHEET _____ OF _____

County HENRY S.R. 109th SR 110

Township HARRISON

Section 11

TSN, RILE

Personnel HOFFMAN

LOEWIRKE

HOUSEHOLDER


BARNHISEL

#14 SR 110

Date 3-23-94

Weather clear

Temp. +25°

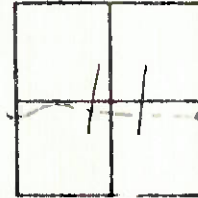

Fd R.R. SPK 1 1/2" Below Surface
4.4' Lt of & Pavt SR 109-110
5.0' to Lt EP
On & Pavt Co. Rd 8


S.L.M. 927 +38

Record: P.I.
Δ = 5° - 26' RT.

SET PK/WASHER

8-24-84

SWH

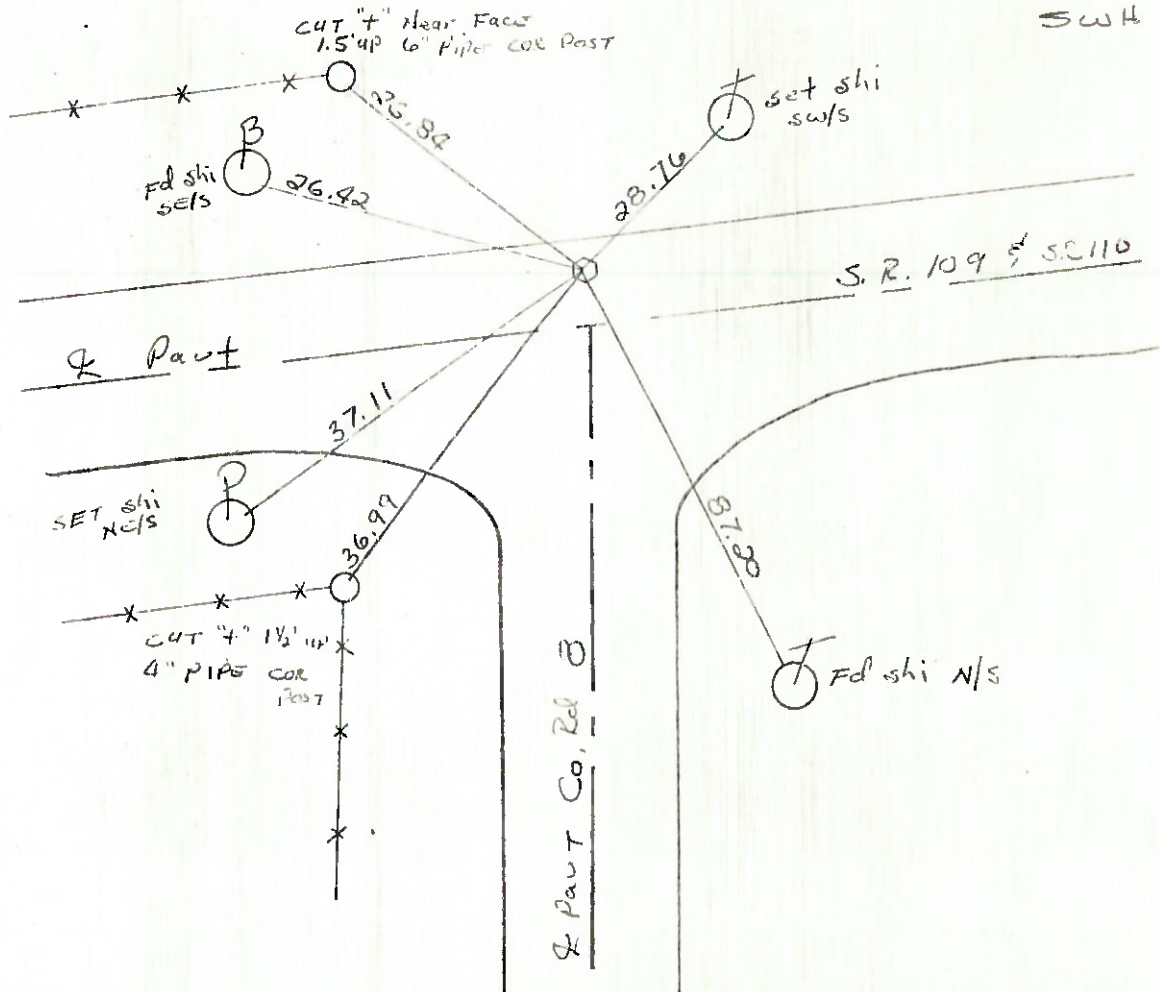

Q.D.O.T. DISTRICT 2 SURVEY OFFICE

SHEET _____ OF _____

County HENRY S.R. 109 & SR110

Township HARRISON

Section 11

TSN, RILE

Personnel HOFFMAN

LOENRKE

HOUSEHOLDER


BARNHISEL

14 SR 110

Date 3-23-84

Weather clear

Temp. +25°

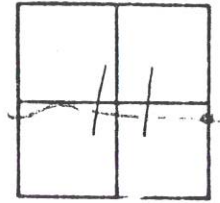

Fd R.R. SPK 1 1/2" Below Surface

4.9 4.4' Lt. of & Paut SR 109-110

4.8 5.0' TO Lt. EP

OK & Paut Co. Rd 8

S.L.M. 927 +38 22

Record: P.I.

$\Delta = 5^{\circ} - 26' RT.$

SET PK / WASHER

8-24-84

SWH

