

O.D.O.T. DISTRICT 2 SURVEY OFFICE (USE ONLY)

PERSONNEL

REFERENCE NO. 38 A

SHEET 34 OF 36

NOTES ASTON

DATE 525/23

ROUTE SR 109

H.C. AUBLE

WEATHER CLOUDY

COUNTY HENRY

R.C. MILLER

TEMP. 55°

TOWNSHIP HARRISON

DWG BY RHOADES

PID PAVTRAIN

SECTION 12

T 5 N R 7 E

TYPE MONUMENT MAG/WASHER

ON SURFACE - ~~BELOW~~ ON

OFFSET $\mathcal{C}$ PAVEMENT 5.9' LT : ~~RT~~
4' TO LT EDGE PAVEMENT


STATION: 938+41

HORZ.DATUM: NAD83 2011

GEOID: NAVD88 2018


GRID: NORTHING: 637242.092

EASTING: 1553012.281

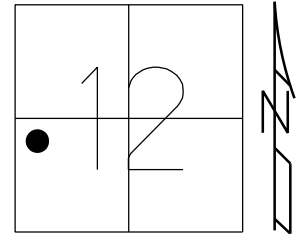

RECORD: P.I.
 $\Delta = 5^{\circ} 11' 00''$ RT
FD P.K./WASHER
8/13/02
SET MAG/WASHER
9-20-02, DCH
FD MAG/WASHER
REFA38
6/17/21, TDN
10/5/21, JFO
FD MAG/WASHER
REF14
12/20/23, DSA
FD MAG/WASHER
7-2-24, TDN

NOTE: REF 14AB SR 110

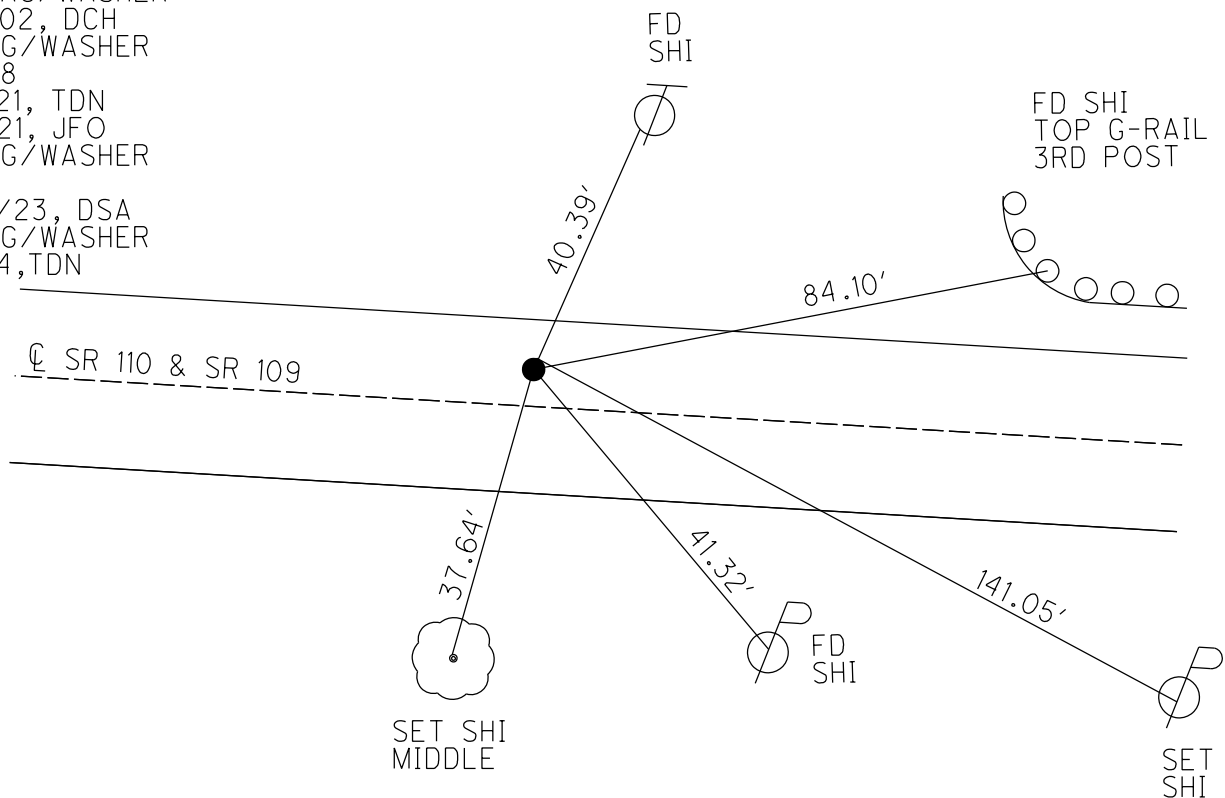

O.D.O.T. DISTRICT 2 SURVEY OFFICE (USE ONLY)

PERSONNEL

REFERENCE NO. 38 A

SHEET 34 OF 36

NOTES ASTON

DATE 525/23

ROUTE SR 109

H.C. AUBLE

WEATHER CLOUDY

COUNTY HENRY

R.C. MILLER

TEMP. 55°

TOWNSHIP HARRISON

SECTION 12

DWG BY RHOADES

PID PAVTRAIN

T 5 N R 7 E

TYPE MONUMENT MAG/WASHER

ON SURFACE - ~~BELOW~~ ON

OFFSET CL PAVEMENT 5.9' LT : ~~RT~~

4' TO LT EDGE PAVEMENT


STATION: 938+41

HORZ. DATUM: NAD83 2011

GEOID: NAVD88 2018


GRID: NORTHING: 637242.092

EASTING: 1553012.281

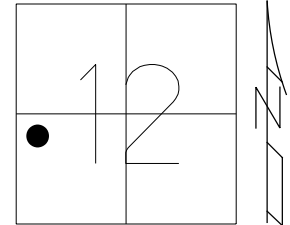

RECORD: P.I.
 $\Delta = 5^{\circ} 11' 00''$ RT
 FD P.K./WASHER
 8/13/02
 SET MAG/WASHER
 9-20-02, DCH
 FD MAG/WASHER
 REFA38
 6/17/21, TDN
 10/5/21, JFO
 FD MAG/WASHER
 REF14
 1220/23, DSA

NOTE: REF 14AB SR 110

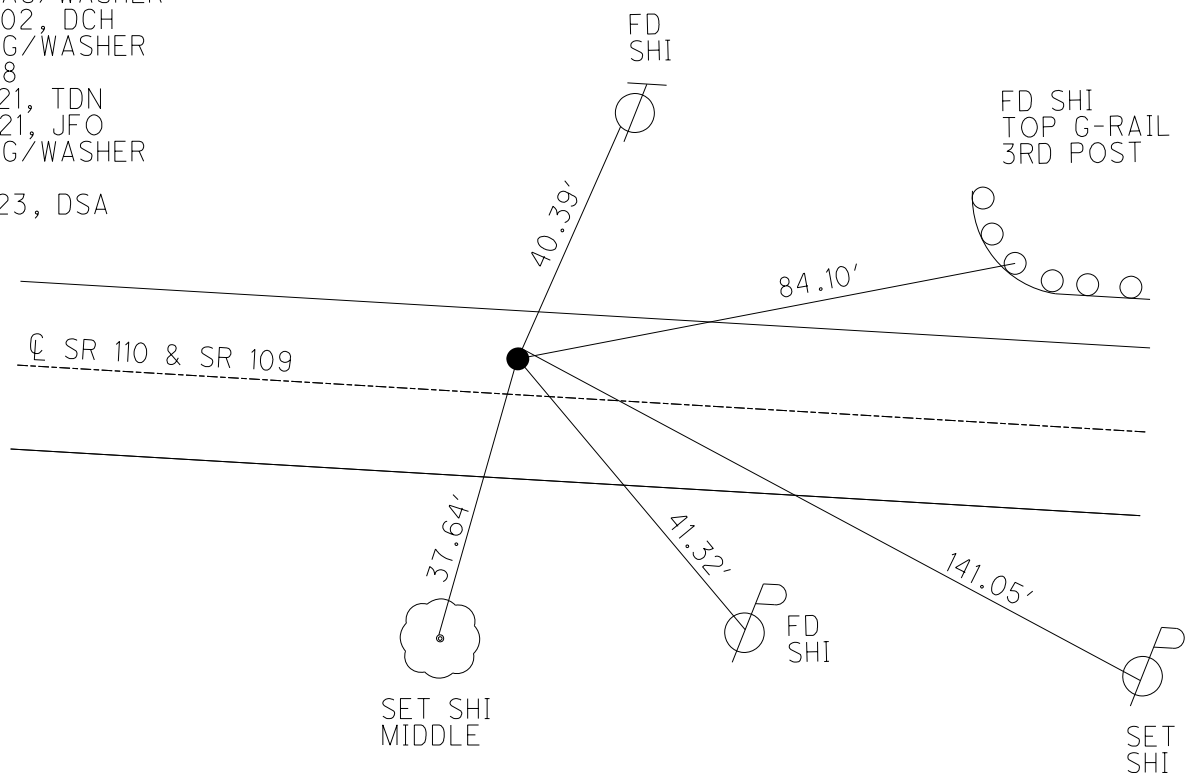

O.D.O.T. DISTRICT 2 SURVEY OFFICE (USE ONLY)

PERSONNEL

REFERENCE NO. 38 A

SHEET 35 OF 39

NOTES HOMAN

DATE 8/13/02

ROUTE SR 109

H.C. ROUSOS

WEATHER CLOUDY

COUNTY HENRY

R.C. BEAUMONT

TEMP. 80°

TOWNSHIP HARRISON

DWG BY RHOADES

PID PAVTRAIN

SECTION 12

T 5 N R 7 E

TYPE MONUMENT P.K./WASHER

ON SURFACE - BELOW ON

OFFSET Q PAVEMENT 5.9' LT : RT

4' TO LT EDGE PAVEMENT


STATION: 938+41

HORZ.DATUM: NAD83 2011


GEOID: NAVD88 2018

GRID: NORTHING: 637242.092

EASTING: 1553012.281

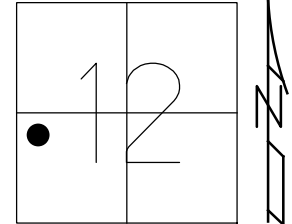


RECORD: P.I.
 $\Delta = 5^{\circ} 11' 00''$ RT
FD P.K./WASHER
8/13/02
SET MAG/WASHER
9-20-02, DCH
FD MAG/WASHER
REFA38
6/17/21, TDN
10/5/21, JFO

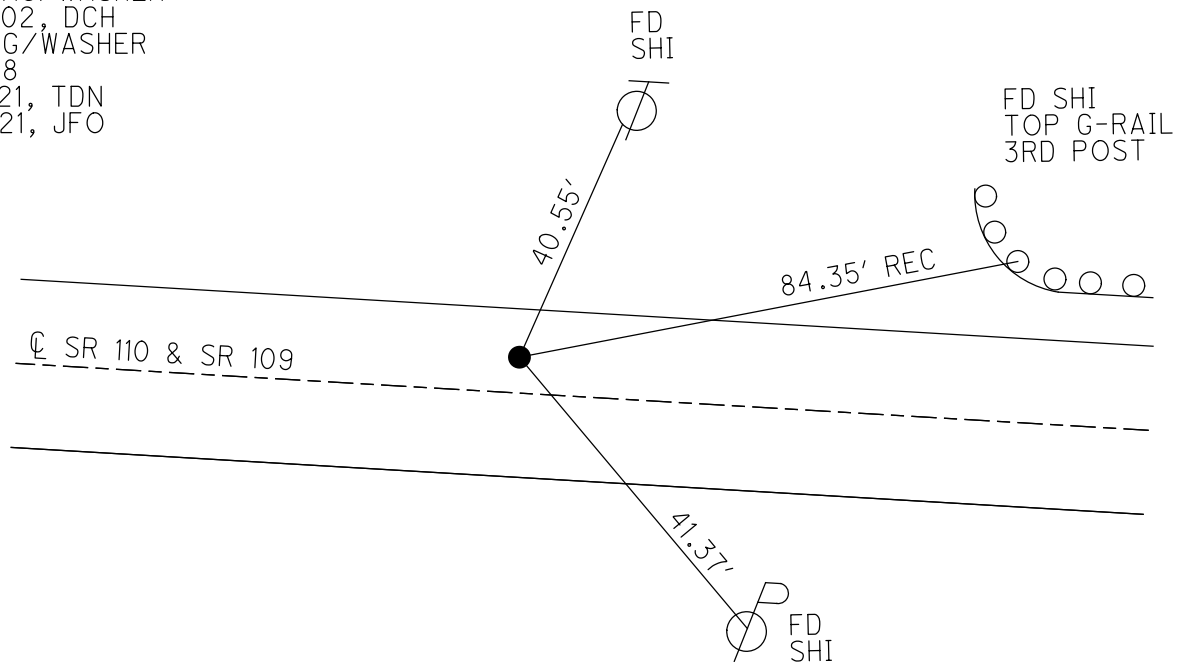

O.D.O.T. DISTRICT 2 SURVEY OFFICE (USE ONLY)

PERSONNEL	REFERENCE NO. <u>38 A</u>	SHEET <u>35</u> OF <u>38</u>
NOTES <u>HOMAN</u>	DATE <u>8-13-02</u>	ROUTE <u>SR 109</u>
H.C. <u>ROUSOS</u>	WEATHER <u>CLOUDY</u>	COUNTY <u>HENRY</u>
R.C. <u>BEAUMONT</u>	TEMP. <u>80°F</u>	TOWNSHIP <u>HARRISON</u>
		SECTION <u>12</u>
		T <u>5</u> N R <u>7</u> E


TYPE MONUMENT PK/WASHER
 ON SURFACE - ~~BELOW~~ ON
 LEFT - ℄ PAV'T - ~~RIGHT~~ 5.9'
4' TO LT EDGE PAVEMENT
 S.L.M. 938+41

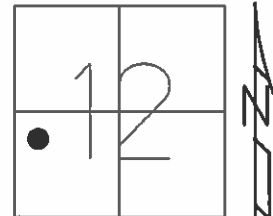

Grid: Northing: - Easting: -

RECORD: P.I.
 $\Delta = 5^{\circ}11'00''\text{RT}$

SET MAG/WASHER
 9-20-02, DCH

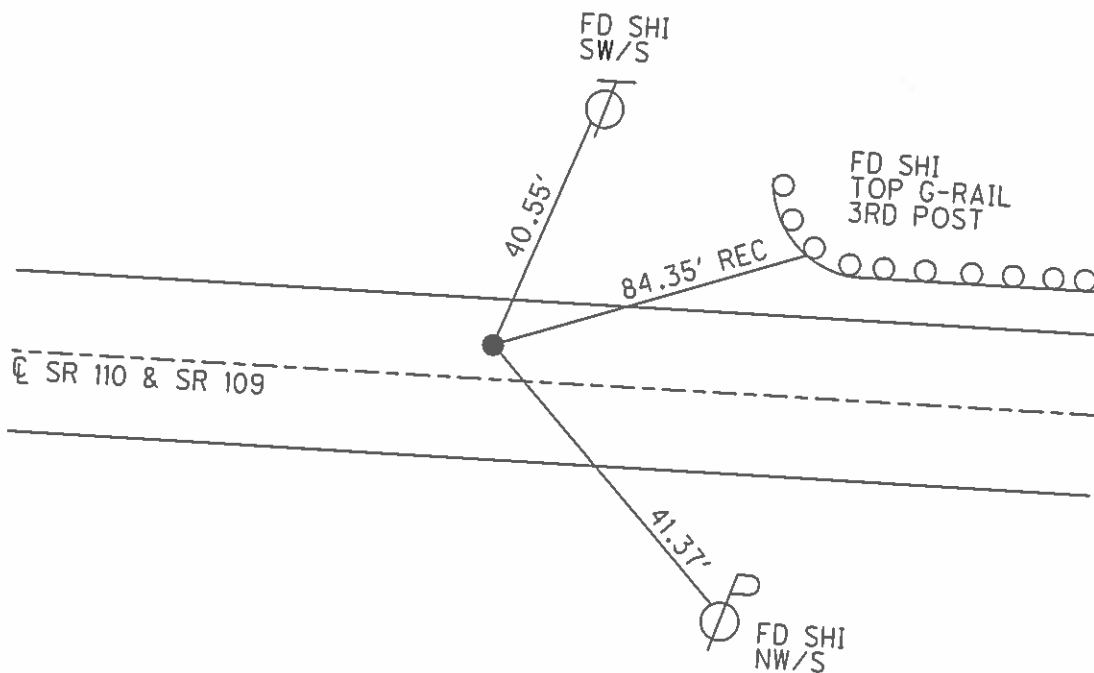

O.D.O.T. DISTRICT 2 SURVEY OFFICE

PERSONNEL

REFERENCE NO. 38A

SHEET 7 OF 9


NOTES HOMAN
H.C. ROUSOS
R.C. BEAUMONT

DATE 8-13-02
WEATHER CLOUDY
TEMP. 80

ROUTE S.R. 109
COUNTY HENRY
TOWNSHIP HARRISON
SECTION 12


T 5 N R 7 E

TYPE MONUMENT PK & WASHER
ON SURFACE - ~~BELOW~~ ON
LEFT - ~~Q PAVT~~ - ~~RIGHT~~ 5.9'
4' TO LT EDGE PAVEMENT
S.L.M. 938+41

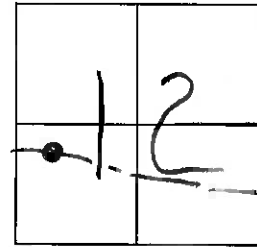

RECORD P.I.
 $\Delta = 5^\circ 11' 00''$ RT

SET MAG NAIL
& WASHER
9-20-02
DCH

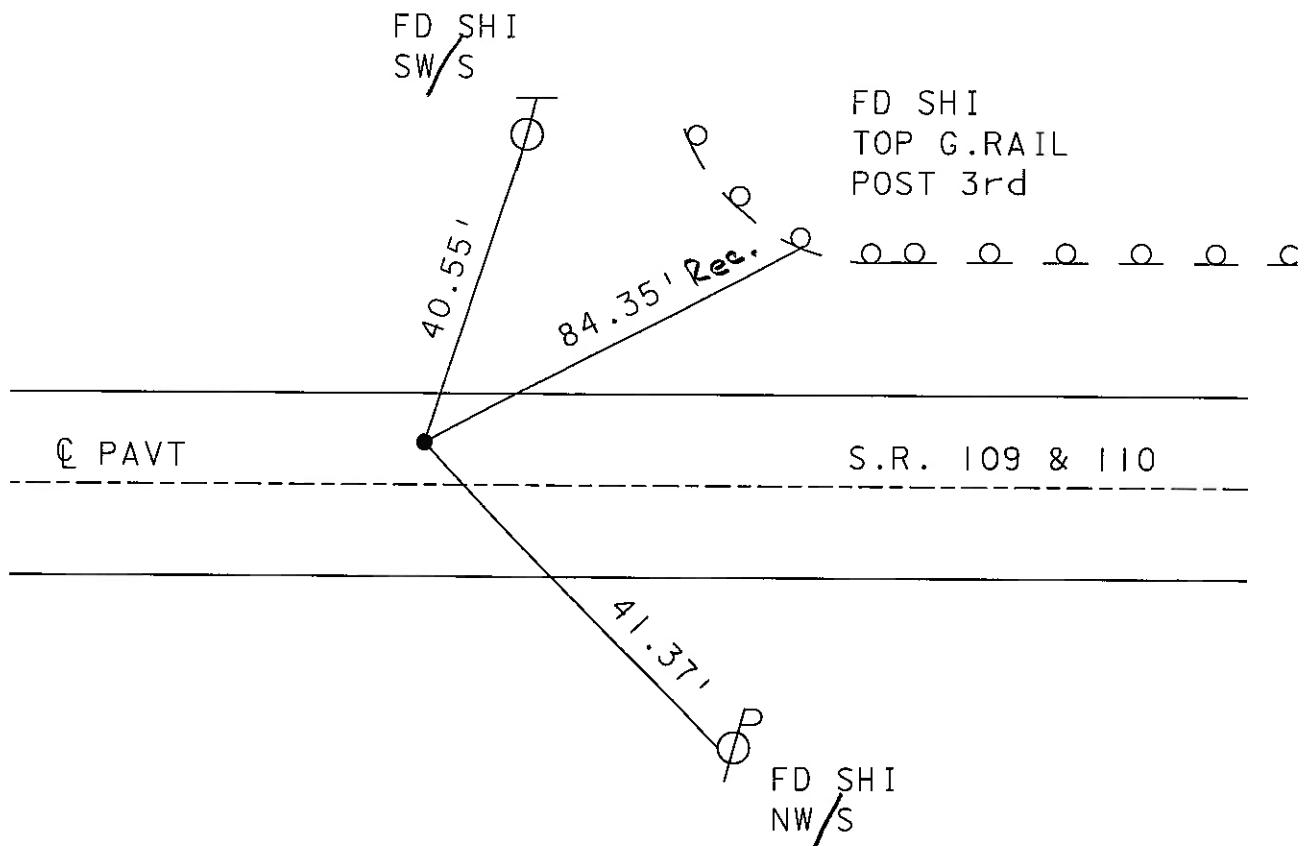

O.D.O.T. DISTRICT 2 SURVEY OFFICE

PERSONNEL

REFERENCE NO. _____

SHEET _____ OF _____

NOTES BARNHISEL

H.C. " "

R.C. HOFFMAN

DATE 9-28-90

WEATHER Clear

TEMP. +65°

ROUTE 109 & 110

COUNTY HENRY

TOWNSHIP HARRISON

SECTION 12

T 5 N R 7 E


TYPE MONUMENT P.K. & WASHER

ON SURFACE - BELOW YES

LEFT- & PAV'T. - RIGHT 5.9

3.6 TO LT EDGE PAVEMENT

S.L.M. 938 + 41

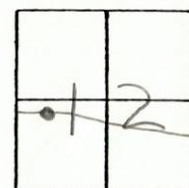


RECORDED: P.I.

$\Delta = 50-11' \text{ Rt}$

Set P.K. & WASHER

10-11-90

MB

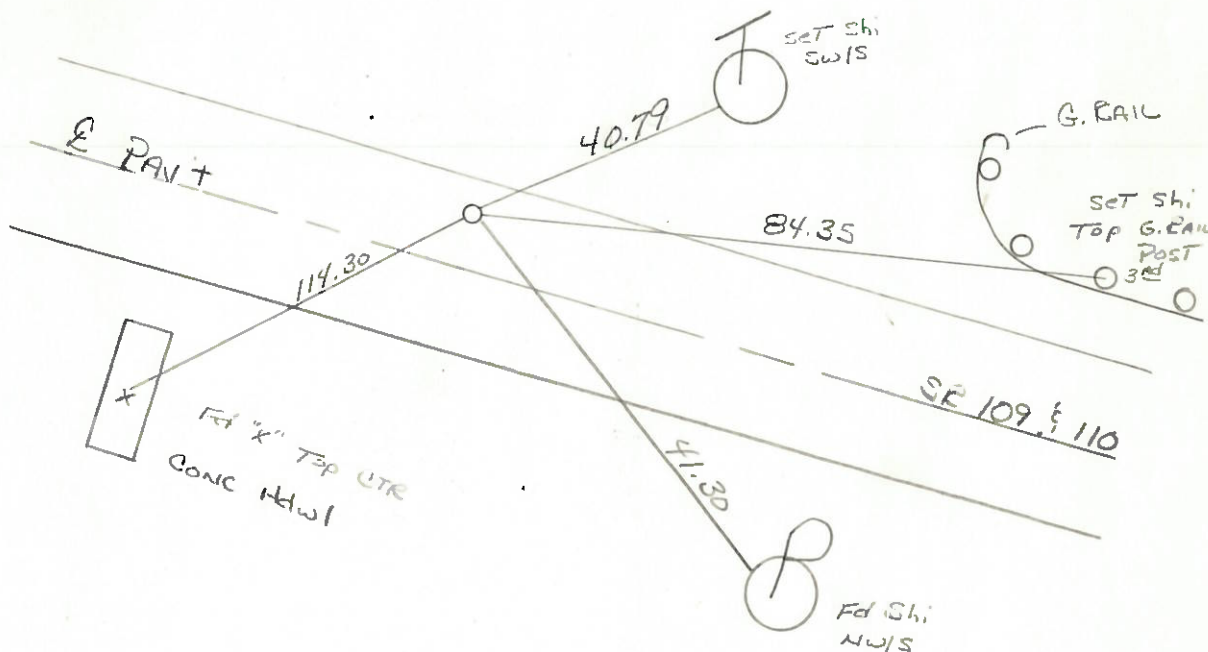

ODOT DISTRICT 2 SURVEY OFFICE

SHEET _____ OF _____

County HENRY S.R. 109^E SR 110

Township HARRISON

Section 12

TSN, RZE

Personnel HOFFMAN

LOEHRKE


HOUSEHOLDER

BARNHISEL

Date 3-23-84

Weather Clear

Temp. +25°

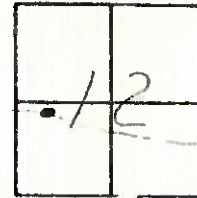

Fd P.K. Nail 1 1/2" Below Surface

5.8' LT. of & Paut

3.0' TO LT. EP

14.9' TO RT. EP

S.I.M. 938 + 57

Reconf: P.T.

$\Delta = 5^{\circ} - 11' RT.$

SET PK/WASHER

8-24-84

S.W.H.

