


O.D.O.T. DISTRICT 2 SURVEY OFFICE (USE ONLY)


PERSONNEL _____ REFERENCE NO. 4 A SHEET 6 OF 20
 NOTES RHOADES DATE 6-7-18 ROUTE SR 281
 H.C. O'DONNELL WEATHER CLOUDY COUNTY HENRY
 R.C. TRENKA TEMP. 65° TOWNSHIP FLAT ROCK
 SECTION 29
 DWG BY JAMES PID 102763 T 4 N R 6 E

TYPE MONUMENT MAG/WASHER
 ON SURFACE - ~~BELOW~~ ON
 OFFSET ☐ PAVEMENT 1.4' ± : RT
8.3' TO RT EDGE PAVEMENT
 STATION: 75+18.31

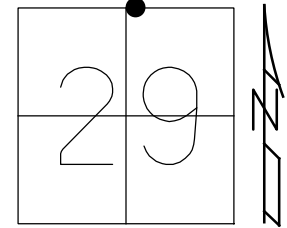

HORIZ.DATUM: NAD83 2011 GEOID: NAVD88 2012A
 GRID: NORTHING: 593130.768 EASTING: 1501280.770


RECORD:
 FD P.K.NAIL
 1985
 SET P.K./WASHER
 6-8-95, KPM
 FD MAG/WASHER
 8-20-09, KPM
 SET MAG/WASHER
 10-19-09, KPM
 FD MAG/WASHER
 REFA4
 6-7-18, JFO

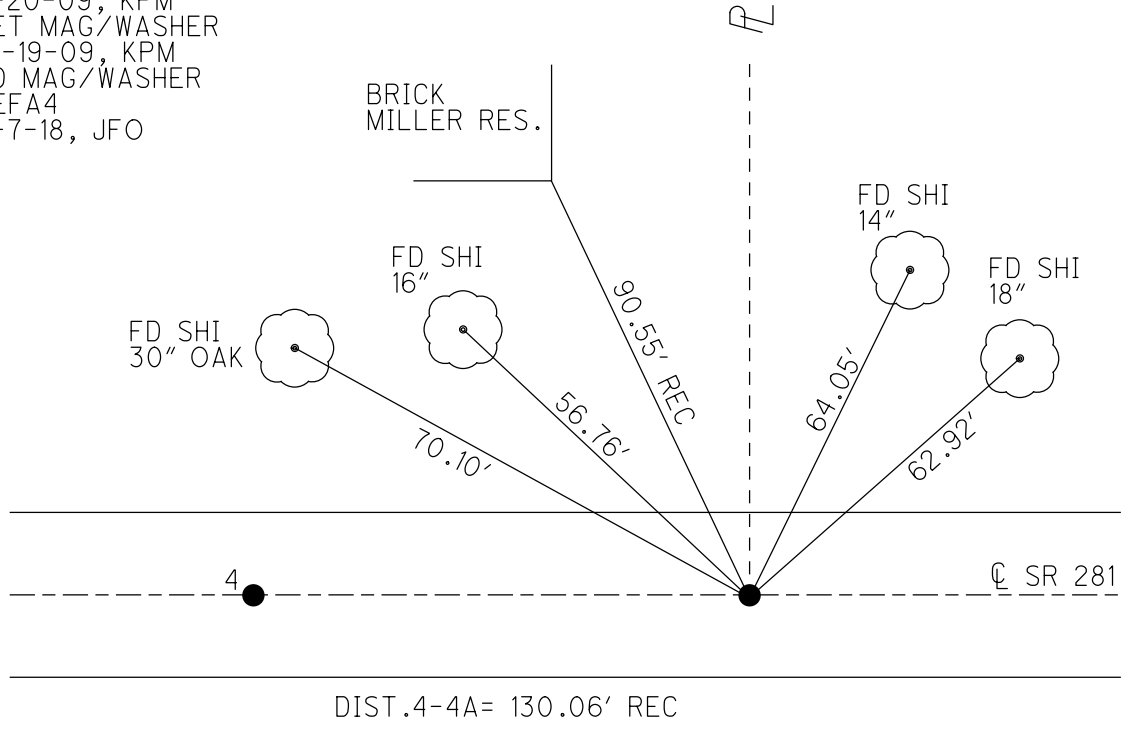

O.D.O.T. DISTRICT 2 SURVEY OFFICE (USE ONLY)


PERSONNEL	REFERENCE NO. <u>4 A</u>	SHEET <u>4</u> OF <u>14</u>
NOTES <u>MOSER</u>	DATE <u>8/20/09</u>	ROUTE <u>SR 281</u>
H.C. <u>GOLDBERG</u>	WEATHER <u>CLOUDY</u>	COUNTY <u>HENRY</u>
R.C. <u>MOSER</u>	TEMP. <u>75°</u>	TOWNSHIP <u>FLAT ROCK</u>
		SECTION <u>29</u>
		T <u>4</u> N R <u>6</u> E

TYPE MONUMENT P.K./WASHER
 ON SURFACE - ~~BELOW~~ ON
~~LEFT = C~~ PAV'T - RIGHT 1.4'
8.3' TO RT EDGE PAVEMENT
 S.L.M. 75+14

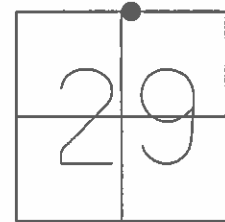

GRID: NORTHING: 593130.759 EASTING: 1501280.693

RECORD:
 FD P.K.NAIL
 1985
 SET P.K./WASHER
 6/8/95, KPM
 SET MAG/WASHER
 10/19/09, KPM

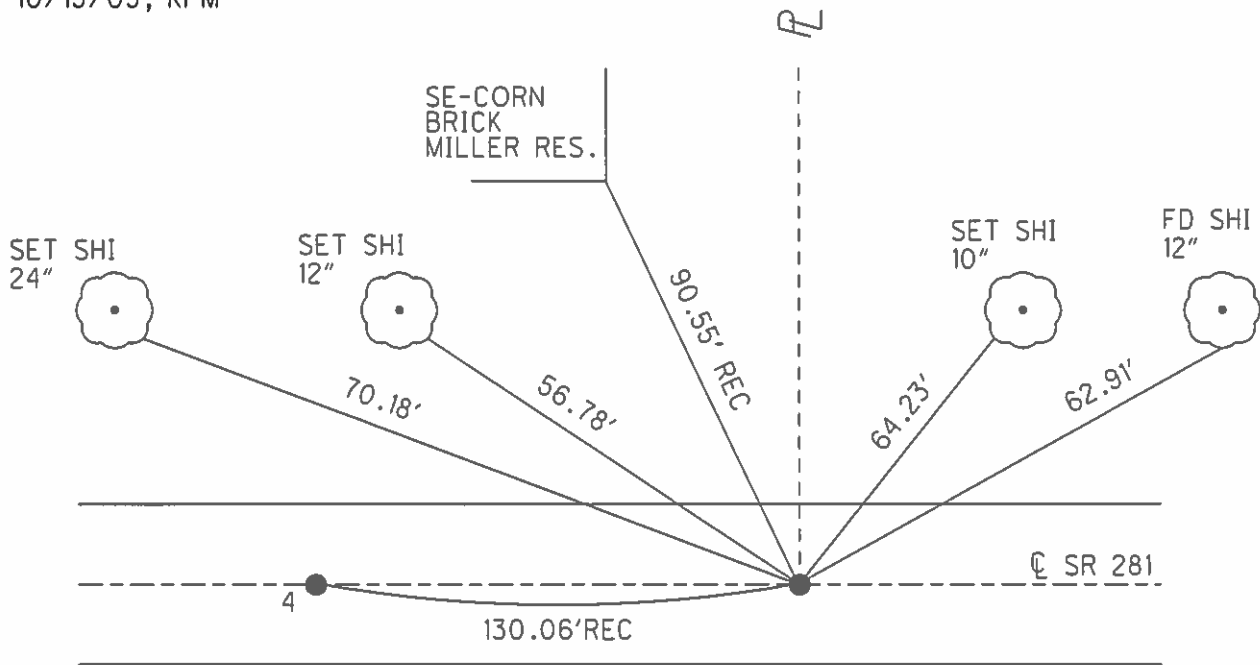

O.D.O.T. DISTRICT 2 SURVEY OFFICE

PERSONNEL

REFERENCE NO. 4-A-B-C SHEET 5 OF 13

NOTES HUSS

H.C. VAN DUSEN

R.C. MOSEB

DATE 6-8-95

WEATHER Cloudy

TEMP. +62°F

ROUTE S.R. 281

COUNTY HENRY

TOWNSHIP FLAT ROCK

SECTION 29

T 4 N R 6 E

TYPE MONUMENT PK/WASHER



ON SURFACE - BELOW YES

~~LEFT -~~ PAV'T. - RIGHT

TO EDGE, PAVEMENT

S.L.M. PT. A 75+09

PT. B = 76+39
PT. C = 77+69

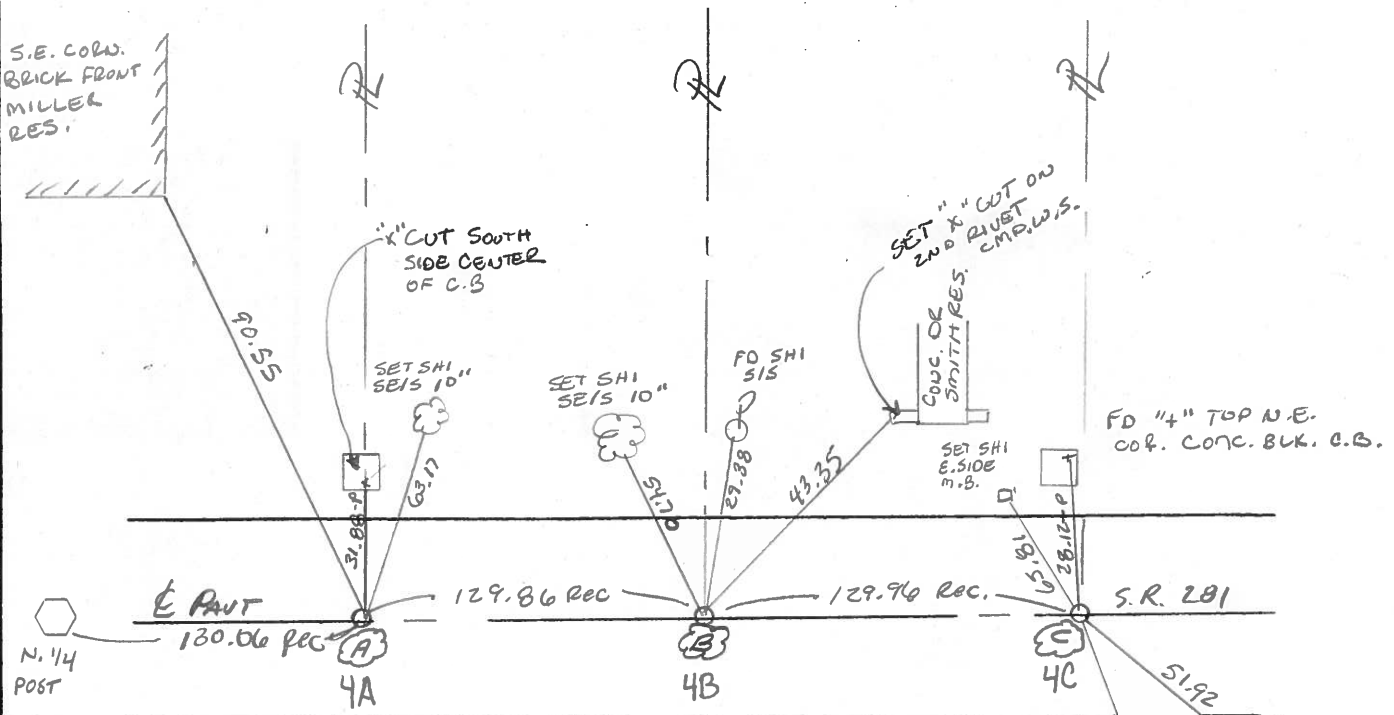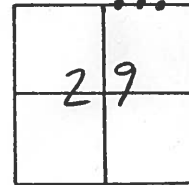

RECORD: (1985)
F.O. PK @ SURFACE
SET PK/WASHER
6-8-95
1.4' RT OF Q PAV'T
8.3' TO RT E.P.

RECORD: (1985)
F.O. PK @ SURFACE
SET PK/WASHER
6-8-95
0.6' TO RT E.P.
3.2' TO RT OF Q

RECORD: (1985)
F.O. RE-SPK 1" BELOW SURFACE
SET PK/WASHER
6-8-95
4.7' RT OF Q PAV'T
5.0' TO RT E.P.
SLM 77+69

CORN. OF
CONC. BLOCK
FON. 2 STRY
FRAME HOUSE

County HENRY S.R. 281

Township FLATROCK

Section 29

T4N, R6E


Personnel Hoffman R.C.
BARNHISEL H.C.

Date 4-15-85

Weather Clear

Temp. 60°


2	9

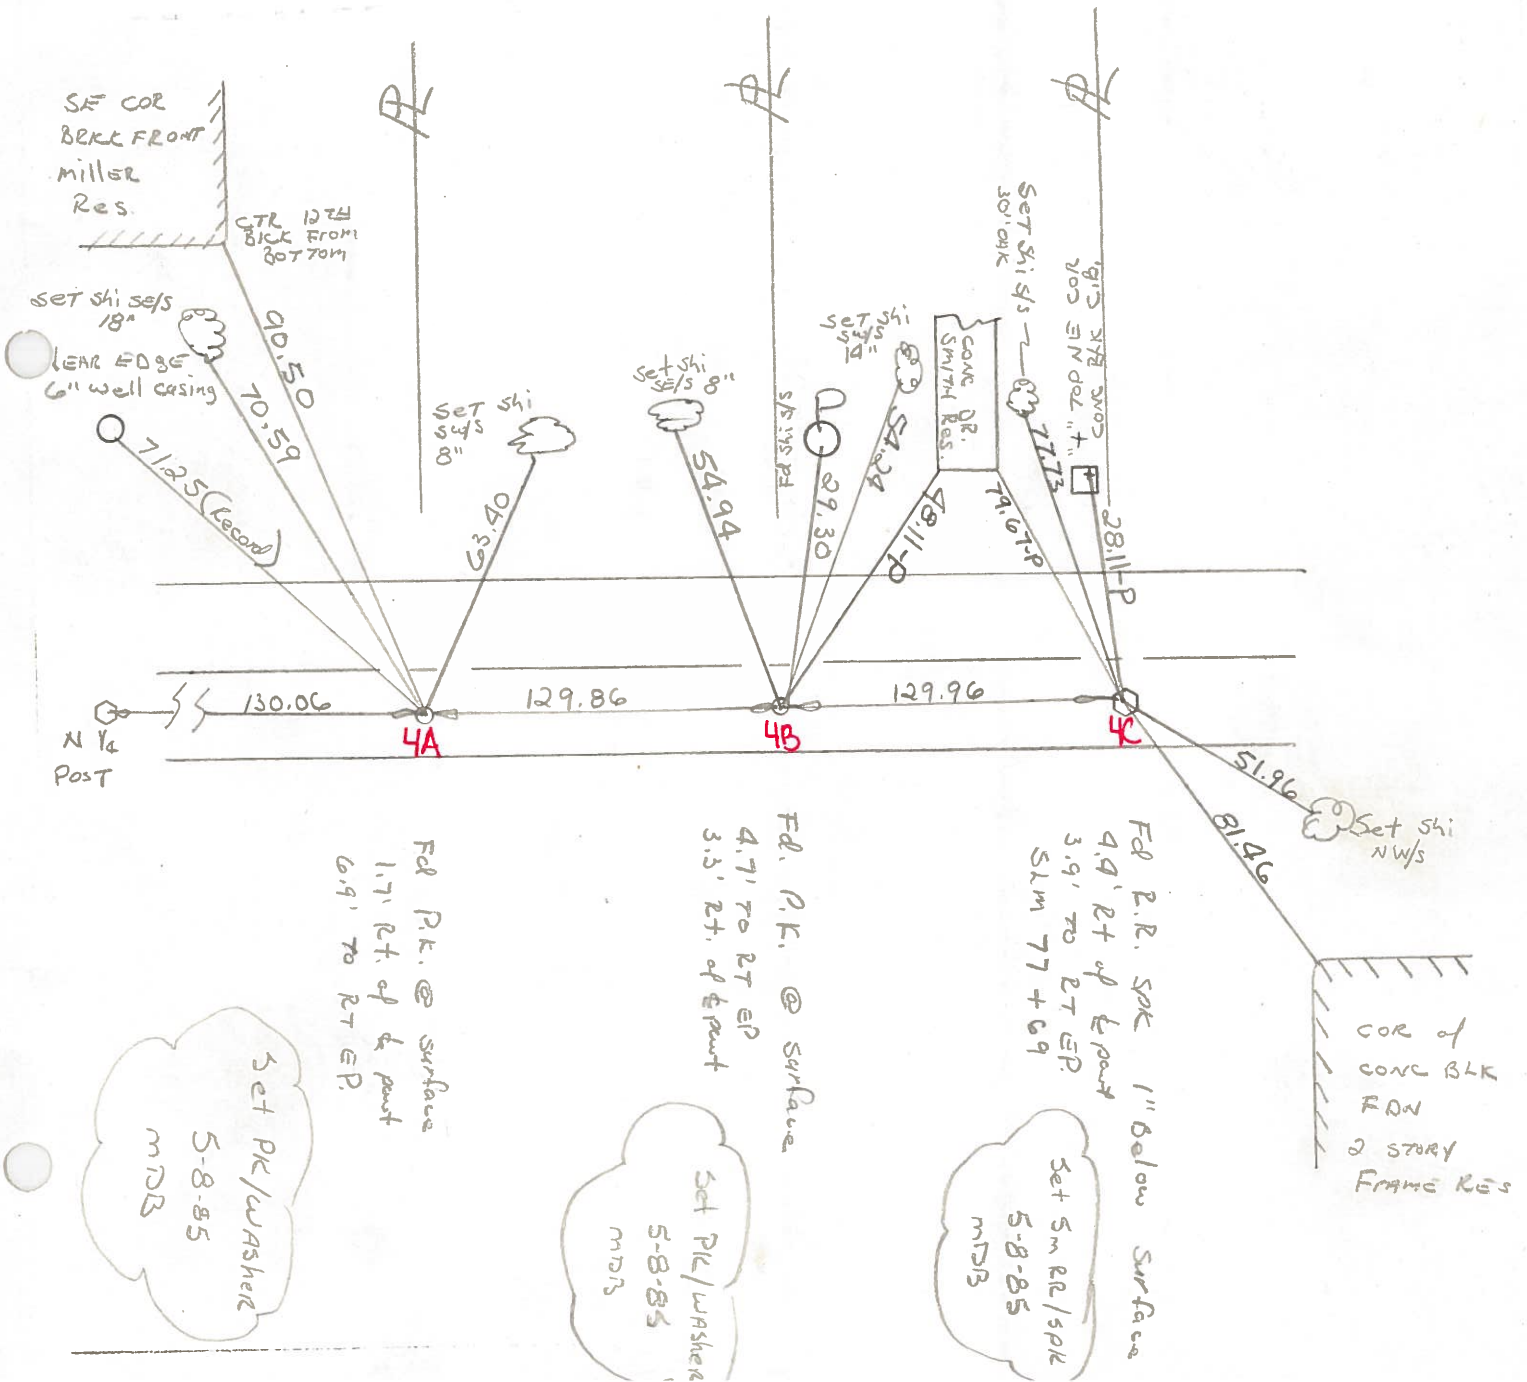

PERSONNEL	TITLE	PERSONNEL	TITLE	COUNTY	DATE
BURNSIDE				HENRY	6-24-77
SMITH				S. R.	281
BOWERS				WEATHER	CLOUDY
MEAD				SEC.	+74°

DESCRIPTION	LEFT	CENTER LINE	RIGHT	JOB NO.
-------------	------	-------------	-------	---------

3/2

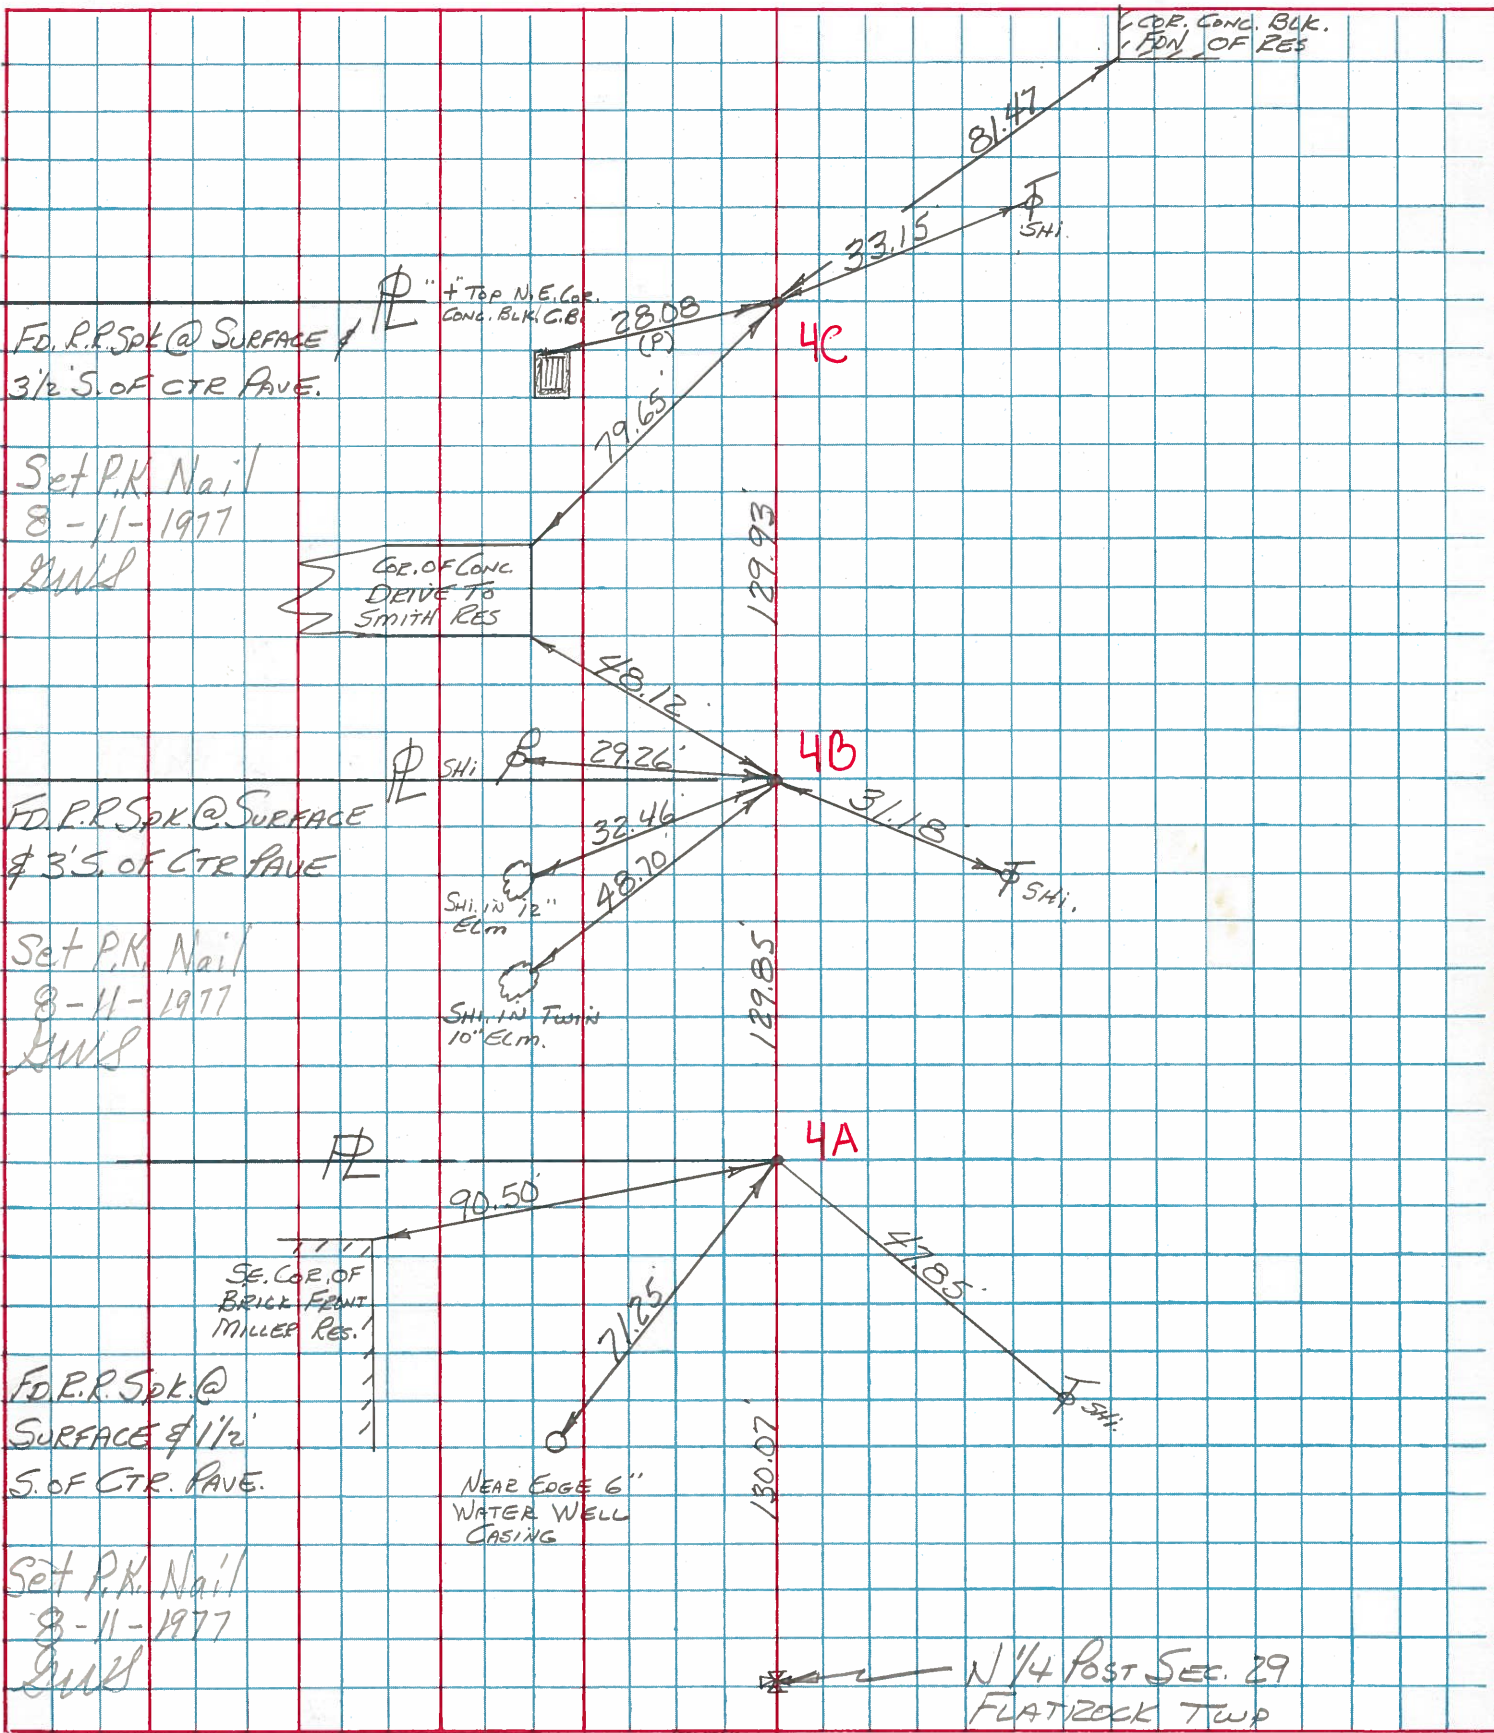

County HENRY S.R. 281

Township FLATROCK

Section 29

T4N, R6E

Personnel BURNSIDE

SMITH



BOWERS

MEAD

Date 6-24-77

Weather CLOUDY

Temp. +74°

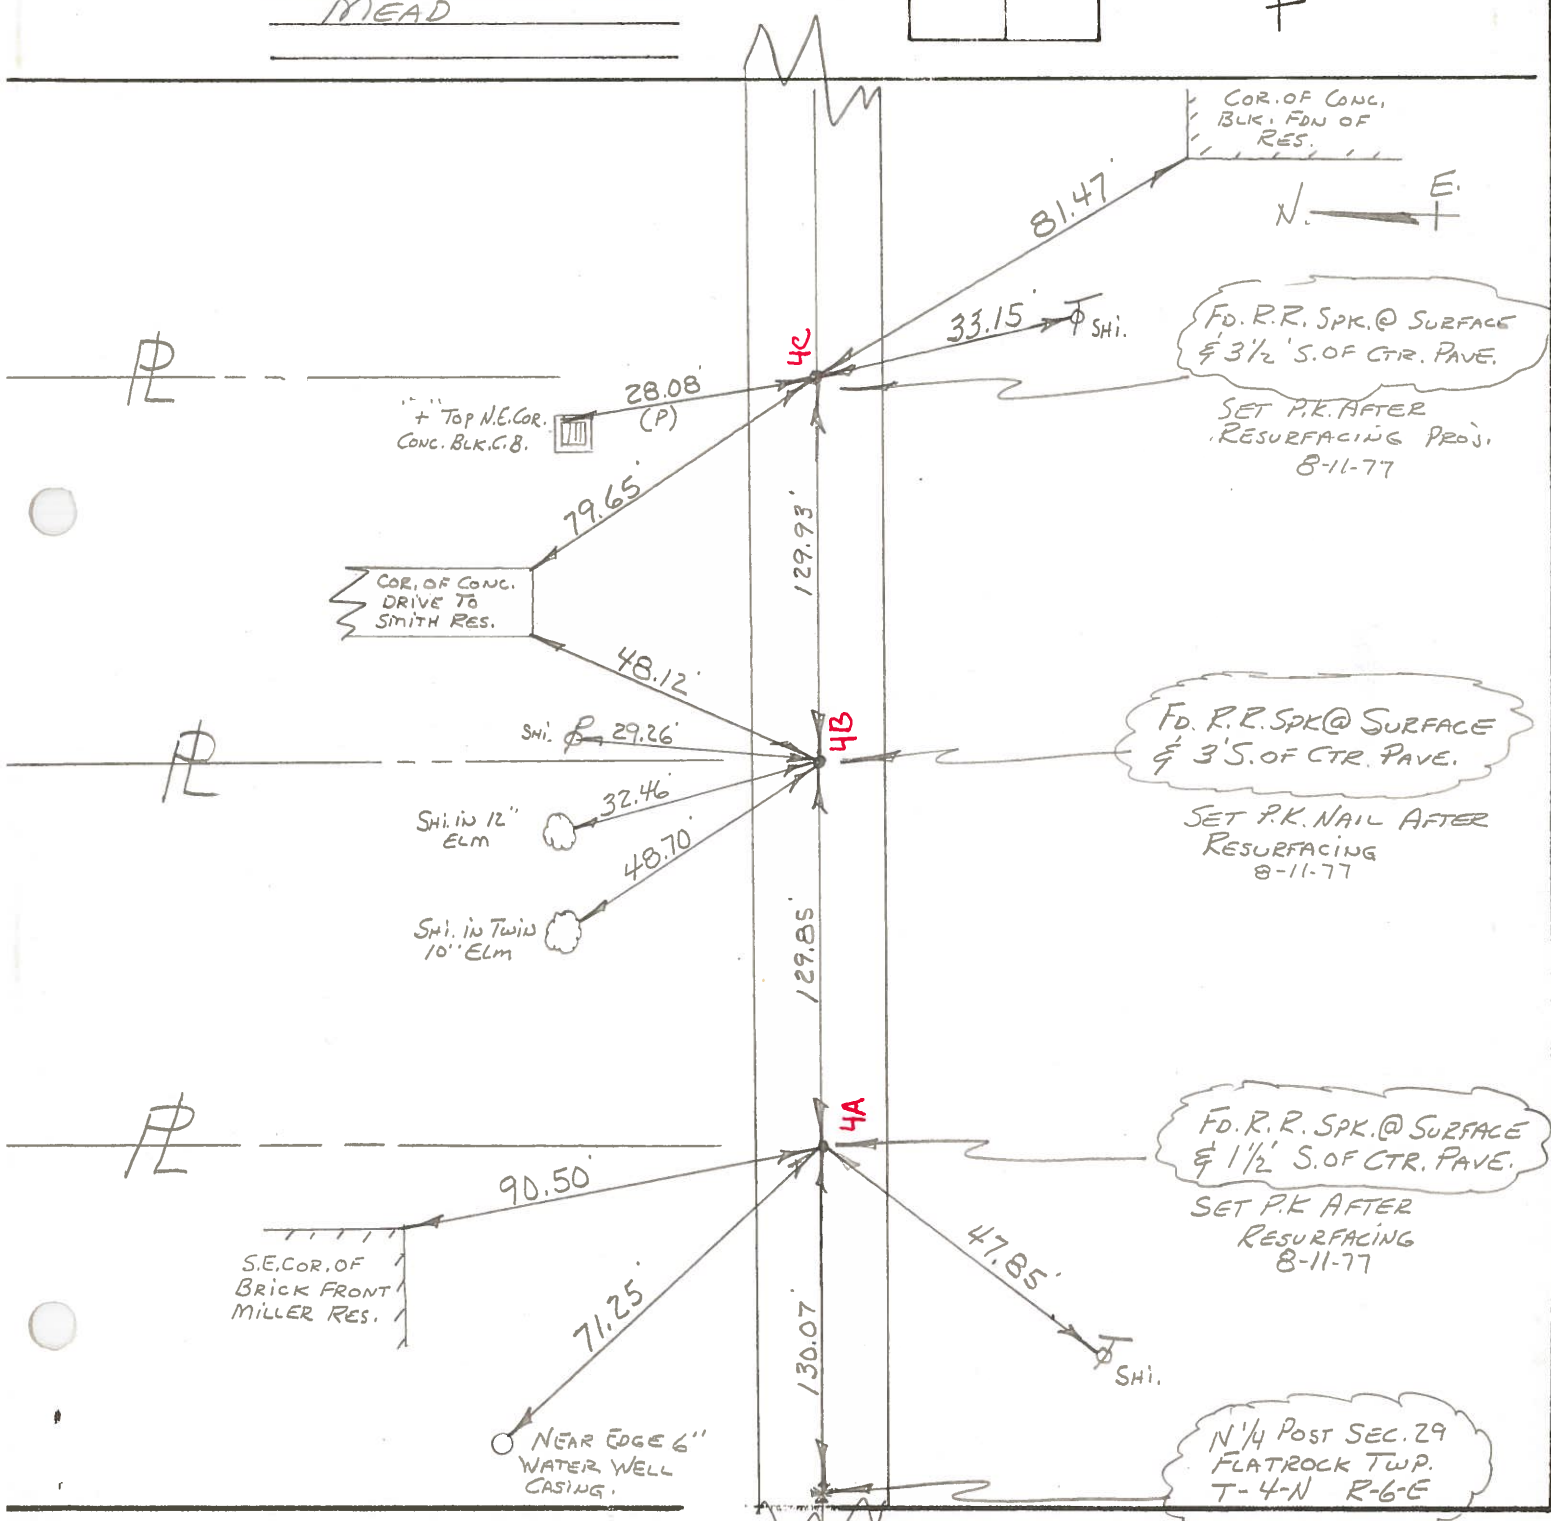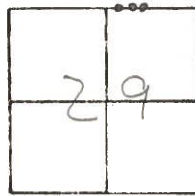

COR. OF CONC.
BLK. FDN OF
RES.

81.47'

33.15' ϕ Shi.

FD. R.R. SPK. @ SURFACE
& 3/2' S. OF CTR. PAVE.

SET P.K. AFTER
RESURFACING PROJ.
8-11-77

FD. R.R. SPK @ SURFACE
& 3' S. OF CTR. PAVE.

SET P.K. NAIL AFTER
RESURFACING
8-11-77

FD. R.R. SPK. @ SURFACE
& 1/2' S. OF CTR. PAVE.

SET P.K. AFTER
RESURFACING
8-11-77

N 1/4 Post SEC. 29
FLATROCK TWP.
T-4-N R-6-E