

O.D.O.T. DISTRICT 2 SURVEY OFFICE (USE ONLY)

PERSONNEL

REFERENCE NO. 13 A

SHEET 20 OF 20

NOTES PRESTON-COLVIN

DATE 11/26/24

ROUTE SR 281

H.C. NEISE

WEATHER WINDY

COUNTY HENRY

R.C. PRESTON-COLVIN

TEMP. 40°

TOWNSHIP FLATROCK

SECTION 25

DWG BY PRESTON-COLVIN PID PAVING TRAIN

T 4 N R 7 E

TYPE MONUMENT P.K. NAIL

ON SURFACE - ~~BELOW~~ ON

OFFSET Q PAVEMENT 6.8' ~~LT~~ : RT

4.3' TO RT EDGE PAVEMENT

STATION: 311+54.55

HORZ.DATUM: NAD83 2011


GEOID: 18

GRID: NORTHING: 592902.470


EASTING: 1524914.835

LDP: NORTHING: 449155.7

EASTING: 160167.7

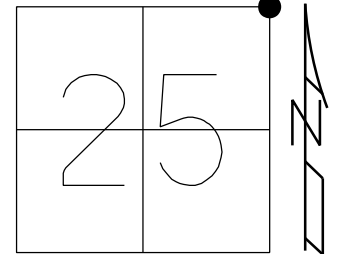

RECORD:
FD SM RR SPK
8-18-98, TMR
SET P.K./WASHER
9-28-98, MB
FD MAG/WASHER
REFA13
11-2-16, JFO
FD P.K.NAIL
REFA13
9/4/18, JFO
FD PK NAIL
7/2/24, TDN
REF13A
FD PK NAIL
11/26/24, TDN

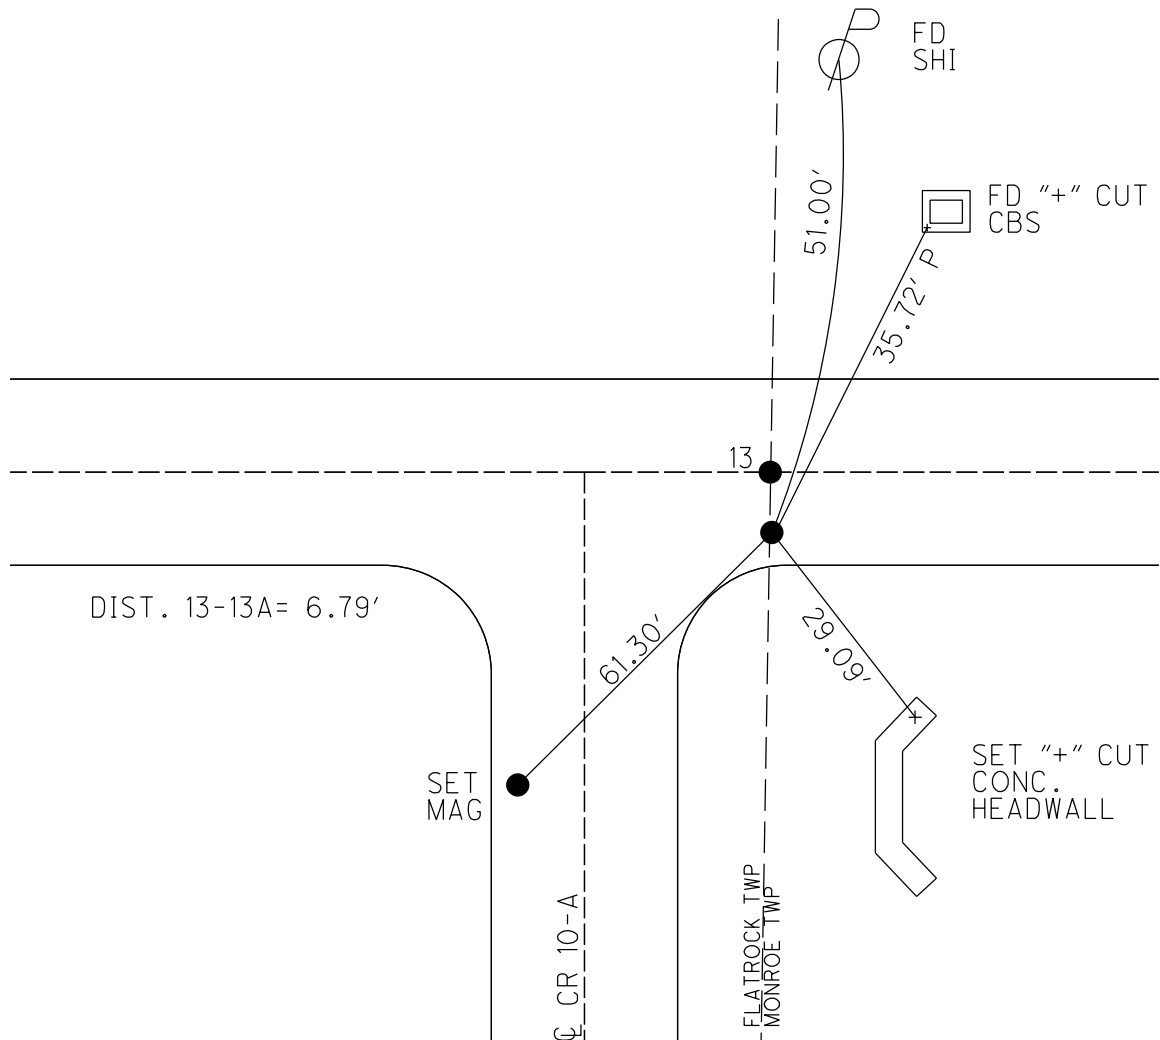

O.D.O.T. DISTRICT 2 SURVEY OFFICE (USE ONLY)

PERSONNEL

REFERENCE NO. 13 A

SHEET 20 OF 20

NOTES O'DONNELL

DATE 9/4/18

ROUTE SR 281

H.C. O'DONNELL

WEATHER SUNNY

COUNTY HENRY

R.C. MILLER

TEMP. 74°

TOWNSHIP FLATROCKSECTION 25

T_4_N R_7_E

DWG BY JAMES

PID CHIP_2

TYPE MONUMENT P.K.NAIL

ON SURFACE - ~~BELOW~~ ON

OFFSET C PAVEMENT 6.8' ~~LT~~ : RT


4.3' TO RT EDGE PAVEMENT

STATION: 311+54.55


HORZ.DATUM: NAD83 2011

GEOID:NAVD88 2012A

GRID: NORTHING: 592902.470

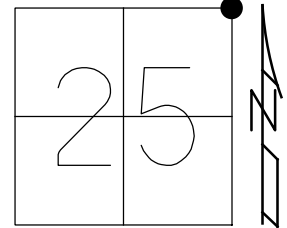EASTING: 1524914.835

RECORD:
FD SM RR SPK
8-18-98, TMR
SET P.K./WASHER
9-28-98, MB
FD MAG/WASHER
REF A13
11-2-16, JFO
FD P.K.NAIL
REF A13
9/4/18, JFO

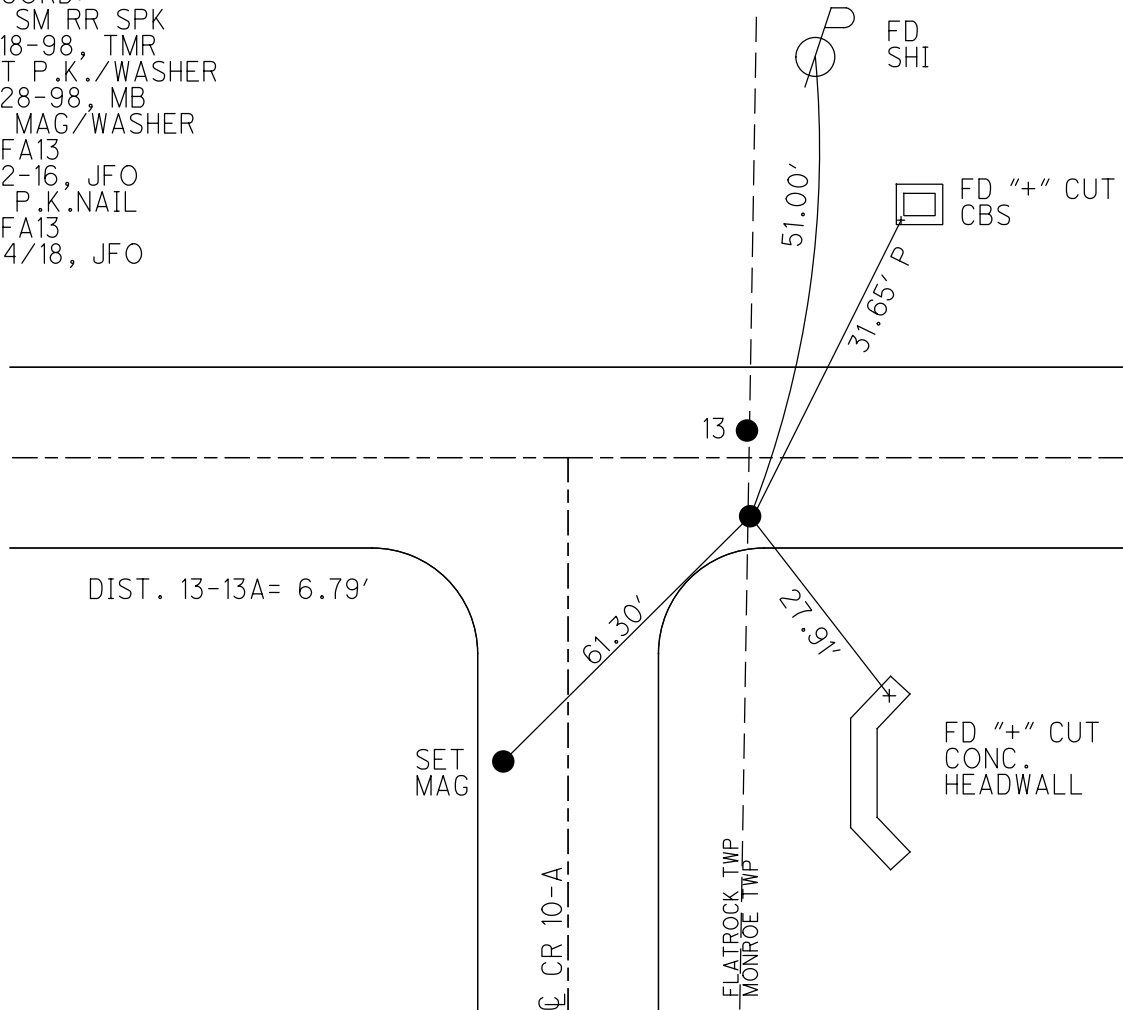

O.D.O.T. DISTRICT 2 SURVEY OFFICE

PERSONNEL

REFERENCE NO. 13

SHEET 2 OF 34

NOTES Huss

H.C. Barnhisel

R.C. Rousos

DATE 8.18.98

WEATHER FAIR

TEMP. 82°

ROUTE SR 281

COUNTY Henry

TOWNSHIP Monroe

SECTION 19

T 4 N R 7 E

TYPE MONUMENT small spk

ON SURFACE - BELOW surface

LEFT- & PAV'T. - RIGHT 6.8' Rt

TO EDGE PAVEMENT

S.L.M. 9+479.58 slk (sta 311+18 SLM)

A

B

surface

on & SR 281

24	19
25	30

FLATROCK MONROE



RECORD:
Sta. 311+49.59
Flatrock Twp

Reset P&E WASHEN
9-28-98
MB

Find 4" Top Conc
HEADWALL

Find. SAI
S/S

Find. Duplex
W/S

& Pmnt.

SR 281

Find SAI
NE/S

Find SAI
NE/S

Find 4" cut TOP CONC.
HEADWALL

Find SAI
NE/S

Co. Rd. 10-A

FLATROCK TWP
MONROE TWP

DRAWN BY TR

O.D.O.T. DISTRICT 2 SURVEY OFFICE

PERSONNEL

REFERENCE NO. 13

SHEET 2 OF

NOTES Sackman

H.C. BARNHISEL

R.C. LOEHRKE

DATE 8-12-87

WEATHER CLEAR

TEMP. +75

ROUTE SR 281

COUNTY HENRY

TOWNSHIP MONROE

SECTION 19

T4 N R 7 E

TYPE MONUMENT P.K. (MONROE TWP)

"B" R.R. SPK (FLATROCK TWP)

FLATROCK TWP MONROE TWP

ON SURFACE - BELOW YES

1 1/2' Below

LEFT- & PAW'T. - RIGHT 6.5' Lt

0.5' Lt.

24	19
25	30



"A" 3.1' TO RT. EDGE PAVEMENT
"B" 9.9' Lt
S.L.M. 311 + 18

Set small RR SPK
Both Points
8-20-87 Sack

FLATROCK MONROE

Record:
Sta. 311 + 49.59
Flatrock Twp

Fd "t" TOP CONC
HEADWALL

Set shi
N/S

Fd Duplex
w/s

6.78 BETWEEN

Left Pavt

SR 281

65.20
61.85
69.65
64.23

Set shi
N/S

Set shi
N/S

Left Pavt Co. Rd 10-A

18.2'

FLATROCK TWP
MONROE TWP

74.18

Fd shi
N/S

Fd "t" TOP CONC HDWL

FLATROCK TWP
MONROE TWP

"A"

"B"

44.01
34.75
41.90

33.83
27.94

57.26
53.31