

O.D.O.T. DISTRICT 2 SURVEY OFFICE (USE ONLY)

PERSONNEL

REFERENCE NO. 22 B

SHEET 18 OF 34

NOTES PRESTON-COLVIN

DATE 11/26/24

ROUTE SR 281

H.C. NEISE

WEATHER WINDY

COUNTY HENRY

R.C. PRESTON-COLVIN

TEMP. 40°

TOWNSHIP MONROE

SECTION 24

DWG BY PRESTON-COLVIN

PID PAVING TRAIN

T 4 N R 7 E

TYPE MONUMENT PK NAIL

ON SURFACE - ~~BELOW~~ ON

OFFSET $\varnothing$ PAVEMENT 1.0' ~~LT~~ : RT

- TO - EDGE PAVEMENT

STATION: 576+06

HORIZ.DATUM: NAD83 2011


GEOID: 18

GRID: NORTHING: 592611.755

EASTING: 1551393.702


LDP: NORTHING: 449352.7

EASTING: 186649.9

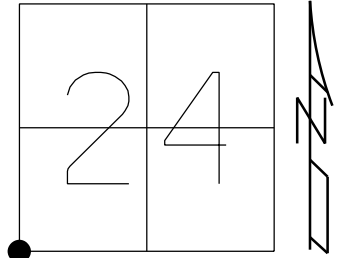

RECORD:
FD HARROW TOOTH
SQUARE SPIKE
BY COUNTY
6/5/79
FD SM.R.R. SPIKE
5/28/98, MC
SET P.K./WASHER
10/1/98, MRC
FD HARROW TOOTH
5" DOWN
REF22B
7/22/24, TDN

BELIEVED TO BE
ON $\varnothing$ CONSTRUCTION

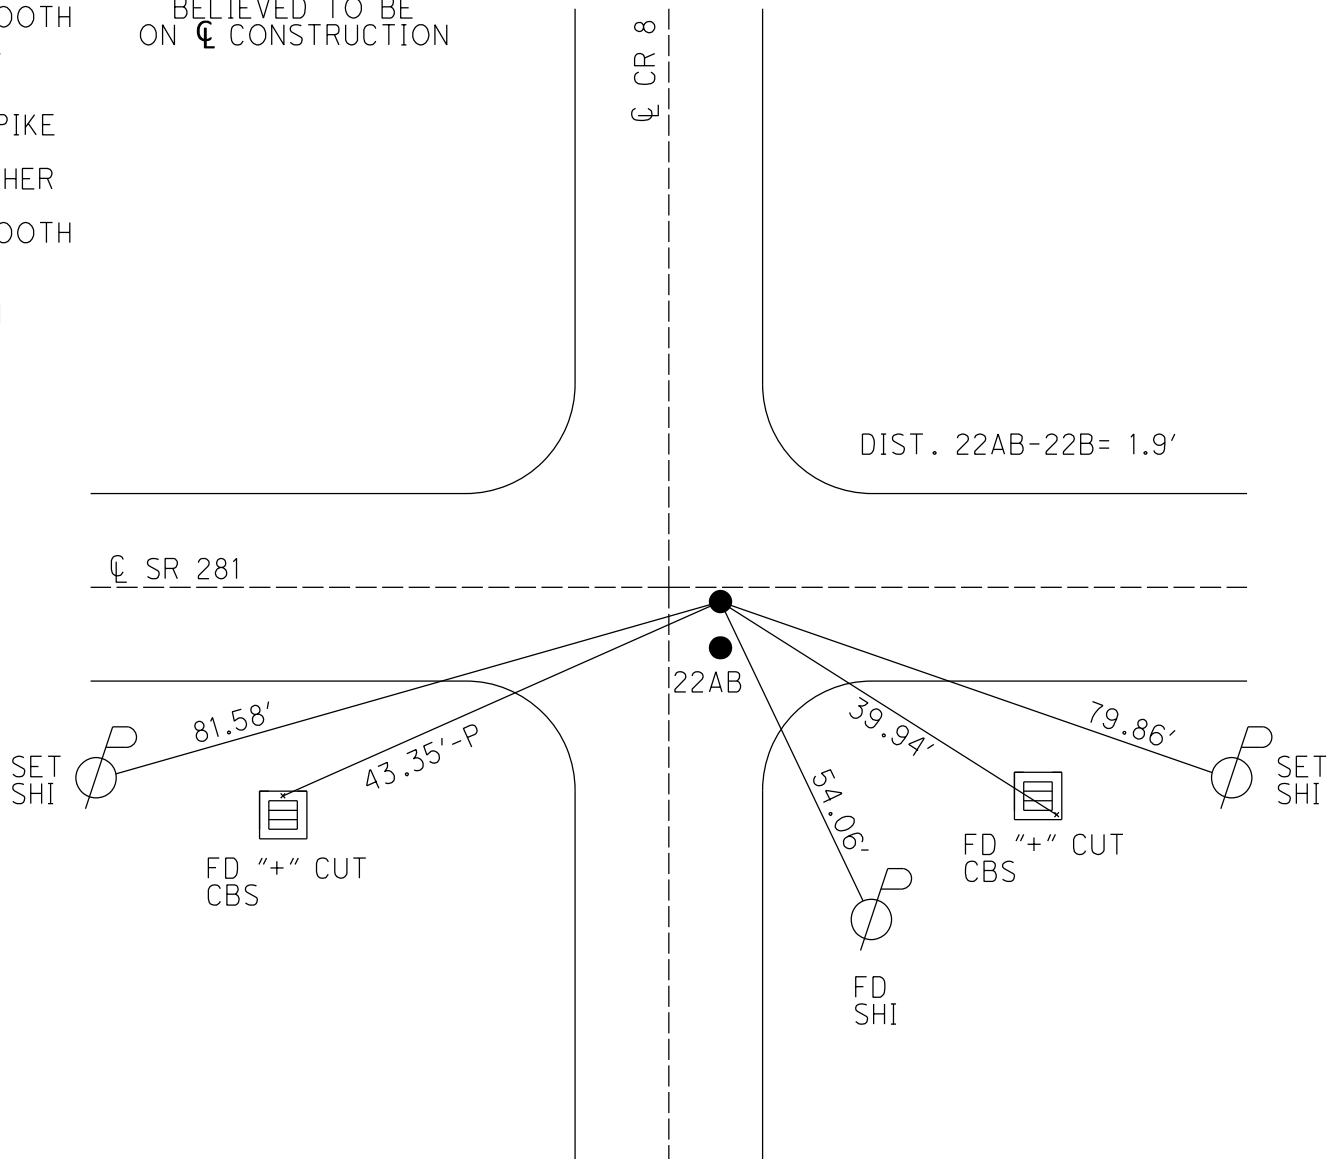

O.D.O.T. DISTRICT 2 SURVEY OFFICE (USE ONLY)

PERSONNEL

REFERENCE NO. 22 B

SHEET 18 OF 34

NOTES RHOADES

DATE 9/6/18

ROUTE SR 281

H.C. O'DONNELL

WEATHER FAIR

COUNTY HENRY

R.C. RHOADES

TEMP. 76°

TOWNSHIP MONROE

SECTION 24

DWG BY NIESE PID CHIP_2

T 4 N R 7 E

TYPE MONUMENT P.K.NAIL

ON SURFACE - ~~BELOW~~ ON

OFFSET 1.0' LT : RT

- TO - EDGE PAVEMENT


STATION: 576+06

HORZ.DATUM: NAD83(2011)

GEOID: 2012A

GRID: NORTHING: 592611.755

EASTING: 1551393.702

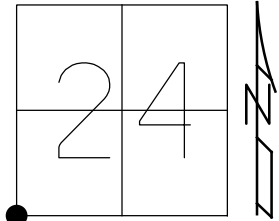


RECORD:
FD HARROW TOOTH
SQUARE SPIKE
BY COUNTY
6/5/79
FD SM.R.R. SPIKE
5/28/98, MC
SET P.K./WASHER
10/1/98, MRC
FD P.K.NAIL
REFB22
9/6/18, JFO
7/25/19, JMR

CR 8

DIST. 22AB-22B= 1.88' REC

SR 281

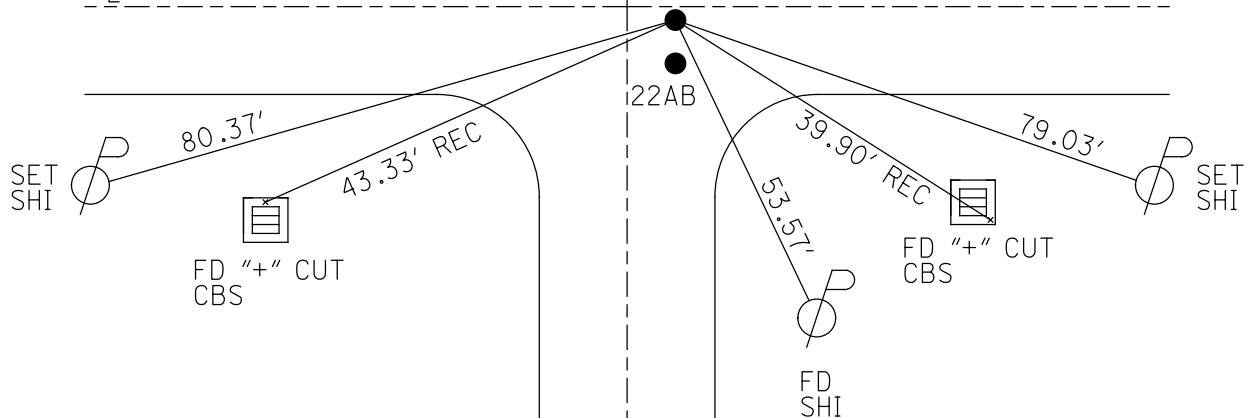

O.D.O.T. DISTRICT 2 SURVEY OFFICE

PERSONNEL

REFERENCE NO. 22-B

SHEET 19 OF 34

NOTES Center bury

H.C. Rousos

R.C. Nuffer

DATE 5-28-98

WEATHER Fair

TEMP. +75°

ROUTE SR 281

COUNTY HENRY

TOWNSHIP MONROE

SECTION 24

T4 N R7 E

TYPE MONUMENT A - Sm RR spike / B - Sm RR spike

ON SURFACE - BELOW Surface

LEFT - 0 PAV'T. - RIGHT 2.8' Rt / B 1.0' Rt &

— JO — EDGE PAVEMENT


S.L. A 17+560.005 SLK, B 17+560.000 SLK (576+06 SLK)

23	24
26	25



'A' RR spike set over stone
By County 6-5-79
'B' Harrow Tooth square spike
Fnd. By County 6-5-79
Between 1.88"

RESET PK & WASHER
Both Points
10-1-98
MRC

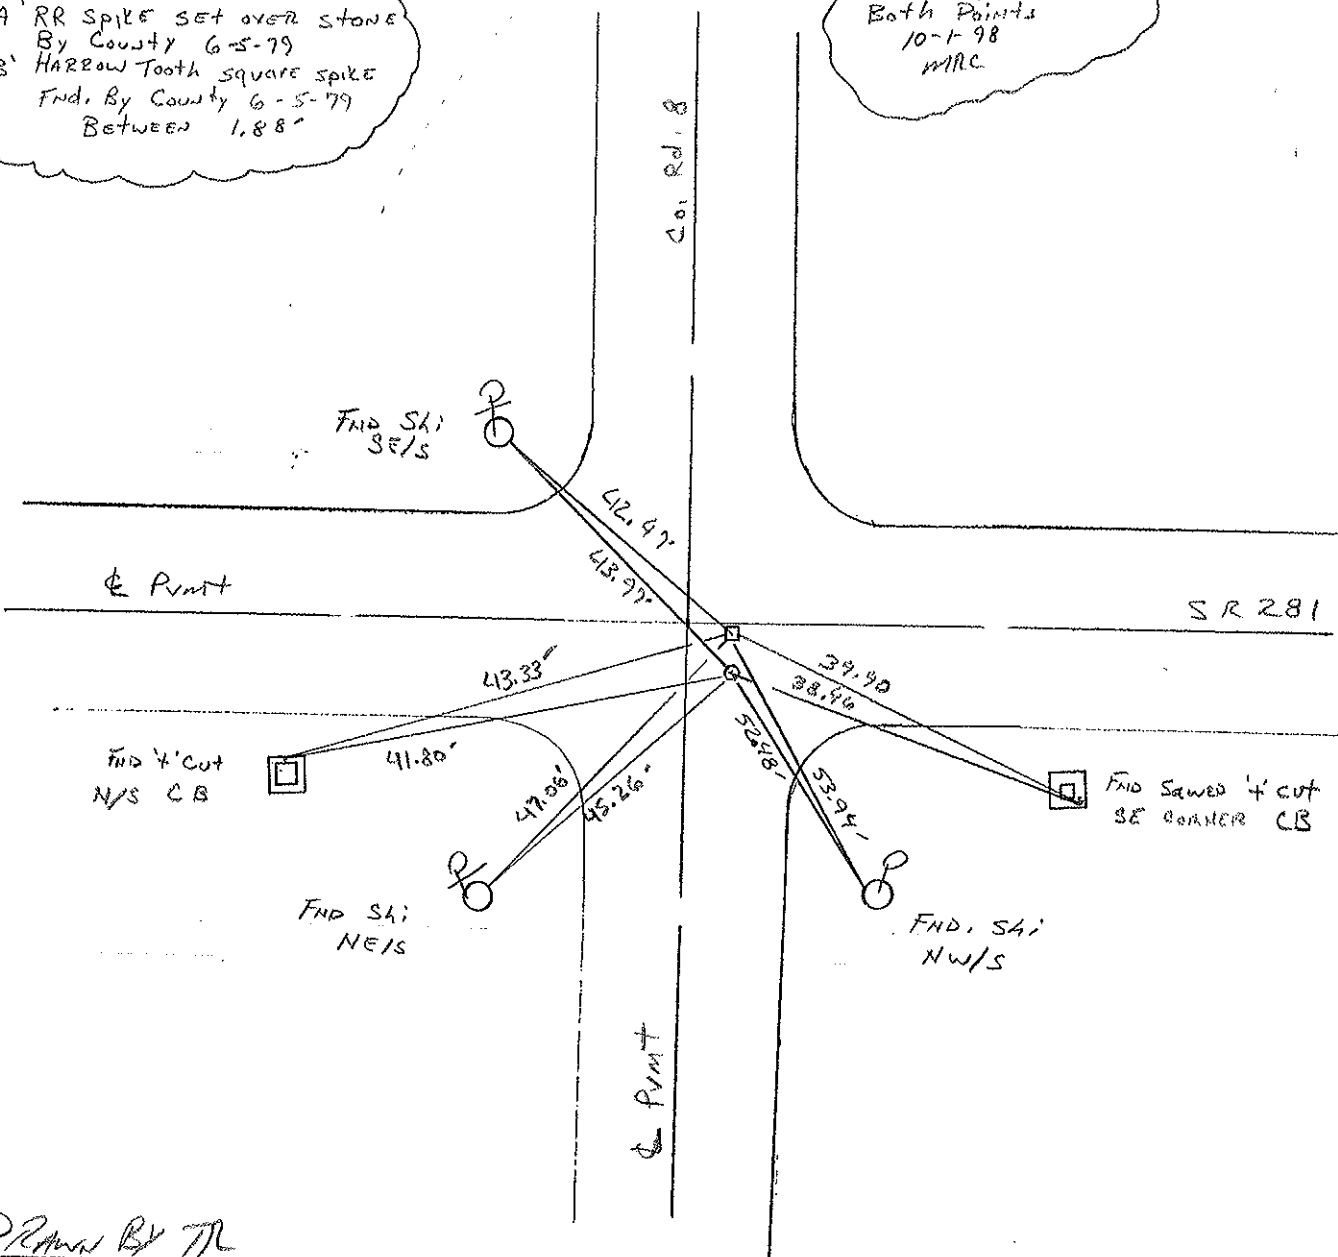

Drawn By TR

O.D.O.T. DISTRICT 2 SURVEY OFFICE

PERSONNEL

REFERENCE NO. 22-B

SHEET 19 OF

NOTES Sackman

H.C. BARN HISE

R.C. LOHRKE

DATE 8-13-87

WEATHER HAZY

TEMP. +72

ROUTE SR 281

COUNTY HENRY

TOWNSHIP MONROE

SECTION 24

T4 NR 7 E

Set Sm RR Spikes "A" "B"
TYPE MONUMENT R.R. SPIKE / HARROW tooth SPIKE

ON SURFACE - BELOW 1 1/2" / 1 1/2"

LEFT- & PAV'T. - RIGHT 2.5' / 0.7'

TO EDGE PAVEMENT 3.2' East of E Part Co. Rd "B" Loc 14

S.L.M. 576 +06

23	24
26	25



"A" RR SPK set OVER STONE
By County 6-5-79

"B" HARROW tooth, SQUARE SPIKE
Fd by County 6-5-79

BETWEEN 1.88

BETWEEN: 688

Set Sm. RR. Spikes
9-2-87
C.L.

Fd "t" N/S.
C.B.

Set shi
SE/S

& Part

SR 281

cut "t" N/S
C.B.

Set shi
NE/S

Set shi
NW/S

& Part

Co. Rd B

42.53
44.03
41.67 P

41.93 P

45.27


53.97
52.50

COUNTY HENRY S.R. 281

TOWNSHIP MONROE

SECTION 25

Sheet 1 of 3
T 4 N . R 7 E

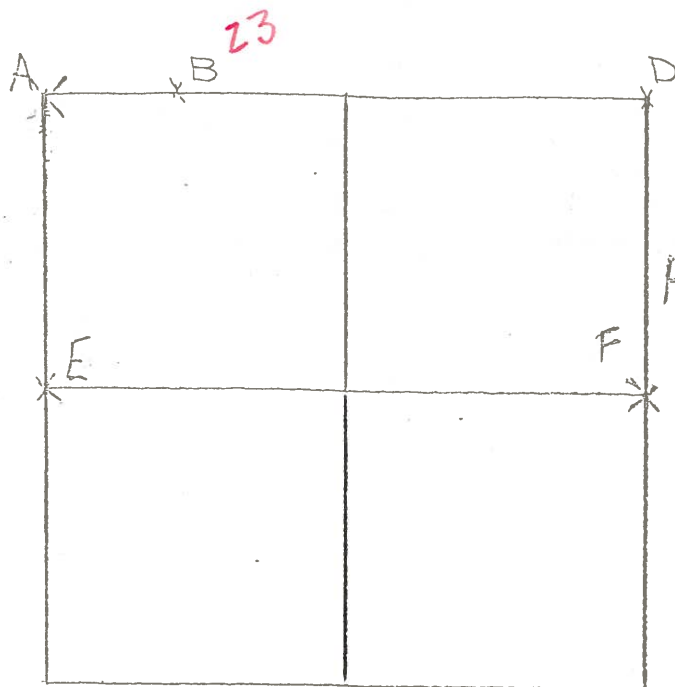

6-26-79 R.W. G.M.
F- FOUND STONE (8"x10"x12")
18" BELOW ROAD SURFACE. FOUND
PROKEN CLAY TILE OVER STONE
PLACED CENTER PUNCHED R.R.
SPIKE ON SURFACE OVER
HIGH POINT OF STONE. P.K.'s
SET 6' N.E. & S.E.

STONE LOCATED 0.33' EAST OF WEST EDGE OF 18'
P.R. SPK. NT

55.86' E.S.E. TO DUPLEX N/S

74.18' S.S.E. TO "+" N.W. COR. CATCH BASIN (PLUMBED)

69.46' S.S.W. TO "+" END 8" DIA. CONC. PIPE (PLUMBED)

134.88' N.N.E. TO DUPLEX W/S

43.12' S. TO W 1/4 POST RICHFIELD TWP.

6-5-79 R.W. J.J. G.M.

A- FOUND SQUARE SPIKE (8" LONG) ON E S.R. 281. FOUND
STONE (8"x10"x14") 18" BELOW ROAD SURFACE. SPIKE LOCATED
1.93' N. AND 0.20' E. OF STONE. FOUND SMALL STONE OVER
TRUE STONE. REMOVED SMALL STONE AND PLACED CENTER
PUNCHED R.R. SPIKE ON SURFACE OVER HIGH POINT OF STONE
P.K.'s SET 6' S. AND E.

R.R. SPIKE

SQUARE SPIKE (8" Lg)

44.04' - N.W. TO DUPLEX E/S - 42.49'

52.72' - S.S.E. TO DUPLEX W/S - 54.24'

45.45' - S.S.W. TO DUPLEX E/S