

O.D.O.T. DISTRICT 2 SURVEY OFFICE (USE ONLY)

PERSONNEL

REFERENCE NO. 22 AB

SHEET 17 OF 34

NOTES PRESTON-COLVIN

DATE 11/26/24

ROUTE SR 281

H.C. NEISE

WEATHER WINDY

COUNTY HENRY

R.C. PRESTON-COLVIN

TEMP. 40°

TOWNSHIP MONROE

SECTION 24

DWG BY PRESTON-COLVIN

PID PAVING TRAIN

T 4 N R 7 E

TYPE MONUMENT PK NAIL

ON SURFACE - ~~BELOW~~ ON

OFFSET $\angle$ PAVEMENT 2.8' ~~LT~~ : RT

- TO - EDGE PAVEMENT

STATION: 576+06

HORZ. DATUM: NAD83 2011


GEOID: 18

GRID: NORTHING: -

EASTING: -


LDP: NORTHING: 449350.8

EASTING: 186649.6

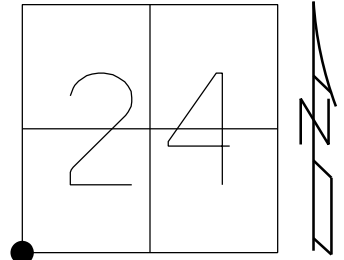

RECORD:
FD R.R.SPIKE,
SET BY COUNTY
OVER STONE
6/5/79
FD SM.R.R.SPIKE
5/28/98, MC
SET P.K./WASHER
10/1/98, MRC
FD P.K.NAIL
REF22AB
9/6/18, JFO
7/25/19,
1/11/23, JMR
FD PK NAIL
REF22AB
7/22/24, TDN
FD PK NAIL
11/26/24, TDN

SW CORNER OF SEC 24
P.I. OF $\angle$ SURVEY

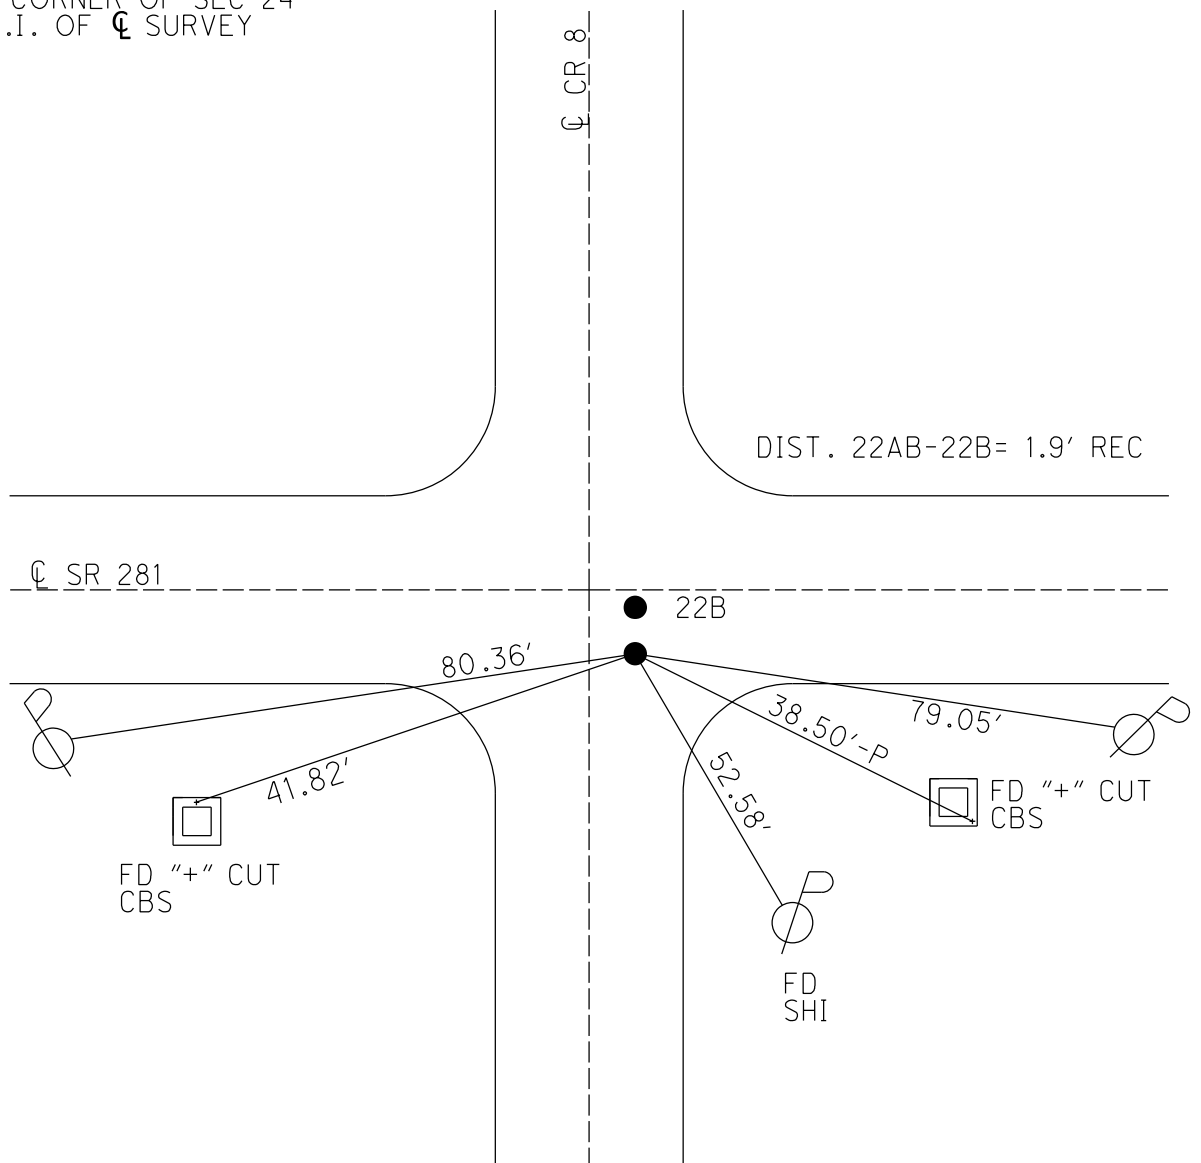

O.D.O.T. DISTRICT 2 SURVEY OFFICE (USE ONLY)

PERSONNEL

REFERENCE NO. 22 AB

SHEET 17 OF 34

NOTES CANTERBURY

DATE 5/28/98

ROUTE SR 281

H.C. ROUSOS

WEATHER FAIR

COUNTY HENRY

R.C. NUHFER

TEMP. 75°

TOWNSHIP MONROE

SECTION 24

DWG BY NIESE PID PAVETRAIN

T 4 N R 7 E

TYPE MONUMENT SM.R.R.SPIKE

ON SURFACE - ~~BELOW~~ ON

OFFSET Q PAVEMENT 2.8' ~~LT~~ : RT

- TO - EDGE PAVEMENT


STATION: 576+06

HORZ.DATUM: -

GEOID: -

GRID: NORTHING: -

EASTING: -

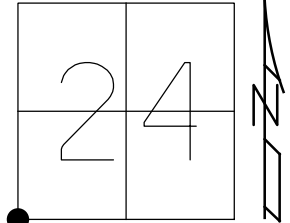

RECORD:
FD R.R.SPIKE,
SET BY COUNTY
OVER STONE
6/5/79
FD SM.R.R.SPIKE
5/28/98, MC
SET P.K./WASHER
10/1/98, MC
DNF
9/6/18, JFO
1/11/23, JMR

Q CR 8

DIST. 22AB-22B= 1.88' REC

Q SR 281

22B

41.80' REC

FD "+" CUT
CBS

38.46' REC

FD "+" CUT
CBS

52.48' REC

FD
SHI

O.D.O.T. DISTRICT 2 SURVEY OFFICE (USE ONLY)

PERSONNEL

REFERENCE NO. 22 AB

SHEET 17 OF 34

NOTES CANTERBURY

DATE 5/28/98

ROUTE SR 281

H.C. ROUSOS

WEATHER FAIR

COUNTY HENRY

R.C. NUHFER

TEMP. 75°

TOWNSHIP MONROE

SECTION 24

DWG BY NIESE PID CHIP_2

T 4 N R 7 E

TYPE MONUMENT SM.R.R.SPIKE

ON SURFACE - ~~BELOW~~ ON

OFFSET CL PAVEMENT 2.8' ~~LT~~ : RT

- TO - EDGE PAVEMENT


STATION: 576+06

HORZ.DATUM: -

GEOID: -

GRID: NORTHING: -


EASTING: -

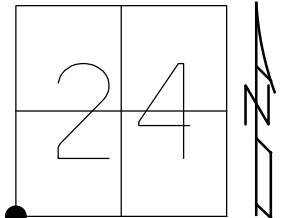

RECORD:
FD R.R.SPIKE,
SET BY COUNTY
OVER STONE
6/5/79
FD SM.R.R.SPIKE
5/28/98, MC
SET P.K./WASHER
10/1/98, MC
DNF
9/6/18, JFO

CL CR 8

DIST. 22AB-22B= 1.88' REC

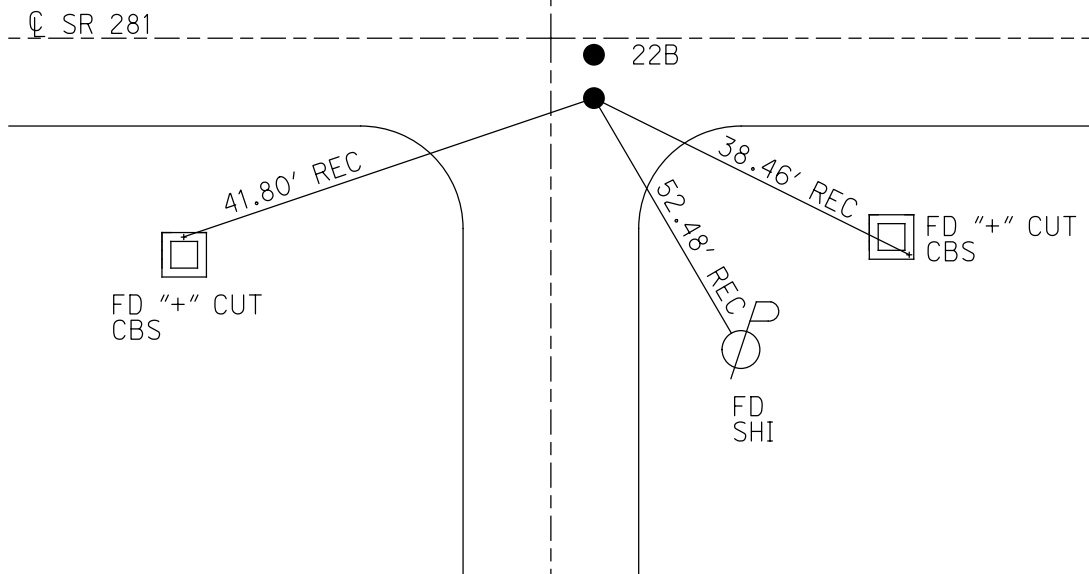

O.D.O.T. DISTRICT 2 SURVEY OFFICE

PERSONNEL

REFERENCE NO. 22-B

SHEET 19 OF 34

NOTES Center bury

H.C. Rousos

R.C. Nuffer

DATE 5-28-98

WEATHER Fair

TEMP. +75°

ROUTE SR 281

COUNTY HENRY

TOWNSHIP MONROE

SECTION 24

T4 N R7 E

TYPE MONUMENT A - Sm RR spike / B - Sm RR spike

ON SURFACE - BELOW Surface

LEFT - 0 PAV'T. - RIGHT 2.8' Rt / B 1.0' Rt &

— TO — EDGE PAVEMENT


S.L. A 17+560.005 SLK, B 17+560.000 SLK (576+06 SLK)

23	24
26	25



'A' RR spike set over stone
By County 6-5-79
'B' Harrow Tooth square spike
Fnd. By County 6-5-79
Between 1.88"

RESET PK & WASHER
Both Points
10-1-98
MRC

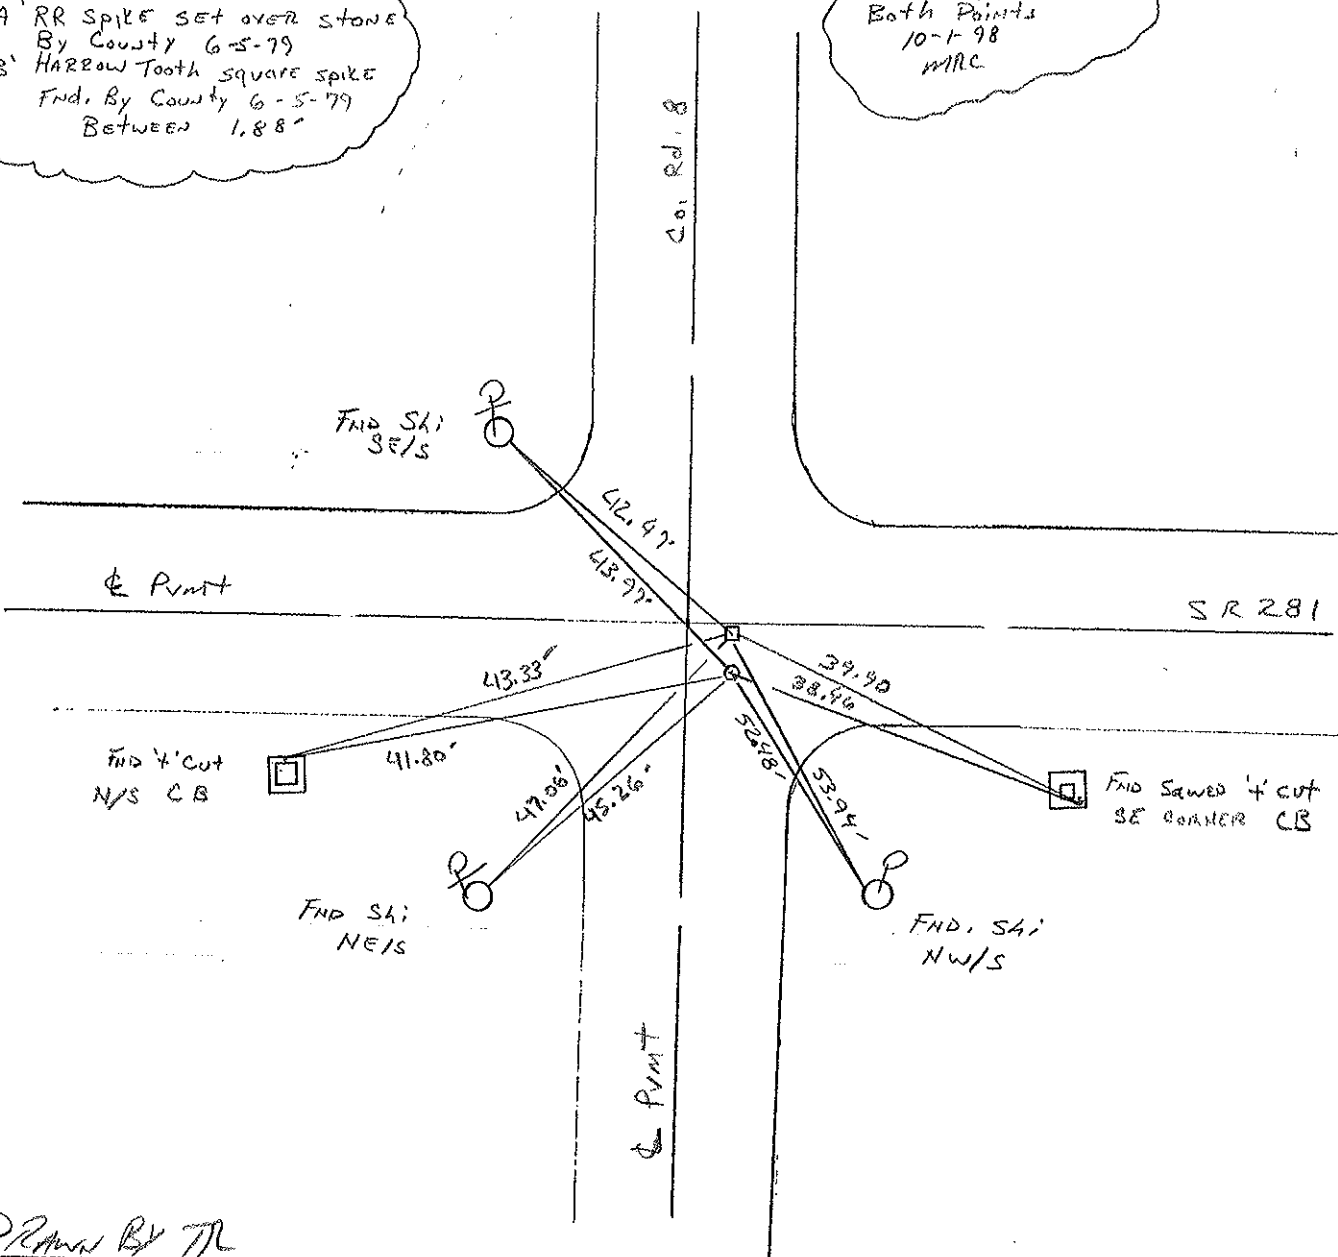

Drawn By TR

O.D.O.T. DISTRICT 2 SURVEY OFFICE

PERSONNEL

REFERENCE NO. 22-B

SHEET 19 OF

NOTES Sackman

H.C. BARN HISE

R.C. LOHRKE

DATE 8-13-87

WEATHER HAZY

TEMP. +72

ROUTE SR 281

COUNTY HENRY

TOWNSHIP MONROE

SECTION 24

T4 NR 7 E

Set Sm RR Spikes "A" "B"
TYPE MONUMENT R.R. SPIKE / HARROW tooth SPIKE

ON SURFACE - BELOW 1 1/2" / 1 1/2"

LEFT- & PAV'T. - RIGHT 2.5' / 0.7'

TO EDGE PAVEMENT 3.2' East of E Part Co. Rd "8" North

S.L.M. 576 +06

23	24
26	25



"A" RR SPK set OVER STONE
By County 6-5-79

"B" HARROW tooth, SQUARE SPIKE
Fd by County 6-5-79

BETWEEN 1.88

BETWEEN: 688

Set Sm. RR. Spikes
9-2-87
C.L.

Fd "t" N/S.
C.B.

Set shi
SE/S

& Part

SR 281

cut "t" N/S
C.B.

Set shi
NE/S

Set shi
NW/S

& Part

Co. Rd 8

42.53
44.03
41.67 P

41.93 P

45.27

53.97
52.50