

O.D.O.T. DISTRICT 2 SURVEY OFFICE (USE ONLY)

PERSONNEL

REFERENCE NO. 23

SHEET 19 OF 34

NOTES PRESTON-COLVIN

H.C. NEISE

R.C. PRESTON-COLVIN

DATE 11/26/24

WEATHER WINDY

TEMP. 40°

ROUTE SR 281

COUNTY HENRY

TOWNSHIP MONROE

SECTION 24

DWG BY PRESTON-COLVIN

PID PAVING TRAIN

T 4 N R 7 E

TYPE MONUMENT SM RR SPIKE

ON SURFACE - ~~BELOW~~ 5.5" DOWN

OFFSET CL PAVEMENT ON ~~LT~~ : RT

10.4' TO RT EDGE PAVEMENT

STATION: 589+31

HORIZ.DATUM: NAD83 2011


GEOID: 18

GRID: NORTHING: 592604.447

EASTING: 1552718.822


LDP: NORTHING: 449367.7

EASTING: 187974.8

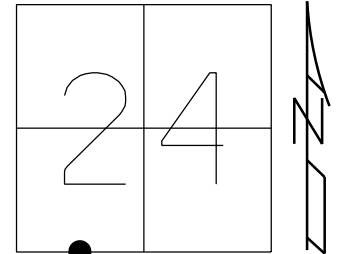

RECORD:
 1/4-1/4 COR SEC 24
 FD SM.R.R.SPIKE
 8/18/98, MC
 SET SM.R.R.SPIKE
 9/2/87, CL
 FD SM.R.R.SPIKE
 8/18/98, MC
 SET P.K./WASHER
 10/1/98, MRC
 FD P.K.SHANK
 REF23
 9/6/18, JFO
 7/25/19,
 1/11/23, JMR
 FD PK SHANK
 REF23
 7/23/24, TDN
 FD SM RRSPK
 NEW REF23
 5.5" DOWN
 11/26/24, TDN

FD CONC FENCE
 LEANING SOUTH
 COR OF "L" BAR

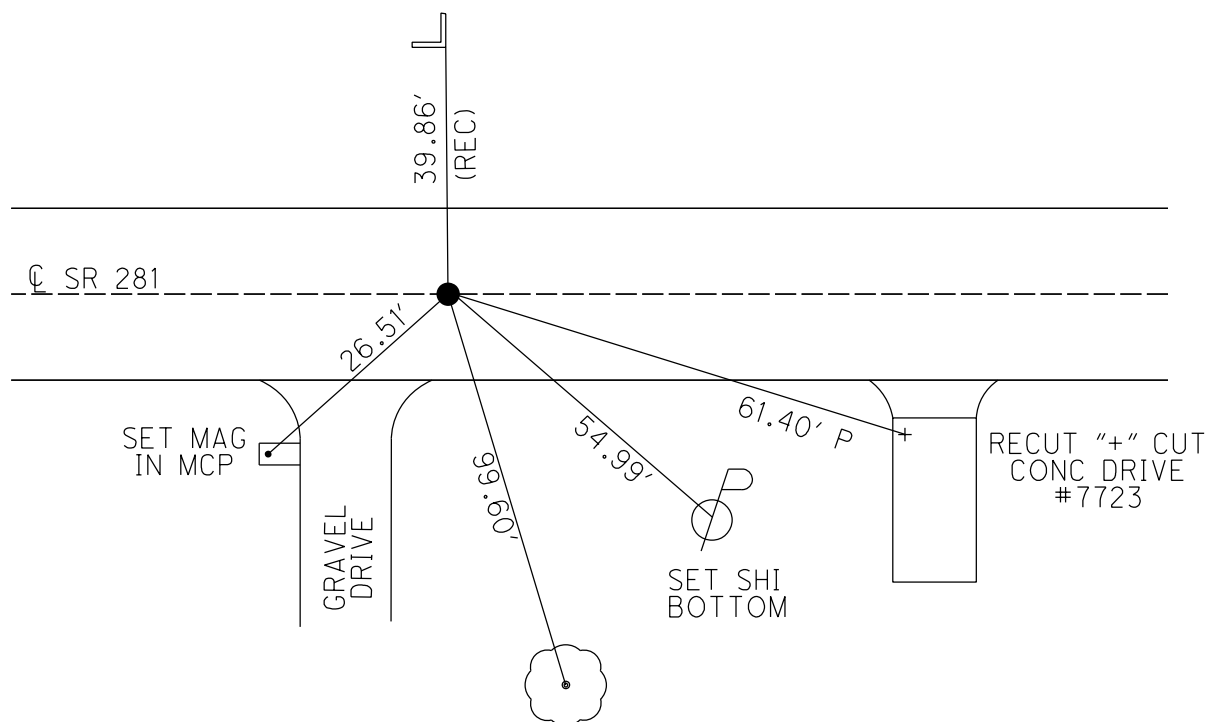

O.D.O.T. DISTRICT 2 SURVEY OFFICE (USE ONLY)

PERSONNEL

REFERENCE NO. 23

SHEET 19 OF 34

NOTES RHOADES

DATE 9/6/18

ROUTE SR 281

H.C. O'DONNELL

WEATHER FAIR

COUNTY HENRY

R.C. RHOADES

TEMP. 76°

TOWNSHIP MONROEDWG BY NIESE

PID PAVETRAIN

T 4 N R 7 F

TYPE MONUMENT P.K. SHANK

ON SURFACE - ~~BELOW~~ ON

OFFSET C PAVEMENT _____ ON _____ LT : RT _____


10.4' TO RT EDGE PAVEMENT

STATION: 589+31


HORZ.DATUM: NAD83(2011)

GEOID: 2012A

GRID: NORTHING: 592604.447

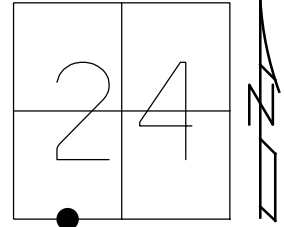EASTING: 1552718.822

RECORD:
1/4-1/4 COR SEC 24
FD SM.R.R.SPIKE
8/18/98, MC
SET SM.R.R.SPIKE
9/2/87, CL
FD SM.R.R.SPIKE
8/18/98, MC
SET P.K./WASHER
10/1/98, MRC
FD P.K.SHANK
REF23
9/6/18, JFO
7/25/19,
1/11/23, JMR

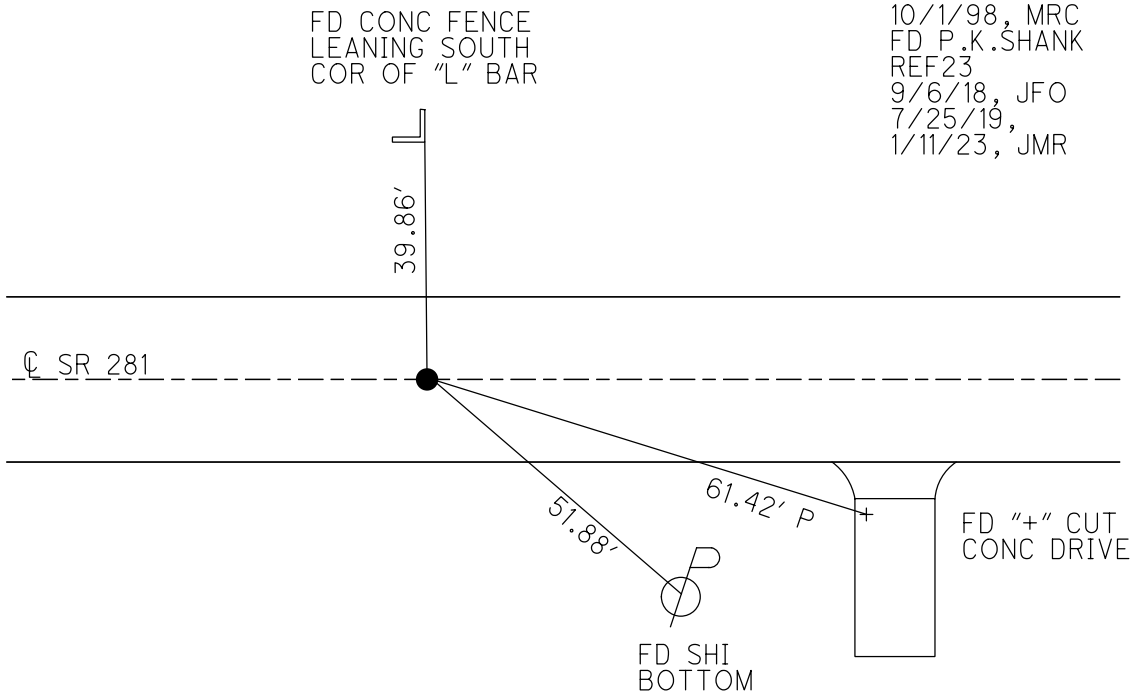

O.D.O.T. DISTRICT 2 SURVEY OFFICE (USE ONLY)

PERSONNEL

REFERENCE NO. 23

SHEET 19 OF 34

NOTES RHOADES

DATE 9/6/18

ROUTE SR 281

H.C. O'DONNELL

WEATHER FAIR

COUNTY HENRY

R.C. RHOADES

TEMP. 76°

TOWNSHIP MONROE

SECTION 24

DWG BY NIESE PID CHIP_2

T 4 N R 7 E

TYPE MONUMENT P.K. SHANK

ON SURFACE - ~~BELOW~~ ON

OFFSET CL PAVEMENT ON LT : RT

10.4' TO RT EDGE PAVEMENT


STATION: 589+31

HORIZ.DATUM: NAD83(2011)


GEOID: 2012A

GRID: NORTHING: 592604.447

EASTING: 1552718.822

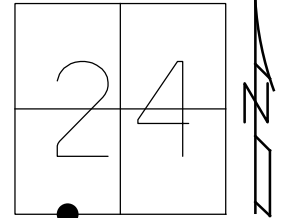

RECORD:
1/4-1/4 COR SEC 24
FD SM.R.R.SPIKE
8/18/98, MC
SET SM.R.R.SPIKE
9/2/87, CL
FD SM.R.R.SPIKE
8/18/98, MC
SET P.K./WASHER
10/1/98, MRC
FD P.K.SHANK
REF23
9/6/18, JFO
7/25/19, JMR

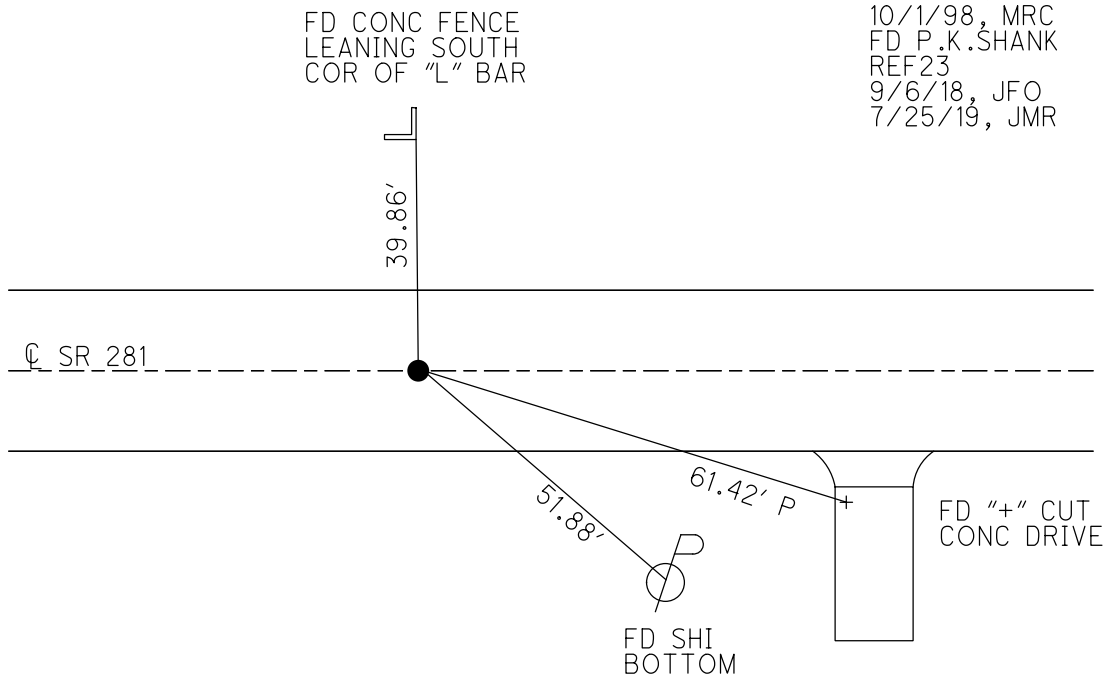

O.D.O.T. DISTRICT 2 SURVEY OFFICE

PERSONNEL

REFERENCE NO. 23

SHEET 20 OF 34

NOTES Canterbury

H.C. Rousos

R.C. Nuffer

DATE 8-18-98

WEATHER FAIR

TEMP. +84°F

ROUTE SR 281

COUNTY HENRY

TOWNSHIP MONROE

SECTION 24

T4 N R 7 E


TYPE MONUMENT Sm RR spk

ON SURFACE - BELOW ON SURFACE

LEFT-CL PAW'T. - RIGHT ON CL

10.4 TO RT EDGE PAVEMENT


S.L.M. 17+961.40 S/LK (Sta 589+31.6m)

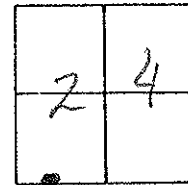

RECORD:
V4-V9 COR. SEC. 24-25

Reset PK & VASHA
10-1-98
MAC

Sm RR spk
Set 9-2-87
CL

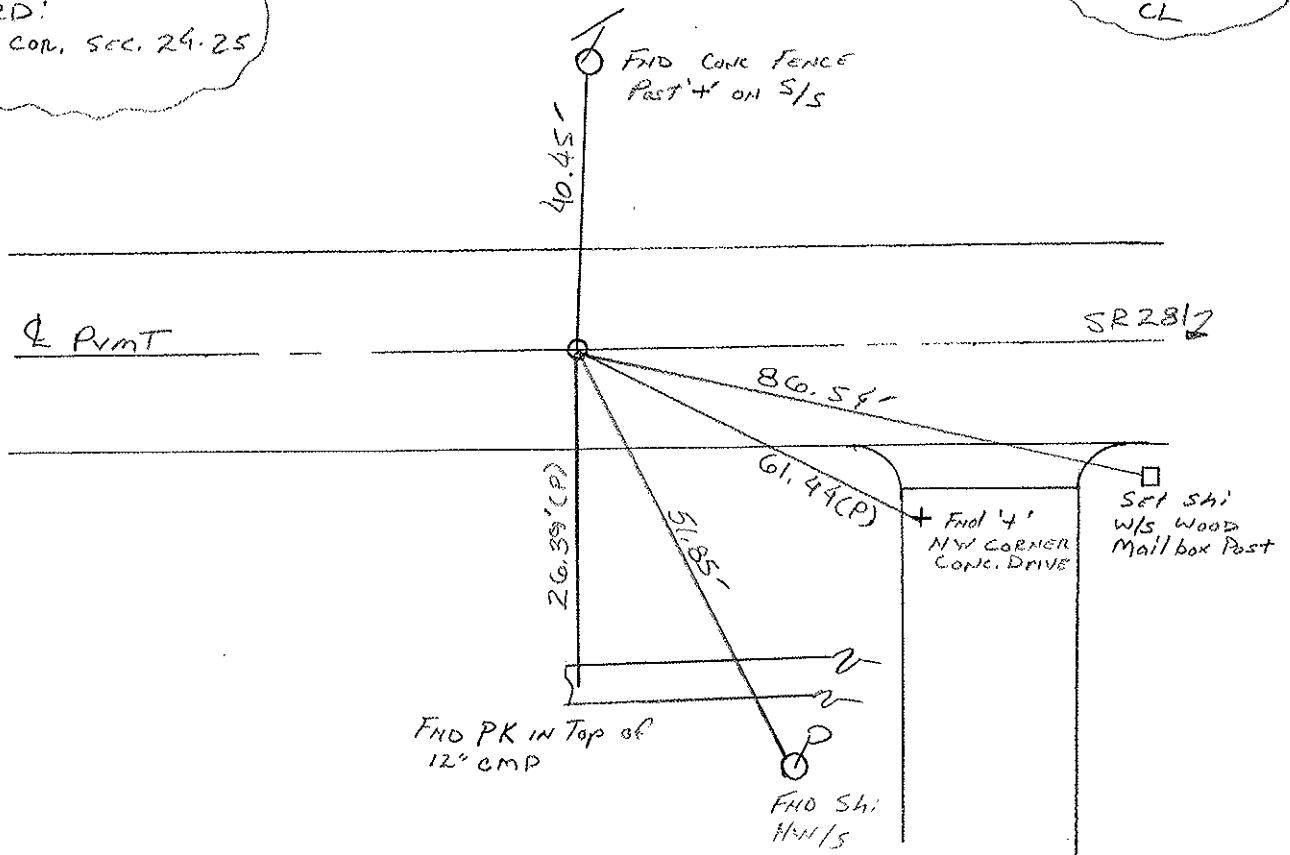

DRAWN BY MR

O.D.O.T. DISTRICT 2 SURVEY OFFICE

PERSONNEL

REFERENCE NO. 23

SHEET 20 OF

NOTES Sackman

H.C. BARNHISEL

R.C. LOEHRKE

DATE 8-13-87

WEATHER HAZY

TEMP. + 73

ROUTE SR 281

COUNTY HENRY

TOWNSHIP MONROE

SECTION 24

T4 N R 7 E


TYPE MONUMENT SMALL R.R. SPIKE

ON SURFACE - BELOW YES

~~LEFT - & PAV'T. - RIGHT~~ YES

9.9 TO RT EDGE PAVEMENT


S.L.M. 589+31

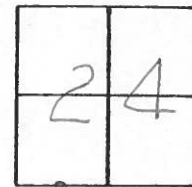

Record:

1/4 - 1/4 COR SEC 24-25

Set Sm. R.R. Spike
9-2-87
CL

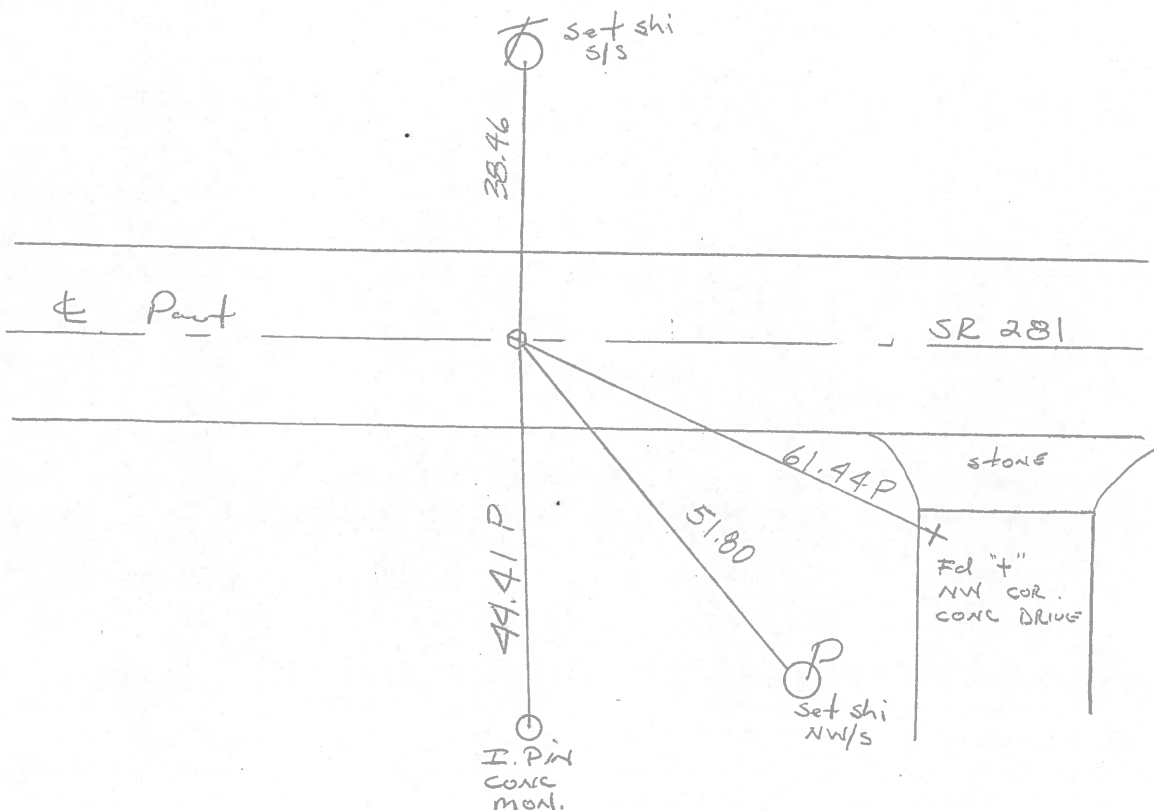


COUNTY HENRY S.R. 281

SHEET 2 OF 5
T 4 N , R 7 E

TOWNSHIP MONROE

SECTION 25

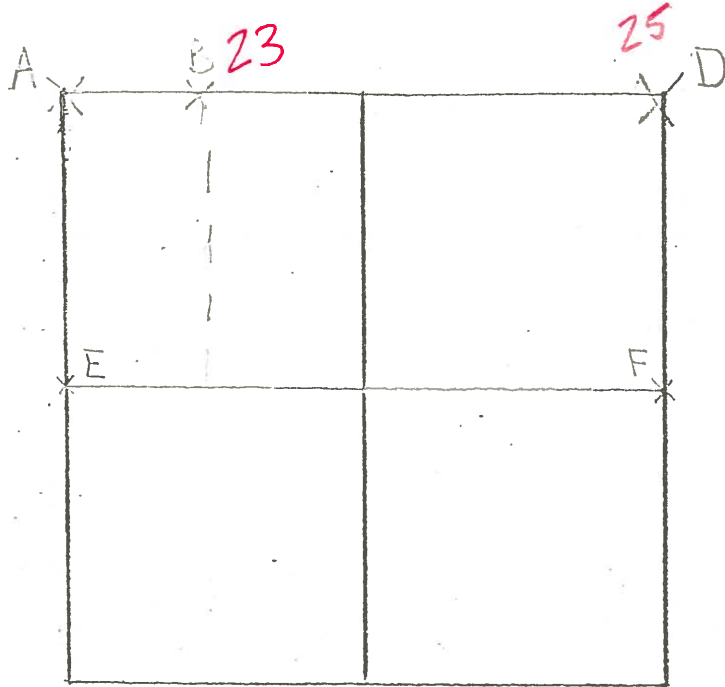

6-6-79 R.W. J.J.G.M.

B- FOUND R.R. SPIKE ON C
S.R. 281. SEARCHED FOR STONE
BUT COULD NOT LOCATE. RESET
R.R. SPIKE ON C S.R. 281

38.50' N. TO N.E.S. S/S B
61.47' E.S.E. TO "T" CONCRETE SPIKE
51.79' S.E. TO N.E.S. N/S D

6-6-79 R.W. G.M. J.J.

D- FOUND IRON PIN OVER STONE (10" X 10" X 9") 11" BELOW
SHOULDER SURFACE. REMOVED IRON PIN AND SET 3/4"
DIAMETER ALONG W/S OF STONE AND BENT TOP OF IRON
PIN DIRECTLY OVER TOP CENTER OF STONE. IRON PIN
6" BELOW SHOULDER SURFACE. P.K.'S SET 6' N.E. &
S.E.

37.39' N.W. TO N.E.S. E/S D


33.16' E.S.E. TO N.E.S. W/S I

27.80' S.S.W. TO "T" ON BASE CONCRETE BRIDGE WALL


56.16' S. TO RICHFIELD STONE

County Henry S.R. 281Date 5-18-1979Township MonroeWeather ClearSection S $\frac{1}{4}$ Cor. of SW $\frac{1}{4}$ Sec. 24Temp. 78°

T4N, R7E

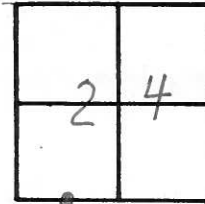Personnel SmithKnapeBowersMead

23
Fd. R.R. Spike
2" Below Surface &
on E of Pavt
589+35

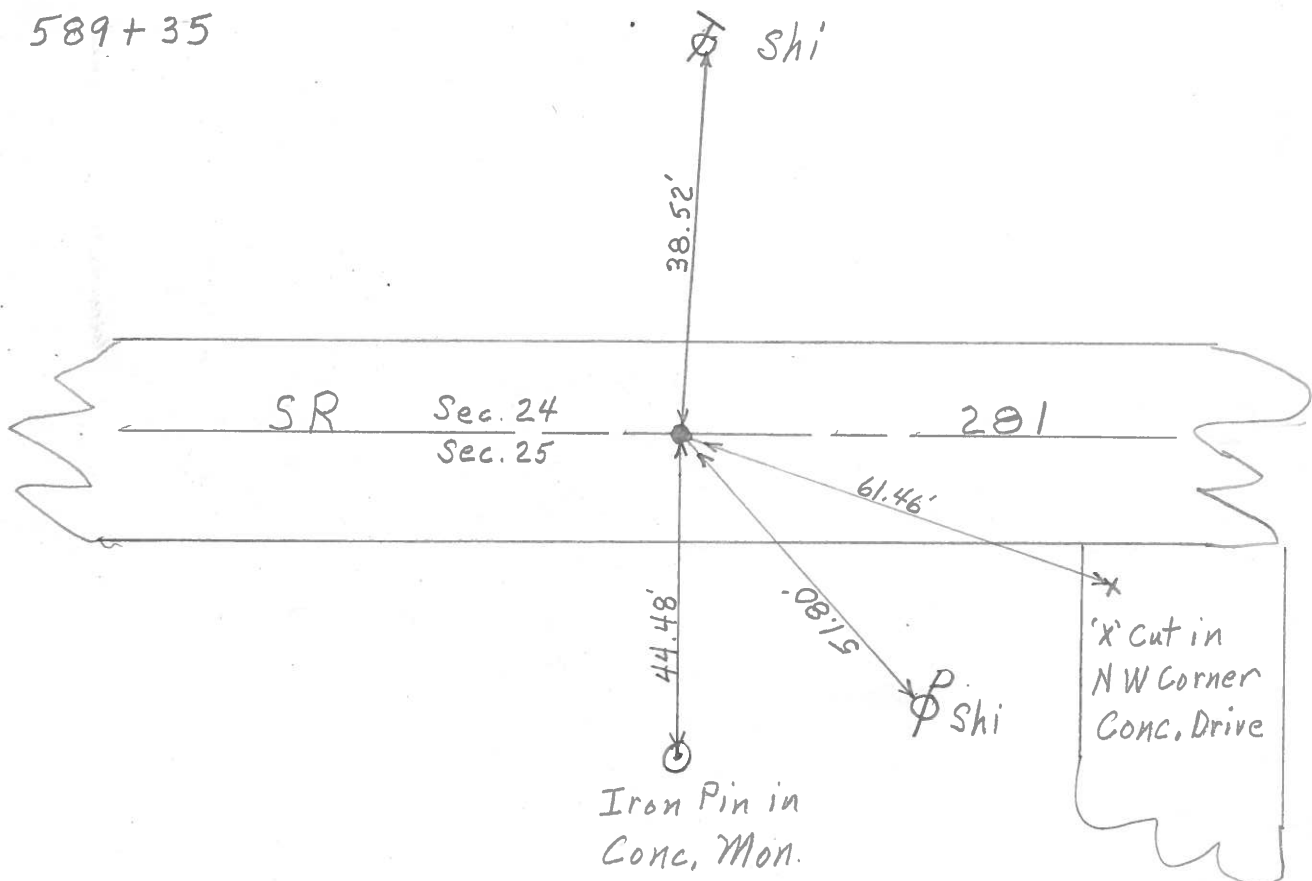

PERSONNEL	TITLE	PERSONNEL	TITLE
Stone			
E			
Crew			

COUNTY Henry DATE 19 April 77


S. R. 281 WEATHER Warm

SEC. Monroe Twp. TEMP. 73°

DESCRIPTION References to Control Points JOB NO. _____

LEFT CENTER LINE RIGHT

23

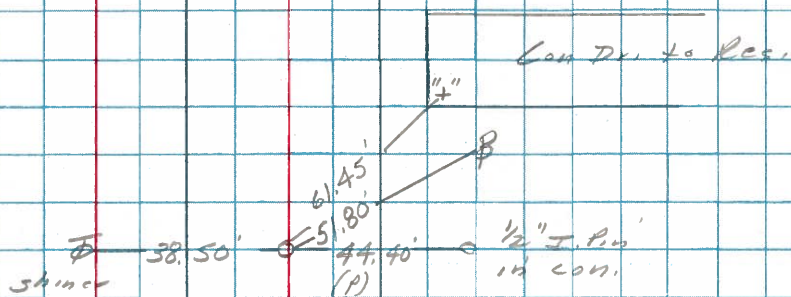

Ed. RR Spk 1" below surface

1/16 cor. 24-25

9.2' to S. edge put.

9.4' to N. edge put.


SR 281

E CO. RD.

No. 82

COUNTY HENRY S.R. 281
 TOWNSHIP MONROE
 SECTION 25

Sheet 1 of 3
 T 4 N . R 7 E

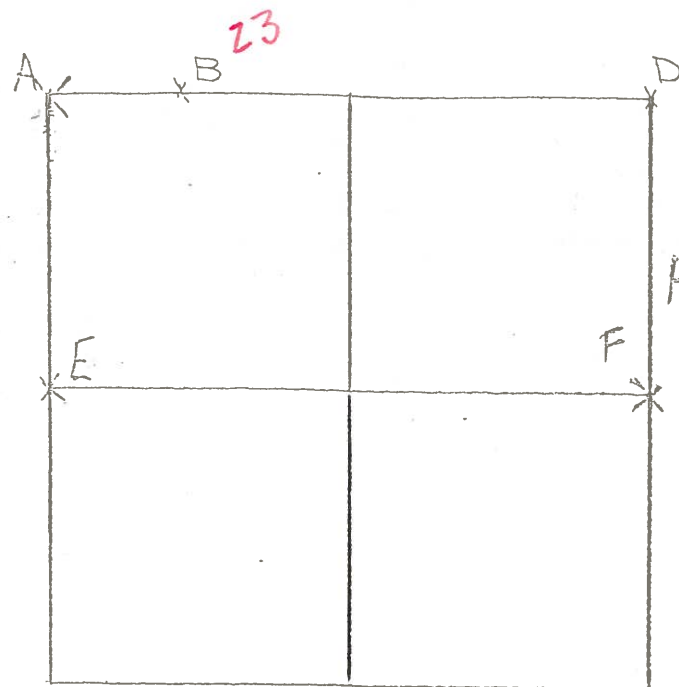

6-26-79 R.W. G.M.
 F- FOUND STONE (8"x10"x12")
 18" BELOW ROAD SURFACE. FOUND
 BROKEN CLAY TILE OVER STONE
 PLACED CENTER PUNCHED R.R.
 SPIKE ON SURFACE OVER
 HIGH POINT OF STONE. P.K.'s
 SET 6' N.E. & S.E.

STONE LOCATED 0.33' EAST OF WEST EDGE OF 18'
 PRESENT
 55.86' E.S.E. TO DUPLEX N/S
 74.18' S.S.E. TO "+" N.W. COR. CATCH BASIN (PLUMBED)
 69.46' S.S.W. TO "+" END 8" DIA. CONC. PIPE (PLUMBED)
 134.88' N.N.E. TO DUPLEX W/S
 43.12' S. TO W 1/4 POST RICHFIELD TWP.

6-5-79 R.W. J.J. G.M.
 A- FOUND SQUARE SPIKE (8" LONG) ON S.R. 281. FOUND
 STONE (8"x10"x14") 18" BELOW ROAD SURFACE. SPIKE LOCATED
 1.93' N. AND 0.20' E. OF STONE. FOUND SMALL STONE OVER
 TRUE STONE. REMOVED SMALL STONE AND PLACED CENTER
 PUNCHED R.R. SPIKE ON SURFACE OVER HIGH POINT OF STONE
 P.K.'s SET 6' S. AND E.

	R.R. SPIKE	SQUARE SPIKE (8"lg)
44.04' - N.W. TO DUPLEX E/S	-	42.49'
52.72' - S.S.E. TO DUPLEX W/S	-	54.24'
45.45' - S.S.W. TO DUPLEX E/S	-	