

O.D.O.T. DISTRICT 2 SURVEY OFFICE (USE ONLY)

PERSONNEL

REFERENCE NO. 26

SHEET 21 OF 34

NOTES PRESTON-COLVIN

DATE 11/26/24

ROUTE SR 281

H.C. NEISE

WEATHER WINDY

COUNTY HENRY

R.C. PRESTON-COLVIN

TEMP. 40°

TOWNSHIP RICHFIELD

SECTION 19

DWG BY PRESTON-COLVIN PID PAVING TRAIN

T 4 N R 8 E

TYPE MONUMENT PK NAIL

ON SURFACE - ~~BELOW~~ ON

OFFSET CL PAVEMENT 1.8' ~~LT~~ : RT

8.2' TO RT EDGE PAVEMENT 11.7' W CL CR 7 S

STATION: 628+82

HORIZ.DATUM: NAD83 2011


GEOID: 18

GRID: NORTHING: 592526.089


EASTING: 1556668.797

LDP: NORTHING: 449383.8

EASTING: 194509.4

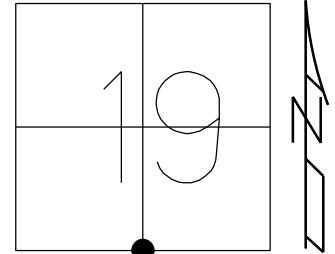

RECORD:
 SET SM.R.R.SPIKE
 9/2/87, CL
 FD SM.R.R.SPIKE
 ATOP R.R.SPIKE
 8/18/98, MC
 SET P.K./WASHER
 10/1/98, MRC
 FD P.K.NAIL
 REF26
 9/6/18, JFO
 7/25/19,
 1/11/23, JMR
 FD PK NAIL
 7/24/24, TDN
 PK PK WASHER
 11/26/24, TDN

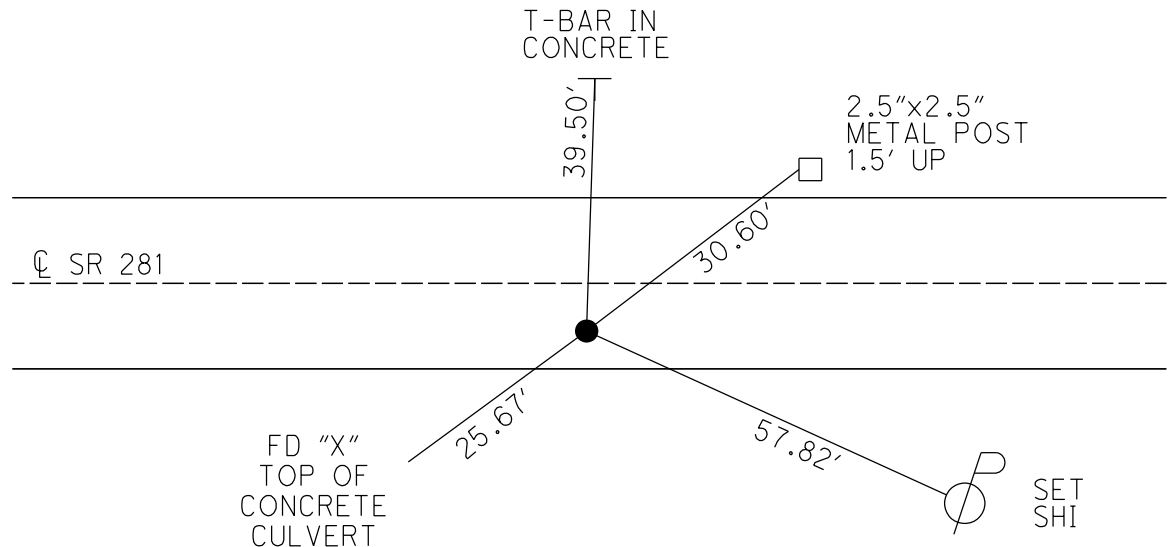

O.D.O.T. DISTRICT 2 SURVEY OFFICE (USE ONLY)

PERSONNEL

REFERENCE NO. 26

SHEET 21 OF 34

NOTES RHOADES

DATE 9/6/18

ROUTE SR 281

H.C. O'DONNELL

WEATHER CLOUDY

COUNTY HENRY

R.C. RHOADES

TEMP. 76°

TOWNSHIP RICHFIELD

SECTION 19

DWG BY NIESE PID PAVETRAIN

T 4 N R 8 E

TYPE MONUMENT P.K. NAIL

ON SURFACE - ~~BELOW~~ ON

OFFSET CL PAVEMENT 1.8' ~~LT~~ : RT

8.2' TO RT EDGE PAVEMENT


STATION: 654+65

HORIZ.DATUM: NAD83(2011)


GEOID: 2012A

GRID: NORTHING: 592500.566

EASTING: 1559252.112

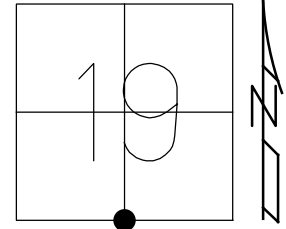

RECORD:
SET SM.R.R.SPIKE
9/2/87, CL
FD SM.R.R.SPIKE
ATOP R.R.SPIKE
8/18/98, MC
SET P.K./WASHER
10/1/98, MRC
FD P.K.NAIL
REF26
9/6/18, JFO
7/25/19,
1/11/23, JMR

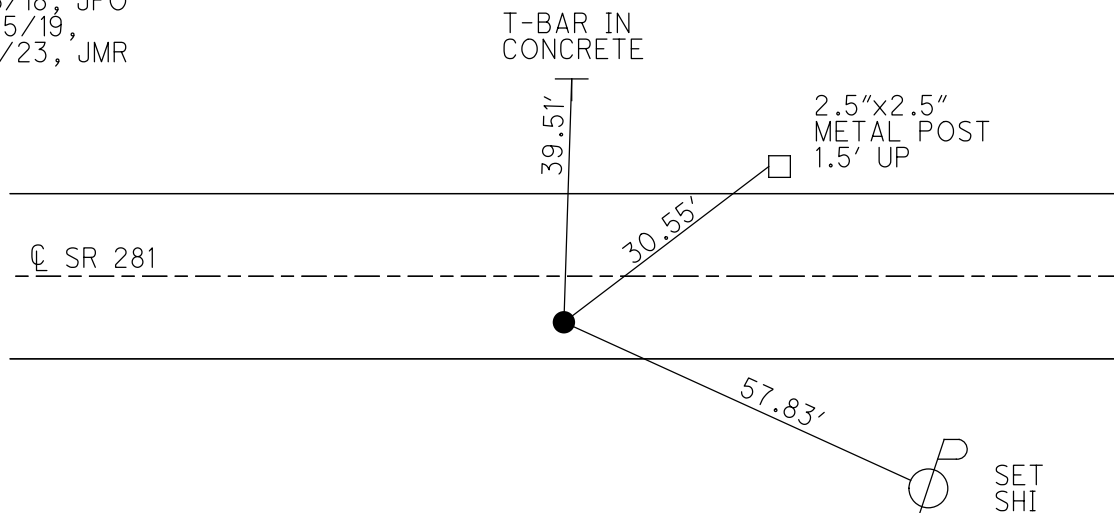

O.D.O.T. DISTRICT 2 SURVEY OFFICE (USE ONLY)

PERSONNEL

REFERENCE NO. 26

SHEET 21 OF 34

NOTES RHOADES

DATE 9/6/18

ROUTE SR 281

H.C. O'DONNELL

WEATHER CLOUDY

COUNTY HENRY

R.C. RHOADES

TEMP. 76°

TOWNSHIP RICHFIELD

SECTION 19

DWG BY NIESE

PID CHIP_2

T 4 N R 8 E

TYPE MONUMENT P.K. NAIL

ON SURFACE - ~~BELOW~~ ON

OFFSET Q PAVEMENT 1.8' ~~LT~~ : RT

8.2' TO RT EDGE PAVEMENT


STATION: 654+65

HORIZ.DATUM: NAD83(2011)


GEOID: 2012A

GRID: NORTHING: 592500.566

EASTING: 1559252.112

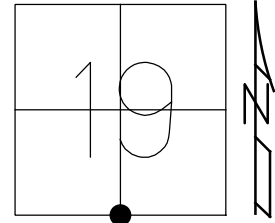

RECORD:
SET SM.R.R.SPIKE
9/2/87, CL
FD SM.R.R.SPIKE
ATOP R.R.SPIKE
8/18/98, MC
SET P.K./WASHER
10/1/98, MRC
FD P.K.NAIL
REF26
9/6/18, JFO
7/25/19, JMR

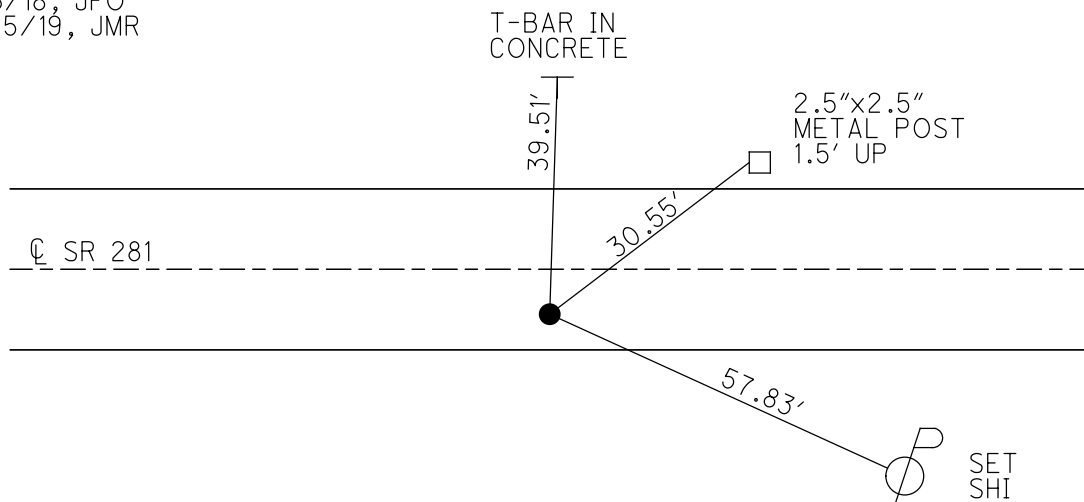

O.D.O.T. DISTRICT 2 SURVEY OFFICE

PERSONNEL

REFERENCE NO. 26

SHEET 22 OF 34

NOTES Canterbury

H.C. Rousas

R.C. Wittler

DATE 8-18-98

WEATHER Fair

TEMP. +84°

ROUTE SR 281

COUNTY Henry

TOWNSHIP Richfield

SECTION 19

T 4 N R 8 E


TYPE MONUMENT Sm RR spk ATOP RR spike

ON SURFACE - ~~BELOW~~ Surface

LEFT - CL PAV'T. - RIGHT 1.8' RT


8.2' TO RT EDGE PAVEMENT

S.L.M. 19+953.732 slm (sta 654+63 slm)

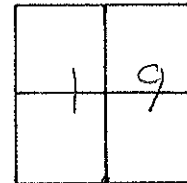

Reset PL & WASHET
10-1-98
DMLC

Sm RR SPK SET
9-2-89
CL

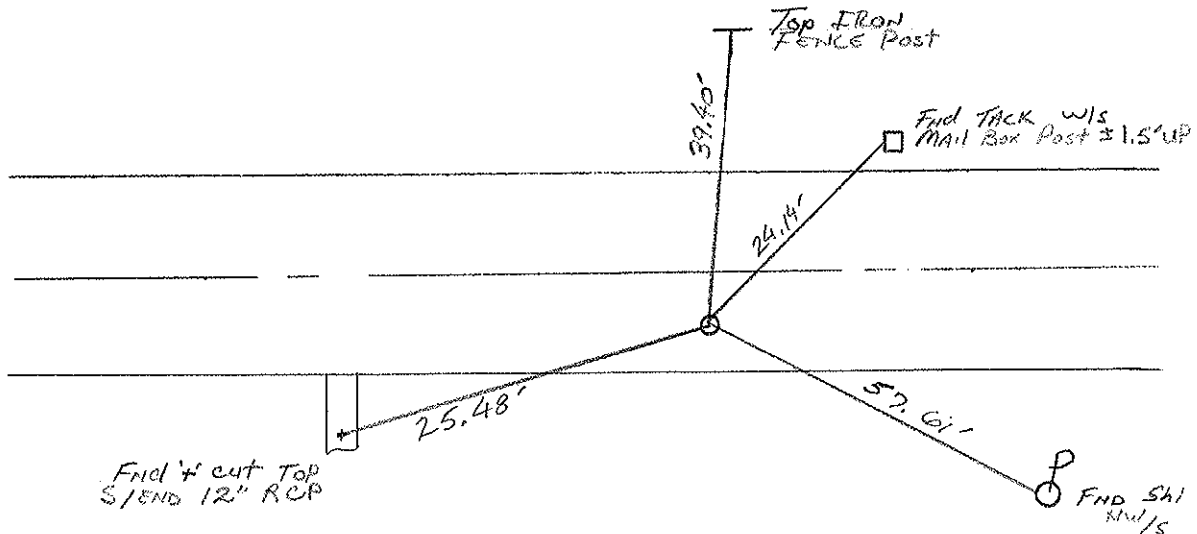

DRAWN BY TR

O.D.O.T. DISTRICT 2 SURVEY OFFICE

PERSONNEL

REFERENCE NO. 26

SHEET 22 OF

NOTES SACKMAN

H.C. BARNHISEL

R.C. LOHRKE

DATE 8-13-87

WEATHER HAZY FOG

TEMP. +75

ROUTE SR 281

COUNTY HENRY

TOWNSHIP RICHFIELD

SECTION 19

T4 N R 8 E


TYPE MONUMENT RR SPIKE

ON SURFACE - BELOW YES


LEFT-CL PAV'T. - RIGHT 2.3

7.2 TO RT EDGE PAVEMENT

S.L.M. 654+65

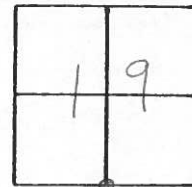

Set Sm. R.R. Spike
9-2-87
C.L.

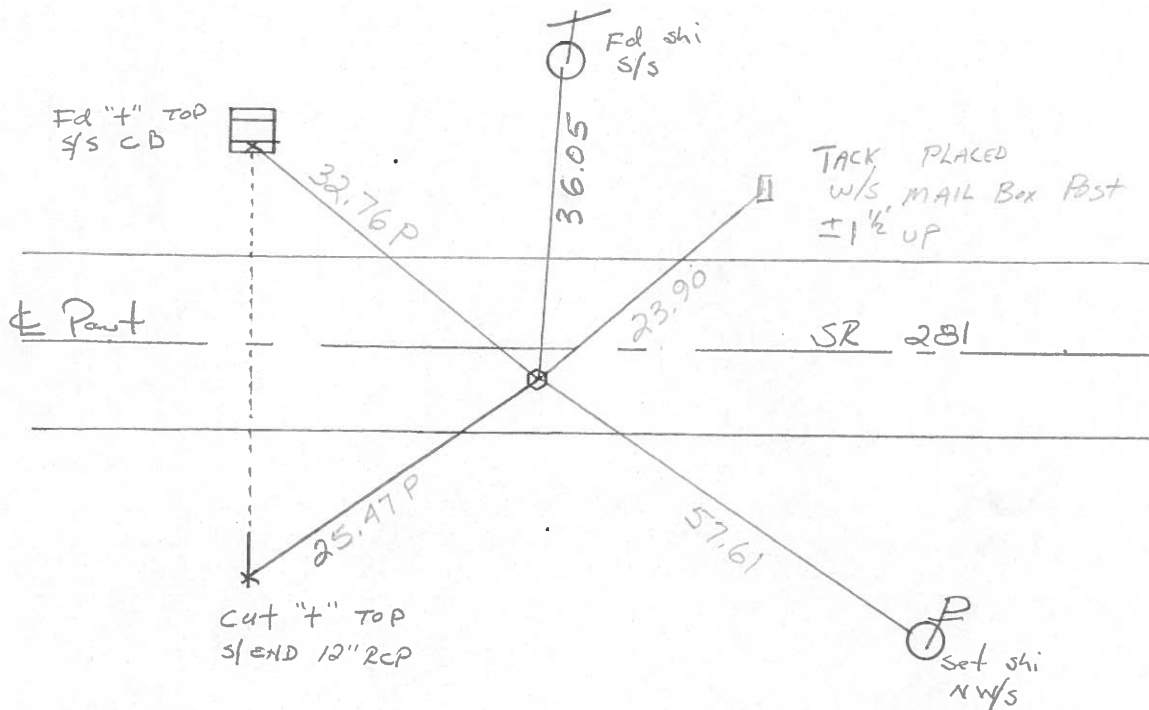


COUNTY HENRY

SHEET 2 OF 2
T-4-N , R-8-E


TOWNSHIP RICH FIELD

SECTION 30

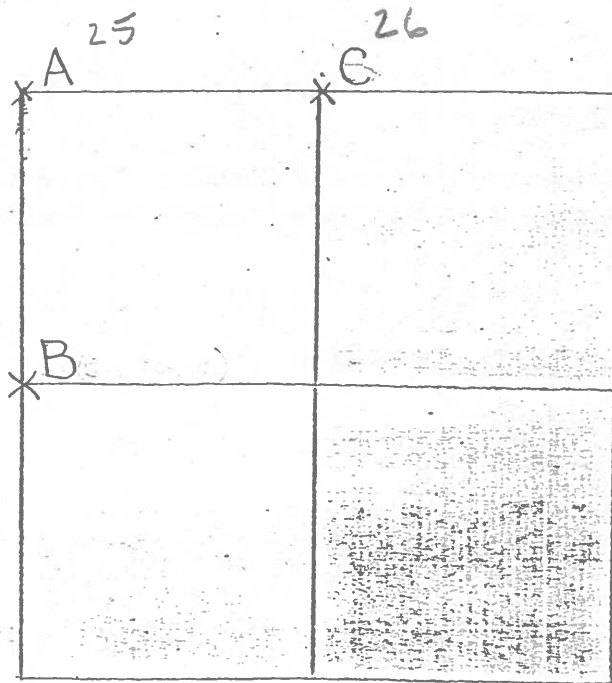

C - FOUND P.K. NAIL 0.70'
NORTH $\pm$ 4.70' EAST OF
TOP CENTER OF STONE. PLACED
CENTER PUNCHED RAILROAD
SPIKE ON SURFACE OVER
TOP CENTER OF STONE.
P.K.'S 6 N. & W. STONE IS
7.1' NORTH OF SOUTH EDGE PAYMENT.

STONE IS 8" x 8" x 11" AND 1/6" BELOW ROAD SURFACE.
32.74' N.N.W. TO "+" TOP CENTER SOUTH WALL CATCH BASIN (PLUMBED)
36.06' N.E. TO SHINER'S S.I.
57.60' S.E. TO SHINER'S NW 1/4 P
35.05' S.E. TO HOLE TOP CENTER 36" C.M.P.
26.62' S. TO "+" TOP CENTER 36" C.M.P.

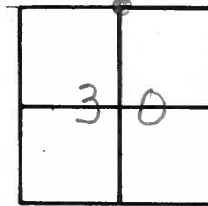County Henry S.R. 281Date 5-18-1979Township RichfieldWeather ClearSection N¹/₄ Cor. Sec. 30Temp. 78°T4N, R8EPersonnel SmithKnapeBowersMeadFd. Black Nail 26

@ Surface &

1.5' S. of E Part

654 + 76

