

O.D.O.T. DISTRICT 2 SURVEY OFFICE (USE ONLY)

PERSONNEL

REFERENCE NO. 28

SHEET 23 OF 34

NOTES PRESTON-COLVIN

H.C. NEISE

R.C. PRESTON-COLVIN

DATE 11/26/24

WEATHER WINDY

TEMP. 40°

ROUTE SR 281

COUNTY HENRY

TOWNSHIP RICHFIELD

SECTION 20

DWG BY PRESTON-COLVIN PID PAVING TRAIN

T 4 N R 8 E

TYPE MONUMENT SHANK/WASHER

ON SURFACE - ~~BELOW~~ ON

OFFSET 1.7' ~~LT~~ : RT

- TO - EDGE PAVEMENT

STATION: 681+06

HORIZ.DATUM: NAD83 2011


GEOID: 18

GRID: NORTHING: 592460.657

EASTING: 1564562.113


LDP: NORTHING: 449402.4

EASTING: 197150.9

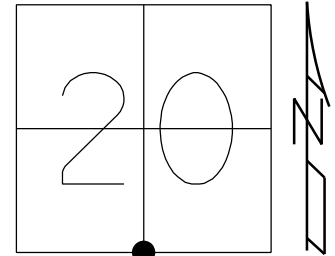

RECORD:
FD SM.R.R.SPIKE
ATOP P.K.NAIL
6/2/98, MC
SET P.K./WASHER
10/5/98, MRC
FD P.K./WASHER
REF20
9/6/18, JFO
7/25/19,
1/11/23, JMR
FD PK
REF28
7/24/24, TDN
FD SHANK/WASHER
11/26/24, TDN

CL SR 281

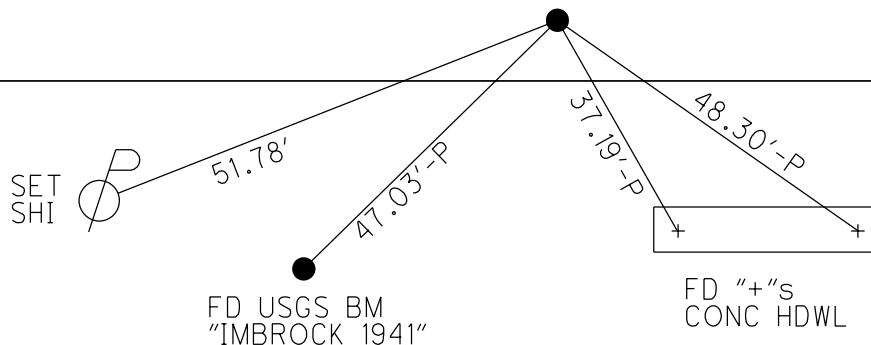

O.D.O.T. DISTRICT 2 SURVEY OFFICE (USE ONLY)

PERSONNEL

REFERENCE NO. 28

SHEET 23 OF 34

NOTES RHOADES

DATE 9/6/18

ROUTE SR 281

H.C. O'DONNELL

WEATHER CLOUDY

COUNTY HENRY

R.C. RHOADES

TEMP. 76°

TOWNSHIP RICHFIELD

SECTION 20

DWG BY NIESE

PID PAVETRAIN

T 4 N R 8 E

TYPE MONUMENT P.K./WASHER

ON SURFACE - ~~BELOW~~ ON

OFFSET CL PAVEMENT 1.7' ~~LT~~ : RT

8.7' TO RT EDGE PAVEMENT


STATION: 707+25

HORZ.DATUM: NAD83(2011)

GEOID: 2012A


GRID: NORTHING: 592460.657

EASTING: 1564562.113

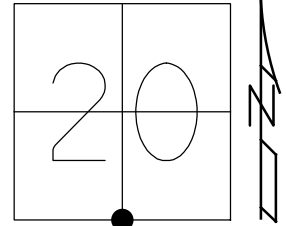

RECORD:
FD SM.R.R.SPIKE
ATOP P.K.NAIL
6/2/98, MC
SET P.K./WASHER
10/5/98, MRC
FD P.K./WASHER
REF20
9/6/18, JFO
7/25/19,
1/11/23, JMR

CL SR 281

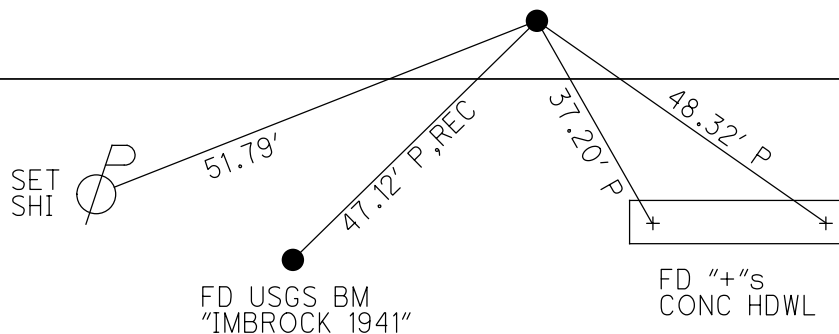

O.D.O.T. DISTRICT 2 SURVEY OFFICE (USE ONLY)

PERSONNEL

REFERENCE NO. 28

SHEET 23 OF 34

NOTES RHOADES

DATE 9/6/18

ROUTE SR 281

H.C. O'DONNELL

WEATHER CLOUDY

COUNTY HENRY

R.C. RHOADES

TEMP. 76°

TOWNSHIP RICHFIELD

DWG BY NIESE

PID CHIP_2

SECTION 20

T 4 N R 8 E

TYPE MONUMENT P.K./WASHER

ON SURFACE - ~~BELOW~~ ON

OFFSET Q PAVEMENT 1.7' ~~LT~~ : RT

8.7' TO RT EDGE PAVEMENT


STATION: 707+25

HORZ.DATUM: NAD83(2011)

GEOID: 2012A


GRID: NORTHING: 592460.657

EASTING: 1564562.113

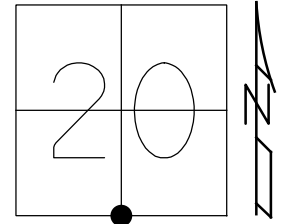

RECORD:
FD SM.R.R.SPIKE
ATOP P.K.NAIL
6/2/98, MC
SET P.K./WASHER
10/5/98, MRC
FD P.K./WASHER
REF20
9/6/18, JFO
7/25/19, JMR

Q SR 281

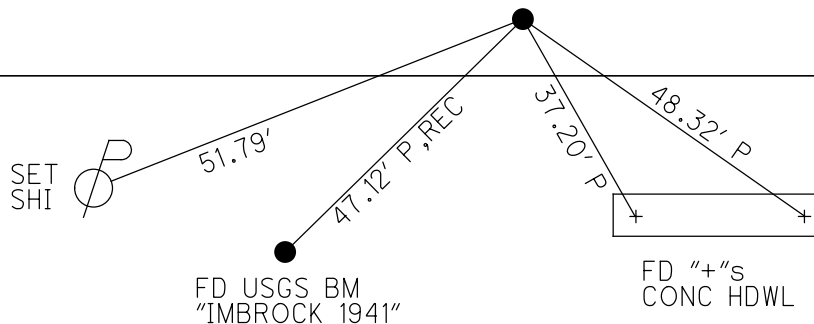

O.D.O.T. DISTRICT 2 SURVEY OFFICE

PERSONNEL

REFERENCE NO. 28

SHEET 24 OF 34

NOTES Canterbury

H.C. Rousos

R.C. Xupfer

DATE 6-2-98

WEATHER Sunny

TEMP. +70°F

ROUTE SR 281

COUNTY Henry

TOWNSHIP Richfield

SECTION 20

T. 4 N R. 8 E


TYPE MONUMENT SMRR Spk ATOP RR NAIL

ON SURFACE - ~~BELOW~~ Surface


LEFT - CL PAV'T. - RIGHT 1.7' RT

8.7' TO RT EDGE PAVEMENT

S.L.M. 21+570.80 SLK, 707+755 SLK

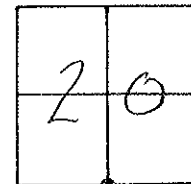

Reset Pk washed
10-5-98
MRC

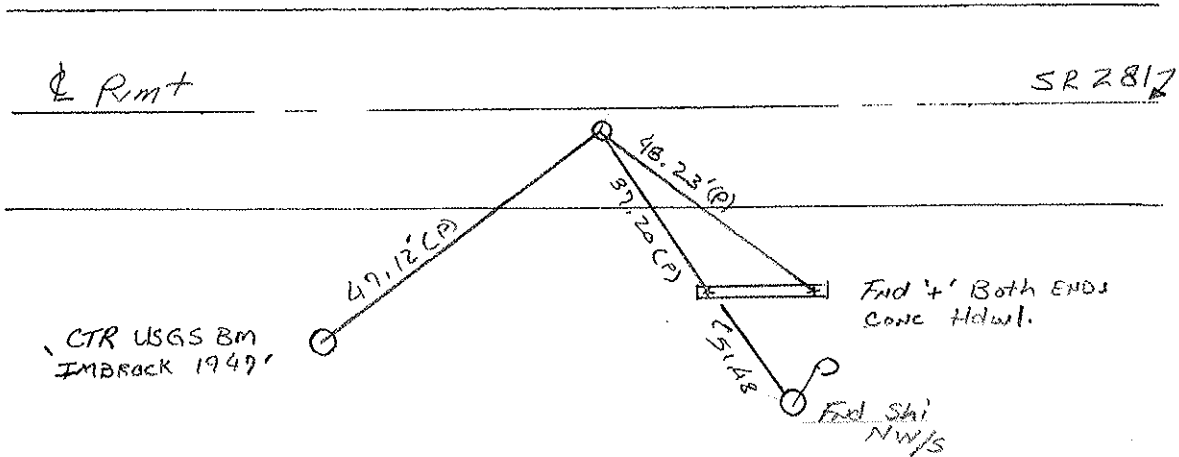

DRAWN BY TR

O.D.O.T. DISTRICT 2 SURVEY OFFICE

PERSONNEL

REFERENCE NO. 28

SHEET 24 OF

NOTES SOCKMAN

H.C. BARNHISEL

R.G. LOEHKE

DATE 8-13-87

WEATHER HAZY

TEMP. +75

ROUTE SR 281

COUNTY HENRY

TOWNSHIP RICHFIELD

SECTION 20

T4 N R 8 E

TYPE MONUMENT P.K. Nail


ON SURFACE - BELOW YES

~~LEFT~~ - PAV'T. - RIGHT 1.8'


7.9 TO 2⁺ EDGE PAVEMENT

S.L.M. 707 + 75

Reset Sm. RR. Spike

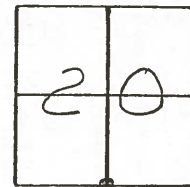

Set Sm. RR. Spike
9-2-87 C.L.

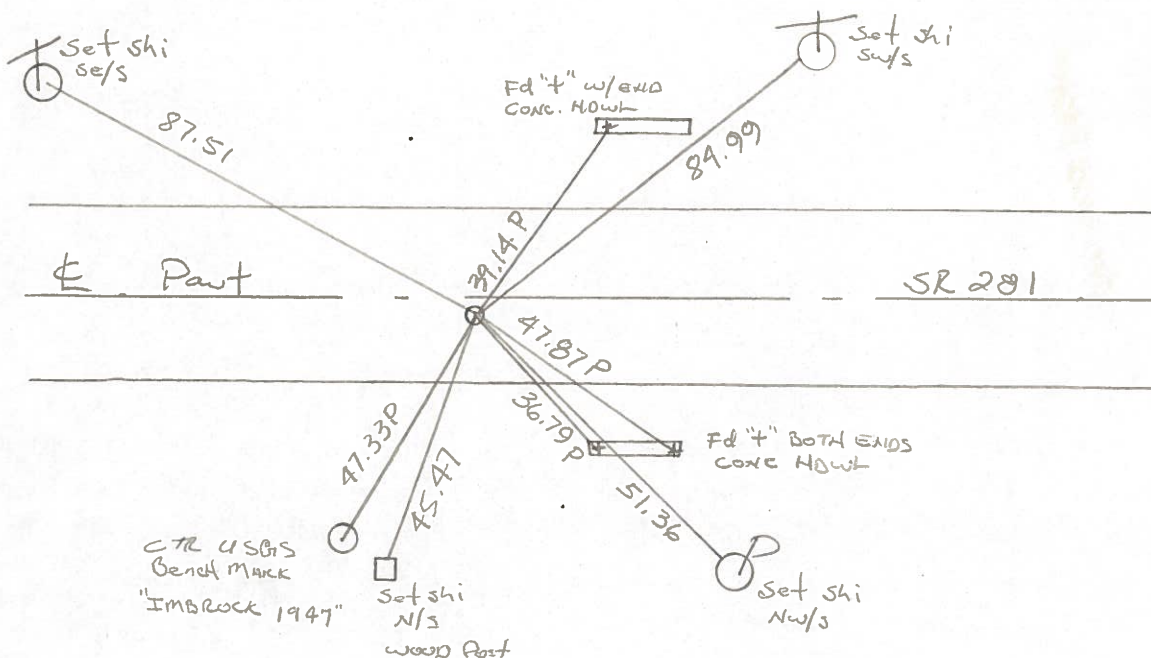

QD.O.T. DISTRICT 2 SURVEY OFFICE

Sht. 6 of

County HENRY S.R. 281

Date 5-22-79

Township RICHFIELD

Weather CLEAR

Section N 1/4 Post SEC. 29

Temp. 65°



T4N, R8E

Personnel BURNSIDE

SMITH

KNAPE

MEAD

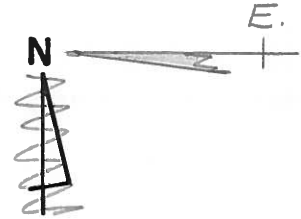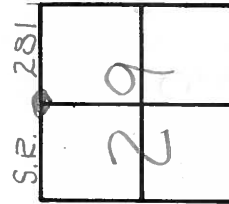

28

