

O.D.O.T. DISTRICT 2 SURVEY OFFICE (USE ONLY)

PERSONNEL

REFERENCE NO. 30

SHEET 25 OF 34

NOTES PRESTON-COLVIN

H.C. NEISE

R.C. PRESTON-COLVIN

DATE 11/26/24

WEATHER WINDY

TEMP. 40°

ROUTE SR 281

COUNTY HENRY

TOWNSHIP RICHFIELD

SECTION 21

DWG BY PRESTON-COLVIN

PID PAVING TRAIN

T 4 N R 8 E

TYPE MONUMENT SM RR SPIKE

~~ON SURFACE~~ - BELOW ON

OFFSET 6.1' TO RT PAVEMENT ET : RT

STATION: 761+02

HORIZ.DATUM: NAD83 2011


GEOID: 18

GRID: NORTHING: 592440.193


EASTING: 1567230.169

LDP: NORTHING: 449469.9

EASTING: 202487.9

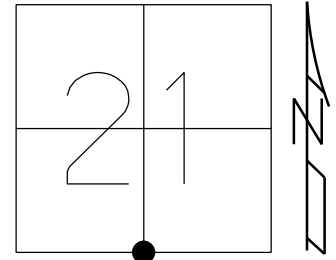

RECORD:
 SET SM.R.R.SPIKE
 9/2/87, CL
 FD SM.R.R.SPIKE
 6/2/98, MC
 SET P.K./WASHER
 10/5/98, MRC
 FD SM.R.R.SPIKE
 REF30
 9/7/18, JFO
 7/25/19,
 1/11/23, JMR
 FD SM RRS
 REF30
 7/24/24, JAM
 FD SM RRS
 11/26/24, TDN

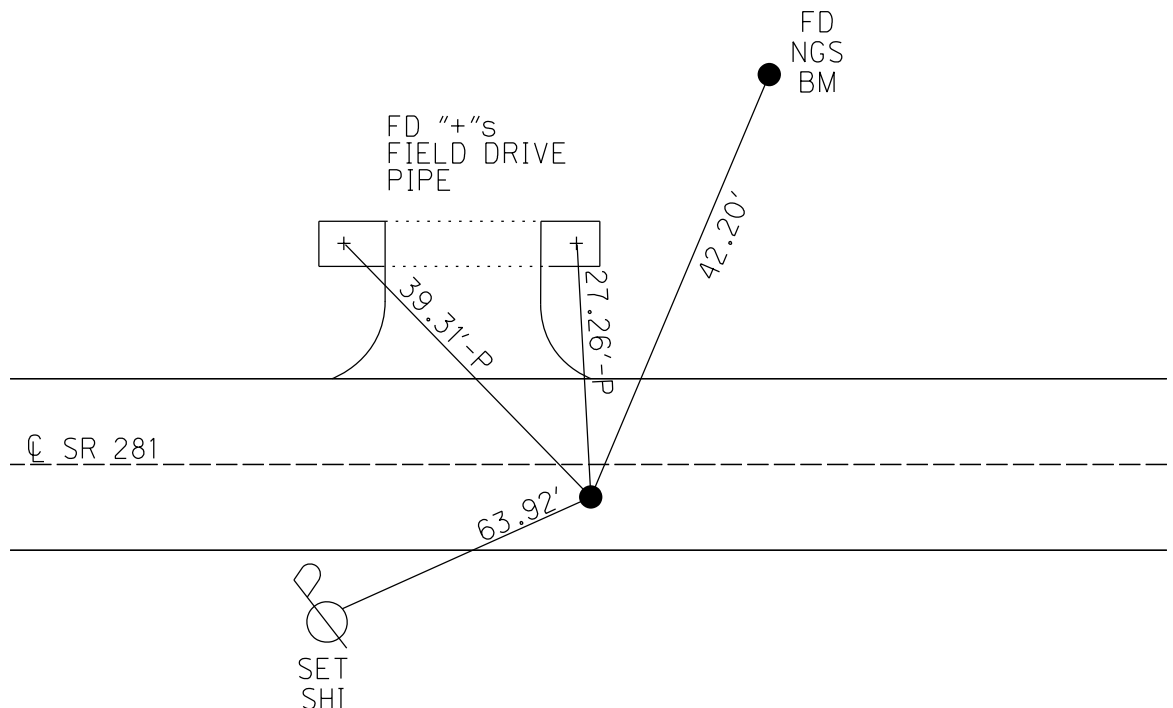

O.D.O.T. DISTRICT 2 SURVEY OFFICE (USE ONLY)

PERSONNEL

REFERENCE NO. 30

SHEET 25 OF 34

NOTES RHOADES

DATE 9/7/18

ROUTE SR 281

H.C. O'DONNELL

WEATHER CLOUDY

COUNTY HENRY

R.C. RHOADES

TEMP. 65°

TOWNSHIP RICHFIELD

SECTION 21

DWG BY NIESE

PID PAVETRAIN

T 4 N R 8 E

TYPE MONUMENT SM.R.R.SPIKE

ON SURFACE - ~~BELOW~~ ON

OFFSET CL PAVEMENT 4.0' ~~LT~~ : RT

6.1' TO RT EDGE PAVEMENT


STATION: 761+02

HORZ.DATUM: NAD83(2011)


GEOID: 2012A

GRID: NORTHING: 592437.724

EASTING: 1569889.622

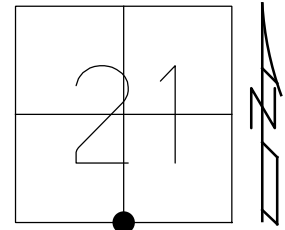

RECORD:
SET SM.R.R.SPIKE
9/2/87, CL
FD SM.R.R.SPIKE
6/2/98, MC
SET P.K./WASHER
10/5/98, MRC
FD SM.R.R.SPIKE
REF30
9/7/18, JFO
7/25/19,
1/11/23, JMR

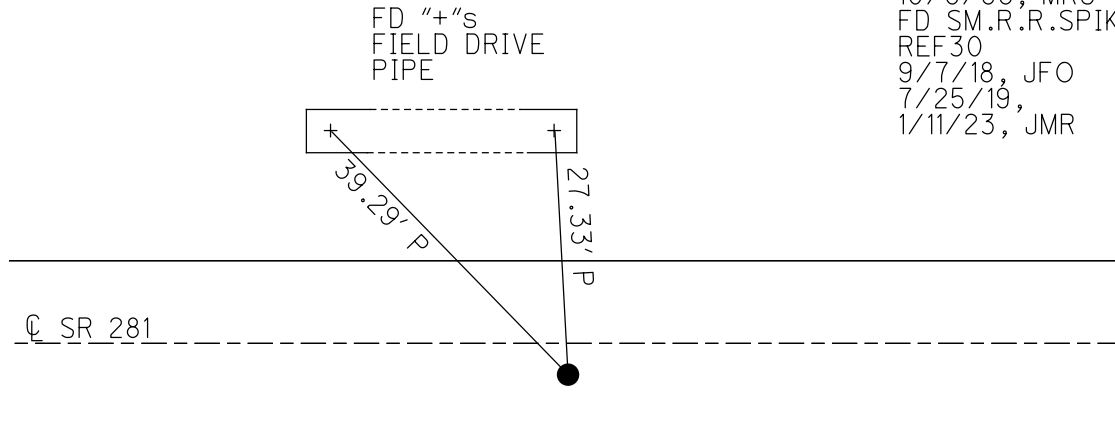

O.D.O.T. DISTRICT 2 SURVEY OFFICE (USE ONLY)

PERSONNEL

REFERENCE NO. 30

SHEET 25 OF 34

NOTES RHOADES

DATE 9/7/18

ROUTE SR 281

H.C. O'DONNELL

WEATHER CLOUDY

COUNTY HENRY

R.C. RHOADES

TEMP. 65°

TOWNSHIP RICHFIELD

SECTION 21

DWG BY NIESE PID CHIP_2

T 4 N R 8 E

TYPE MONUMENT SM.R.R.SPIKE

ON SURFACE - ~~BELOW~~ ON

OFFSET CL PAVEMENT 4.0' ~~LT~~ : RT

6.1' TO RT EDGE PAVEMENT


STATION: 761+02

HORZ.DATUM: NAD83(2011)


GEOID: 2012A

GRID: NORTHING: 592437.724

EASTING: 1569889.622

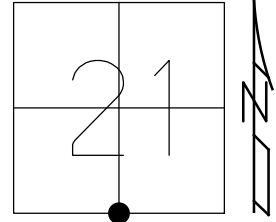

RECORD:
SET SM.R.R.SPIKE
9/2/87, CL
FD SM.R.R.SPIKE
6/2/98, MC
SET P.K./WASHER
10/5/98, MRC
FD SM.R.R.SPIKE
REF30
9/7/18, JFO
7/25/19, JMR

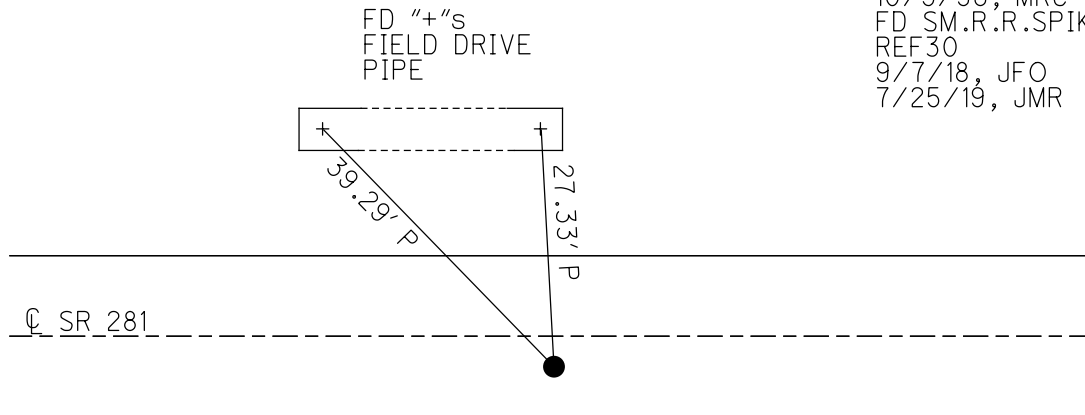

O.D.O.T. DISTRICT 2 SURVEY OFFICE

PERSONNEL

REFERENCE NO. 30

SHEET 26 OF 34

NOTES Canterbury

H.C. Roads

R.C. Nutley

DATE 6-2-98

WEATHER Sunny

TEMP. +70°F

ROUTE SR 281

COUNTY Henry

TOWNSHIP Richfield

SECTION 21

T 4 N R 8 E


TYPE MONUMENT 5m RR spike atop RR SPIKE

ON SURFACE - BELOW surface

LEFT-CL PAV'T. - RIGHT 4.0 RT


6.1 TO RT EDGE PAVEMENT

S.L.M. 23 + 191.923 SLK, 761 + 02 SEM

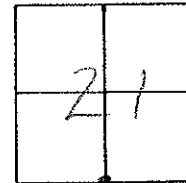

Reset PILEWASHER
10-5-98
HMR

5m. RR spike set
9-2-89
CL

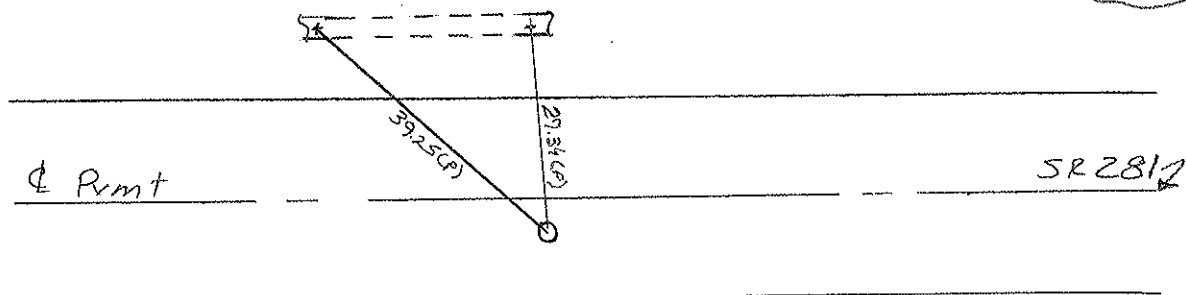

DRAWN BY TR

O.D.O.T. DISTRICT 2 SURVEY OFFICE

PERSONNEL

REFERENCE NO. 30

SHEET 26 OF

NOTES SACKMAN

H.C. BARNHISEL

R.C. LOGHRKE

DATE 8-13-87

WEATHER HAZY

TEMP. +77

ROUTE SR 281

COUNTY HENRY

TOWNSHIP RICHFIELD

SECTION 21

T4 NR 8 E


TYPE MONUMENT P.P. SPIKE

ON SURFACE - BELOW YES

~~LEFT~~ & PAW'T. - RIGHT 3.8

5.7 TO 2 EDGE PAVEMENT

S.L.M. 761 + 02

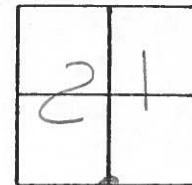

Set Sm. R.R. Spike
9-2-87
C.L.

Field Drive

Fd. USCGS BENCHMARK
BENTEN 1947

12" CONC PIPE
Fd "+" IS BOTH ENDS

---+---


39.22P

27.32P

42.18P

E. Pawt

SR 281

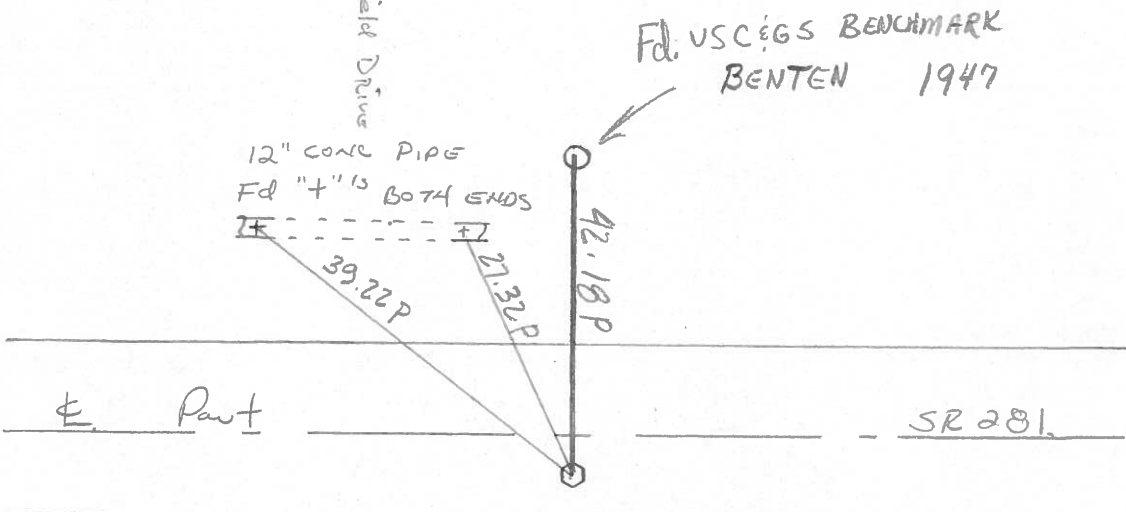


COUNTY HENRY

TOWNSHIP RICHFIELD

SECTION 28

SHEET 2 OF 2
T-4-N, R-8-E

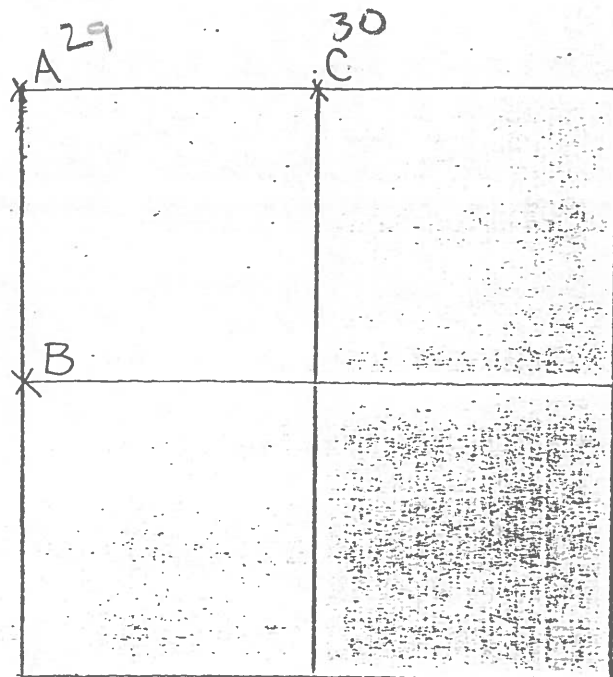

11-12-79 R.W. J.J. C.S.

C- FOUND RECORDED RAILROAD SPIKE

0.15' SOUTH OF 1x2' WOOD STAKE 24"

BELOW ROAD SURFACE. PLACED

CENTER PUNCHED RAILROAD SPIKE

ON SURFACE OVER 1x2' WOOD STAKE.

P.K.'S 6 N. & W.

RAILROAD SPIKE IS 5.6' NORTH

OF SOUTH EDGE 19' PAVEMENT.

67.81' W.N.W. TO SHINER SE/S I

39.15' N.W. TO "+" TOP 12" R.C.P. (PLUMBED)

42.14' N. TO CENTER U.S.C. & G. A. STA. BENEIN-1947 (PLUMBED)

27.28' N. TO "+" TOP 12" R.C.P. (PLUMBED)

76.44' N.E. TO SHINER SW/S I



44.96' S. TO SHINER N/S COR POST (LOOSE)

Q.D.O.T. DISTRICT 2 SURVEY OFFICE


Sht. 8 of

County HENRY S.R. 281
 Township RICHFIELD
 Section N 1/4 Post SEC. 28
T4N, R8E
 Personnel BURNSIDE
SMITH
KNAPE
MEAD

Date 5-22-79
 Weather CLEAR
 Temp. +65°

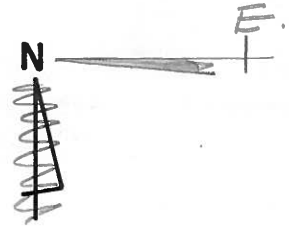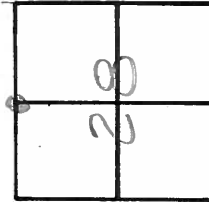

30

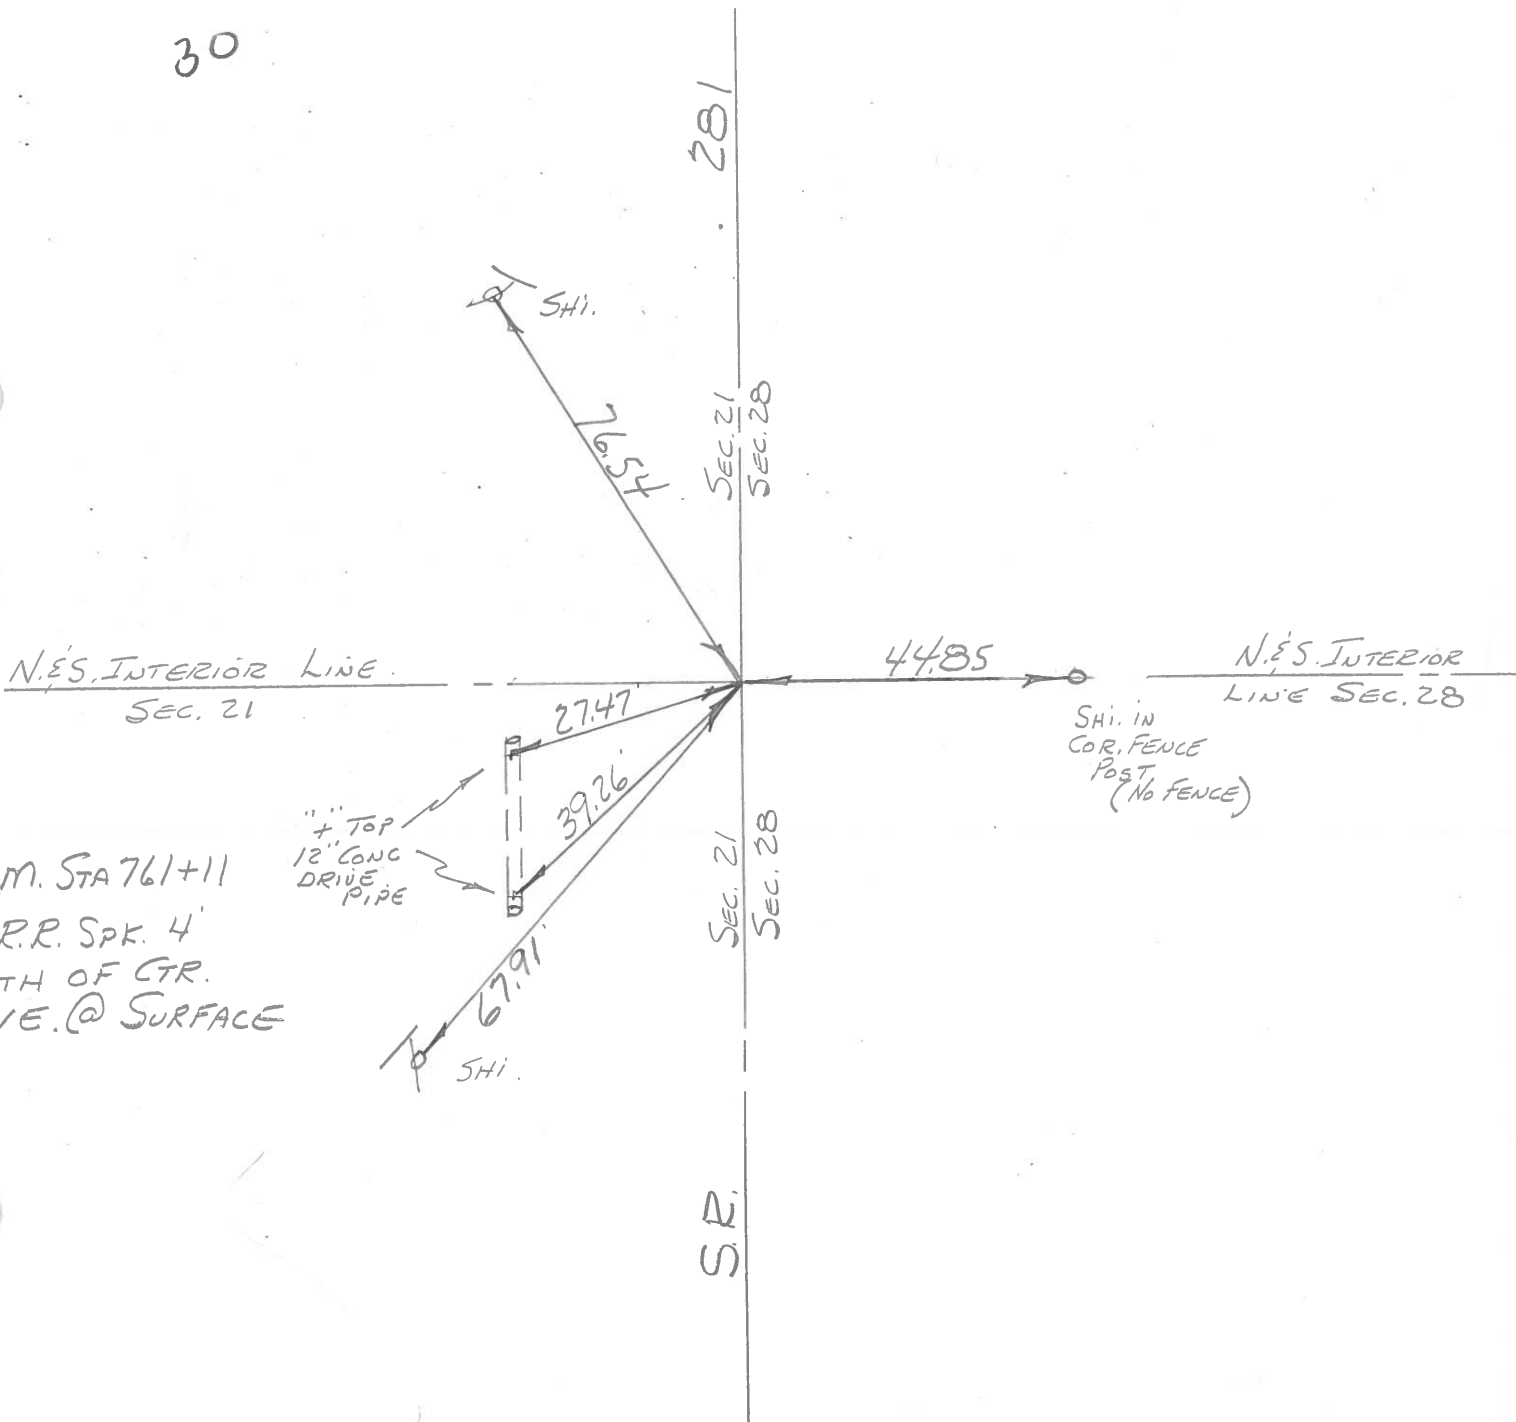

PERSONNEL	TITLE	PERSONNEL	TITLE	COUNTY	DATE	WEATHER	TEMP.
Tomsic				HENRY	Nov. 26, 1974		
Neuser				S. R. 281			
Granata				SEC. RICHFIELD TWP.			

DESCRIPTION	LEFT	CENTER LINE	RIGHT	JOB NO.
-------------	------	-------------	-------	---------

