

O.D.O.T. DISTRICT 2 SURVEY OFFICE (USE ONLY)

PERSONNEL

REFERENCE NO. 36B

SHEET 33 OF 34

NOTES PRESTON-COLVIN

DATE 11/26/24

ROUTE SR 281

H.C. NEISE

WEATHER WINDY

COUNTY HENRY

R.C. PRESTON-COLVIN

TEMP. 40°

TOWNSHIP RICHFIELD

SECTION 25

DWG BY PRESTON-COLVIN

PID PAVING TRAIN

T 4 N R 8 E

TYPE MONUMENT MONBOX

~~ON SURFACE~~ - BELOW ON

OFFSET $\varnothing$ PAVEMENT 9.5' ~~LT~~ : RT

0.9' TO RT EDGE PAVEMENT

STATION: 938+83.72

HORIZ.DATUM: NAD83 2011


GEOID: 18

GRID: NORTHING: 592316.625


EASTING: 1587651.079

LDP: NORTHING: 449717.7

EASTING: 222629.4

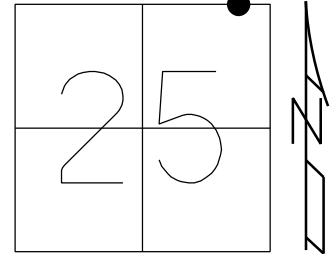

RECORD:
FD MONBOX
COVERED W/ASPHALT
SHOT CTR LID
REFB36
9/7/18, JFO
7/25/19, JMR
FD MON BOX
REF36B
7/25/24, JAM

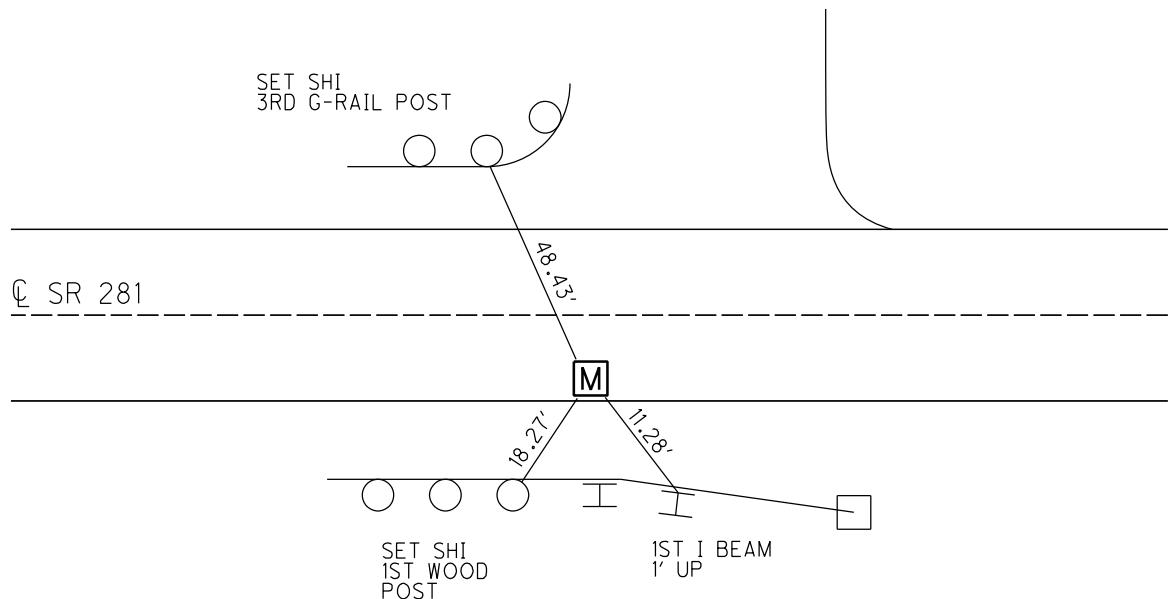

O.D.O.T. DISTRICT 2 SURVEY OFFICE (USE ONLY)

PERSONNEL

REFERENCE NO. 36 B

SHEET 33 OF 34

NOTES CANTERBURY

DATE 6/2/98

ROUTE SR 281

H.C. ROUSOS

WEATHER WINDY

COUNTY HENRY

R.C. NUHFER

TEMP. 75°

TOWNSHIP RICHFIELD

SECTION 25

DWG BY NIESE PID CHIP_2

T 4 N R 8 E

TYPE MONUMENT MONBOX

ON SURFACE - ~~BELOW~~ ON

OFFSET Q PAVEMENT 9.5' ~~LT~~ : RT

0.9' TO RT EDGE PAVEMENT


STATION: 938+83.72

HORIZ.DATUM: NAD83(2011)

GEOID: 2012A

GRID: NORTHING: 592316.625

EASTING: 1587651.079

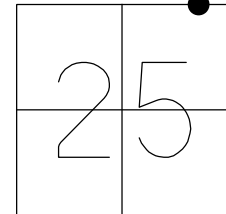

RECORD:
FD MONBOX
COVERED W/ASPHALT
SHOT CTR LID
REFB36
9/7/18, JFO
7/25/19, JMR

