

O.D.O.T. DISTRICT 2 SURVEY OFFICE (USE ONLY)

PERSONNEL

REFERENCE NO. 37

SHEET 34 OF 34

NOTES PRESTON-COLVIN

DATE 11/26/24

ROUTE SR 281

H.C. NEISE

WEATHER WINDY

COUNTY HENRY

R.C. PRESTON-COLVIN

TEMP. 40°

TOWNSHIP RICHFIELD

SECTION 25

DWG BY PRESTON-COLVIN PID PAVING TRAIN

T 4 N R 8 E

TYPE MONUMENT MAG/WASHER

~~ON SURFACE~~ - BELOW ON

OFFSET $\odot$ PAVEMENT - ~~LT~~ : RT

- TO - EDGE PAVEMENT

STATION: 947+59

HORZ.DATUM: NAD83 2011


GEOID: 18

GRID: NORTHING: 592316.625


EASTING: 1587651.079

LDP: NORTHING: 449717.7

EASTING: 222629.4

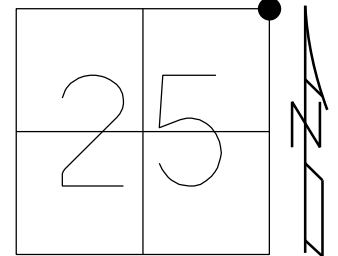

RECORD:
FD R.R.SPIKE
1/8/75, TOMSIC
FD SM.R.R.SPIKE
5/22/90, CL
7/2/12, DCH
SET MAG/WASHER
NEWREF1
9/24/12, DCH
FD MAG/WASHER
REF37
9/7/18, JFO
FD MAG/WASHER
REF37
7/25/24, JAM
FD MAG/WASHER
11/26/24, TDN

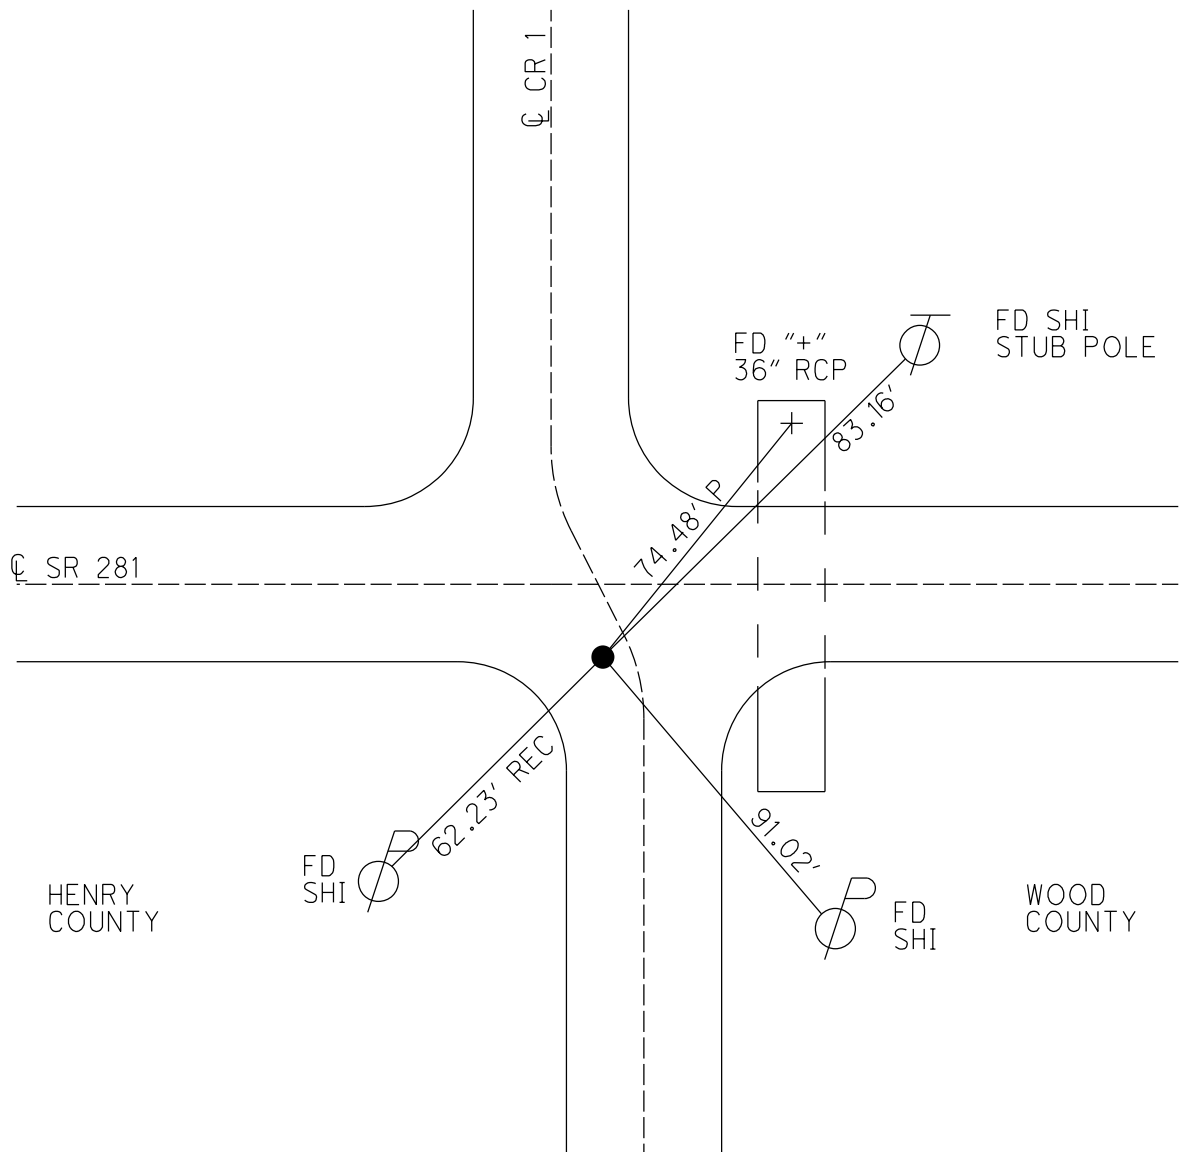

O.D.O.T. DISTRICT 2 SURVEY OFFICE (USE ONLY)

PERSONNEL

REFERENCE NO. 37

SHEET 34 OF 34

NOTES RHOADES

DATE 9/7/18

ROUTE SR 281

H.C. O'DONNELL

WEATHER CLOUDY

COUNTY HENRY

R.C. RHOADES

TEMP. 69°

TOWNSHIP RICHFIELD

SECTION 25

DWG BY NIESE PID CHIP_2

T 4 N R 8 E

TYPE MONUMENT MAG/WASHER

ON SURFACE - BELOW ON

OFFSET Q PAVEMENT - LT : RT

- TO - EDGE PAVEMENT


STATION: 947+59

HORIZ.DATUM: NAD83(2011)


GEOID: 2012A

GRID: NORTHING: 592312.219

EASTING: 1588509.764

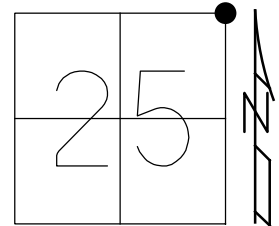

RECORD:
FD R.R.SPIKE
1/8/75, TOMSIC
FD SM.R.R.SPIKE
5/22/90, CL
7/2/12, DCH
SET MAG/WASHER
NEWREF1
9/24/12, DCH
FD MAG/WASHER
REF37
9/7/18, JFO

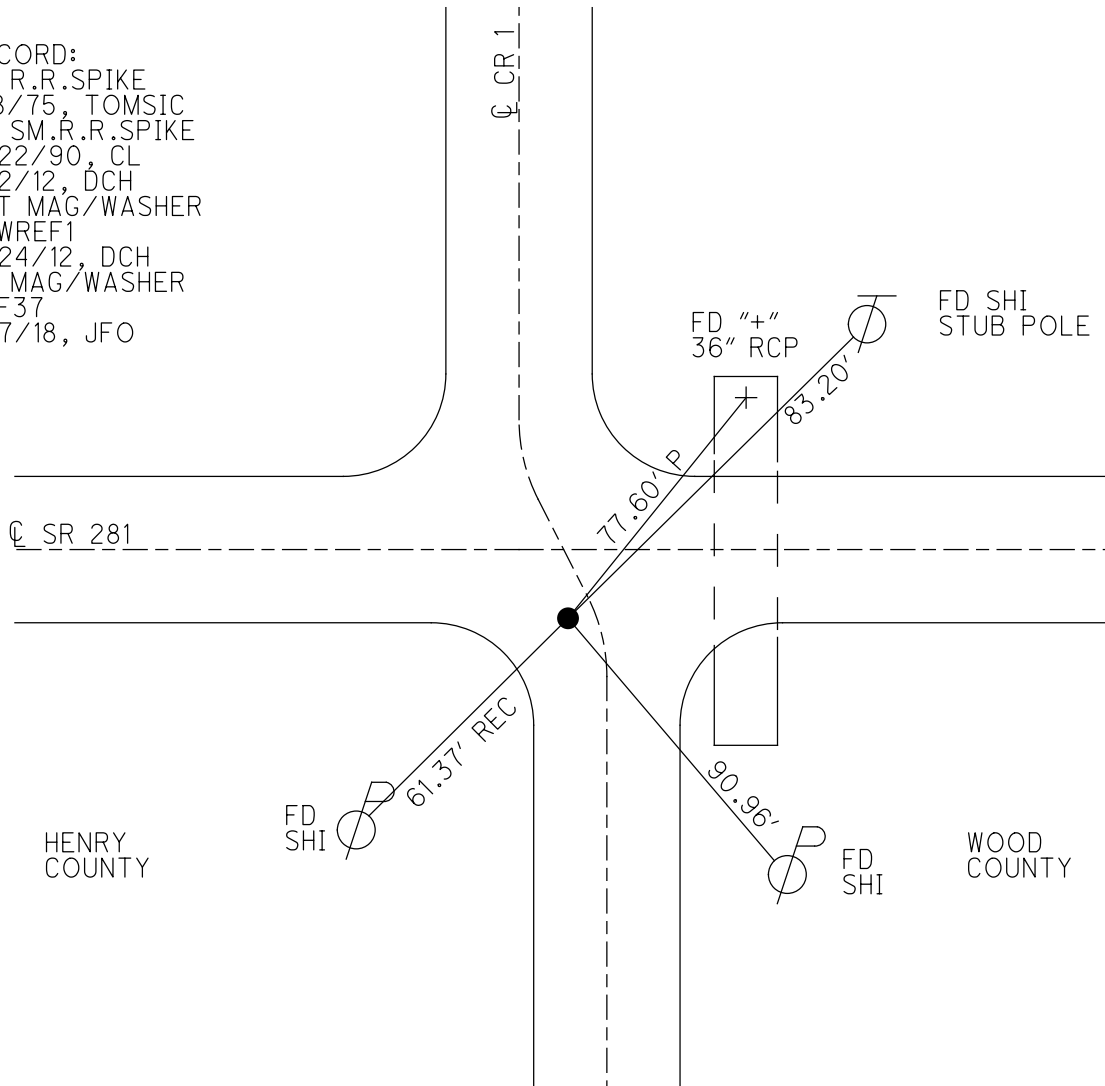

PERSONNEL	TITLE	PERSONNEL	TITLE
Tomsic			
Neuser			
Granata			

COUNTY HENRY DATE JAN. 8, 1975

S. R. 281 WEATHER _____

SEC. RICHFIELD TWP. TEMP. _____

DESCRIPTION _____ LEFT _____ CENTER LINE _____ RIGHT _____ JOB NO. _____

