

O.D.O.T. DISTRICT 2 SURVEY OFFICE (USE ONLY)

PERSONNEL

REFERENCE NO. 28

SHEET 7 OF 13

NOTES MILLER
H.C. NIESE
R.C.

DATE 2/24/23
WEATHER SUNNY
TEMP. 78°

ROUTE SR 2
COUNTY LUCAS
TOWNSHIP AMBOY
SECTION 11

DWG BY BARRIERE PID 108465

T 2 N R E

TYPE MONUMENT P.K./WASHER

ON SURFACE - BELOW ON

OFFSET Q PAVEMENT ON LT : RT

15.2' TO RT EDGE PAVEMENT

STATION:

HORIZ.DATUM:


GEOID:

GRID: NORTHING:


EASTING:

LDP: NORTHING:

EASTING:

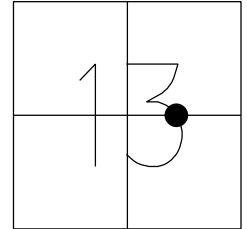

RECORD:
FD P.K./WASHER
7/16/93, MRC
SET P.K./WASHER
8/11/93, MB
DID NOT FIND
2/24/23, TDN

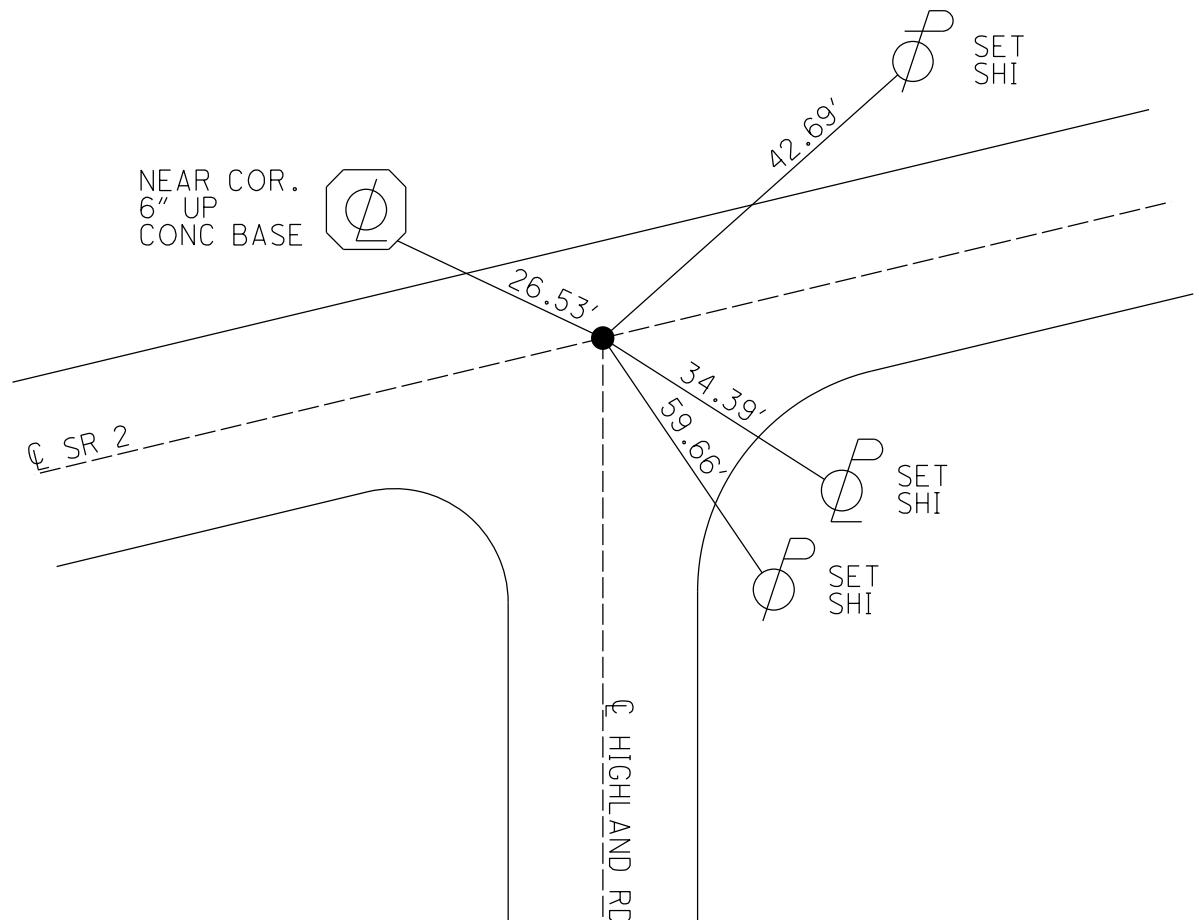

O.D.O.T. DISTRICT 2 SURVEY OFFICE (USE ONLY)

PERSONNEL

REFERENCE NO. 28

SHEET 7 OF 13

NOTES CORDES

DATE 7/16/93

ROUTE SR 2

H.C. KUSZ

WEATHER PARTLY CLOUDY

COUNTY LUCAS

R.C. OTTO

TEMP. 78°

TOWNSHIP ADAMS

BARNHISEL

SECTION 13

DWG BY NIESE PID _____

T 2 US R E

TYPE MONUMENT P.K./WASHER

ON SURFACE - ~~BELOW~~ ON


OFFSET Q PAVEMENT ON LT : RT

15.2' TO RT EDGE PAVEMENT


STATION: 709+34

HORIZ.DATUM: _____ GEOID: _____

GRID: NORTHING: _____ EASTING: _____

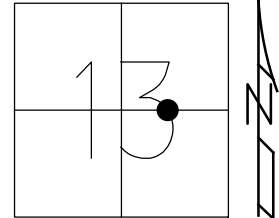

RECORD:
FD P.K./WASHER
7/16/93, MRC
SET P.K./WASHER
8/11/93, MB

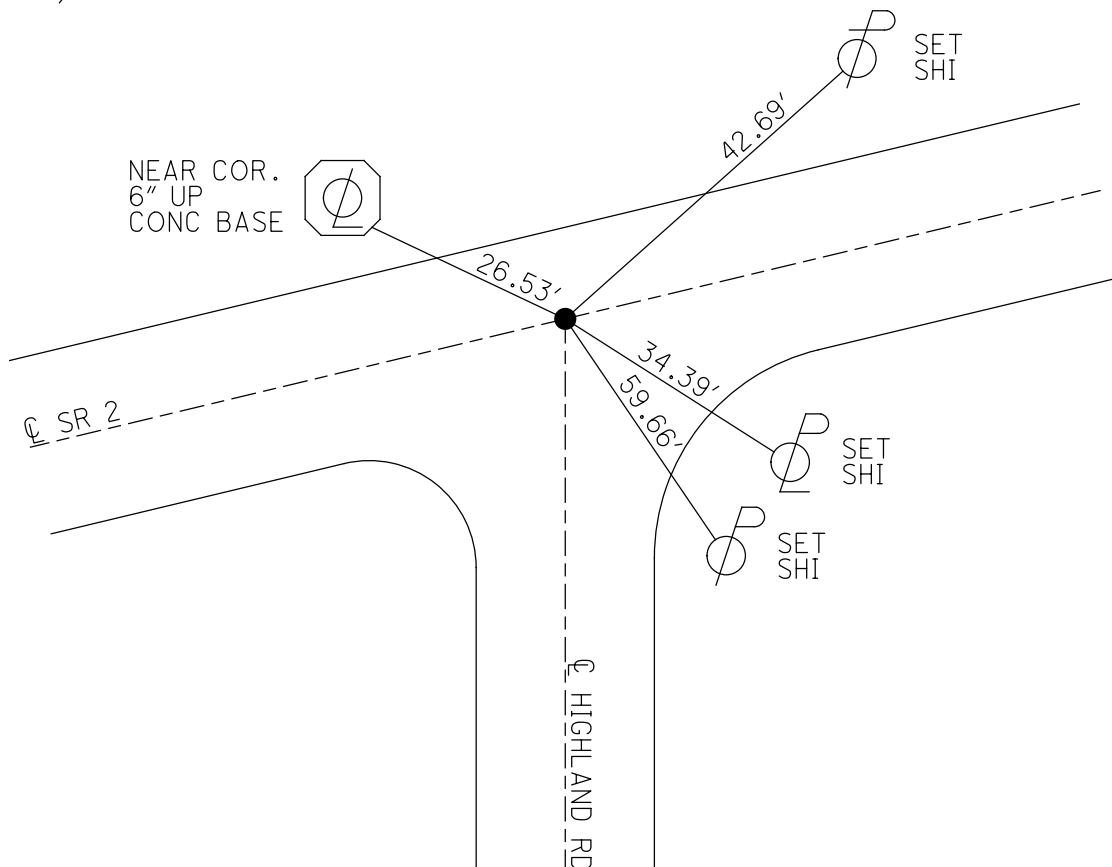

O.D.O.T. DISTRICT 2 SURVEY OFFICE

PERSONNEL

REFERENCE NO. 28

SHEET 7 OF 7

NOTES Cordes

H.C. Kusz

R.C. OTTO

BARNHISEL

DATE 7-16-93

WEATHER Pt Cloudy

TEMP. 170

ROUTE S.R. 2

COUNTY Lincoln

TOWNSHIP ADAMS

SECTION 13

T245.R

TYPE MONUMENT PK Nail & Washer

ON SURFACE - BELOW Yes


~~LEFT - C~~ PAW'T. - ~~RIGHT~~ center

15.2 TO RT EDGE PAVEMENT

S.L.M. 709 + 34


Reset

8-11-93

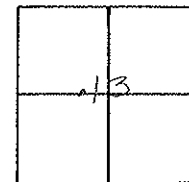

CAR
WASH

Neat corner
6" up
conc.
Base

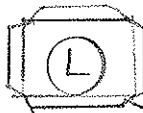

26.53

42.69

Set
sh.

PAW'T

S.R. 2

34.39

59.66

Set
sh.

Set
sh.

Highway Rd

PERSONNEL

TITLE

PERSONNEL

TITLE

BIAY

COUNTY LUCASDATE 5/19/61

CREW

S. R. #2WEATHER clearSEC. Reynolds Rd. To T.T.R.R.TEMP 75°DESCRIPTION Ref To Mon.

LEFT

CENTER LINE

RIGHT

JOB NO. _____

BLAY 10/3/61

#7

