

O.D.O.T. DISTRICT 2 SURVEY OFFICE (USE ONLY)

PERSONNEL

REFERENCE NO. 28 B

SHEET 8 OF 13

NOTES MILLER

DATE 2/24/23

ROUTE SR 2

H.C. NIESE

WEATHER SUNNY

COUNTY LUCAS

R.C.

TEMP. 78°

TOWNSHIP AMBOY

SECTION 13

DWG BY BARRIERE

PID 108465

T 2 N R E

TYPE MONUMENT "+" IN BRICK

ON SURFACE - BELOW ON

OFFSET Q PAVEMENT ON LT : RT

TO EDGE PAVEMENT

STATION: 723+98.58

HORZ.DATUM:


GEOID:

GRID: NORTHING:


EASTING:

LDP: NORTHING:

EASTING:

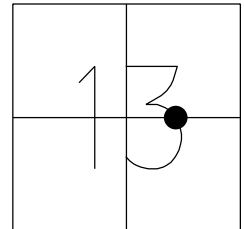

RECORD:
FD "+" IN BRICK
9/8/60
DID NOT FIND
2/23/24, TDN

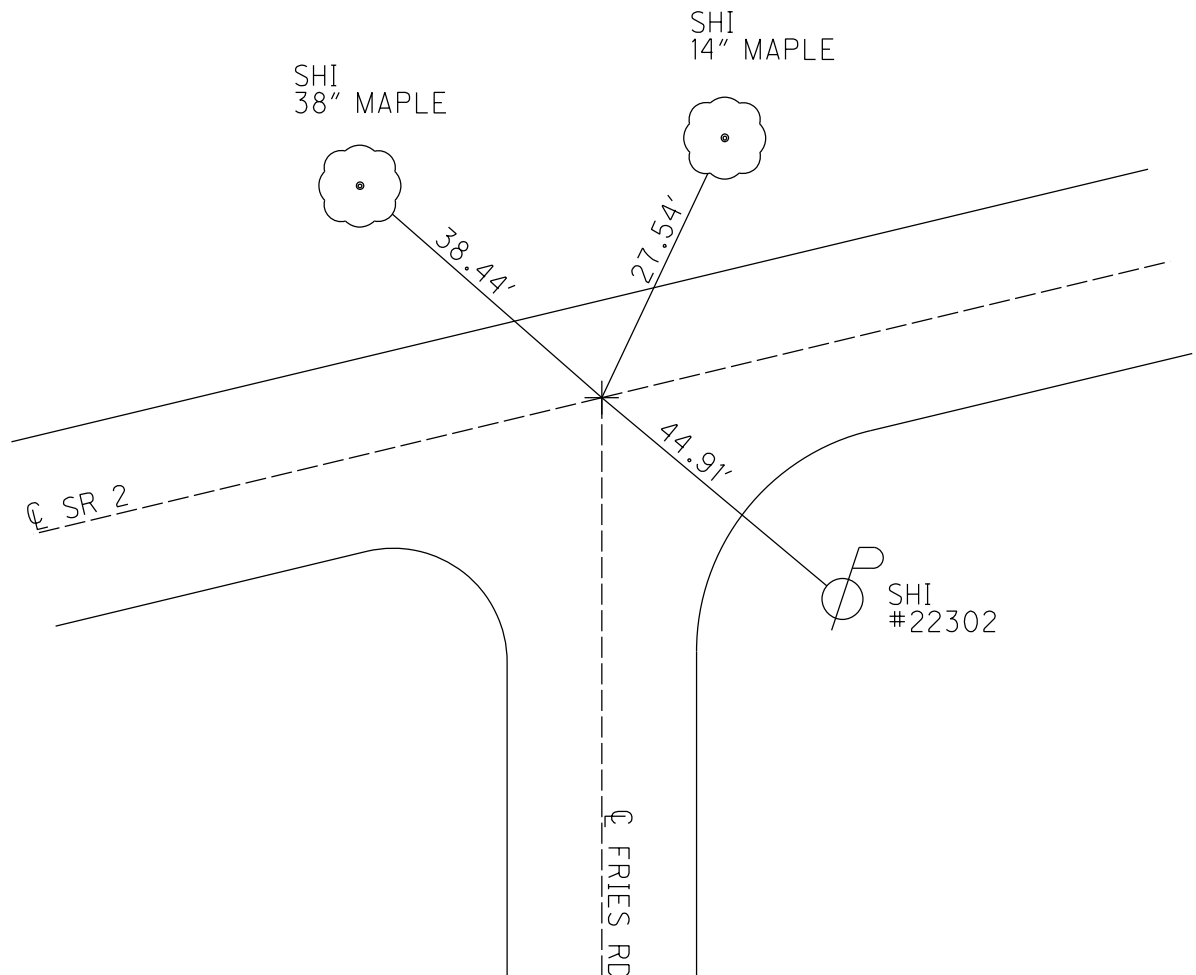

O.D.O.T. DISTRICT 2 SURVEY OFFICE (USE ONLY)

PERSONNEL

REFERENCE NO. 28 B

SHEET 9 OF 13

NOTES TOMSIK

DATE 9/8/60

ROUTE SR 2

H.C. DRAUR

WEATHER CLEAR-HOT

COUNTY LUCAS

R.C. CHOPPURESS

TEMP. 90°

TOWNSHIP ADAMS

ORLOK/NORRIS

SECTION 13

DWG BY NIESE

PID _____

T 2 US R E

TYPE MONUMENT "+" IN BRICK

ON SURFACE - ~~BELOW~~ ON

OFFSET Q PAVEMENT _____ LT : RT

_____ TO _____ EDGE PAVEMENT


STATION: 723+98.58

HORIZ.DATUM: _____


GEOID: _____

GRID: NORTHING: _____

EASTING: _____

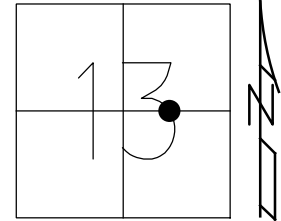

RECORD:
FD "+" IN BRICK
9/8/60

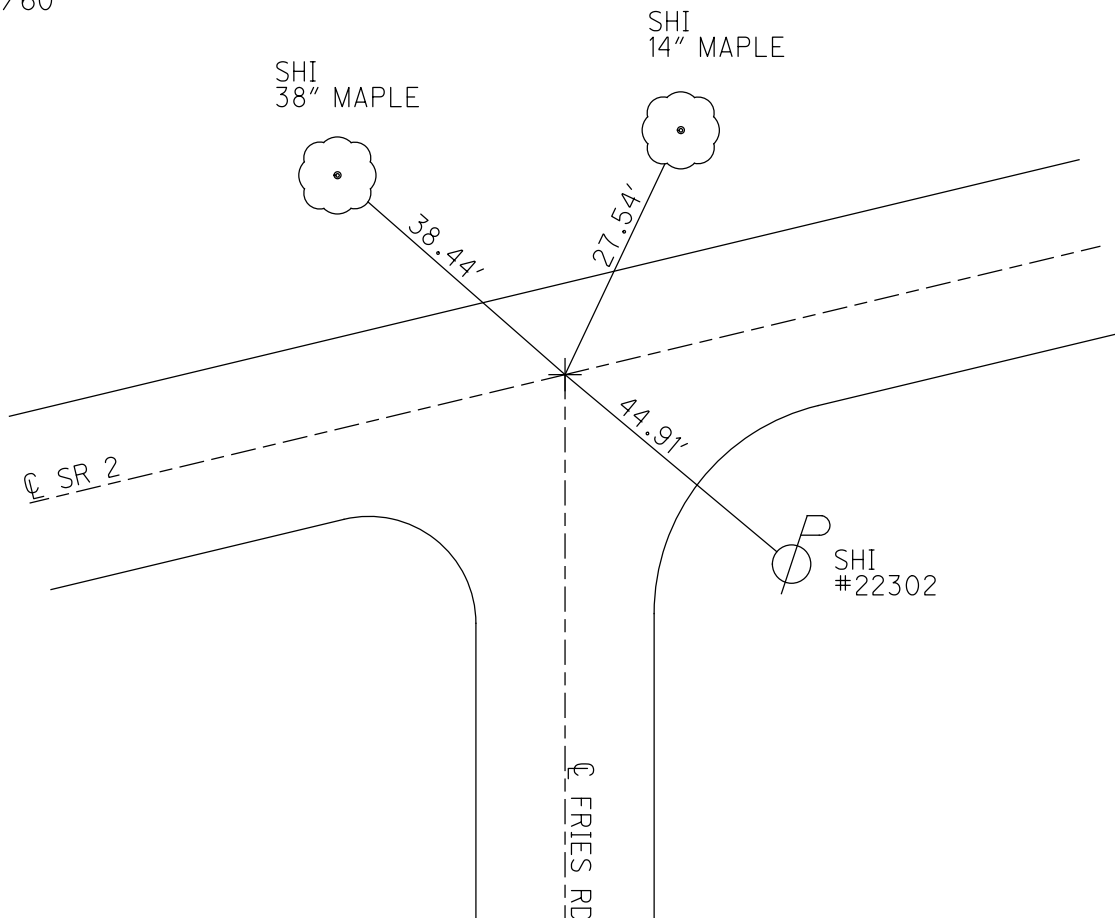

PERSONNEL TITLE PERSONNEL TITLE

Tomlin

Drake

Chapman

Oluk

COUNTY Lucas

DATE Sept.-8-60

S. R. Lu-2

WEATHER clear-hot

SEC. Rt Byrne Rd

TEMP. 90°

DESCRIPTION Monument Reference

LEFT

CENTER LINE

RIGHT

JOB NO.

