

O.D.O.T. DISTRICT 2 SURVEY OFFICE (USE ONLY)

PERSONNEL

REFERENCE NO. 28 D

SHEET 11 OF 13

NOTES MILLER

DATE 2/24/23

ROUTE SR 2

H.C. NIESE

WEATHER SUNNY

COUNTY LUCAS

R.C.

TEMP. 78°

TOWNSHIP AMBOY

DWG BY BARRIERE

PID 108465

SECTION 13

T 2 N R E

TYPE MONUMENT "+" IN PAVEMENT

ON SURFACE - BELOW ON

OFFSET Q PAVEMENT ON LT : RT

TO EDGE PAVEMENT

STATION: 735+06.38

HORZ.DATUM:


GEOID:

GRID: NORTHING:


EASTING:

LDP: NORTHING:

EASTING:

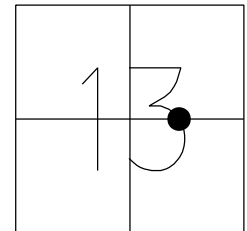

RECORD:
FD BRASS PLATE
9/8/60
DID NOT FIND
2/23/24, TDN

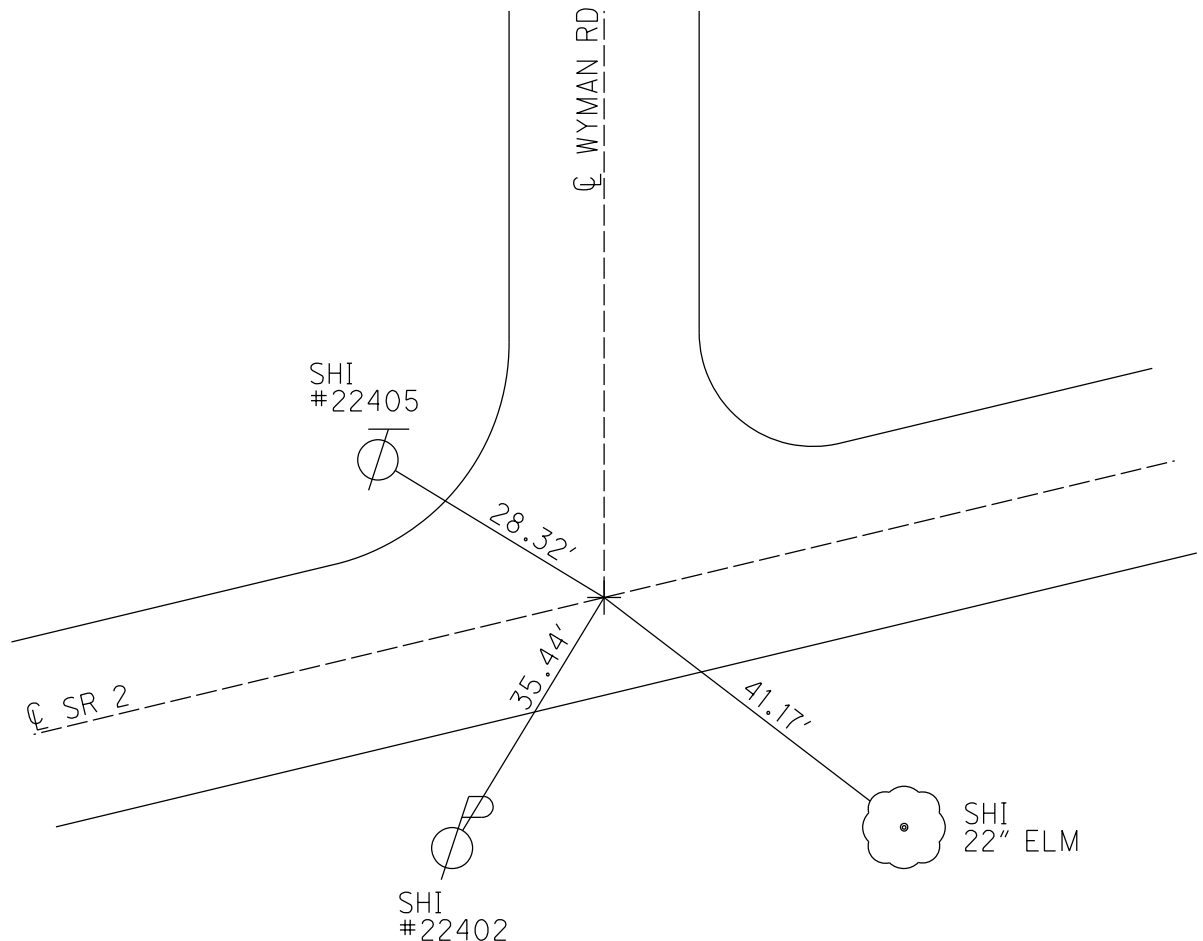

O.D.O.T. DISTRICT 2 SURVEY OFFICE (USE ONLY)

PERSONNEL

REFERENCE NO. 28 D

SHEET 11 OF 13

NOTES TOMSIK
H.C. DRAUR
R.C. CHOPPURESS
ORLOK/NORRIS

DATE 9/8/60
WEATHER CLEAR-HOT
TEMP. 90°

ROUTE SR 2
COUNTY LUCAS
TOWNSHIP ADAMS
SECTION 13
T 2 US R E

DWG BY NIESE PID

TYPE MONUMENT "+" IN PAVEMENT


ON SURFACE - ~~BELOW~~ ON

OFFSET ℄ PAVEMENT LT : RT
 TO EDGE PAVEMENT


STATION: 735+06.38

HORZ.DATUM: GEOID:

GRID: NORTHING: EASTING:

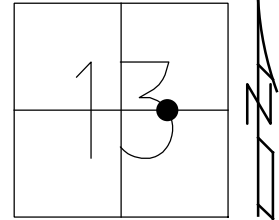

RECORD:
FD BRASS PLATE
9/8/60

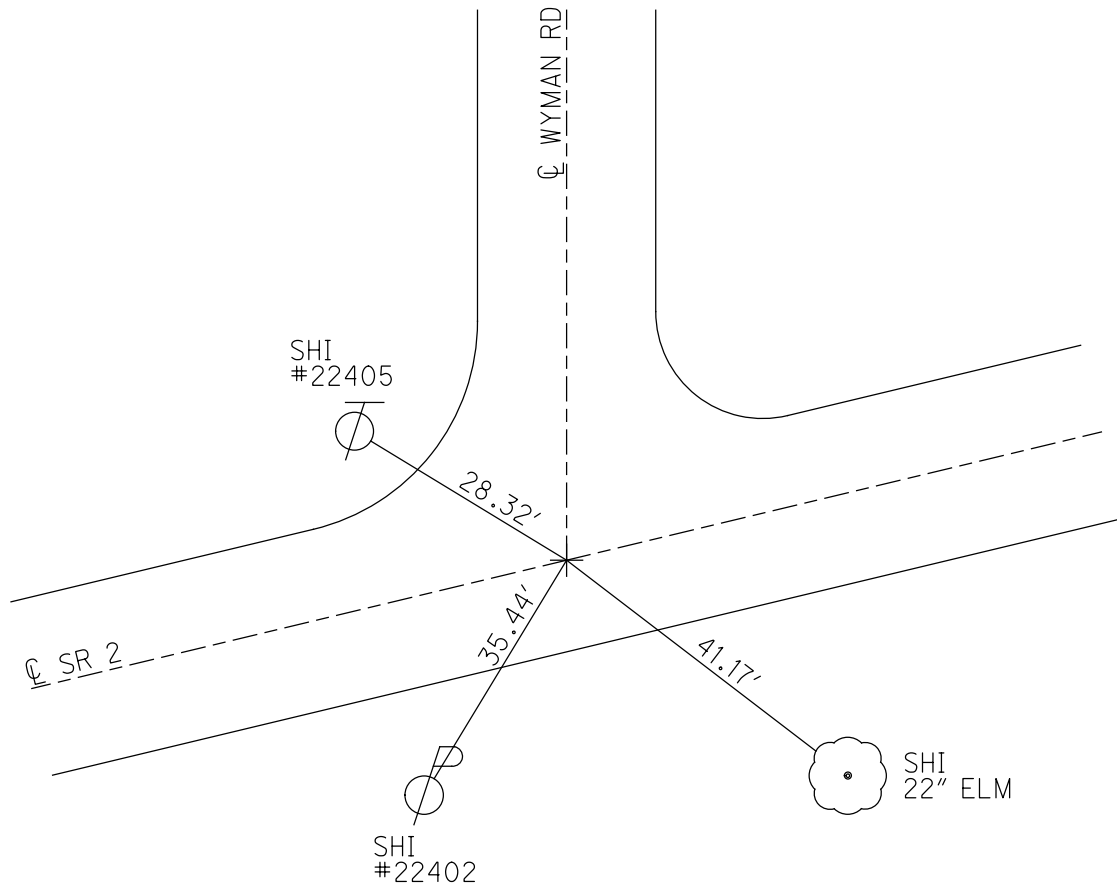

PERSONNEL

TITLE

PERSONNEL

TITLE

COUNTY Lucas

DATE: Sept. - 8 - 60

Tonische

Dravi-

Apples

S. R. 64-2

WEATHER clear-hot

Chappuis

other

SEC. A + Byrne Rd

TEMP. 90°

DESCRIPTION

Monument Reference

JOB NO.

LEFT

CENTER LINE

RIGHT

