

O.D.O.T. DISTRICT 2 SURVEY OFFICE (USE ONLY)

PERSONNEL

REFERENCE NO. 28 E

SHEET 12 OF 13

NOTES MILLER

DATE 2/24/23

ROUTE SR 2

H.C. NIESE

WEATHER SUNNY

COUNTY LUCAS

R.C.

TEMP. 78°

TOWNSHIP AMBOY

DWG BY BARRIERE

PID 108465

SECTION 13

T 2 N R E

TYPE MONUMENT ROOFING NAIL

ON SURFACE - BELOW ON

OFFSET $\varnothing$ PAVEMENT ON LT : RT

TO EDGE PAVEMENT

STATION: 739+25.62

HORIZ.DATUM:


GEOID:

GRID: NORTHING:


EASTING:

LDP: NORTHING:

EASTING:

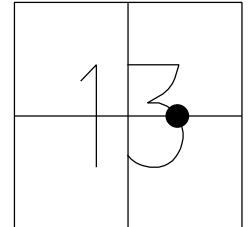

RECORD:
FD ROOFING NAIL
9/8/60
DID NOT FIND
2/23/24, TDN

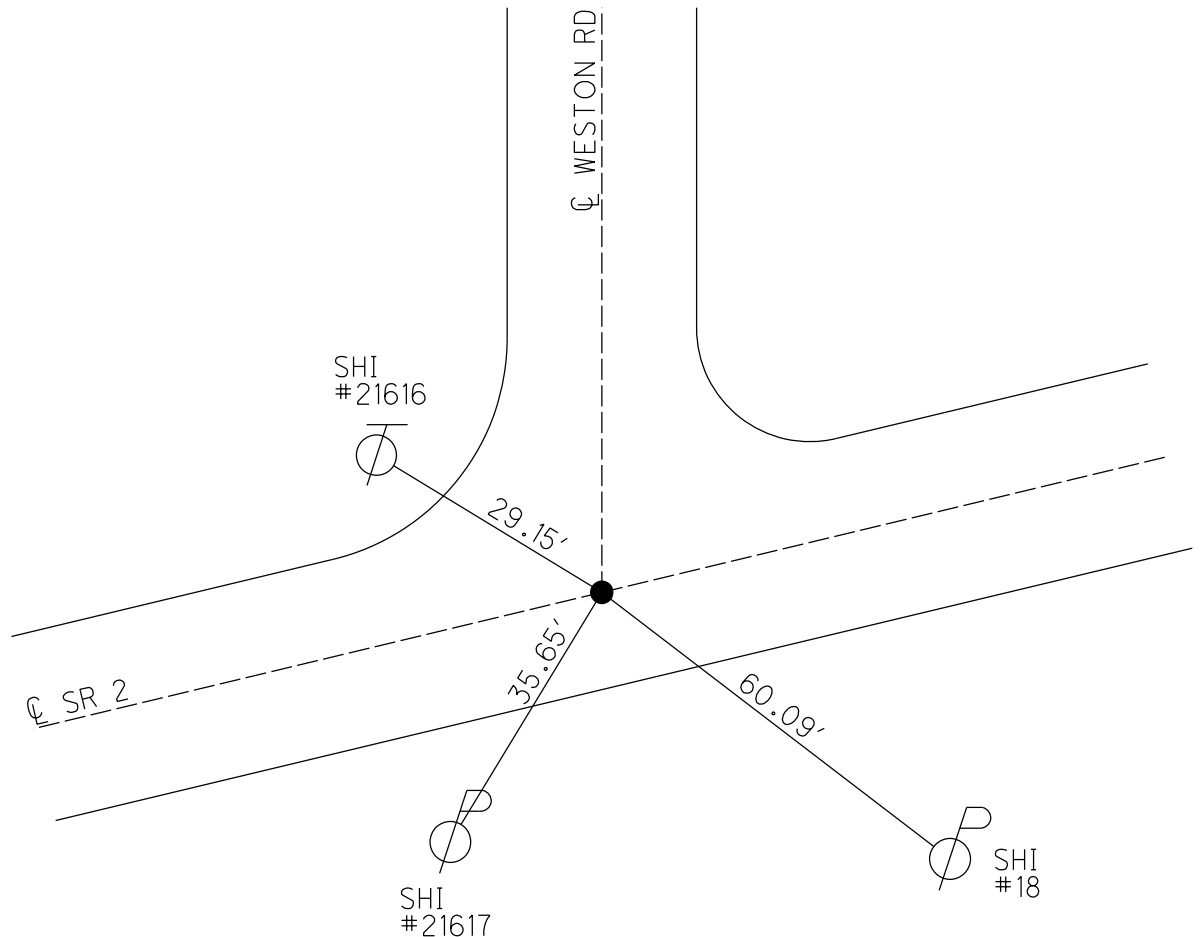

O.D.O.T. DISTRICT 2 SURVEY OFFICE (USE ONLY)

PERSONNEL

REFERENCE NO. 28 E

SHEET 12 OF 13

NOTES TOMSIK
H.C. CHOPPURESS
R.C. ORLOK
DRAUR/NORRIS

DATE 9/8/60
WEATHER CLOUDY
TEMP. 70°

ROUTE SR 2
COUNTY LUCAS
TOWNSHIP ADAMS
SECTION 13

DWG BY NIESE PID

T 2 US R E

TYPE MONUMENT ROOFING NAIL

ON SURFACE - ~~BELOW~~ ON


OFFSET $\odot$ PAVEMENT LT : RT

 TO EDGE PAVEMENT


STATION: 739+25.62

HORZ.DATUM: GEOID:

GRID: NORTHING: EASTING:

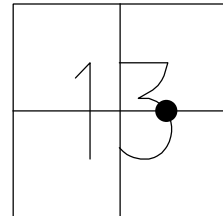

RECORD:
FD ROOFING NAIL
9/8/60

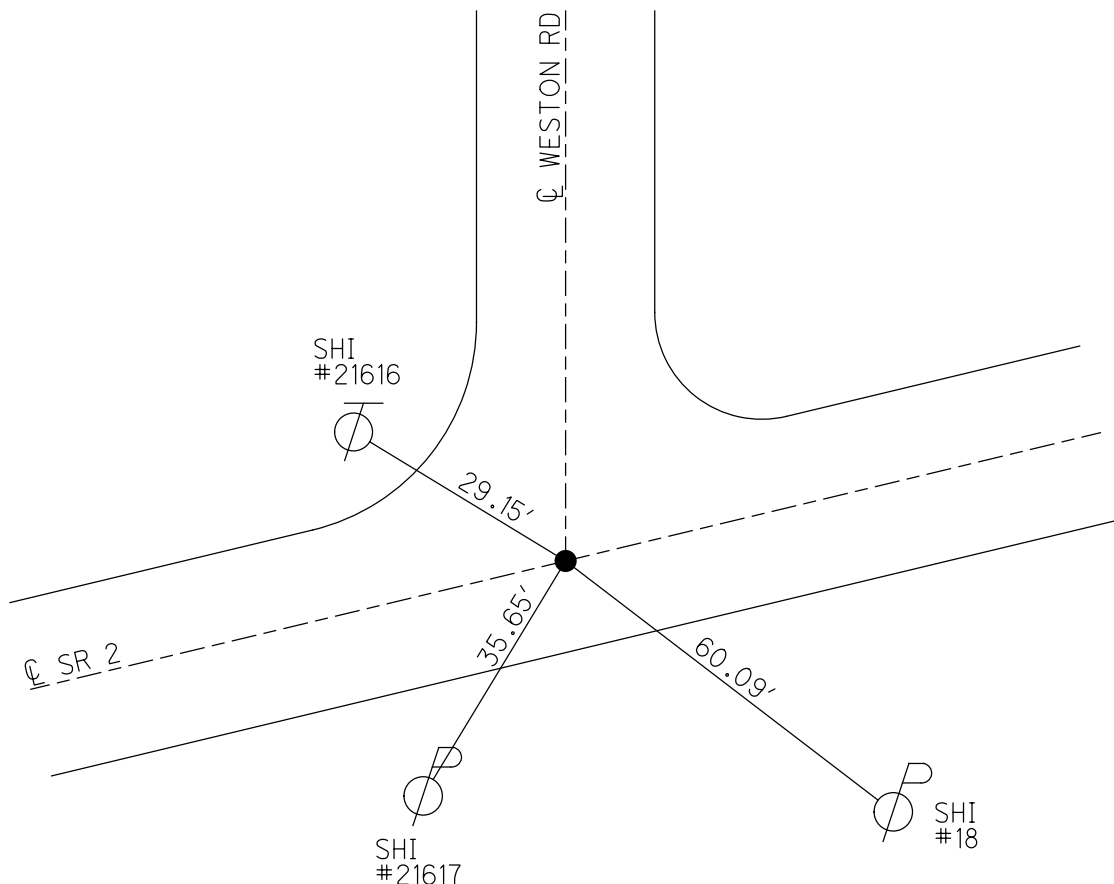

PERSONNEL TITLE PERSONNEL TITLE

COUNTY LucasDATE Sept. 9-60TomsicChappuissOrlukDravNorrisS. R. LU-2WEATHER Cloudy

SEC. _____

TEMP. 70°DESCRIPTION Monument Reference S.R. #2 & Byrne Rd.

JOB NO. _____

LEFT

CENTER LINE

RIGHT

Weston Rd.739+25.62 Routing Nail in PavementShiner in ϕ # 2166Shiner in ϕ # 2167I.P. in Med. on Byrne Rd.Shiner in ϕ # 2168

2168

7+21.07I-pin with 'f' in it.Shiner in ϕ # 932

Shiner 12" Maple

20+96.201/2" I.P. in Conc. Mon
on Byrne Rd.Shiner in ϕ # 30Shiner in ϕ # 29