

O.D.O.T. DISTRICT 2 SURVEY OFFICE (USE ONLY)

PERSONNEL

REFERENCE NO. 28 F

SHEET 14 OF 15

NOTES MILLER
H.C. NIESE
R.C. _____

DATE 2/24/23
WEATHER SUNNY
TEMP. 29°

ROUTE SR 2
COUNTY LUCAS
TOWNSHIP _____
SECTION 13
T 2 N R E

DWG BY BARRIERE PID 108465

TYPE MONUMENT MONBOX W/ 1" IPIN

ON SURFACE - BELOW ON

OFFSET Q PAVEMENT ON LT : RT

TO EDGE PAVEMENT

STATION: _____

HORIZ.DATUM: NAD83 (2011)


GEOID: NAVD88 2012B

GRID: NORTHING: 715992.611


EASTING: 1663309.388

LDP: NORTHING: _____

EASTING: _____

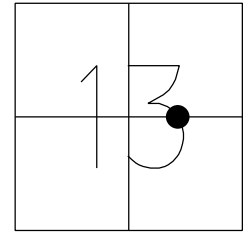

RECORD:
FD ROOFING NAIL
9/8/60
FD MONBOX
W/ 1" IPIN
REFF28
2/23/24, TDN

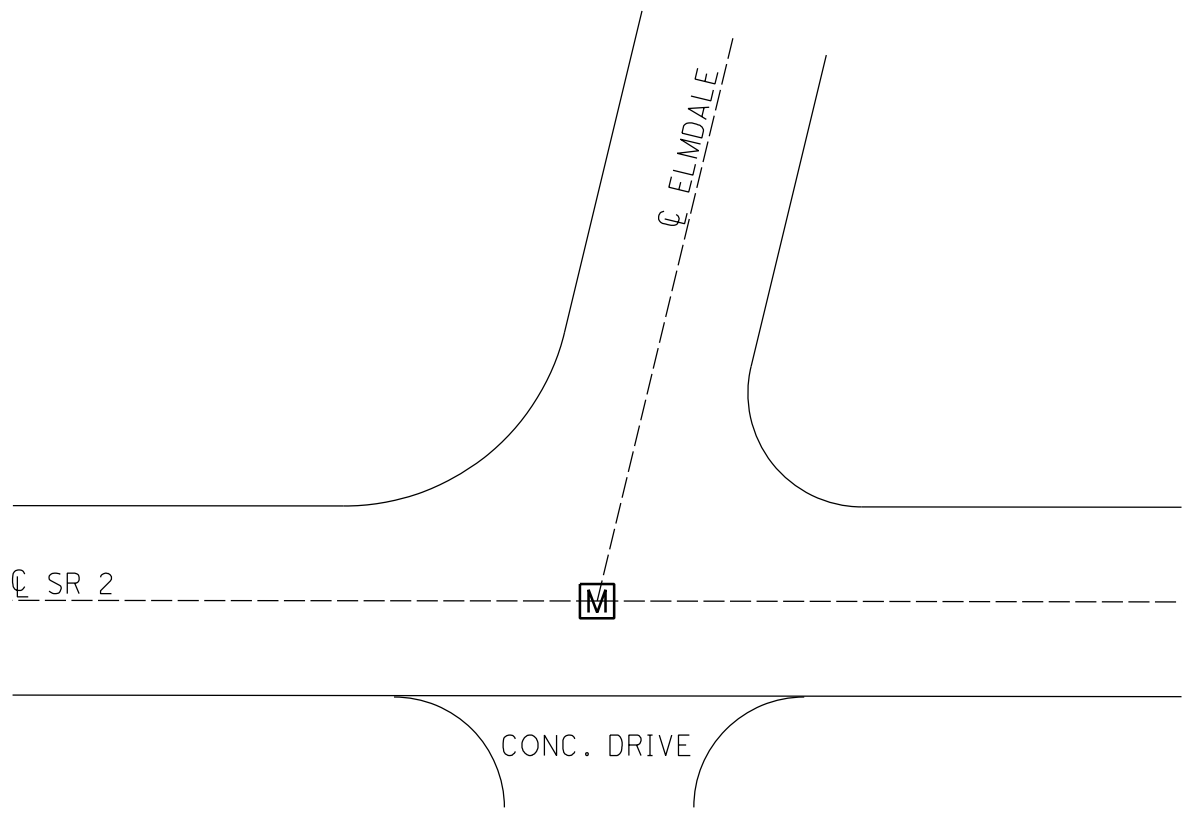

PERSONNEL TITLE PERSONNEL TITLE

COUNTY LUCASDATE 5/19/61BLAY
CREWS. R. #2WEATHER ClearSEC. Reynold Rd To T.T.R.R.TEMP. 75°DESCRIPTION Ref To Mon SR #2 (T.T.R.R. West)

JOB NO.

BLAY 10/3/61

LEFT

CENTER LINE

RIGHT

"X" IN
4" Steel Light Post

46.13

EIMDALE ST.

29.38

N of Shiner



BRASS PLATE

757+07.05

19.70

N of Shiner

SET RR SPIKE
10/3/61

"X" IN CURB

27.32

#9

N of Shiner

24.01

2" Steel
Fence Post

58.02

BRASS PLATE

741+35.32

19.55

SET PK NAIL
10/3/61

N of Shiner

New Pole

#8