

O.D.O.T. DISTRICT 2 SURVEY OFFICE (USE ONLY)

PERSONNEL

REFERENCE NO. 1

SHEET 1 OF 5

NOTES O'DONNELL

DATE 12/11/20

ROUTE SR 64

H.C.

WEATHER

COUNTY LUCAS

R.C.

TEMP.

TOWNSHIP WATERVILLE

SECTION RT 36

DWG BY RHOADES

PID 92088

T 6 N R 10 E

TYPE MONUMENT MONBOX W/ 1" IPIN

ON SURFACE - ~~BELOW~~ ON

OFFSET Q PAVEMENT - LT : RT

- TO - EDGE PAVEMENT


STATION: 5+33.34

HORIZ.DATUM: NAD 83 2011


GEOID: 2018

GRID: NORTHING: 670314.160

EASTING: 1635520.903

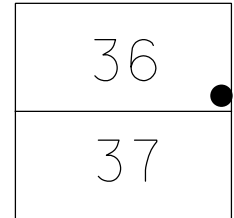

RECORD: P.I.
STA. 5+33.34
 $\Delta = 17^\circ 11' 30''$
R = 603.00'
L = 180.93'
C = 180.25'
C.B. = N $75^\circ 16' 23''$ W
P.C. STA. 4+42.19
FD MONBOX
W/1" IPIN
NEWSTA533
12/11/20, JFO

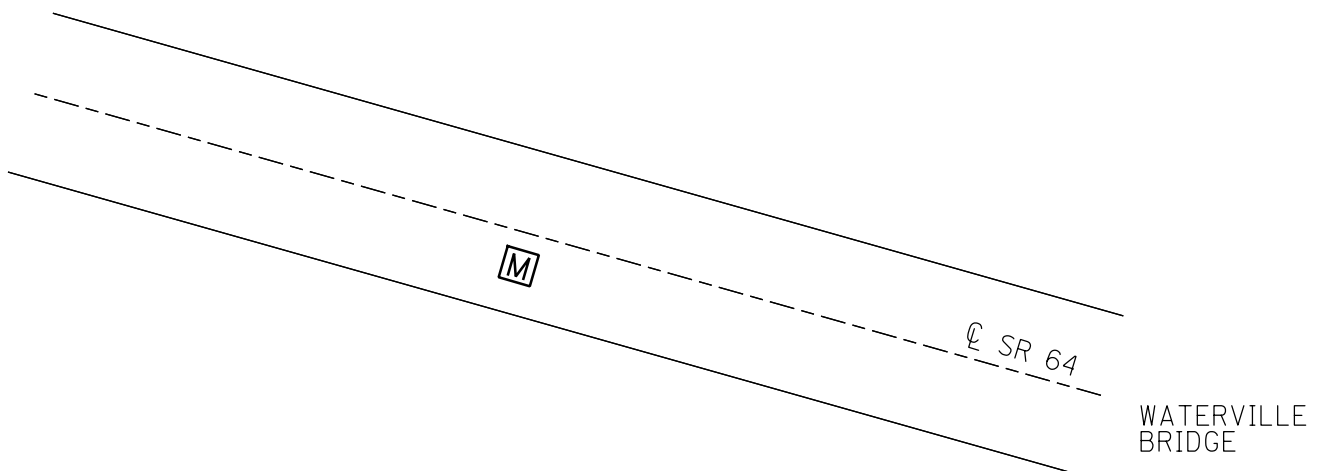

O.D.O.T. DISTRICT 2 SURVEY OFFICE (USE ONLY)

PERSONNEL

REFERENCE NO. 1 A

SHEET 2 OF 5

NOTES O'DONNELL

DATE 12/11/20

ROUTE SR 64

H.C.

WEATHER

COUNTY LUCAS

R.C.

TEMP.

TOWNSHIP WATERVILLE

SECTION RT 36

DWG BY RHOADES

PID 92088

T 6 N R 10 E

TYPE MONUMENT MONBOX W/1" IPIN

ON SURFACE - ~~BELOW~~ ON

OFFSET CL PAVEMENT ON LT : RT

- TO - EDGE PAVEMENT

STATION: 6+23.12

HORIZ.DATUM: NAD 83 2011

GEOID: 2018


GRID: NORTHING: 670350.165

EASTING: 1635437.232

36
37



RECORD: P.T.
STA. 6+23.12
FD MONBOX
W/1" IPIN
NEWSTA623
12/11/20, JFO

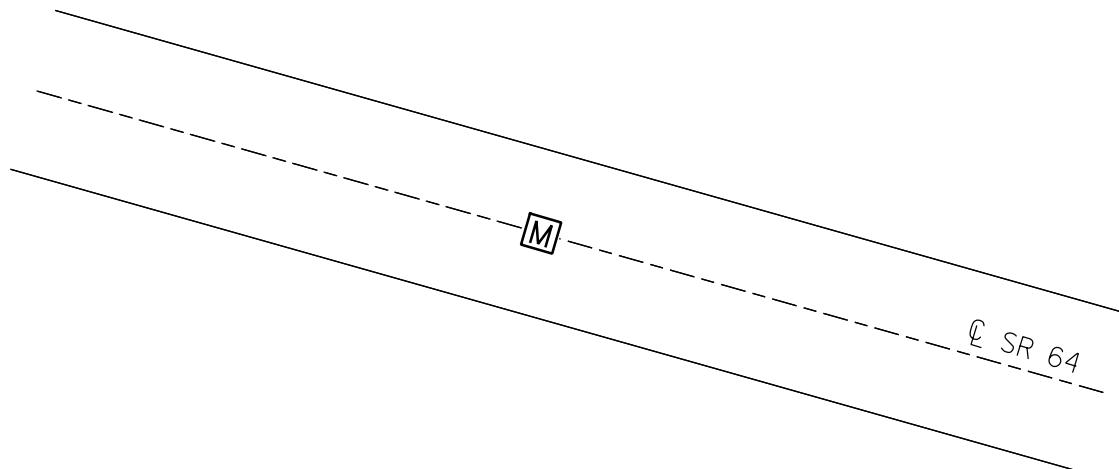

O.D.O.T. DISTRICT 2 SURVEY OFFICE (USE ONLY)

PERSONNEL

REFERENCE NO. 1 B

SHEET 3 OF 5

NOTES O'DONNELL

DATE 12/11/20

ROUTE SR 64

H.C.

WEATHER

COUNTY LUCAS

R.C.

TEMP.

TOWNSHIP WATERVILLE

SECTION RT 36

DWG BY RHOADES

PID 92088

T 6 N R 10 E

TYPE MONUMENT MONBOX W/1" IPIN

ON SURFACE - ~~BELOW~~ ON

OFFSET CL PAVEMENT ON LT : RT

- TO - EDGE PAVEMENT


STATION: 7+56.95

HORIZ.DATUM: NAD 83 2011

GEOID: 2018

GRID: NORTHING: 670403.211

EASTING: 1635314.308

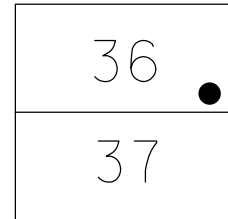

RECORD:

STA. 7+41.15

EXISTING CL 64

STA. 7+56.95


RELOCATED CL 64

FD MONBOX

W/1" IPIN

NEW STA 756

12/11/20, JFO

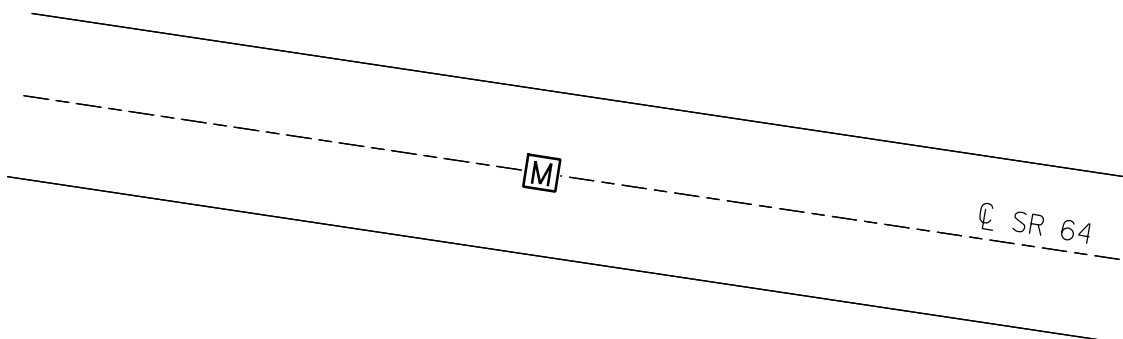

O.D.O.T. DISTRICT 2 SURVEY OFFICE (USE ONLY)

PERSONNEL

REFERENCE NO. 2

SHEET 4 OF 5

NOTES ROUSOS

DATE 4/18/02

ROUTE SR 64

H.C. HOMAN

WEATHER SUNNY

COUNTY LUCAS

R.C. ROUSOS

TEMP. 60°

TOWNSHIP WATERVILLE

SECTION RT 36

DWG BY RHOADES PID 92088

T 6 N R 10 E

TYPE MONUMENT LG.R.R.SPIKE

~~ON SURFACE~~ - BELOW 3"

OFFSET Q PAVEMENT ON LT : RT

- TO - EDGE PAVEMENT


STATION: 9+27.00

HORZ.DATUM: NAD 83 2011


GEOID: 2018

GRID: NORTHING: 670431.292

EASTING: 1635130.607

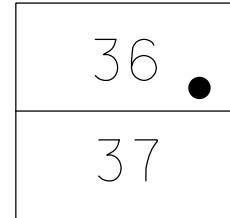

RECORD:
STA. 8+77
FD LG.R.R.SPIKE
3" DOWN
4/18/02, DCH
FD MONBOX
W/3" IPIPE
CL03
1/31/18, JMR

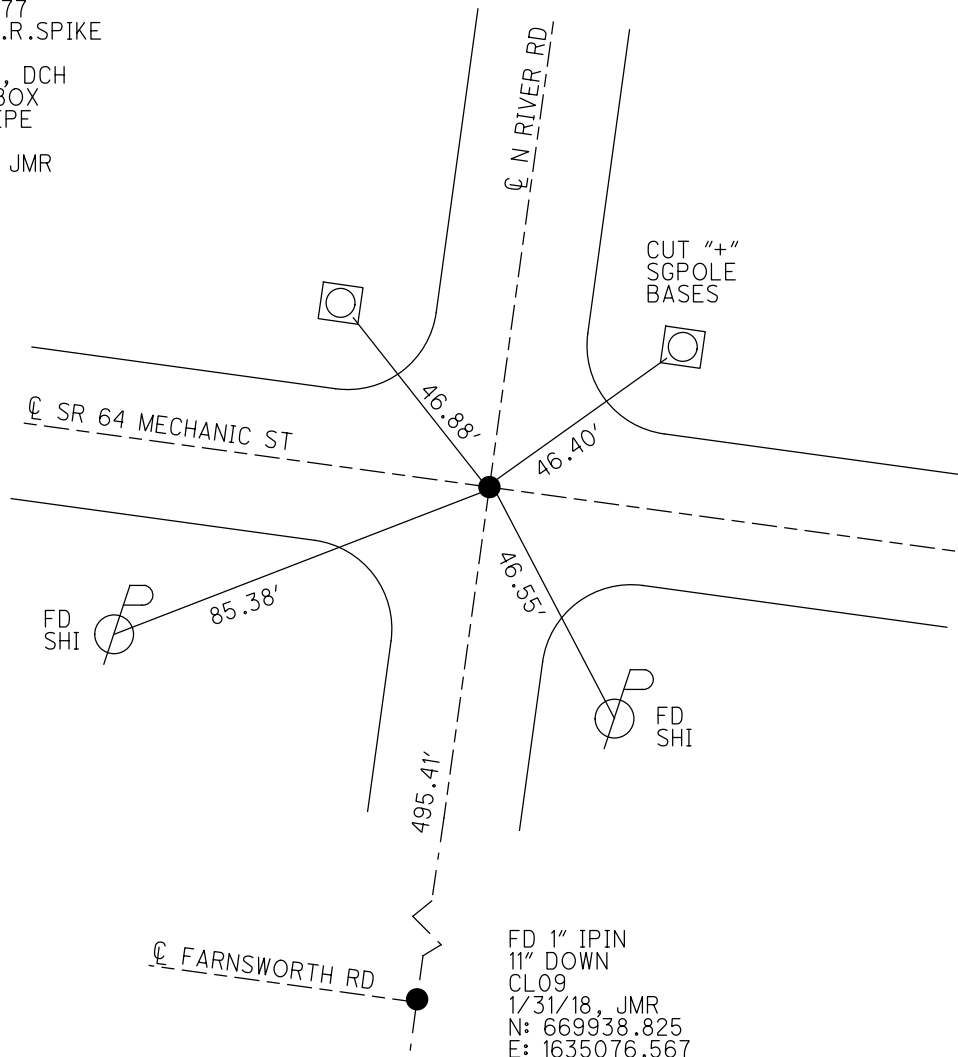

O.D.O.T. DISTRICT 2 SURVEY OFFICE (USE ONLY)

PERSONNEL

REFERENCE NO. 3

SHEET 5 OF 5

NOTES ROUSOS

DATE 5/7/02

ROUTE SR 64

H.C. HOMAN

WEATHER SUNNY

COUNTY LUCAS

R.C. ROUSOS

TEMP. 65°

TOWNSHIP WATERVILLE

DWG BY RHOADES PID 92088

SECTION RT 36

T 6 N R 10 E

TYPE MONUMENT 1/2" IPIN

~~ON SURFACE~~ - BELOW 7"

OFFSET CL PAVEMENT ON LT : RT

- TO - EDGE PAVEMENT

STATION: 12+90.12


HORIZ.DATUM: NAD 83 2011

GEOID: 2018


GRID: NORTHING: 670470.795

EASTING: 1634769.710

36
37

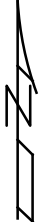

RECORD:
STA. 12+91
FD 1/2" IPIN
7" DOWN
5/7/02, DCH
FD MONBOX
W/1/2" IPIN
CL04
1/31/18, JMR

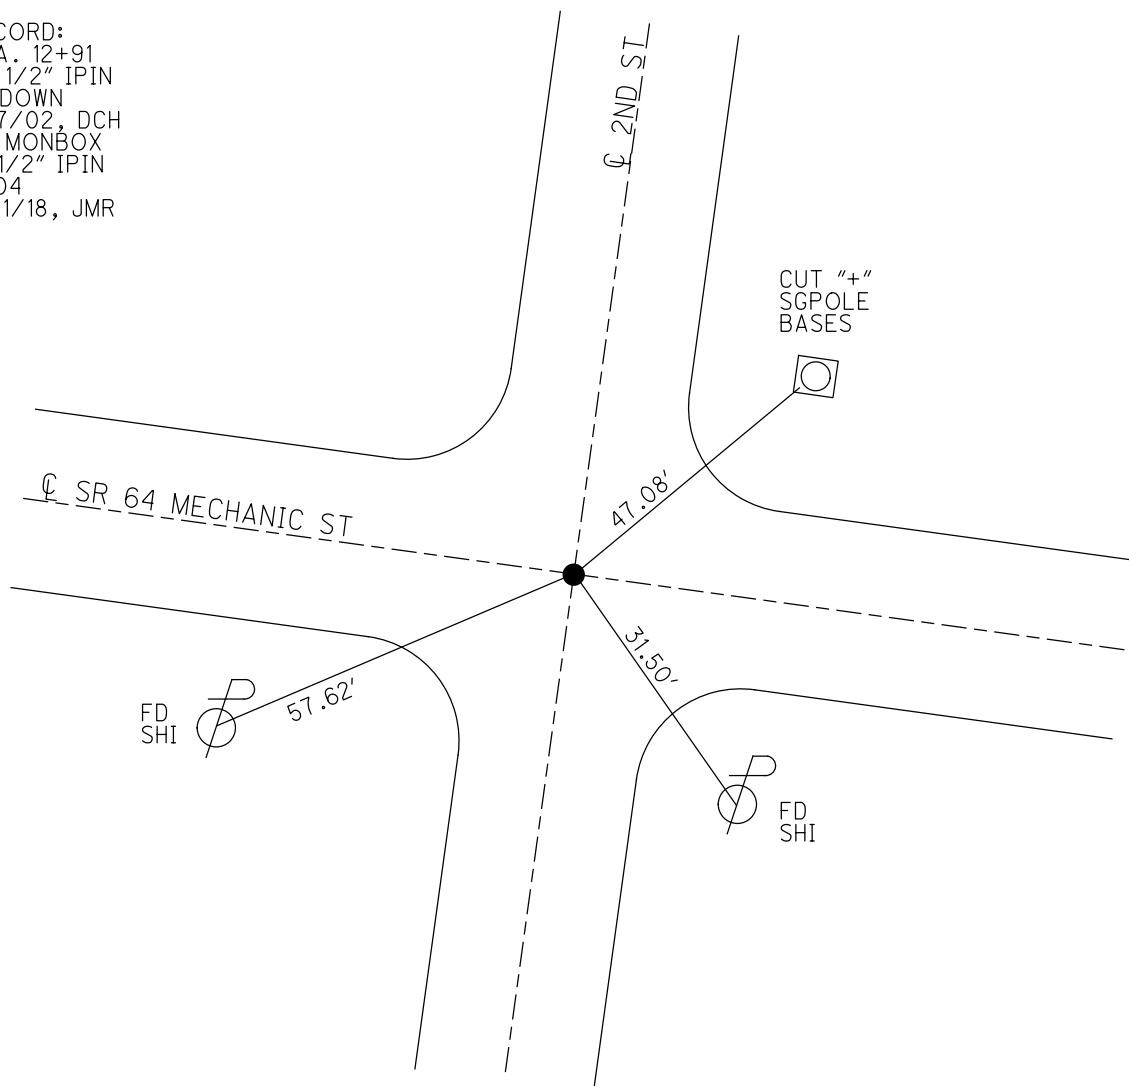

O.D.O.T. DISTRICT 2 SURVEY OFFICE (USE ONLY)

PERSONNEL

REFERENCE NO. 4

SHEET 6 OF 7

NOTES STONE

DATE 6/26/84

ROUTE SR 64

H.C.

WEATHER FAIR

COUNTY LUCAS

R.C. MICHALAK

TEMP. 71°

TOWNSHIP 12 MILE RESERVE

CURTIS

SECTION RT 36

DWG BY NIESE

PID

T 1 US R E

TYPE MONUMENT MOBORA

~~ON SURFACE~~ - BELOW 4"

OFFSET Q PAVEMENT ON LT : RT

- TO - EDGE PAVEMENT


STATION: 16+89.6

HORIZ.DATUM:

GEOID:


GRID: NORTHING:

EASTING:

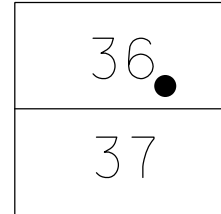

RECORD:
SLM STA 0.32
FD MOBORA
4" DOWN
6/26/84, IRS
SET P.K./WASHER
9/19/84, IRS

NOTE: REF57 US 24

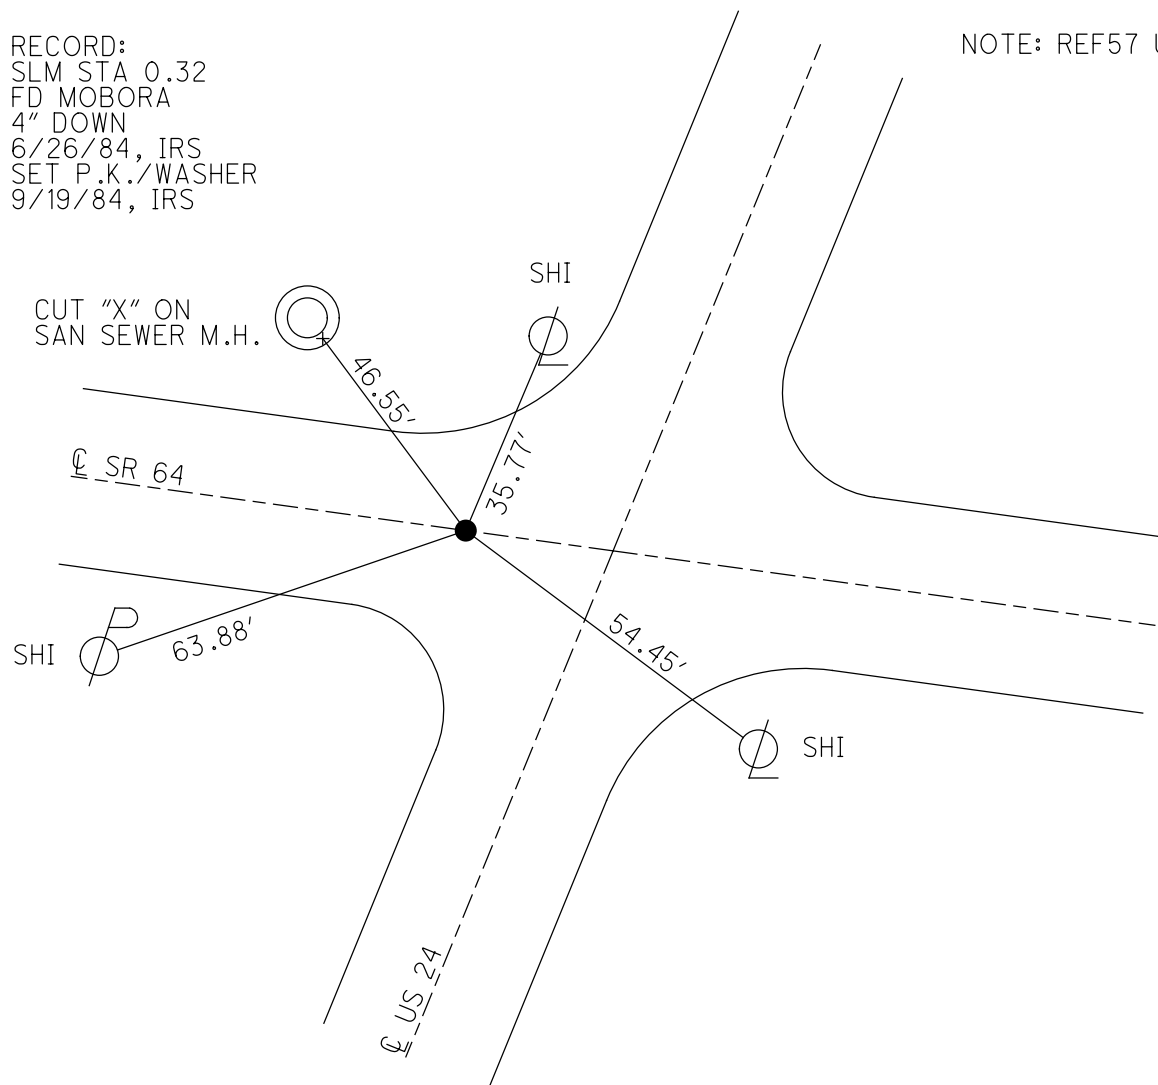

O.D.O.T. DISTRICT 2 SURVEY OFFICE (USE ONLY)

PERSONNEL

REFERENCE NO. 5

SHEET 7 OF 7

NOTES ROUSOS

DATE 4/18/02

ROUTE SR 64

H.C. HOMAN

WEATHER SUNNY

COUNTY LUCAS

R.C. ROUSOS

TEMP. 65°

TOWNSHIP 12 MILE RESERVE

SECTION RT 36

DWG BY NIESE PID

T 1 US R E

TYPE MONUMENT FD "X" ON MOBORA MON

~~ON SURFACE~~ - BELOW 1"

OFFSET Q PAVEMENT ON LT : RT

- TO - EDGE PAVEMENT

STATION: 23+93

HORIZ.DATUM:

GEOID:


GRID: NORTHING:

EASTING:

36
37



RECORD:
MONBOX SET
FD MOBORA W/ X
1" BELOW
4/18/02, TR

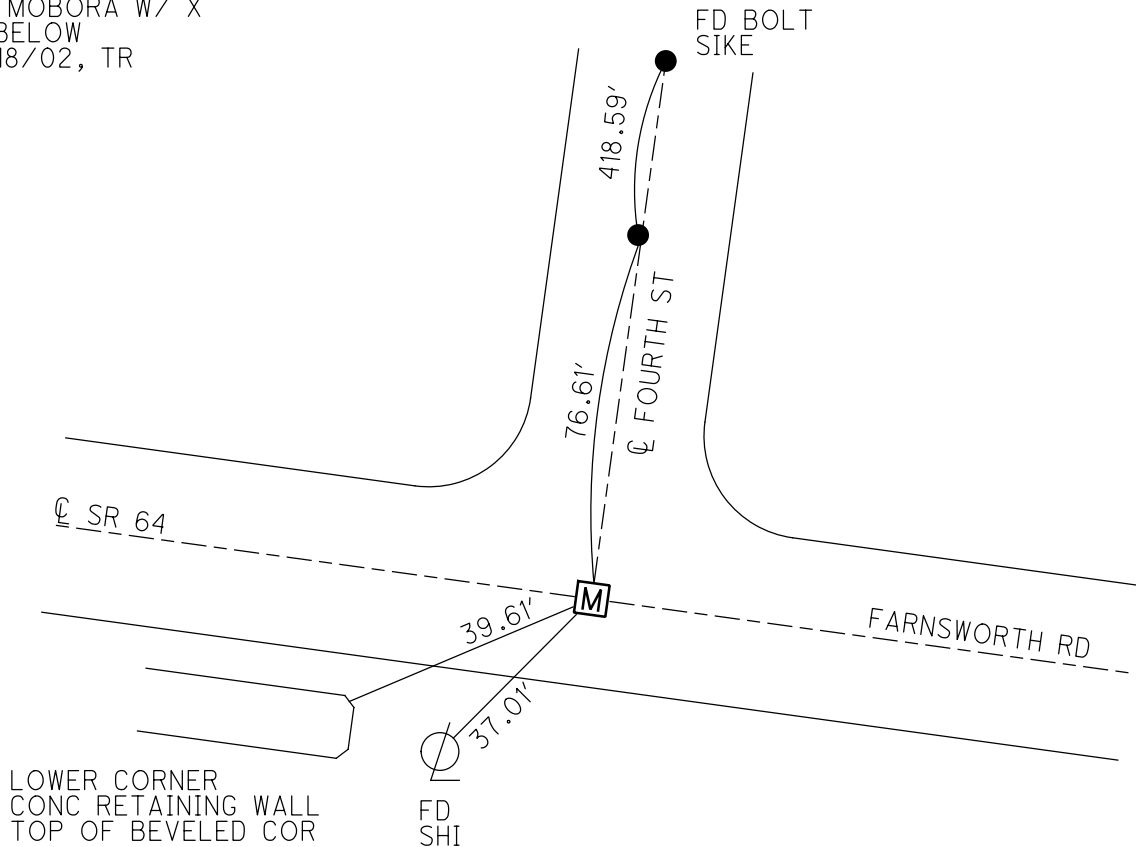

O.D.O.T. DISTRICT 2 SURVEY OFFICE (USE ONLY)

PERSONNEL

REFERENCE NO. 6

SHEET 8 OF 18

NOTES ROUSOS

DATE 5-01-02

ROUTE SR 64

H.C. HOMAN

WEATHER CLOUDY

COUNTY LUCAS

R.C. ROUSOS

TEMP. 60

TOWNSHIP WATERVILLESECTION RT 37

T__N R__E

DWG BY RHOADES

PID _____

TYPE MONUMENT P.K./WASHER

ON SURFACE - ~~BELOW~~ ON

OFFSET C PAVEMENT ON LT : RT

_____TO_____EDGE PAVEMENT


STATION: 27+59

HORZ.DATUM: _____


GEOID: _____

GRID: NORTHING: _____

EASTING: _____

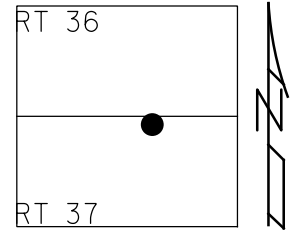

RECORD:
FD MOBORA MON.
7/30/68, DC
FD MOBORA MON.
1" DOWN
3/23/77, IRS
FD BRASS PLUGS
1" DOWN
5/21/81, CL
FD R.R. SPIKE
10/28/81 , SWH
FD P.K. NAIL
8/14/91, CL
SET P.K. NAIL
3/4/92, CL
FD MONBOX
W/IPIN
5/01/02, DCH

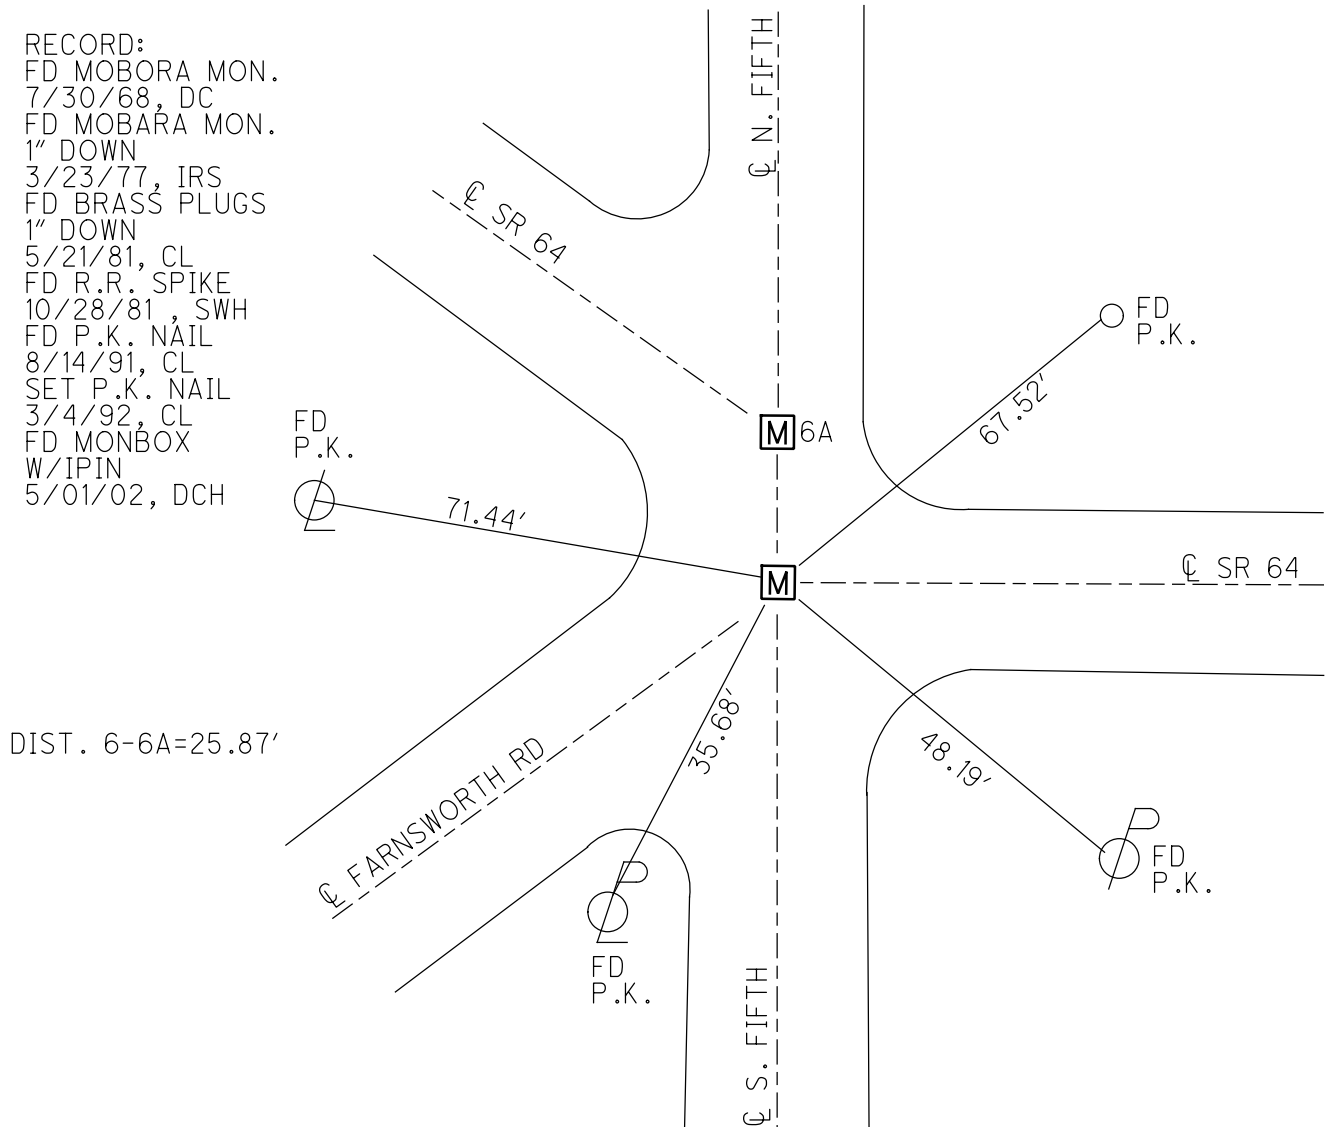

O.D.O.T. DISTRICT 2 SURVEY OFFICE (USE ONLY)

PERSONNEL

REFERENCE NO. 6 A

SHEET 9 OF 18

NOTES ROUSOS

DATE 5-01-02

ROUTE SR 64

H.C. HOMAN

WEATHER CLOUDY

COUNTY LUCAS

R.C. ROUSOS

TEMP. 60

TOWNSHIP WATERVILLE

SECTION RT 37

DWG BY RHOADES

PID -----

T N R E

TYPE MONUMENT MONBOX W/IPIN

ON SURFACE - ~~BELOW~~ ON

OFFSET CL PAVEMENT ON LT : RT

----- TO ----- EDGE PAVEMENT


STATION: 27+84.81

HORZ.DATUM: -----

GEOID: -----


GRID: NORTHING: -----

EASTING: -----

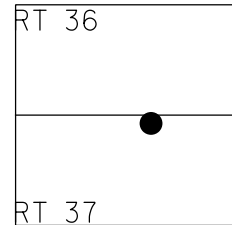

RECORD:
FD MOBORA MON.
7/30/68, DC
FD MOBORA MON.
1" DOWN
3/23/77, IRS
FD BRASS PLUGS
1" DOWN
5/21/81, CL
FD R.R. SPIKE
10/28/81, SWH
FD P.K. NAIL
8/14/91, CL
SET P.K. NAIL
3/4/92, CL
FD MONBOX
W/IPIN
5/01/02, DCH

DIST. 6-6A=25.87'

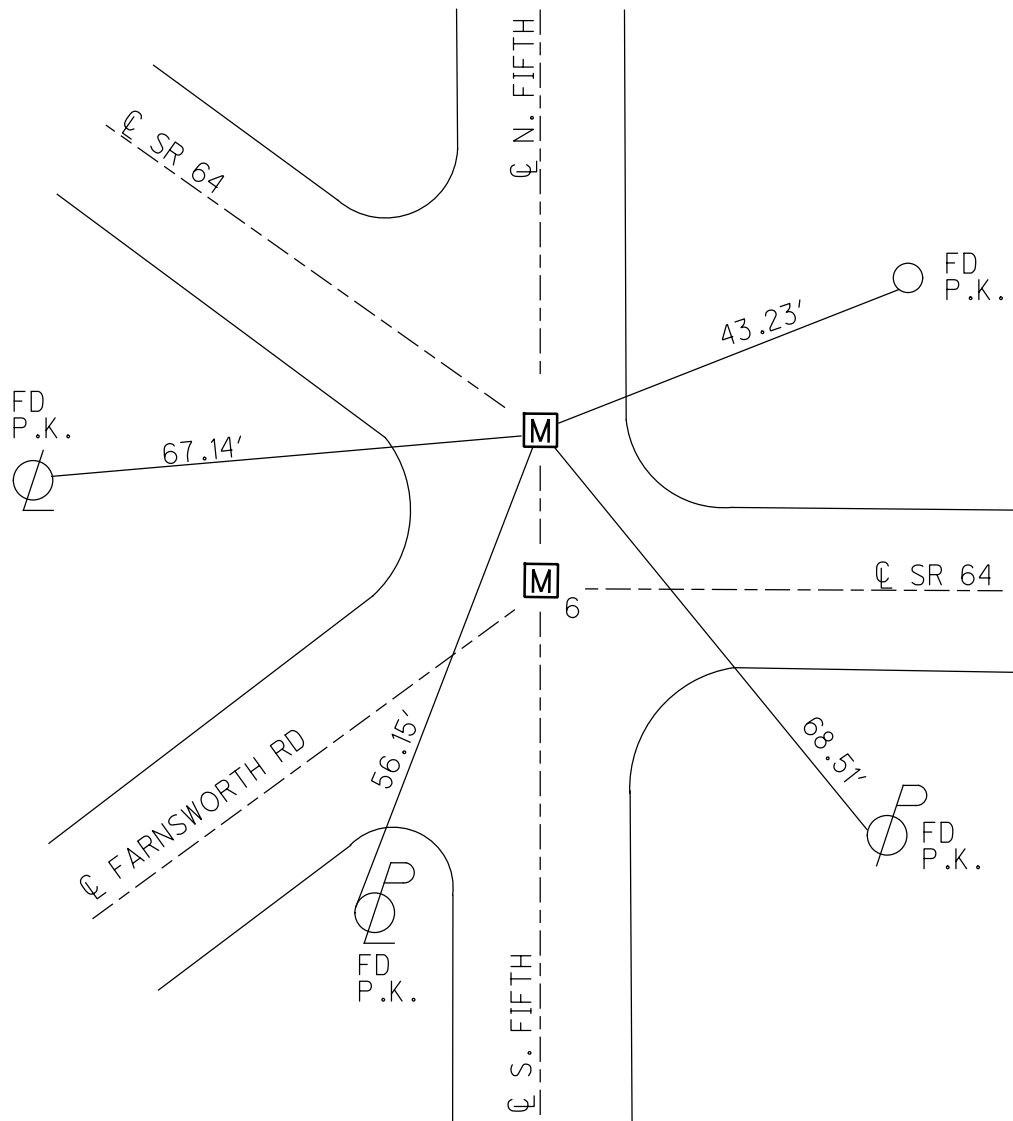

O.D.O.T. DISTRICT 2 SURVEY OFFICE

PERSONNEL

REFERENCE NO. 7

SHEET 7 OF 47

NOTES HOMAN

DATE 5-01-02

ROUTE S.R. 64

H.C. ROUSOS

WEATHER CLOUDY

COUNTY LUCAS

R.C. HOMAN

TEMP. 60

TOWNSHIP WATERVILLE

SECTION

T R


TYPE MONUMENT PK NAIL

ON SURFACE - BELOW ON


LEFT - PAV'T - RIGHT ON

 TO EDGE PAVEMENT

S.L.M. 31+50

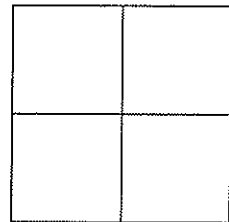

MONUMENT BOX SET

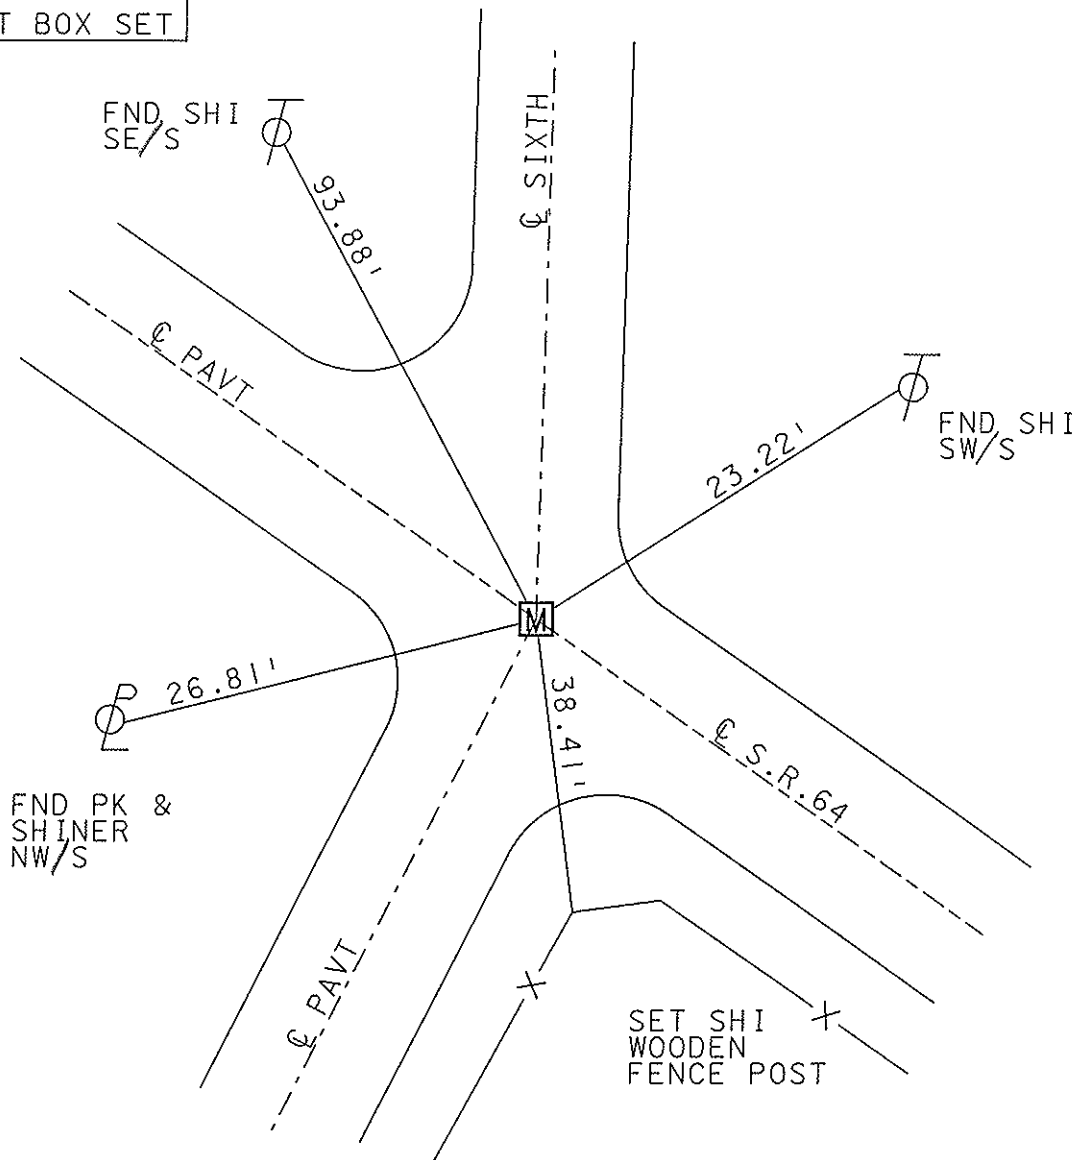

O.D.O.T. DISTRICT 2 SURVEY OFFICE

PERSONNEL

REFERENCE NO. 7-A

SHEET 8 OF 47

NOTES _____ HUMAN

DATE 5-01-02

ROUTE S.R. 64

H.C. ROUSOS

WEATHER CLOUDY

COUNTY LUCAS

R.C. HOMAN

TEMP. 60

TOWNSHIP WATERVILLE

SECTION _____

T _____ R _____



TYPE MONUMENT SEE DRAWING

ON SURFACE - BELOW SEE DRAWING

~~LEFT~~ - C PAV'T - ~~RIGHT~~ ON

TO _____ EDGE PAVEMENT

S.L.M. 38+14

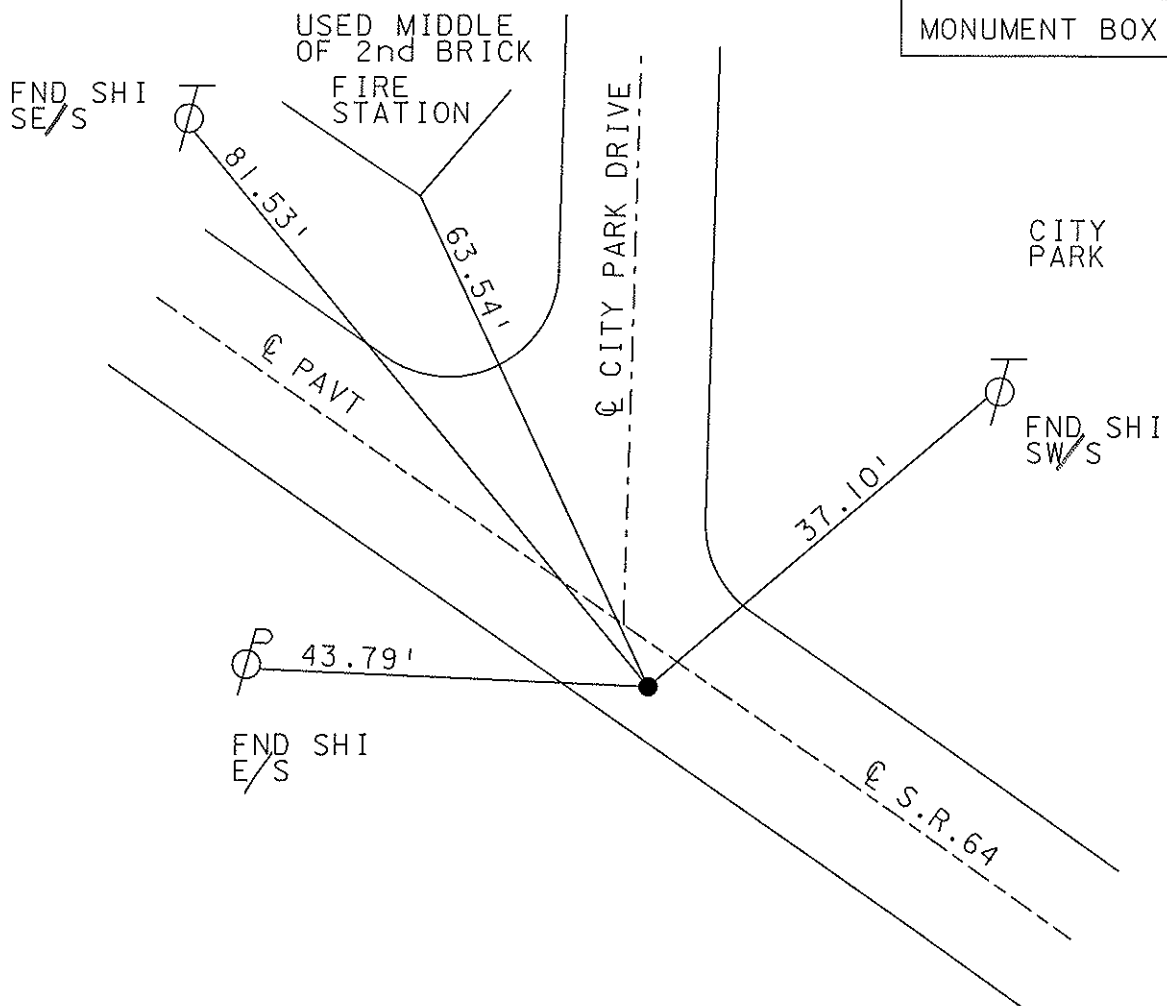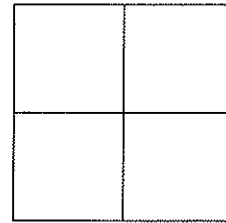

MONUMENT BOX SET

FD PK & WASHER
OVER SMALL RR SPIKE 2" DOWN

O.D.O.T. DISTRICT 2 SURVEY OFFICE

PERSONNEL

REFERENCE NO. 8

SHEET 9 OF 47

NOTES HOMAN

DATE 5-01-02

ROUTE S.R. 64

H.C. ROUSOS

WEATHER CLOUDY

COUNTY LUCAS

R.C. HOMAN

TEMP. 60

TOWNSHIP WATERVILLE

SECTION

T R


TYPE MONUMENT SEE DRAWING

ON SURFACE - BELOW SEE DRAWING

~~LEFT - C PAVT - RIGHT~~ ON


TO EDGE PAVEMENT

S.L.M. 48+11

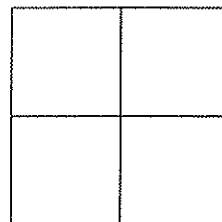

RECORD P.I.
 $\Delta = 0^{\circ} 03' \text{ LT}$

SET MAG NAIL
& WASHER
12-13-02
DCH

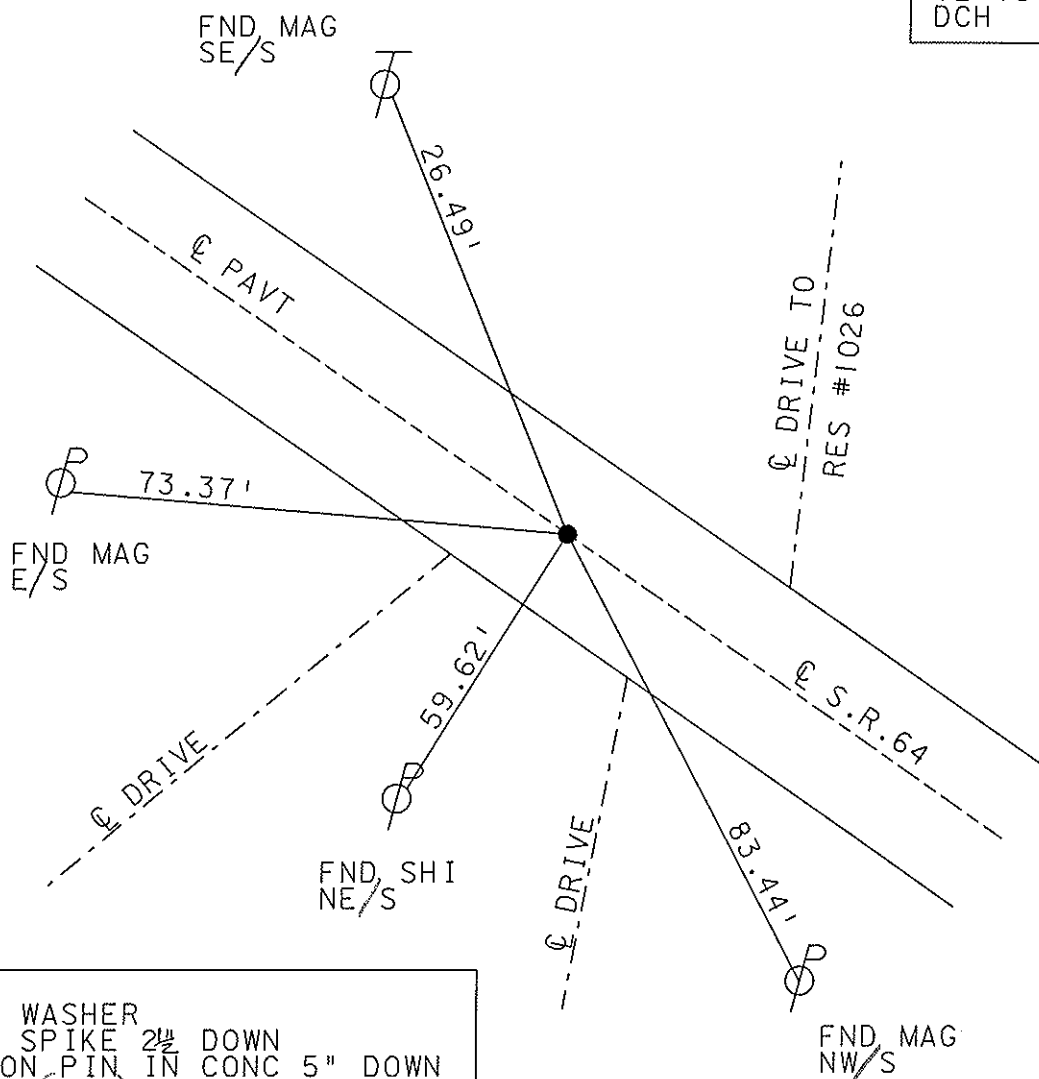

FD PKY & WASHER
OVER RR SPIKE $2\frac{1}{2}$ DOWN
OVER IRON PIN IN CONC 5" DOWN
(PIPE)

O.D.O.T. DISTRICT 2 SURVEY OFFICE

PERSONNEL

NOTES HOMAN

H.C. ROUSOS

R.C. HOMAN

REFERENCE NO. 9

DATE 5-01-02

WEATHER CLOUDY

TEMP. 65

SHEET 10 OF 47

ROUTE S.R. 64

COUNTY LUCAS

TOWNSHIP WATERVILLE

SECTION

T R


TYPE MONUMENT SEE DRAWING

ON SURFACE - BELOW SEE DRAWING


~~LEFT - C PAV'T - RIGHT~~ ON

TO EDGE PAVEMENT

S.L.M. 58+98

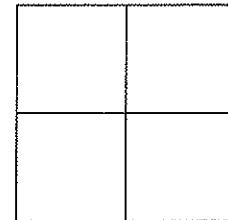

RECORD P.I.
 $\Delta = 0^\circ 02' RT$

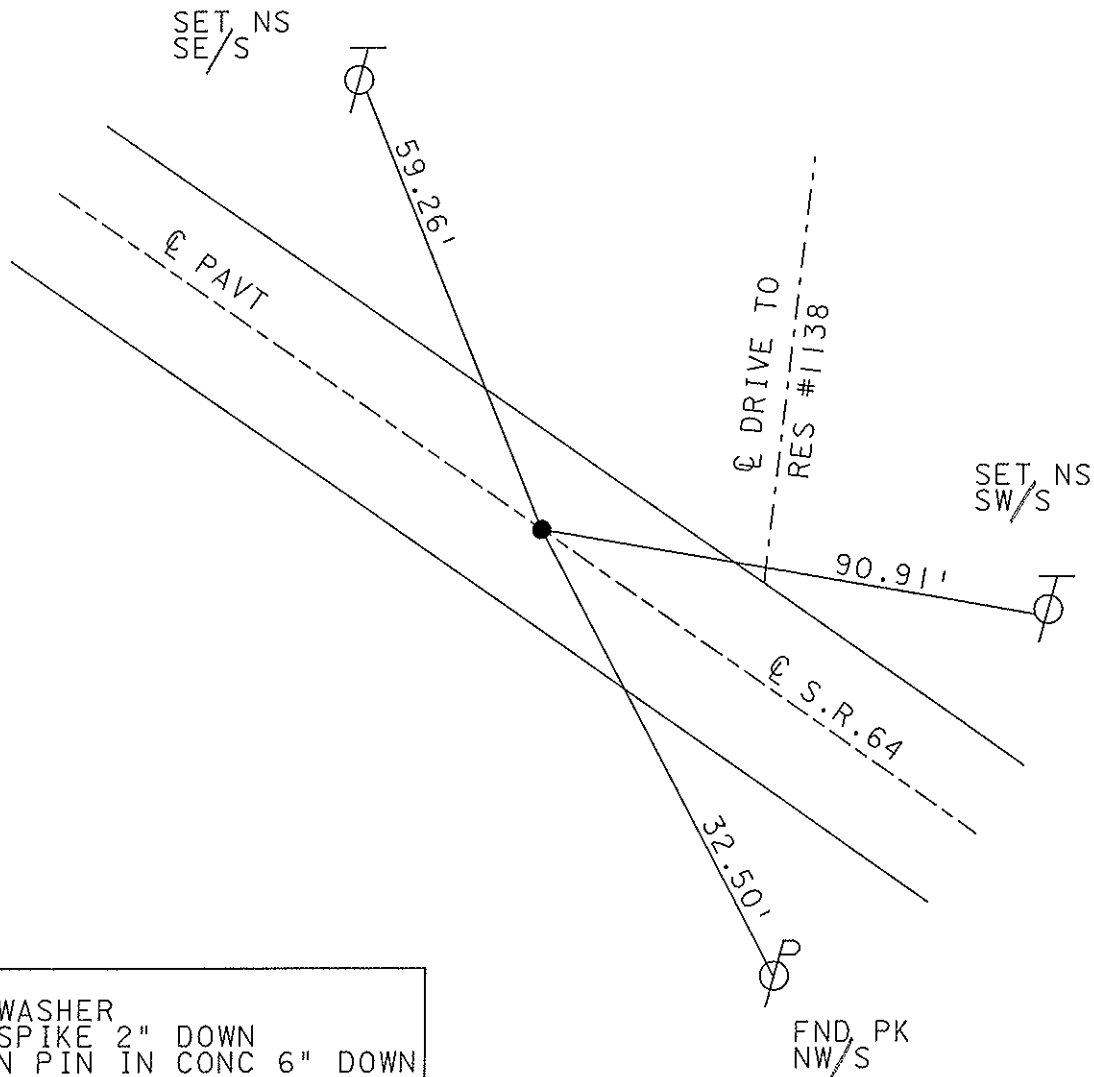

FD PK & WASHER
OVER RR SPIKE 2" DOWN
OVER IRON PIN IN CONC 6" DOWN

O.D.O.T. DISTRICT 2 SURVEY OFFICE

PERSONNEL

NOTES HOMAN

H.C. ROUSOS

R.C. HOMAN

REFERENCE NO. 9-A

DATE 5-01-02

WEATHER CLOUDY

TEMP. 65

SHEET 11 OF 47

ROUTE S.R. 64

COUNTY LUCAS

TOWNSHIP WATERVILLE

SECTION

T R


TYPE MONUMENT SEE DRAWING

ON SURFACE - BELOW SEE DRAWING

~~LEFT - C PAV'T - RIGHT~~ ON

TO EDGE PAVEMENT

S.L.M. 61+73

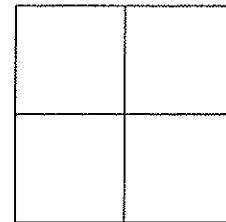

MONUMENT BOX SET

FND SHI
SE/S

46.89'

C PAVT

C CEDAR LANE

P 68.42'

FND SHI
E/S

66.93'

FND SHI
E/S

C S.R. 64
MICHIGAN AVE

FD PK & WASHER
OVER RR SPIKE 2" DOWN

O.D.O.T. DISTRICT 2 SURVEY OFFICE

PERSONNEL

REFERENCE NO. 10

SHEET 12 OF 47

NOTES _____ HOMAN _____

DATE 5-07-02

ROUTE S.R. 64

H.C. ROUSOS

WEATHER CLOUDY

COUNTY LUCAS

R.C. HOMAN

TEMP. 65

TOWNSHIP WATERVILLE


TYPE MONUMENT SEE DRAWING

~~ON SURFACE~~ - BELOW SEE DRAWING


~~LEFT~~ - C PAV'T - ~~RIGHT~~ ON

_____ TO _____ EDGE PAVEMENT

S.L.M. _____ 73+06

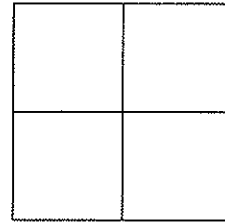

MONUMENT BOX SET

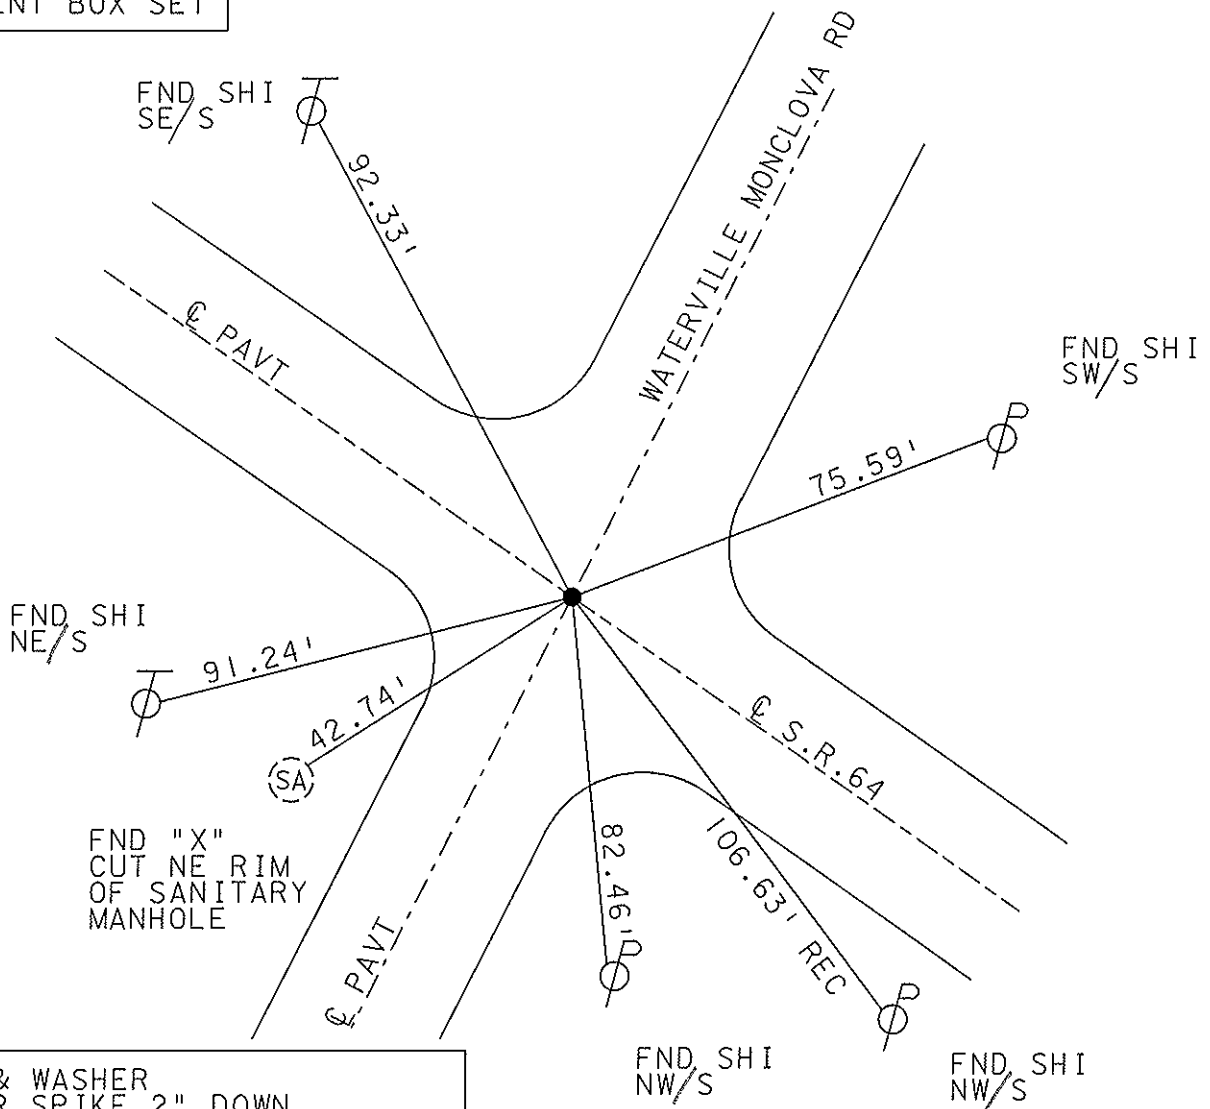

FD PK & WASHER
OVER RR SPIKE 2" DOWN
OVER IRON PIN IN CONC 5" DOWN

O.D.O.T. DISTRICT 2 SURVEY OFFICE

PERSONNEL

NOTES ROUSOS

H.C. HOMAN

R.C. MICHALAK

REFERENCE NO. 11

DATE 5-20-02

WEATHER CLOUDY

TEMP. 46

SHEET 13 OF 47

ROUTE S.R. 64

COUNTY LUCAS

TOWNSHIP WATERVILLE

SECTION 30

T 6 N R 6 E


TYPE MONUMENT Small RR SPIKE

ON SURFACE - ~~BELOW~~ ON


~~LEFT~~ - Q PAV'T - RIGHT 2.6'

7' TO RT EDGE PAVEMENT

S.L.M. 80+37

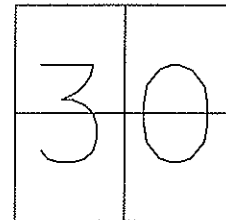

SET MAG NAIL
& WASHER
12-11-02
DCH

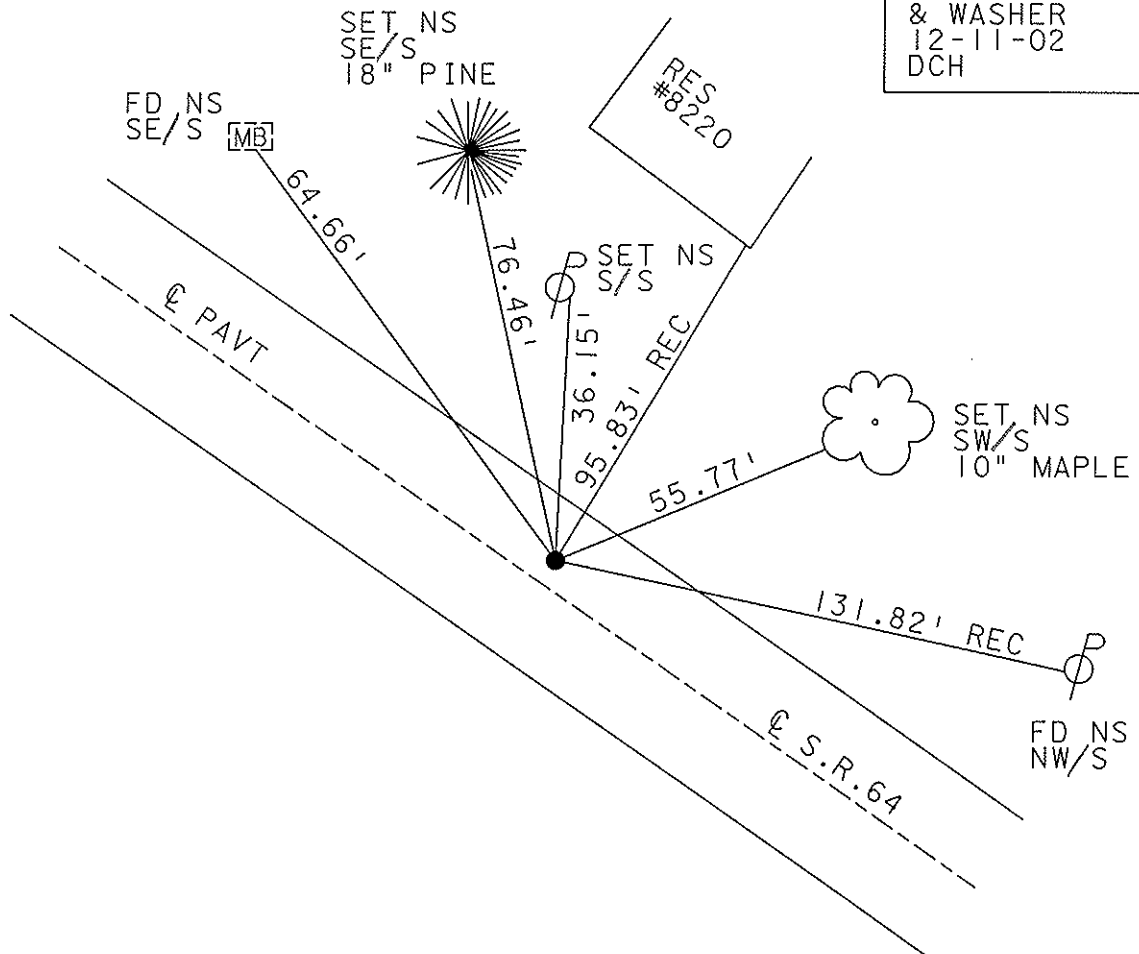

O.D.O.T. DISTRICT 2 SURVEY OFFICE

PERSONNEL

NOTES ROUSOS

H.C. HOMAN

R.C. MICHALAK

REFERENCE NO. 12

DATE 5-20-02

WEATHER CLOUDY

TEMP. 48

SHEET 14 OF 47

ROUTE S.R. 64

COUNTY LUCAS

TOWNSHIP WATERVILLE

SECTION 30

T 6 N R 6 E


TYPE MONUMENT Small RR SPIKE

ON SURFACE - ~~BELOW~~ ON


~~LEFT~~ - Q PAV'T - RIGHT 6.5'

4' TO RT EDGE PAVEMENT

S.L.M. 87+13

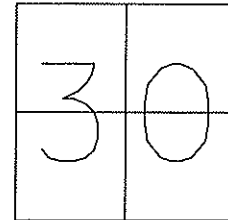

SET PK NAIL
& WASHER
8-07-02
DCH

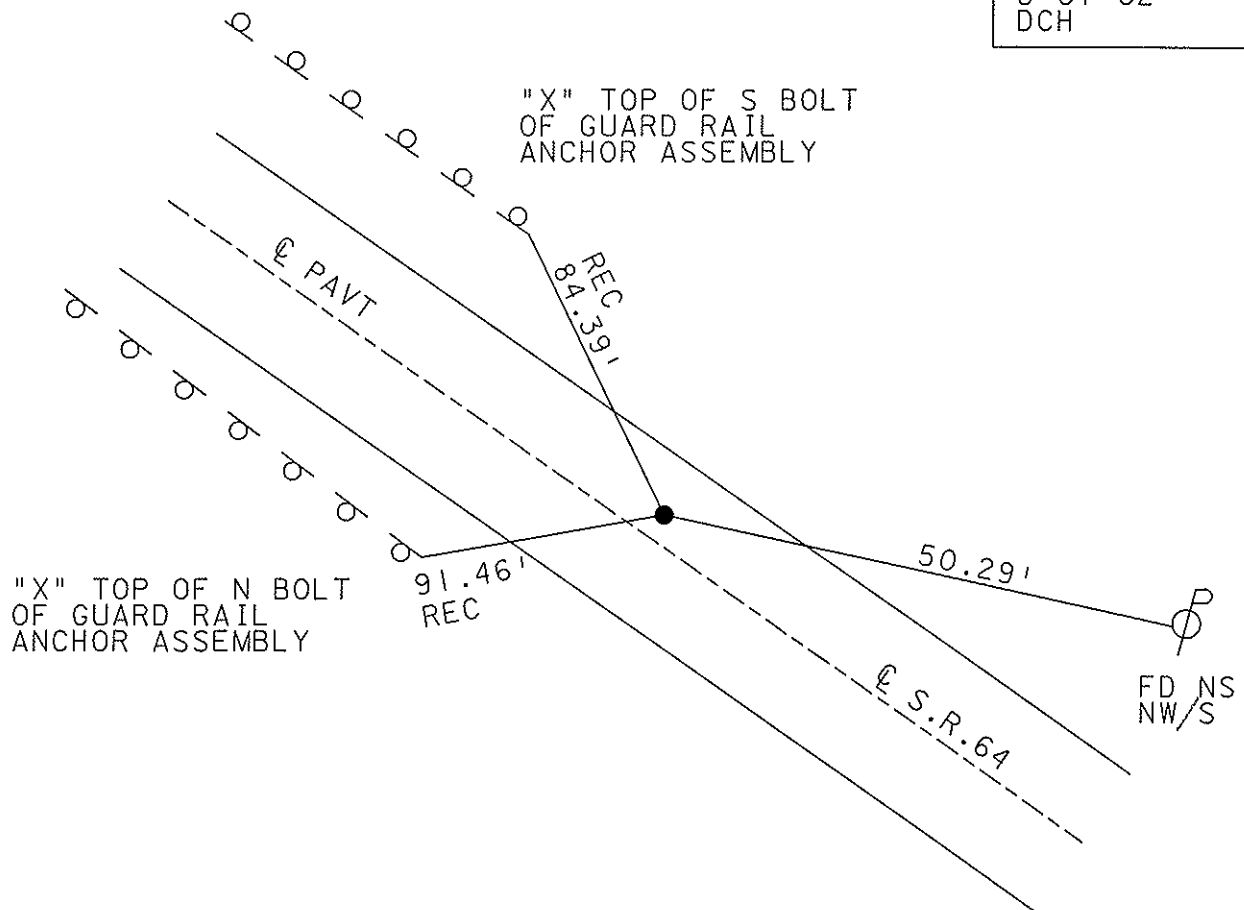

O.D.O.T. DISTRICT 2 SURVEY OFFICE

PERSONNEL

NOTES ROUSOS

H.C. HOMAN

R.C. MICHALAK

REFERENCE NO. 13

DATE 5-20-02

WEATHER CLOUDY

TEMP. 48

SHEET 15 OF 47

ROUTE S.R. 64

COUNTY LUCAS

TOWNSHIP WATERVILLE

SECTION 30

T 6 N R 6 E


TYPE MONUMENT PK NAIL & WASHER

ON SURFACE - ~~BELOW~~ ON


LEFT - Q PAV'T - ~~RIGHT~~ 3.0'

7' TO LT EDGE PAVEMENT

S.L.M. 109+29

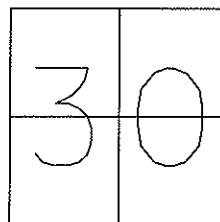

SET MAG NAIL
& WASHER
12-11-02
DCH

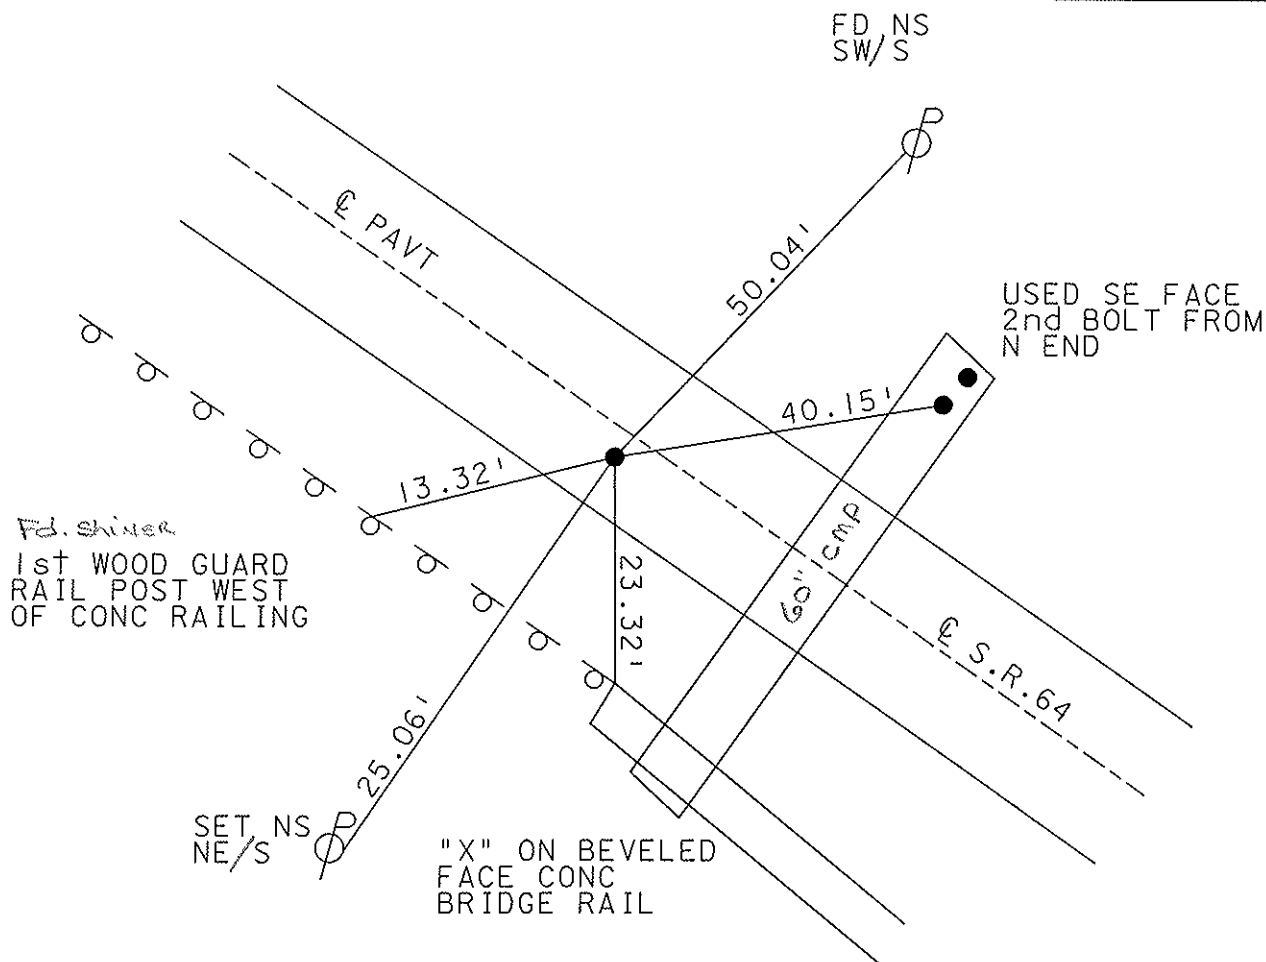

[illegible]

O.D.O.T. DISTRICT 2 SURVEY OFFICE (USE ONLY)

PERSONNEL

REFERENCE NO. 15

SHEET 2 OF 56

NOTES ROUSOS

DATE

ROUTE SR 64

H.C. HOMAN

WEATHER CLOUDY

COUNTY LUCAS

R.C. MICHALAK

TEMP. 48°

TOWNSHIP WATERVILLE

SECTION 19

T 6 N R 10 E

TYPE MONUMENT P.K.NAIL/WASHER


ON SURFACE - ~~BELOW~~ ON

LEFT - CL PAV'T - ~~RIGHT~~ 1.9'


8.1' TO LT EDGE PAVEMENT

S.L.M. 116+19.71

Grid: Northing: _____ Easting: _____

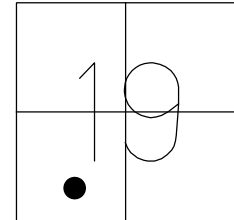

RECORD: P.I.
STA. 121+78
 $\Delta = 0^\circ 39' 30''$ LT
SET P.K.NAIL/WASHER
8-07-02, DCH
DNF
1-4-16, JFO

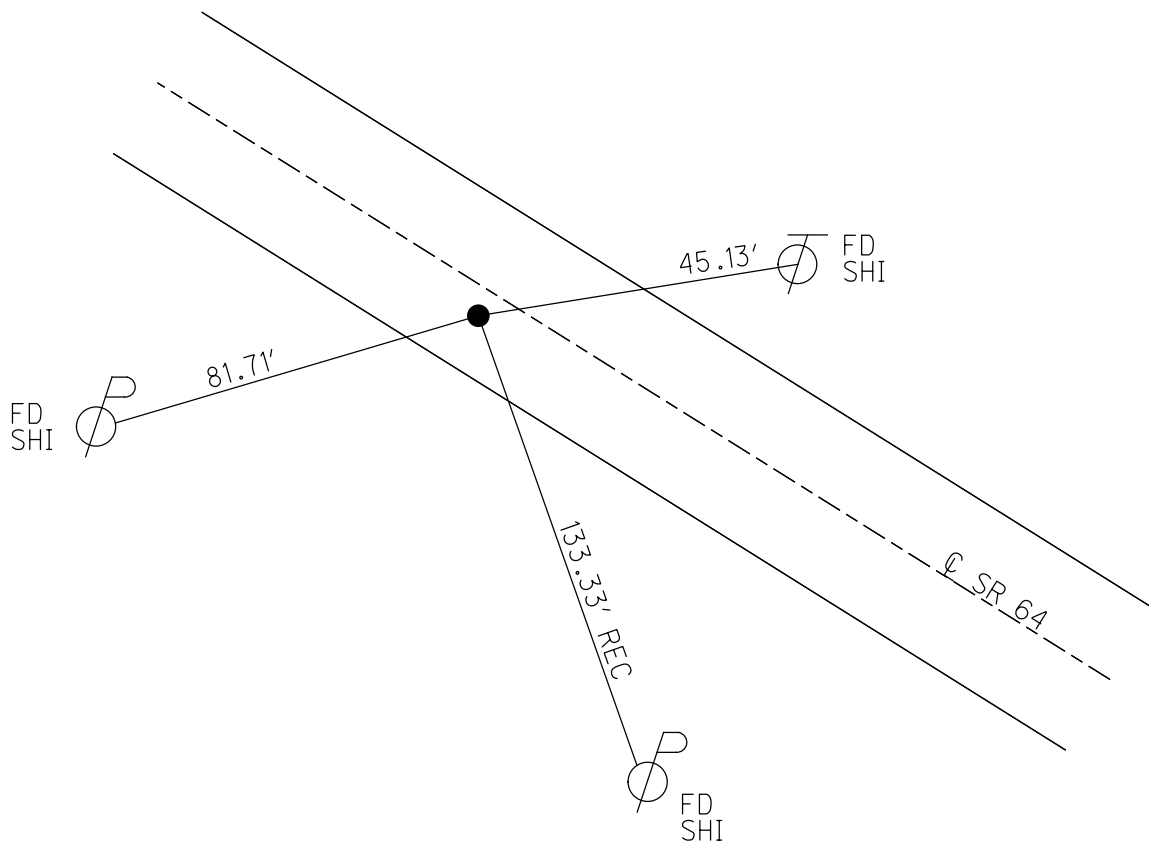


O.D.O.T. DISTRICT 2 SURVEY OFFICE (USE ONLY)


PERSONNEL	REFERENCE NO. <u>16</u>	SHEET <u>3</u> OF <u>50</u>
NOTES <u>ROUSOS</u>	DATE <u>5-20-02</u>	ROUTE <u>SR 64</u>
H.C. <u>HOMAN</u>	WEATHER <u>CLOUDY</u>	COUNTY <u>LUCAS</u>
R.C. <u>MICHALAK</u>	TEMP. <u>48°</u>	TOWNSHIP <u>WATERVILLE</u>
		SECTION <u>19</u>
		T <u>6</u> N R <u>10</u> E

TYPE MONUMENT P.K.WASHER
 ON SURFACE - ~~BELOW~~ ON
 LEFT - Q PAV'T - ~~RIGHT~~ 2.5'
7' TO LT EDGE PAVEMENT
 S.L.M. 127+25.52

Grid: Northing: 673737.8568 Easting: 1624314.3890

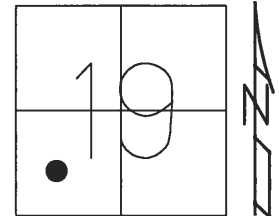

RECORD:
 P.I. $\Delta = 0^\circ 34' 00''$ LT
 SET P.K.NAIL/WASHER
 8-07-02, DCH
 FD MON BOX WITH
 1" IPIN REF16
 1-15-16, JFO

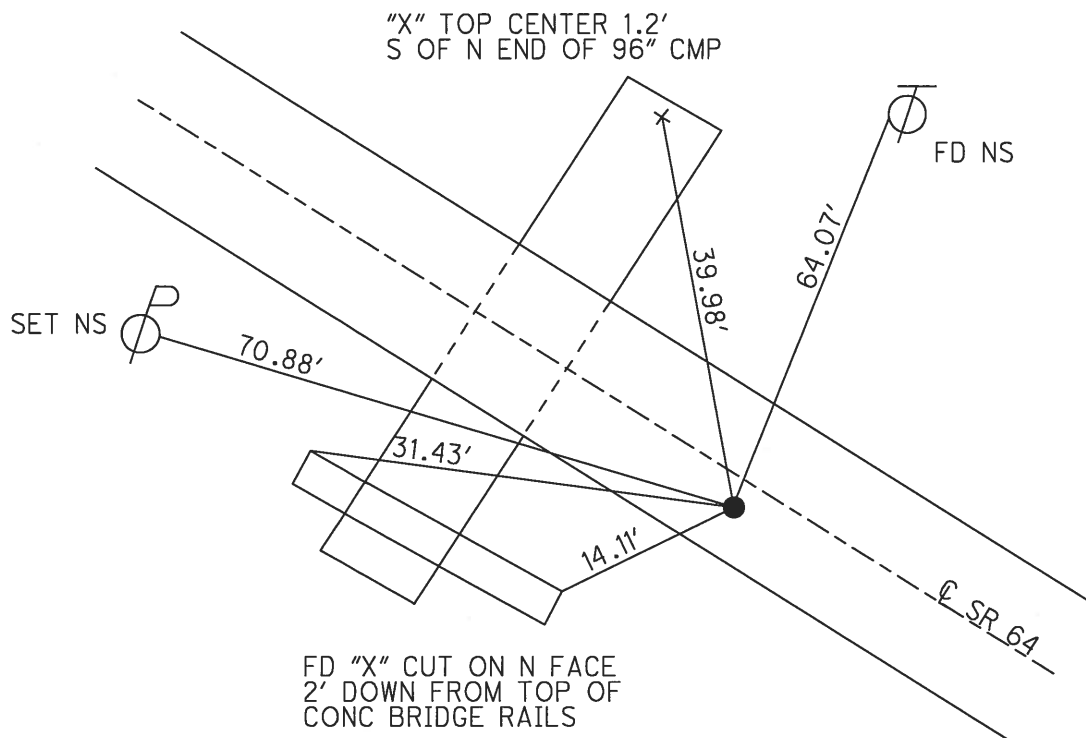


O.D.O.T. DISTRICT 2 SURVEY OFFICE (USE ONLY)


PERSONNEL _____ REFERENCE NO. 17 SHEET 4 OF 50
NOTES RHOADES DATE 4-20-18 ROUTE SR 64
H.C. O'DONNELL WEATHER SUNNY COUNTY LUCAS
R.C. SEAMAN TEMP. 40° TOWNSHIP WATERVILLE
SECTION 19
T 6 N R 10 E

TYPE MONUMENT MAG/WASHER
ON SURFACE - ~~BELOW~~ ON _____
LEFT - ~~C PAV'T~~ - ~~RIGHT~~ 2.0'
7.9' TO LT EDGE PAVEMENT
S.L.M. 140+80

Grid: Northing: 674228.7828 Easting: 1623051.8983

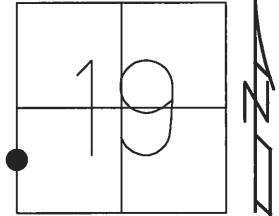

RECORD:
SET P.K.NAIL/WASHER
8-07-02, DCH
REF17
FND P.K./WASHER
1-15-16, JFO
SET MAG/WASHER
4-20-18, JFO

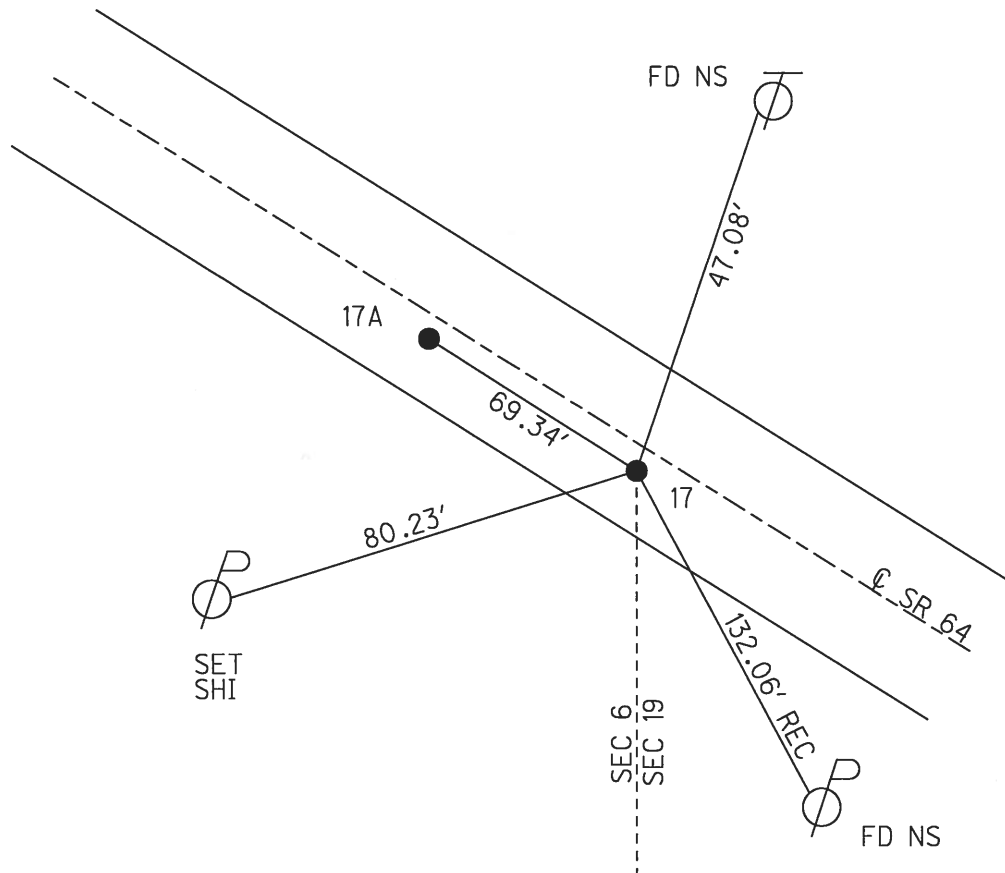


O.D.O.T. DISTRICT 2 SURVEY OFFICE (USE ONLY)


PERSONNEL	REFERENCE NO. <u>17 A</u>	SHEET <u>5</u> OF <u>50</u>
NOTES <u>RHOADES</u>	DATE <u>4-20-18</u>	ROUTE <u>SR 64</u>
H.C. <u>O'DONNELL</u>	WEATHER <u>SUNNY</u>	COUNTY <u>LUCAS</u>
R.C. <u>SEAMAN</u>	TEMP. <u>40°</u>	TOWNSHIP <u>WATERVILLE</u>
		SECTION <u>19</u>
		T <u>6</u> N R <u>10</u> E

TYPE MONUMENT MAG/WASHER
 ON SURFACE - ~~BELOW~~ ON
 LEFT - ~~C PAV'T~~ - ~~RIGHT~~ 2.0'
7.9' TO LT EDGE PAVEMENT
 S.L.M. 141+49.42

Grid: Northing: 674253.9252 Easting: 1622987.3045

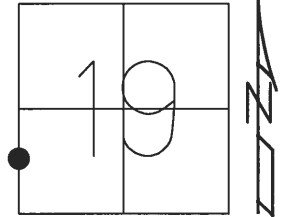

RECORD:
 P.I. $\Delta = 0^\circ 44' 15''$ LT
 SET P.K. NAIL/WASHER
 8-07-02, DCH
 REFA17
 FND P.K/WASHER
 1-15-16, JFO
 SET MAG/WASHER
 4-20-18, JFO

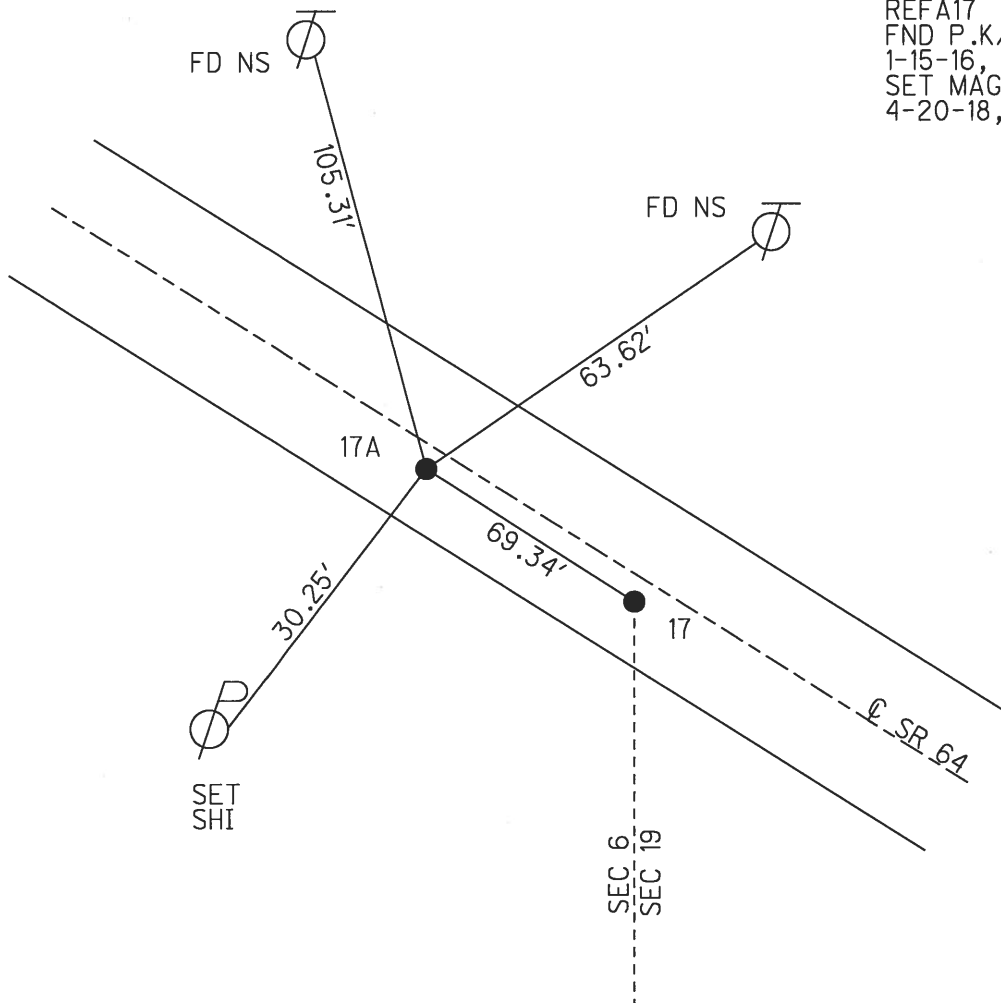

O.D.O.T. DISTRICT 2 SURVEY OFFICE (USE ONLY)

PERSONNEL

REFERENCE NO. 18

SHEET 6 OF 50

NOTES RHOADES

DATE 6-16-17

ROUTE SR 64

H.C. O'DONNELL

WEATHER FAIR

COUNTY LUCAS

R.C. CARSON

TEMP. 80°

TOWNSHIP WATERVILLE

POORE

SECTION 1

T_6_N R_9_E

TYPE MONUMENT SM.R.R.SPIKE


~~ON SURFACE - BELOW~~ 8"

~~LEFT~~ - C PAV'T - RIGHT 2.8'

12.8' TO RT EDGE PAVEMENT

S.L.M. $156+24.73$

Grid: Northing: 674770.3390 Easting: 1621605.3215

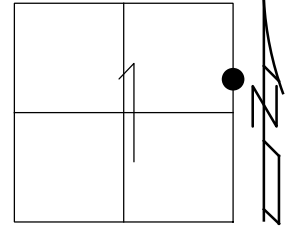

RECORD:

P.I. $\Delta = 0^{\circ} 08' 30''$ RT
SET MAG NAIL & WASHED

SET MAG NAIL & WASHER

12-11-02, DCH


FD RR.SPIKE 8" DOWN

REF18

1-15-16, JFO

SET MAG/WASHER

12-4-17, JFO

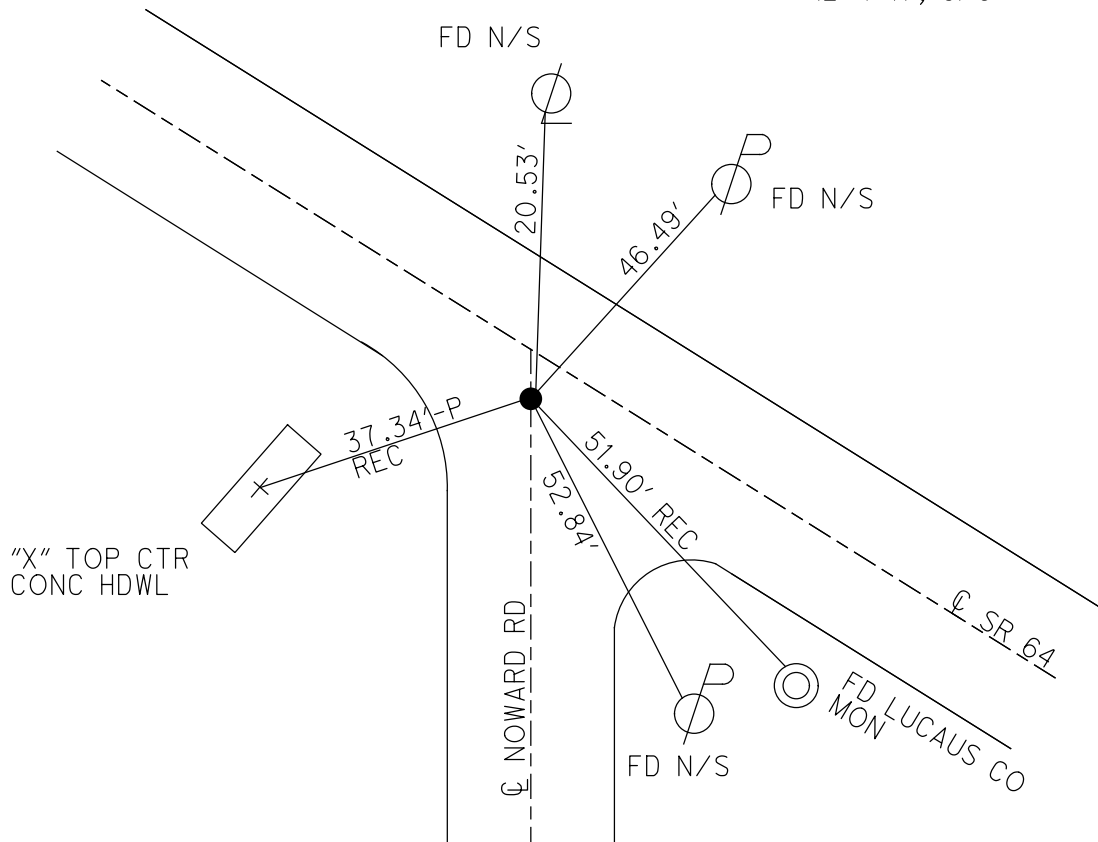

O.D.O.T. DISTRICT 2 SURVEY OFFICE (USE ONLY)

PERSONNEL

REFERENCE NO.

18 A

SHEET

7

OF 50

NOTES

RHAODES

DATE

6-16-17

ROUTE

SR 64

H.C.

O'DONNELL

WEATHER

FAIR

COUNTY

LUCAS

R.C.

CARSON

TEMP.

80°

TOWNSHIP

WATERVILLE

POORE

SECTION

1

T 6 N R 9 E

TYPE MONUMENT

MAG/WASHER

ON SURFACE - ~~BELOW~~

ON

LEFT - Q PAV'T - ~~RIGHT~~ 3'

11'


TO LT

EDGE PAVEMENT

S.L.M.

170+19

Grid: Northing: 675262.0605 Easting: 1620300.1165

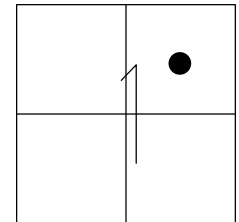

RECORD :

(7-20-1971)

POINT IS 1320'± N.W. OF SR 64 AND NOWARD RD.

IT IS MID-POINT OF THE N.E.

1/4 QUADRANT OF SECTION 1

FOUND R.R.SPIKE AT SURFACE

7-20-1971


SET MAG/WASHER

12-11-02, DCH

FD MAG/WASHER

REFA18


1-15-16, JFO

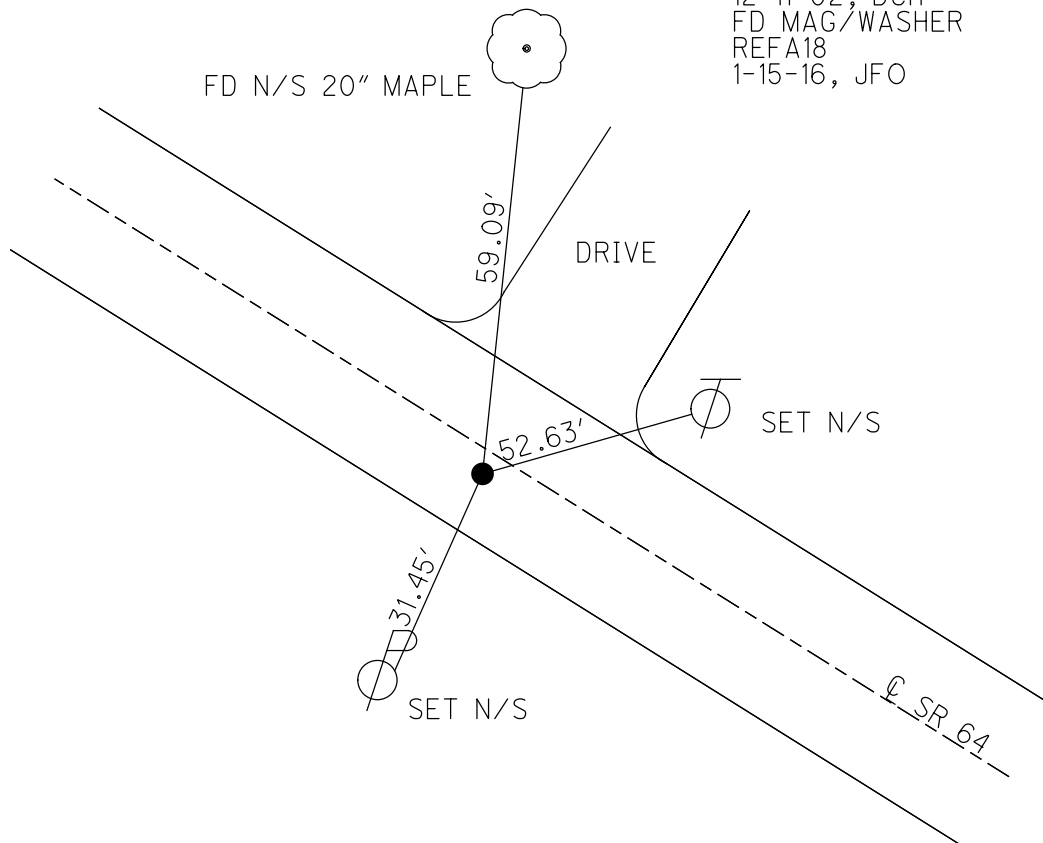


O.D.O.T. DISTRICT 2 SURVEY OFFICE (USE ONLY)

PERSONNEL _____ REFERENCE NO. 19 SHEET 8 OF 50
NOTES RHOADES DATE 6-16-17 ROUTE SR 64
H.C. O'DONNELL WEATHER FAIR COUNTY LUCAS
R.C. CARSON TEMP. 73° TOWNSHIP WATERVILLE
POORE SECTION 1
T 6 N R 9 E

TYPE MONUMENT MAG NAIL
ON SURFACE - ~~BELOW~~ ON
LEFT - C PAV'T - ~~RIGHT~~ 2.3'
7.8' TO LT EDGE PAVEMENT
S.L.M. 184+38
Grid: Northing: 675763.2075 Easting: 1618973.0304

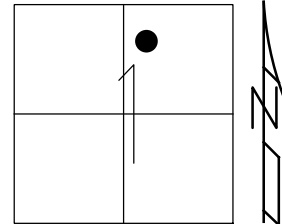

RECORD:
SET P.K.NAIL/WASHER
8-07-02, DCH
FD MAG REF19,
1-4-16
1-15-16, JFO
SET MAG/WASHER
12-4-17, JFO

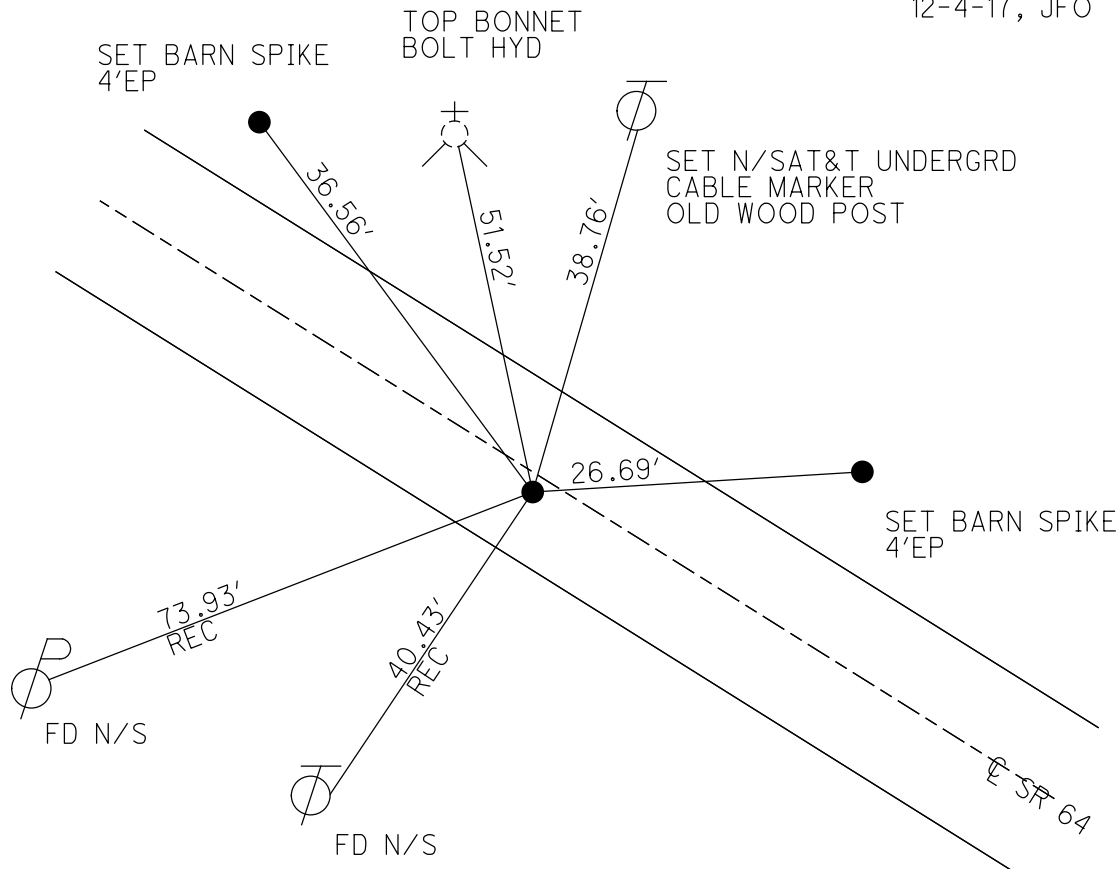

O.D.O.T. DISTRICT 2 SURVEY OFFICE (USE ONLY)

PERSONNEL

REFERENCE NO.

20

SHEET

9

OF 50

NOTES

RHOADES

DATE

5-21-15

ROUTE

SR 64

H.C.

O'DONNELL

WEATHER

CLOUDY

COUNTY

LUCAS

R.C.

RHOADES

TEMP.

60°F

TOWNSHIP

WATERVILLE

SECTION

1

T 6 N R 9 E

TYPE MONUMENT MAG/WASHER


ON SURFACE - ~~BELOW~~ ON

LEFT - CL PAV'T - ~~RIGHT~~ 2.8'

7.1' TO LT EDGE PAVEMENT

S.L.M. 190+67.64

Grid: Northing: 675984.3842 Easting: 1618383.5623

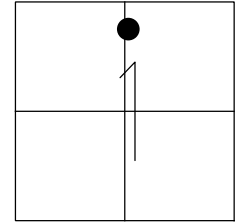

RECORD:

P.I. $\Delta=0^{\circ}08'30''$ RT

SET MAG/WASHER

12-12-02, DCH

FD MAG/WASHER


REF20

5-21-15, JFO

FD MONBOX

1-4-16, JFO

NOTE: NEW ROUND ABOUT CONSTRUCTED

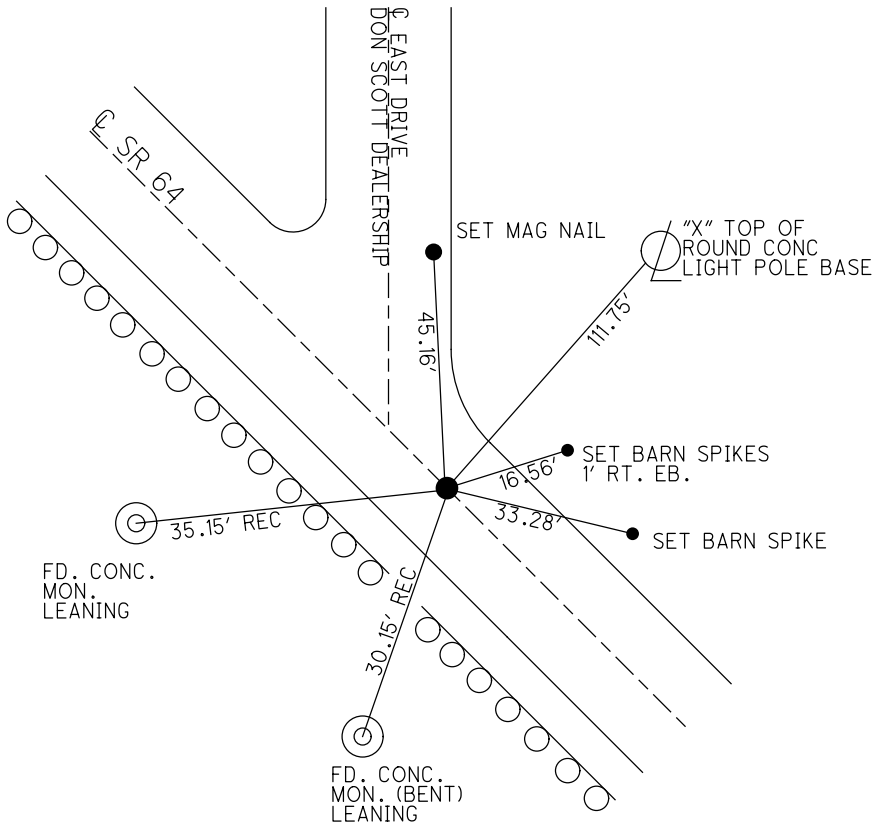

O.D.O.T. DISTRICT 2 SURVEY OFFICE (USE ONLY)

PERSONNEL

REFERENCE NO. 21

SHEET 10 OF 50

NOTES RHOADES

DATE 5-21-15

ROUTE SR 64

H.C. O'DONNELL

WEATHER CLOUDY

COUNTY LUCAS

R.C. RHOADES

TEMP. 60°F

TOWNSHIP WATERVILLE

SECTION 1

T 6 N R 9 E

TYPE MONUMENT MAG/WASHER


ON SURFACE - ~~BELOW~~ ON

LEFT - CL PAV'T - ~~RIGHT~~ 3.5'

6.5' TO LT EDGE PAVEMENT


S.L.M. 198+08.05

Grid: Northing: 676247.187 Easting: 1617691.3621

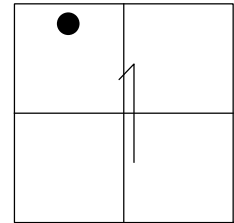

RECORD:
P.I. $\Delta=0^{\circ}20'$ RT
SET MAG/WASHER
12-12-02, DCH
FD MAG/WASHER
GPS, REF21
5-21-15, JMR

NOTE: NEW ROUND ABOUT CONSTRUCTED

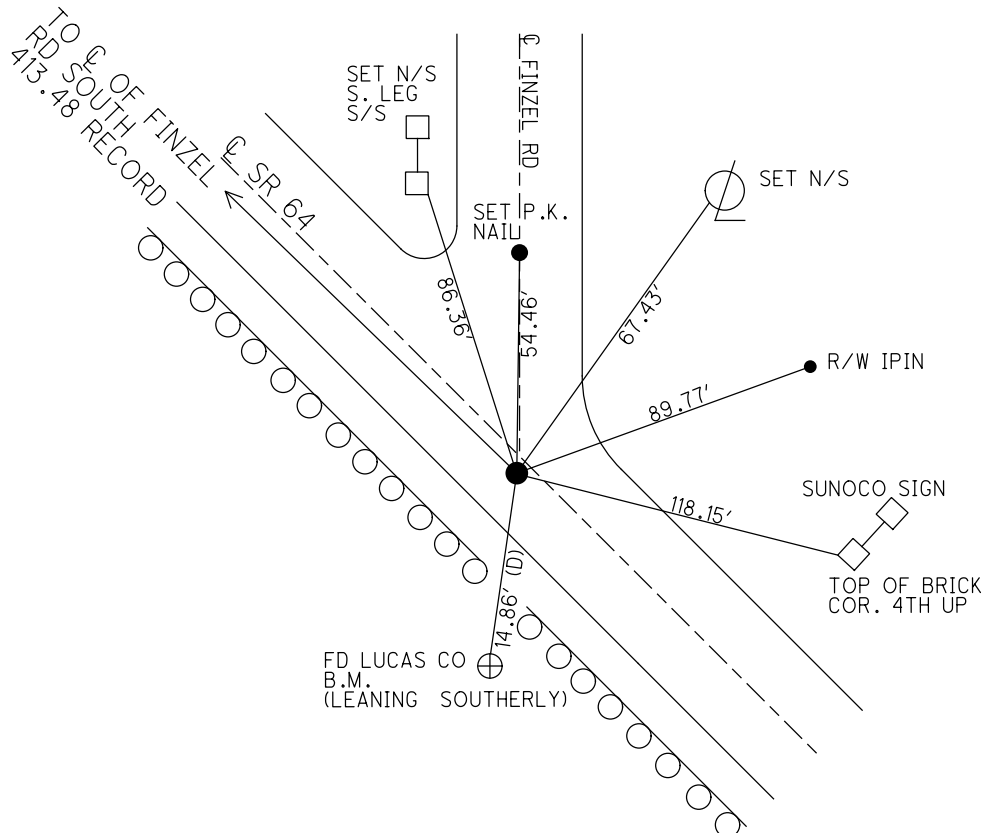


O.D.O.T. DISTRICT 2 SURVEY OFFICE (USE ONLY)

PERSONNEL	REFERENCE NO.	22	SHEET	11	OF	50
NOTES	RHOADES	DATE	5-21-15	ROUTE	SR 64	
H.C.	O'DONNELL	WEATHER	CLOUDY	COUNTY	LUCAS	
R.C.	RHOADES	TEMP.	60°F	TOWNSHIP	WATERVILLE	
				SECTION	1	
				T	6	N
				R	9	E


TYPE MONUMENT MAG/WASHER
ON SURFACE - ~~BELOW~~ ON
LEFT - CL PAV'T - ~~RIGHT~~ 6.7'
---- TO ---- EDGE PAVEMENT
S.L.M. 203+25

Grid: Northing: 676392.5957 Easting: 1617304.4401

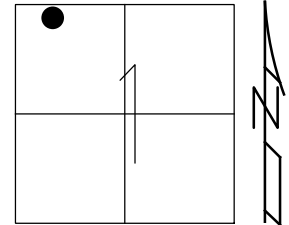

RECORD:
P.O.T.
SET MAG/WASHER
12-12-02, DCH
FD MAG/WASHER
REF22
5-21-15, JFO

NOTE: NEW ROUND ABOUT CONSTRUCTED
DIST. REF22 TO REFA22 = 5.75'

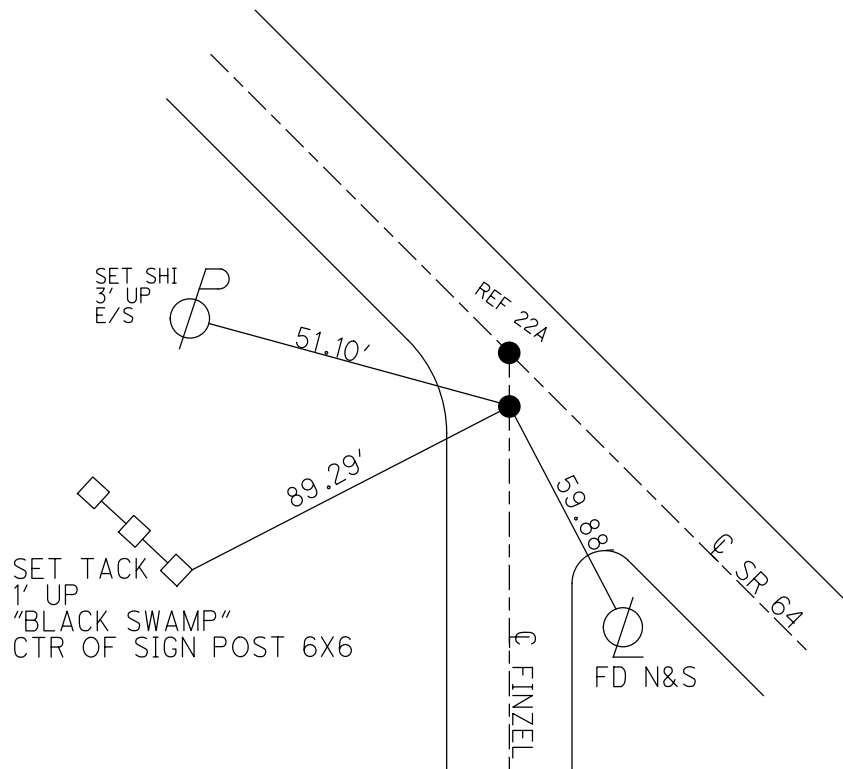


O.D.O.T. DISTRICT 2 SURVEY OFFICE (USE ONLY)

PERSONNEL _____ REFERENCE NO. 22 A SHEET 12 OF 50
NOTES RHOADES DATE 5-21-15 ROUTE SR 64
H.C. O'DONNELL WEATHER CLOUDY COUNTY LUCAS
R.C. RHOADES TEMP. 60°F TOWNSHIP WATERVILLE
SECTION 1
T 6 N R 9 E


TYPE MONUMENT MAG/WASHER
ON SURFACE - ~~BELOW~~ ON
LEFT - ℄ PAV'T - RIGHT ON
_____ TO _____ EDGE PAVEMENT
S.L.M. 203+25

Grid: Northing: 676398.2975 Easting: 1617304.9617

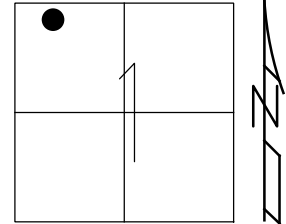

RECORD:
SET BY OTHERS
SET MAG/WASHER
12-12-02, DCH
FD MAG/WASHER
REFA22
5-21-15, JFO


NOTE: NEW ROUND ABOUT CONSTRUCTED
DIST. REF22 TO REFA22 = 5.75'

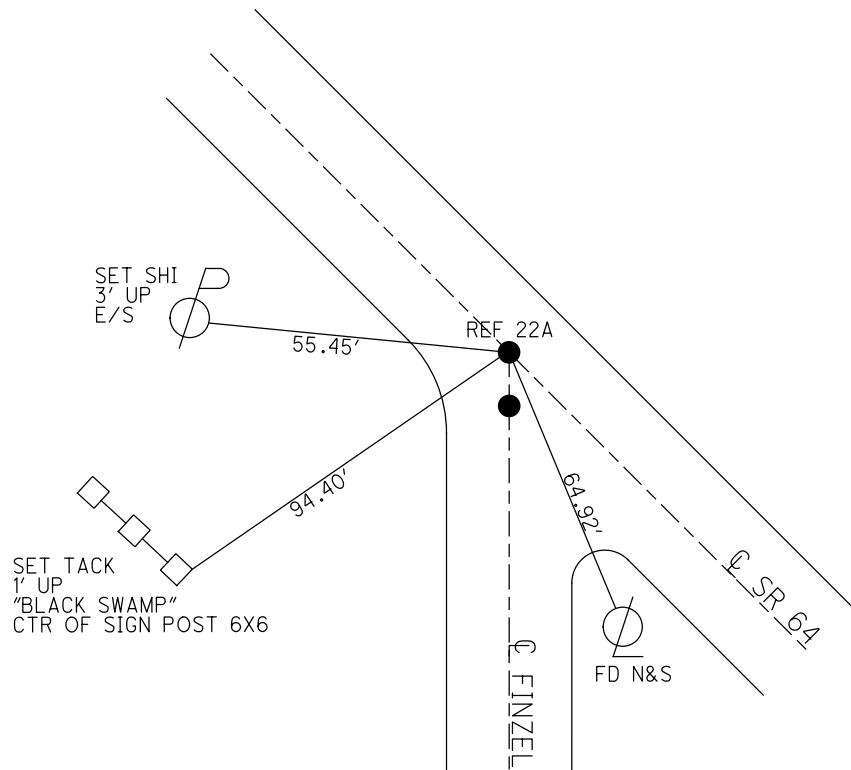

O.D.O.T. DISTRICT 2 SURVEY OFFICE (USE ONLY)


PERSONNEL	REFERENCE NO. <u>23</u>	SHEET <u>13</u> OF <u>50</u>	
NOTES	RHOADES	DATE	4-20-18
H.C.	O'DONNELL	WEATHER	SUNNY
R.C.	SEAMAN	TEMP.	42°
		ROUTE	SR 64
		COUNTY	LUCAS
		TOWNSHIP	WATERVILLE
		SECTION	1
		T <u>6</u> N	R <u>9</u> E

TYPE MONUMENT 1/2" IPIN BENT W.ERLY
~~ON SURFACE~~ - BELOW 1"
~~LEFT - C~~ PAV'T - RIGHT 29.5'
18.4' TO RT EDGE PAVEMENT
 S.L.M. 209+65
 Grid: Northing: 676664.3035 Easting: 1616612.0161

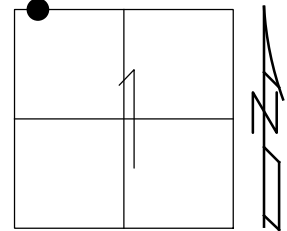

RECORD:
 P.I.
 DID NOT RESET
 THIS IS ALL RECORD
 INFORMATION
 SAME FOR
 5-21-02
 OUT OF PROJECT
 5-21-15
 FD 1/2" IPIN
 1-5-16, JFO
 REF 23
 1-15-16, JFO

DIST REF23 TO REF24= 236.13'

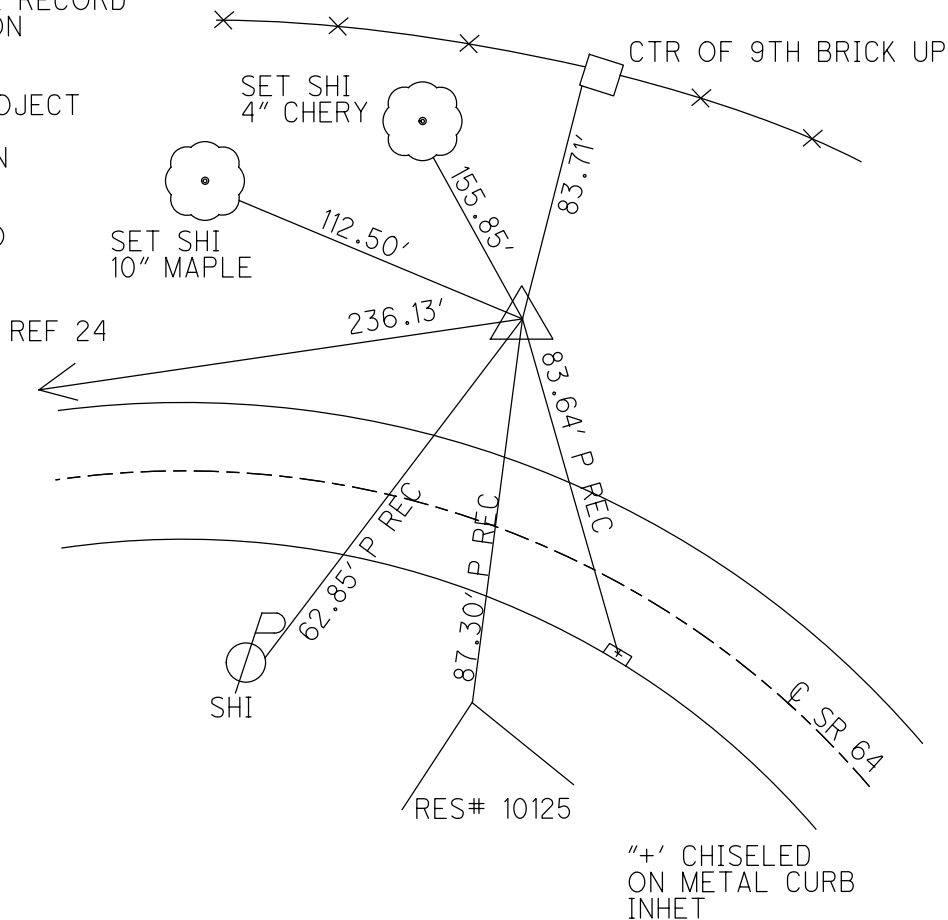

O.D.O.T. DISTRICT 2 SURVEY OFFICE (USE ONLY)

PERSONNEL

REFERENCE NO. 23 A

SHEET 14 OF 50


NOTES RHOADES
H.C. O'DONNELL
R.C. CARSON
POORE

DATE 6-16-17
WEATHER FAIR
TEMP. 73°


ROUTE SR 64
COUNTY LUCAS
TOWNSHIP WATERVILLE
SECTION 11
T 6 N R 9 E

TYPE MONUMENT MAG/WASHER
ON SURFACE - ~~BELOW~~ ON
LEFT - CL PAV'T - ~~RIGHT~~ 1'
TO EDGE PAVEMENT
S.L.M. 212+61

Grid: Northing: 676665.0061 Easting: 1616349.5644

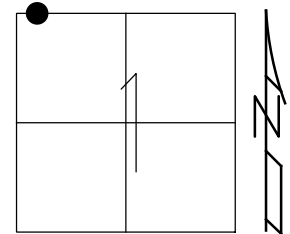

RECORD:
SET MAG/WASHER
12-12-02, DCH
SET MAG/WASHER
12-4-17

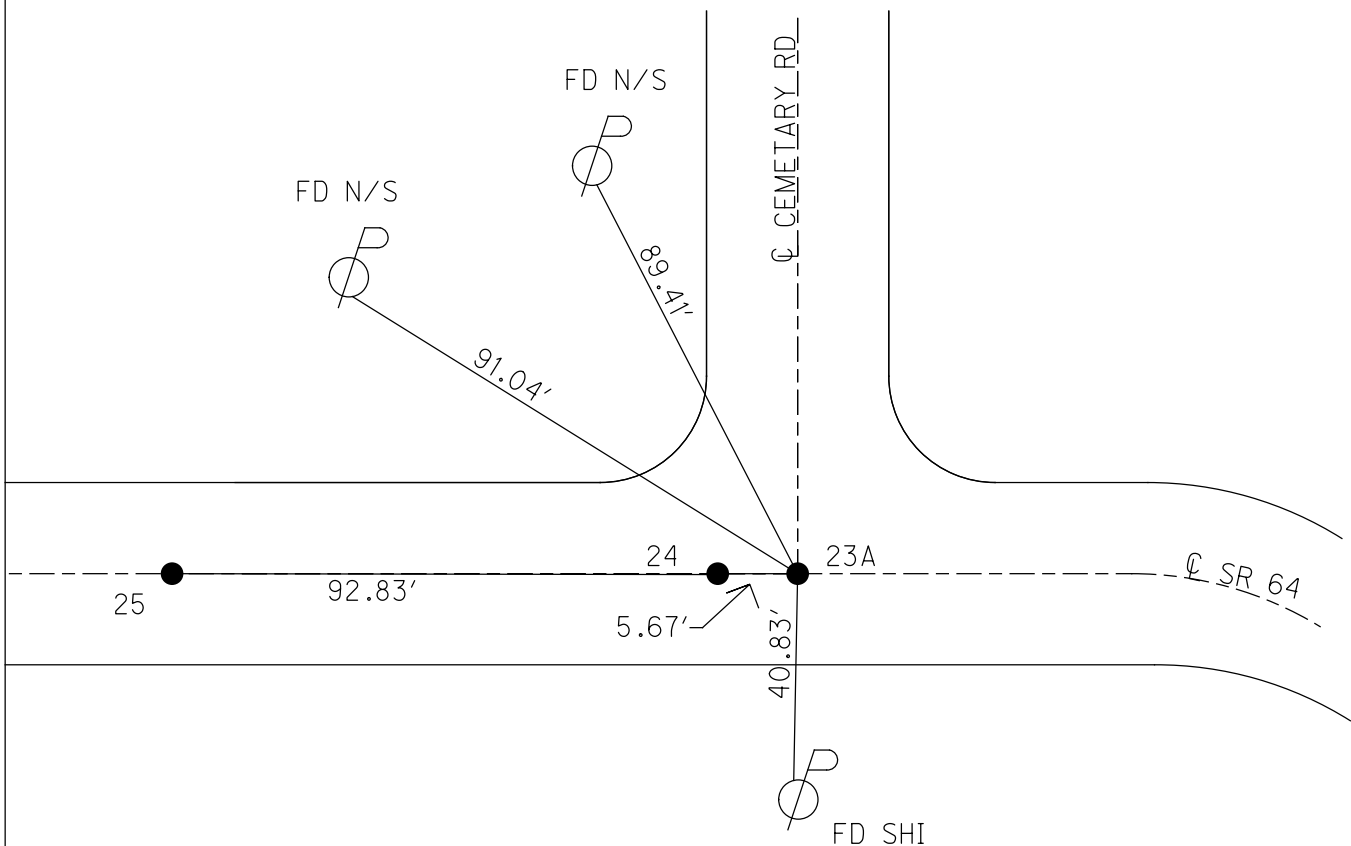

O.D.O.T. DISTRICT 2 SURVEY OFFICE (USE ONLY)

PERSONNEL

REFERENCE NO. 24

SHEET 15 OF 50


NOTES RHOADES
H.C. O'DONNELL
R.C. CARSON
POORE

DATE 6-16-17
WEATHER FAIR
TEMP. 73°


ROUTE SR 64
COUNTY LUCAS
TOWNSHIP WATERVILLE
SECTION 1
T 6 N R 9 E

TYPE MONUMENT MAG/WASHER
ON SURFACE - ~~BELOW~~ ON
LEFT - ℄ PAV'T - ~~RIGHT~~ 0.2'
TO EDGE PAVEMENT
S.L.M. 212+33

Grid: Northing: 676665.15 Easting: 1616343.8609

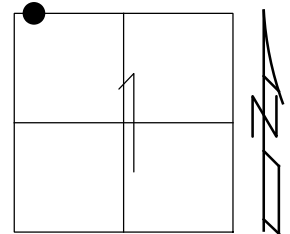

RECORD:
SET MAG/WASHER
12-12-02, DCH
FD MAG/WASHER
REF24
1-5-16, JFO
SET MAG/WASHER
12-4-17

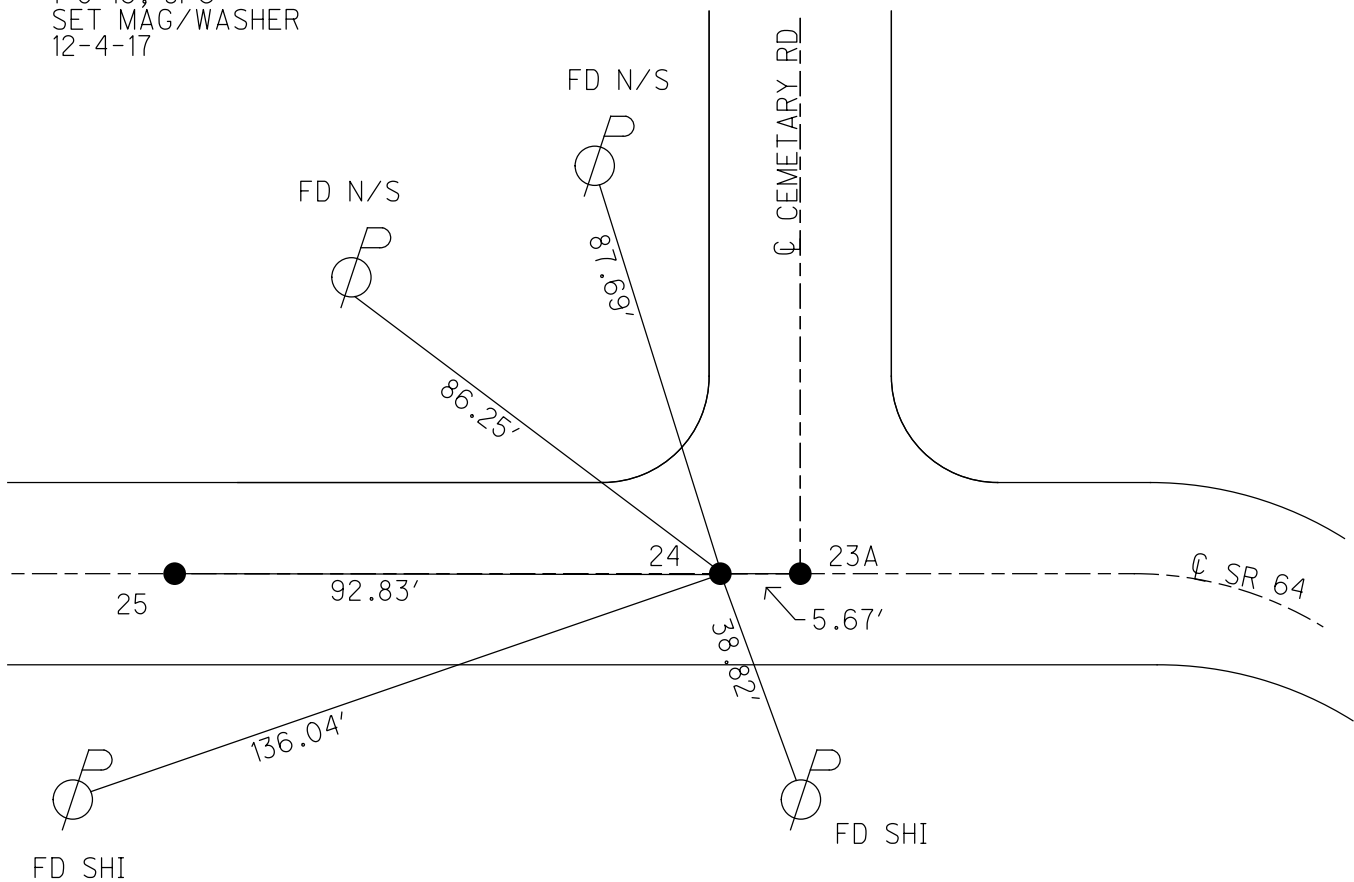

O.D.O.T. DISTRICT 2 SURVEY OFFICE (USE ONLY)

PERSONNEL

REFERENCE NO.

25

SHEET 16 OF 50

OF 50

NOTES RHOADES

DATE 6-16-17

6-16-17

ROUTE SR 64

SR 64

H.C. _____ O'DONNELL

WEATHER FAIR

FAIR

COUNTY LUCAS

LUCAS

R.C. CARSON

TEMP. _____

73°

TOWNSHIP WATERVILLEWATERVILLE

POORE

POORE

SECTION 1

1

T_6_N R_9_E

R.

R_9_E

TYPE MONUMENT MAG/WASHER

ON SURFACE - ~~BELOW~~ ON

LEFT - C PAV'T - RIGHT_2'

8.2' TO LT EDGE PAVEMENT

S.L.M. 213+26.16

Grid: Northing: 676665.4776 Easting: 1616251.0545

676665.4776

Fasting:

1616251.0545

RECORD:

SET MAG/WASHER

12-12-02, DCH


FD MAG WASHER

REF 25

1-5-16, JFO

SET MAG/WASHER

12-4-17

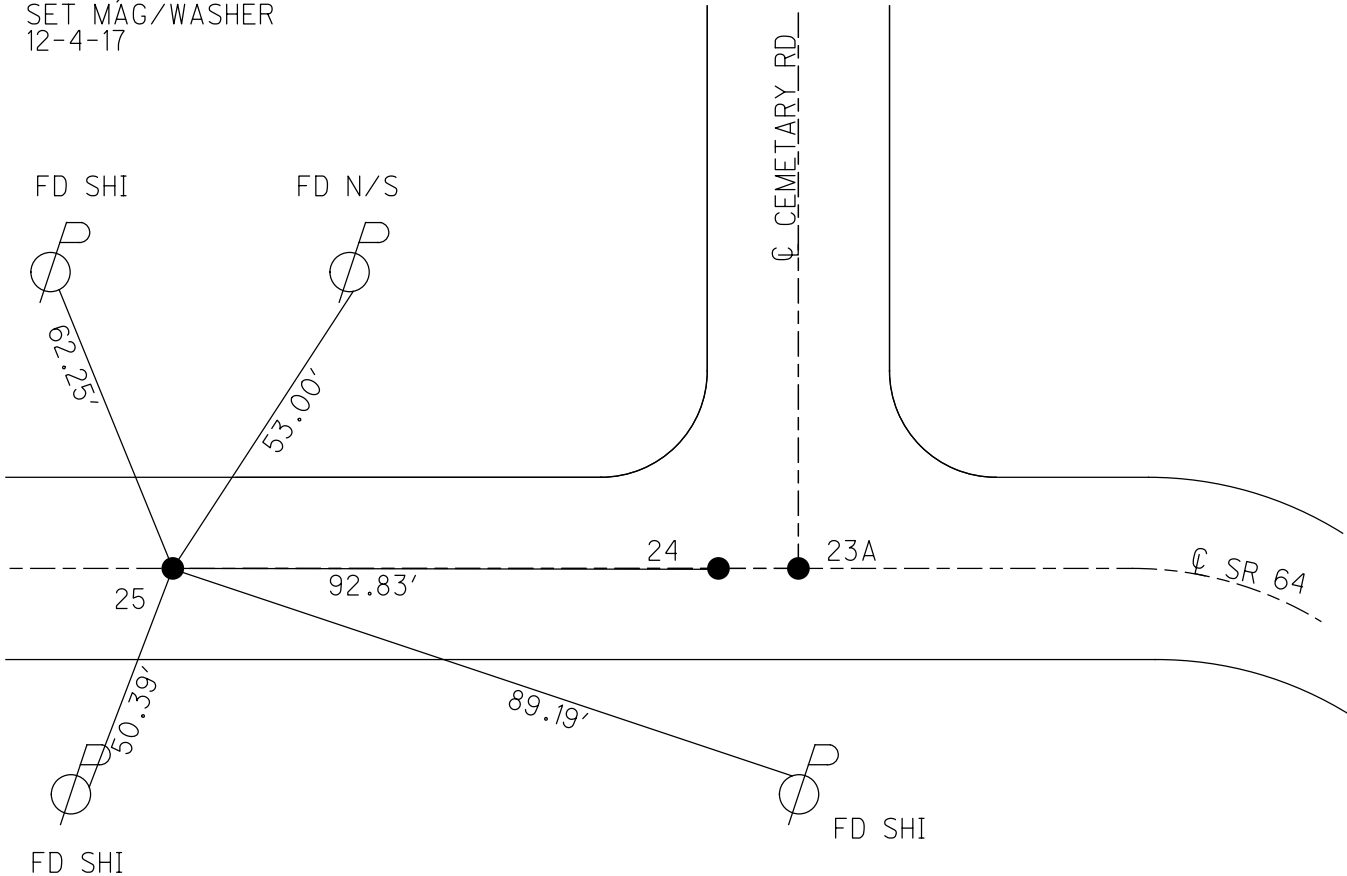

O.D.O.T. DISTRICT 2 SURVEY OFFICE (USE ONLY)

PERSONNEL

REFERENCE NO. 26


SHEET 17 OF 50

NOTES RHOADES
H.C. O'DONNELL
R.C. CARSON
POORE


DATE 6-16-17
WEATHER FAIR
TEMP. 73°

ROUTE SR 64
COUNTY LUCAS
TOWNSHIP WATERVILLE
SECTION 1
T 6 N R 9 E

TYPE MONUMENT MAG/WASHER
ON SURFACE - ~~BELOW~~ ON
LEFT - ℄ PAV'T - ~~RIGHT~~ 1.8'
8.3 TO LT EDGE PAVEMENT
S.L.M. 218+85
Grid: Northing: 676666.9919 Easting: 1615692.2494

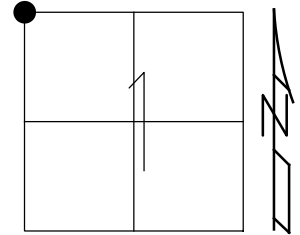

RECORD:
SET MAG/WASHER
12-12-02, DCH
FD MAG/WASHER
REF26
1-12-16, JFO
SET MAG/WASHER
12-4-17, JFO

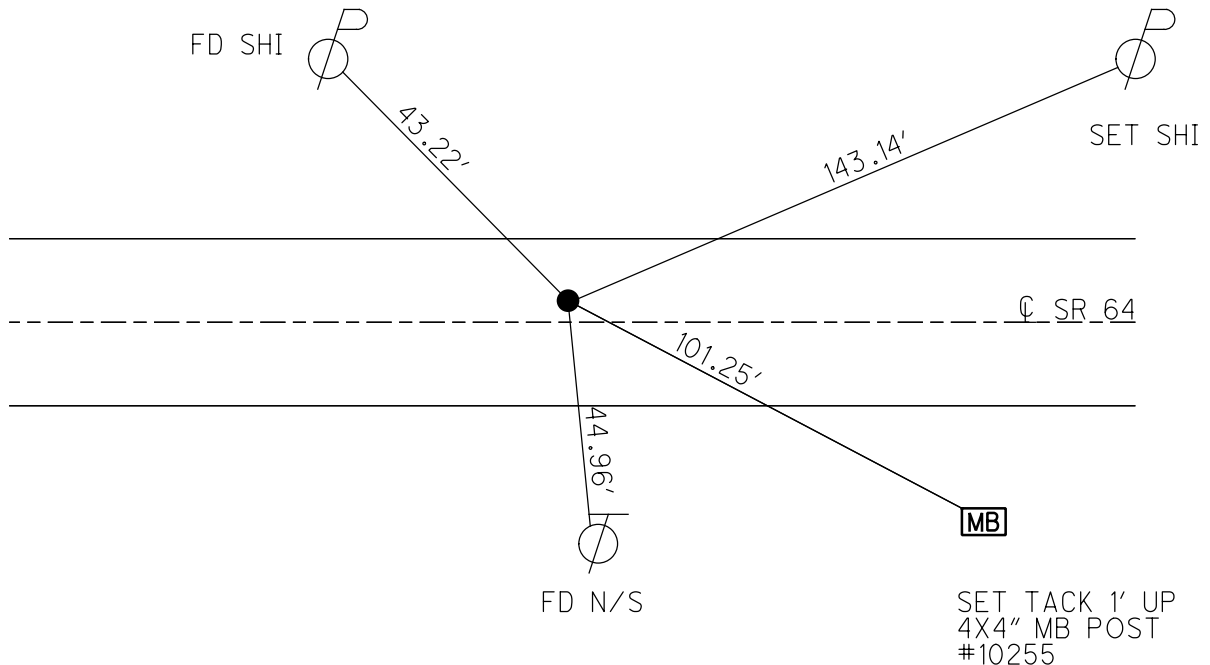

O.D.O.T. DISTRICT 2 SURVEY OFFICE (USE ONLY)

PERSONNEL

REFERENCE NO. 27

SHEET 18 OF 50

NOTES RHOADES
H.C. O'DONNELL
R.C. CARSON
POORE

DATE 6-16-17
WEATHER FAIR
TEMP. 73°

ROUTE SR 64
COUNTY LUCAS
TOWNSHIP WATERVILLE
SECTION 2
T 7 N R 9 E

TYPE MONUMENT MAG/WASHER


ON SURFACE - ~~BELOW~~ ON

~~LEFT~~ - CL PAV'T - RIGHT 2.8'


8.3 TO RT EDGE PAVEMENT

S.L.M. 238+81.08

Grid: Northing: 676667.6959 Easting: 1613696.1326

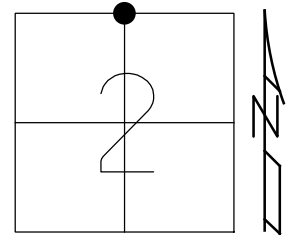

RECORD:
Δ=0-01' RT
FD 1" IPIN IN CONC
SET MAG/WASHER
12-12-02, DCH
FD MAG/WASHER
REF27
1-15-16, JFO
SET MAG/WASHER
12-4-17, JFO

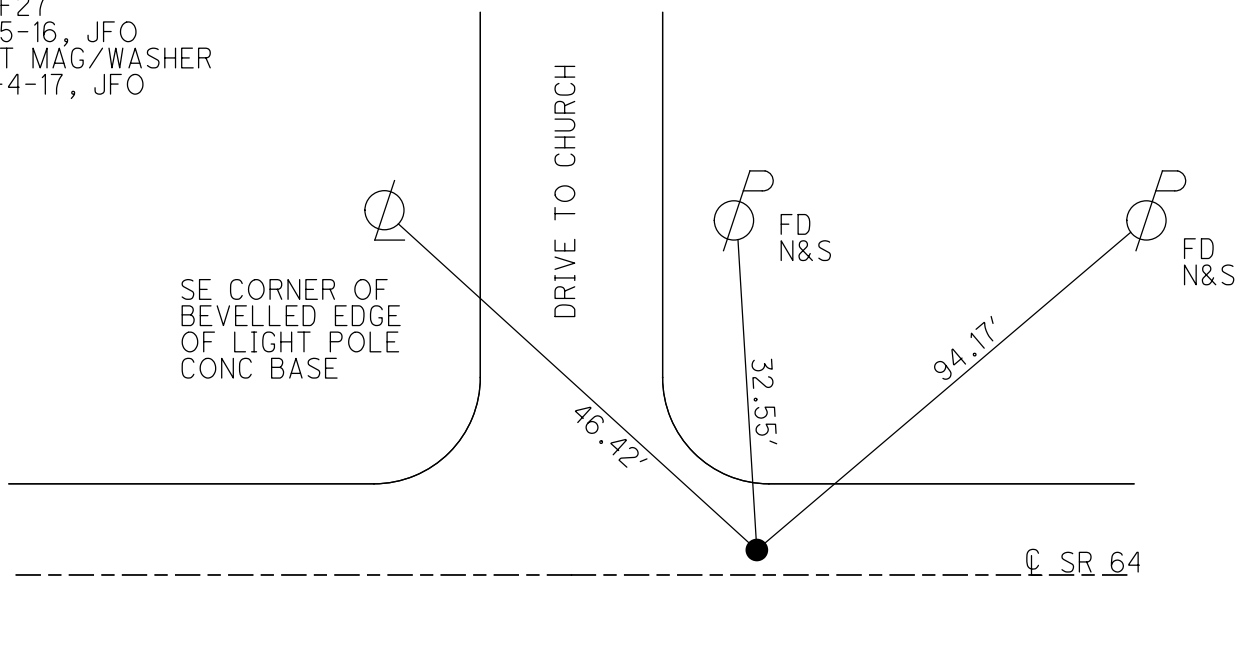

O.D.O.T. DISTRICT 2 SURVEY OFFICE (USE ONLY)

PERSONNEL

REFERENCE NO. 28

SHEET 19 OF 50

NOTES RHOADES
H.C. O'DONNELL
R.C. CARSON
POORE

DATE 6-16-17
WEATHER FAIR
TEMP. 73°

ROUTE SR 64
COUNTY LUCAS
TOWNSHIP WATERVILLE
SECTION 2
T 7 N R 9 E

TYPE MONUMENT MAG NAIL


ON SURFACE - BELOW ON

~~LEFT~~ - ℄ PAV'T - RIGHT 4.4'

13.8' TO RT EDGE PAVEMENT

S.L.M. 245+79

Grid: Northing: 676668.3063 Easting: 1612998.6588

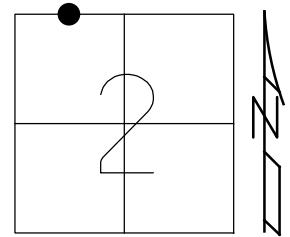

RECORD:

OLD DUG POINT EXPOSED

12-12-02, DCH

PATCHED HOLE

SET MAG/WASHER

7-18-03, DCH


FD MAG/WASHER

REF28

1-15-16, JFO

SET MAG/WASHER

12-4-17, JFO

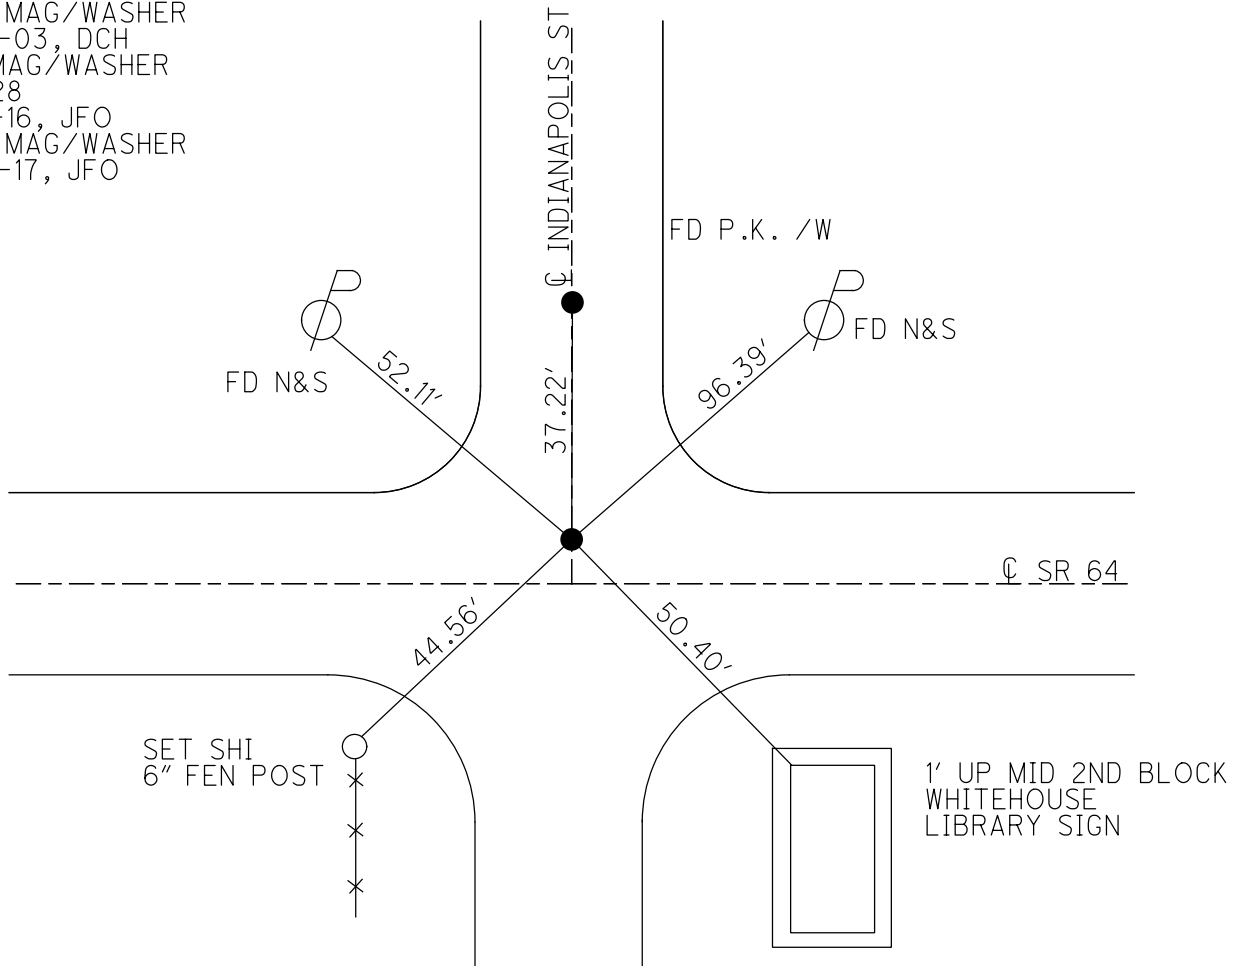

O.D.O.T. DISTRICT 2 SURVEY OFFICE (USE ONLY)

PERSONNEL

REFERENCE NO.

28A

SHEET

20

OF 50

NOTES

RHOADES

DATE

6-16-17

ROUTE

SR 64

H.C.

POORE

WEATHER

FAIR

COUNTY

LUCAS

R.C.

CARSON

TEMP.

73°

TOWNSHIP

WATERVILLE

O'DONNELL

SECTION

2

T 7 N R 9 E

TYPE MONUMENT

MAG/WASHER

ON SURFACE - ~~BELOW~~

ON

~~LEFT~~ - CL PAV'T - RIGHT

2'

10' TO LT EDGE PAVEMENT

S.L.M.


253+46

Grid: Northing:

676670.2168

Easting:

1612231.1410

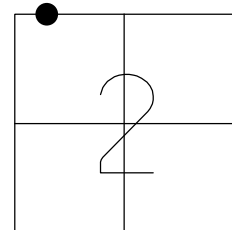

RECORD:

SET MAG/WASHER

12-12-02, DCH


FD MAG/WASHER

REF28

1-15-16, JFO

SET MAG/WASHER

12-4-17, JFO

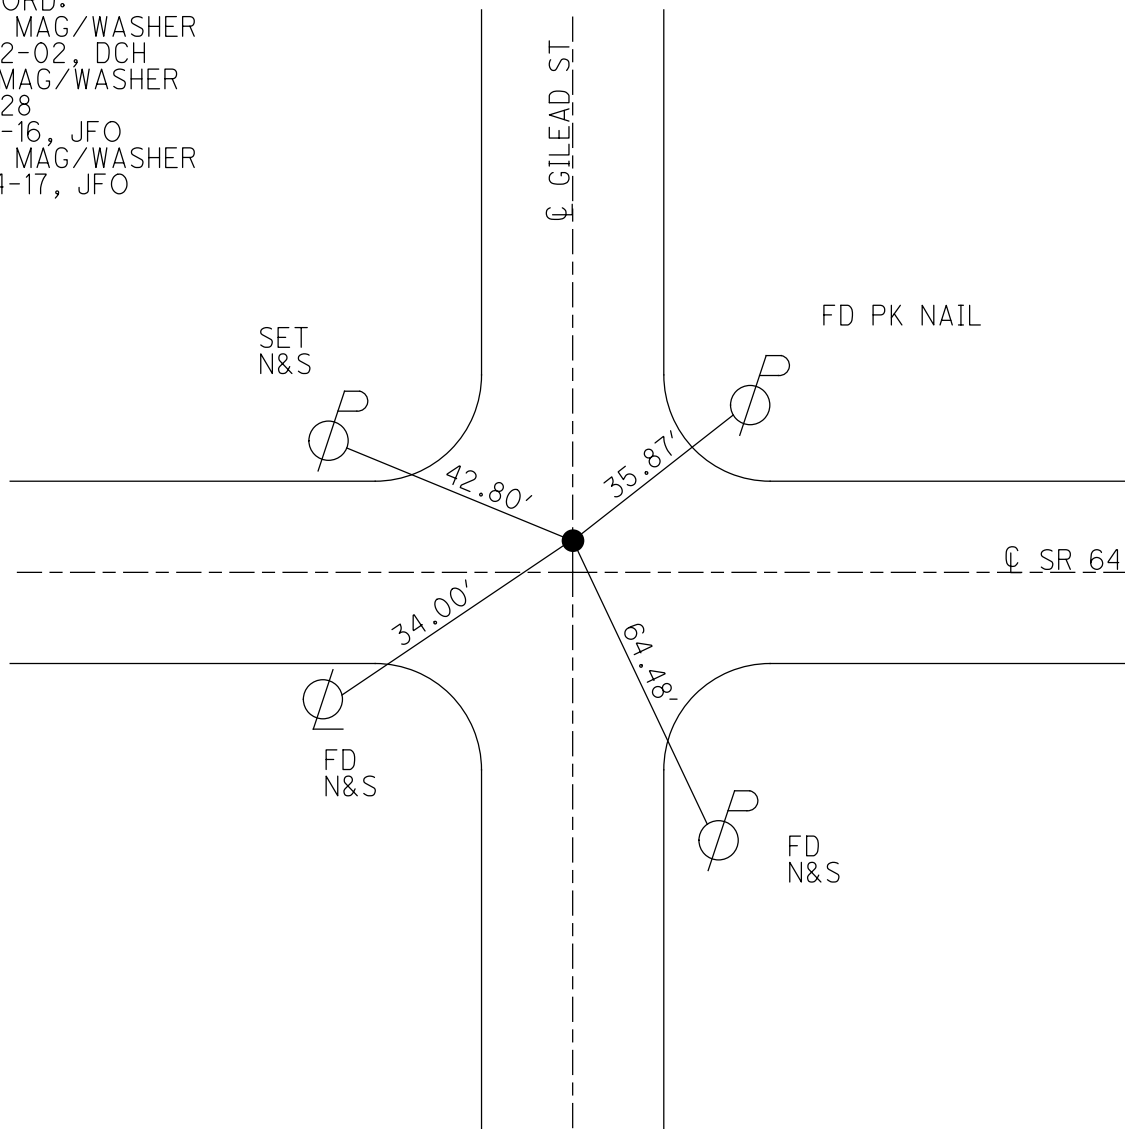

O.D.O.T. DISTRICT 2 SURVEY OFFICE (USE ONLY)

PERSONNEL

REFERENCE NO. 29

SHEET 21 OF 50



NOTES RHOADES
H.C. POORE
R.C. CARSON
O'DONNELL

DATE 6-6-17
WEATHER FAIR
TEMP. 69°

ROUTE SR 64
COUNTY LUCAS
TOWNSHIP WATERVILLE
SECTION 2
T 7 N R 9 E

TYPE MONUMENT MAG/WASHER
ON SURFACE - ~~BELOW~~ ON
~~LEFT - C~~ PAV'T - ~~RIGHT~~ ON
TO EDGE PAVEMENT
S.L.M. 258+64.82

Grid: Northing: 676671.5226 Easting: 1611712.3954

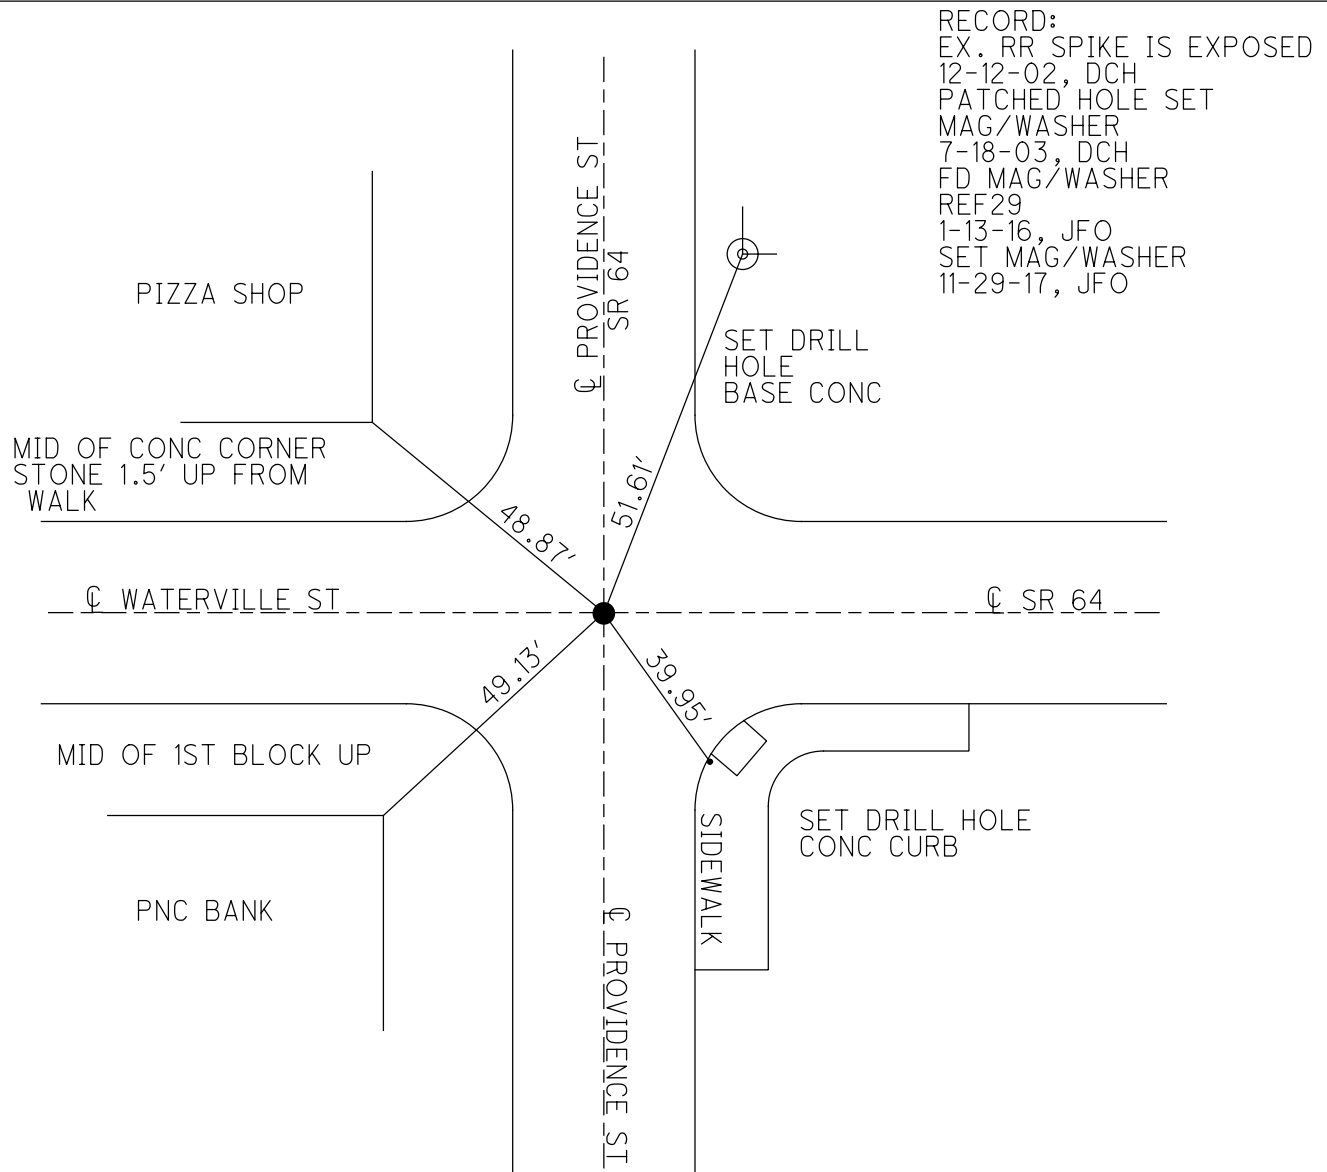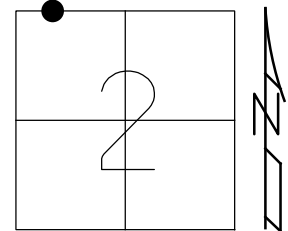

O.D.O.T. DISTRICT 2 SURVEY OFFICE (USE ONLY)

PERSONNEL

REFERENCE NO.

30

SHEET

22

OF 50

NOTES

RHOADES

DATE

6-16-17

ROUTE

SR 64

H.C.

POORE

WEATHER

FAIR

COUNTY

LUCAS

R.C.

CARSON

TEMP.

69°

TOWNSHIP

WATERVILLE

O'DONNELL

SECTION

35

T 7 N R 9 E

TYPE MONUMENT

MAG/WASHER

ON SURFACE - ~~BELOW~~



ON

~~LEFT~~ - CL PAV'T - ~~RIGHT~~ ON

24' TO RT EDGE PAVEMENT

S.L.M. 262+10

Grid: Northing: 677016.5522 Easting: 1611713.2728

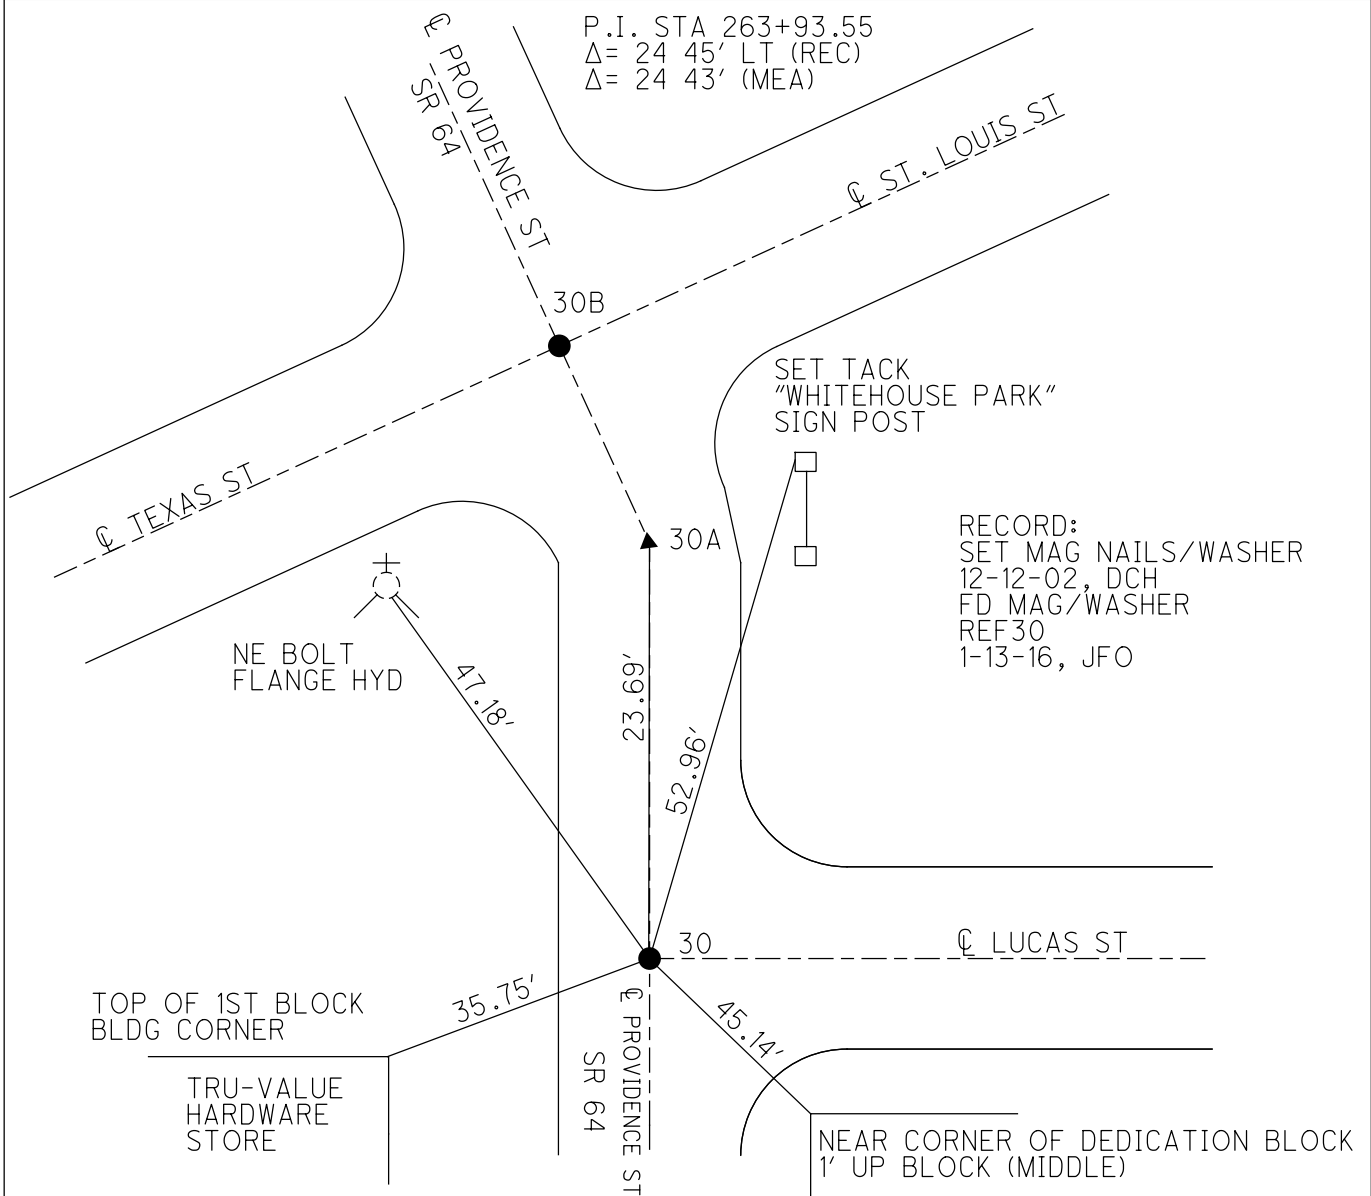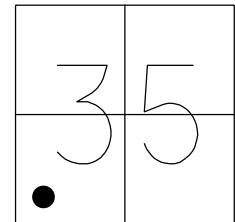

O.D.O.T. DISTRICT 2 SURVEY OFFICE (USE ONLY)

PERSONNEL

REFERENCE NO.

30 A

SHEET

23

OF

56

NOTES RHOADES

DATE 6-16-17

ROUTE SR 64

H.C. POORE

WEATHER FAIR

COUNTY LUCAS

R.C. CARSON

TEMP. 69°

TOWNSHIP WATERVILLE

O'DONNELL

SECTION 35

T 7 N R 9 E

TYPE MONUMENT MAG/WASHER



ON SURFACE - ~~BELOW~~ ON

~~LEFT~~ - ℄ PAV'T - ~~RIGHT~~ ON

TO EDGE PAVEMENT

S.L.M. 262+33.53

Grid: Northing: 677040.2334 Easting: 1611713.3420

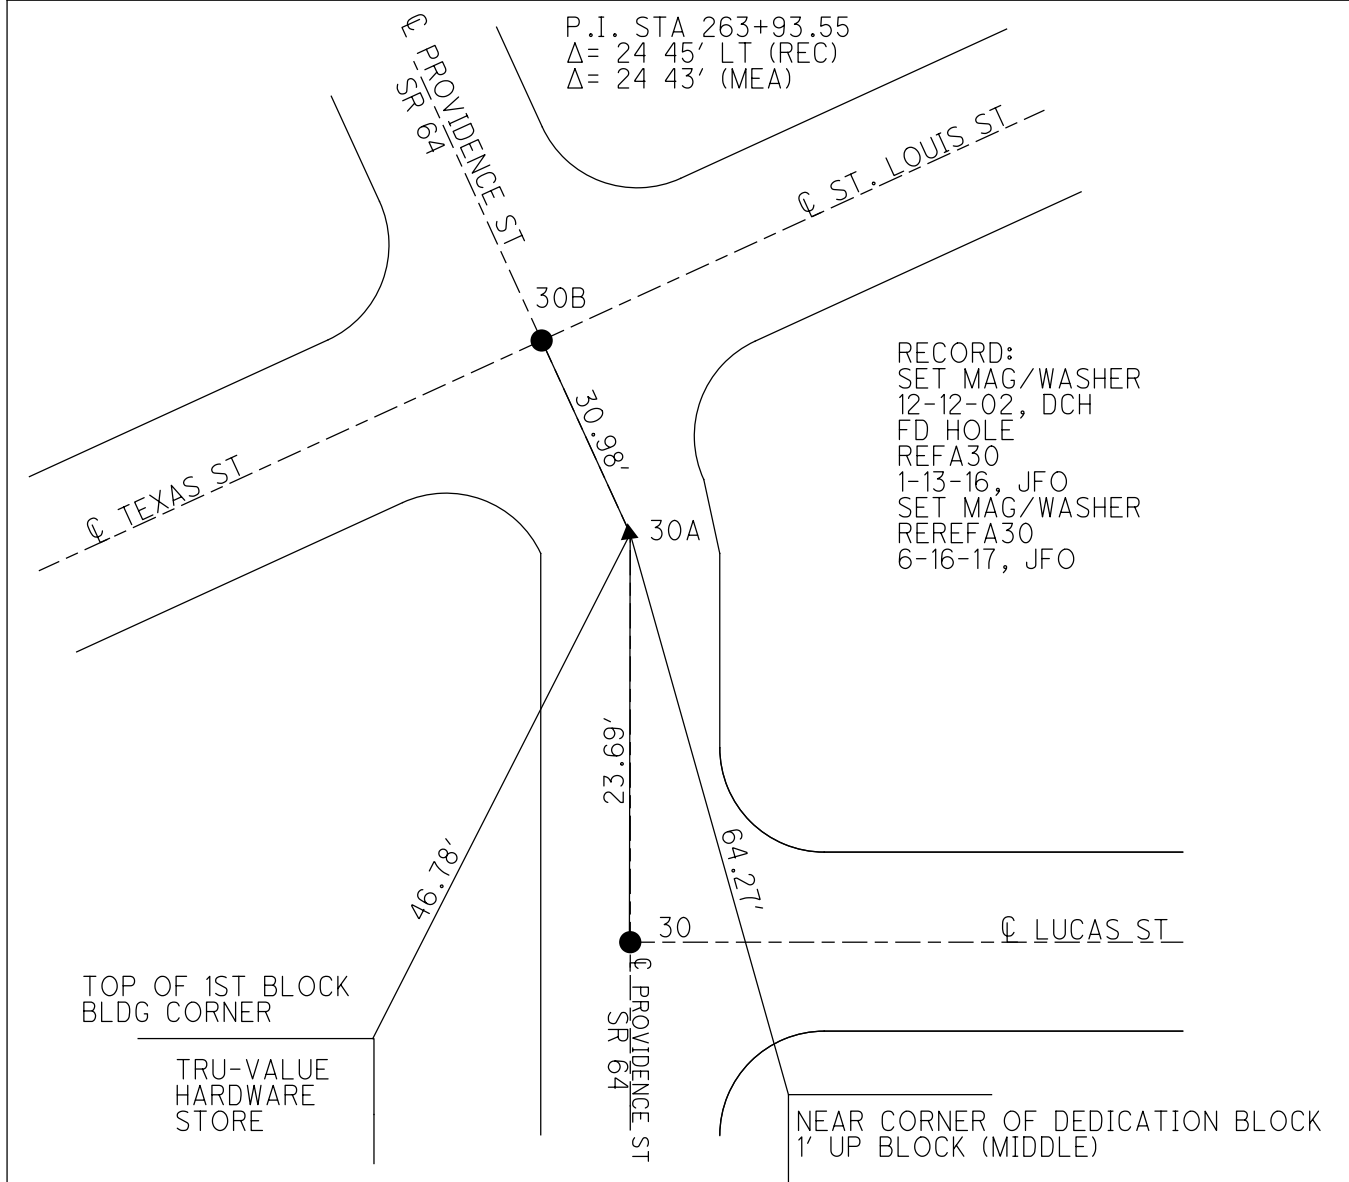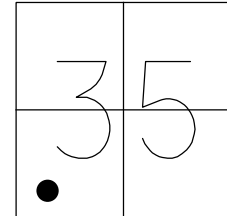

O.D.O.T. DISTRICT 2 SURVEY OFFICE (USE ONLY)

PERSONNEL

REFERENCE NO.

30 B

SHEET

24

OF 50

NOTES

RHOADES

DATE

6-16-17

ROUTE

SR 64

H.C.

POORE

WEATHER

FAIR

COUNTY

LUCAS

R.C.

CARSON

TEMP.

69°

TOWNSHIP

WATERVILLE

O'DONNELL

SECTION

35

T 7 N R 9 E

TYPE MONUMENT MAG/WASHER


ON SURFACE - ~~BELOW~~ ON

~~LEFT~~ - C PAV'T - ~~RIGHT~~ ON

TO EDGE PAVEMENT

S.L.M. 262+65

Grid: Northing: 677068.4603 Easting: 1611700.4687

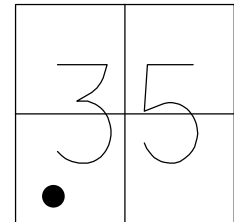

RECORD:
SET MAG/WASHER
12-12-02, DCH
FD MAG/WASHER
REFB30
1-13-16, JFO

PROVIDENCE ST

P.I. STA 263+93.55
 $\Delta = 24\ 45'$ LT (REC)
 $\Delta = 24\ 43'$ (MEA)

ST. LOUIS ST

30B

SET TACK
"WHITEHOUSE PARK"
SIGN POST

TEXAS ST

NE BOLT
FLANGE HYD

63.15'

TOP OF 1ST BLOCK
BLDG CORNER

TRU-VALUE
HARDWARE
STORE

30

PROVIDENCE ST
SR 64

LUCAS ST

NEAR CORNER OF DEDICATION BLOCK
1' UP BLOCK (MIDDLE)

O.D.O.T. DISTRICT 2 SURVEY OFFICE (USE ONLY)

PERSONNEL

REFERENCE NO.

31

SHEET

25

OF 50

NOTES RHOADES

DATE 6-15-17

ROUTE SR 64

H.C. POORE

WEATHER CLOUDY

COUNTY LUCAS

R.C. O'DONNELL

TEMP. 78°

TOWNSHIP WATERVILLE

SECTION 35

T 7 N R 9 E

TYPE MONUMENT MAG/WASHER


ON SURFACE - ~~BELOW~~ ON

~~LEFT~~ - Q PAV'T - ~~RIGHT~~ ON


TO EDGE PAVEMENT

S.L.M. 264+44

Grid: Northing: 677231.626 Easting: 1611626.0099

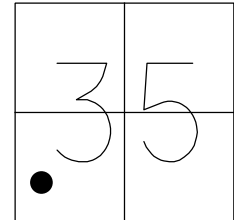

P.O.T. OLD STA
266+02.57

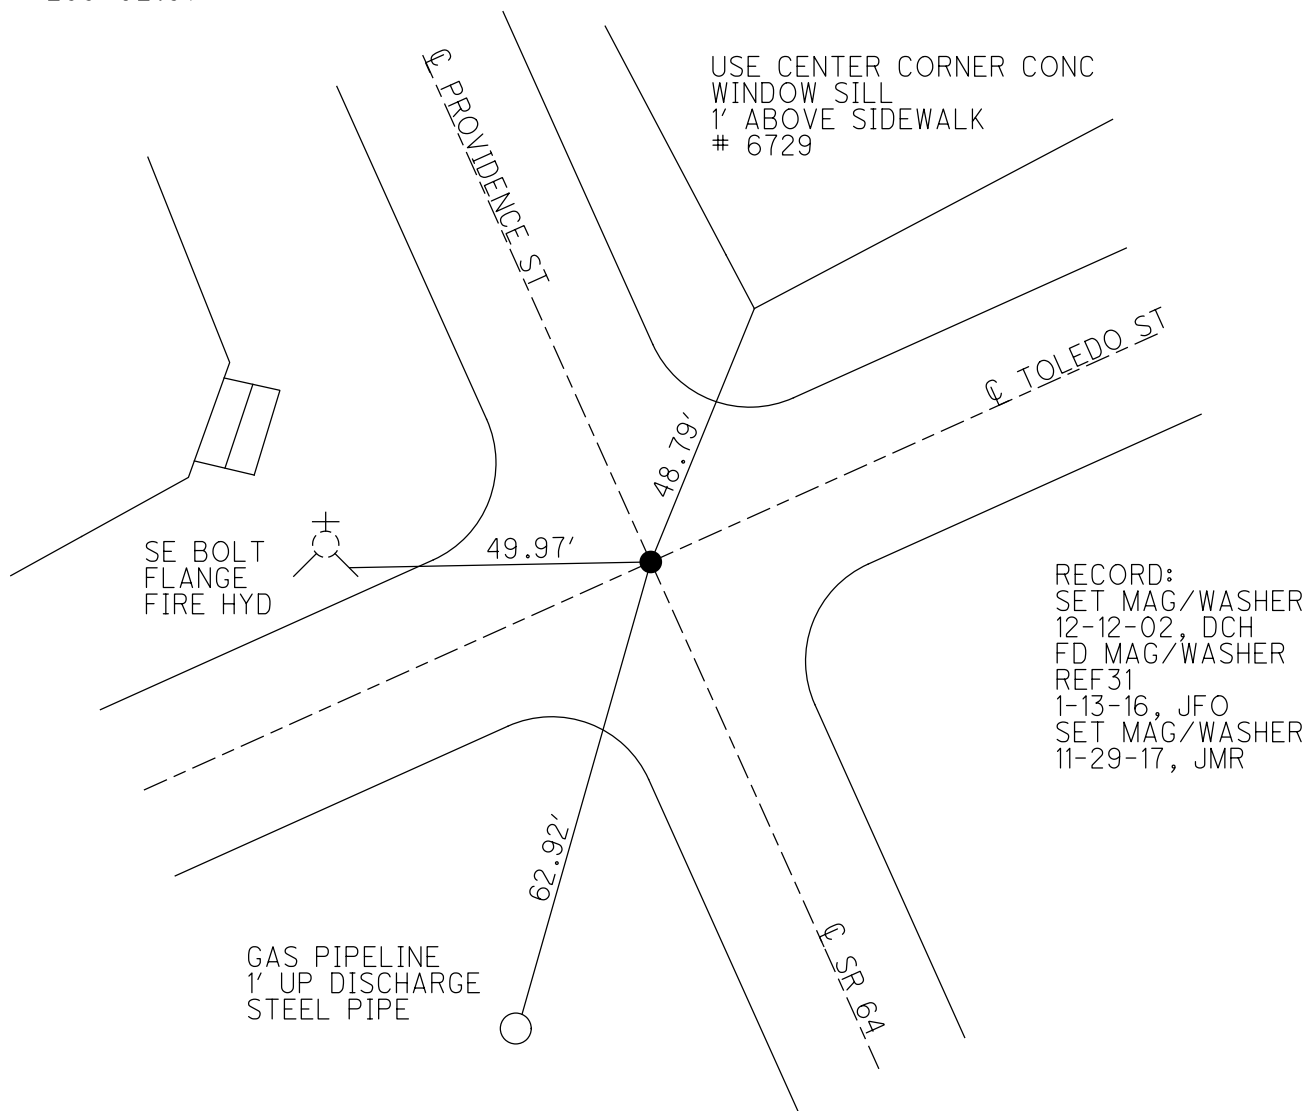

O.D.O.T. DISTRICT 2 SURVEY OFFICE (USE ONLY)

PERSONNEL

REFERENCE NO.

32

SHEET

26

OF 50

NOTES LOEHRKE

DATE 8-9-91

ROUTE SR 64

H.C. CURTIS

WEATHER CLEAR

COUNTY LUCAS

R.C. LUCE

TEMP. 75°

TOWNSHIP WATERVILLE

SECTION 35

T 7 N R 9 E

TYPE MONUMENT P.K. NAIL - .2' EAST OF MAINHOLE RIM


ON SURFACE - ~~BELOW~~ ON

~~LEFT~~ - Q PAV'T - ~~RIGHT~~ ON

TO EDGE PAVEMENT


S.L.M.

Grid: Northing: Easting:

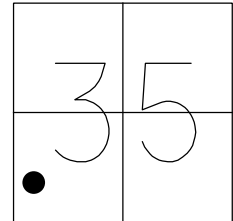

P.O.T.
OLD STA= 269+50.00

RECORD:
SET P.K. WASHER
3-5-92
DH, TR, MM
REFERENCES GONE
NO POINT FD
1951 NOTES CALL FOR POINT
TO BE ON MAINHOLE
5-21-02
DNF
1-13-16

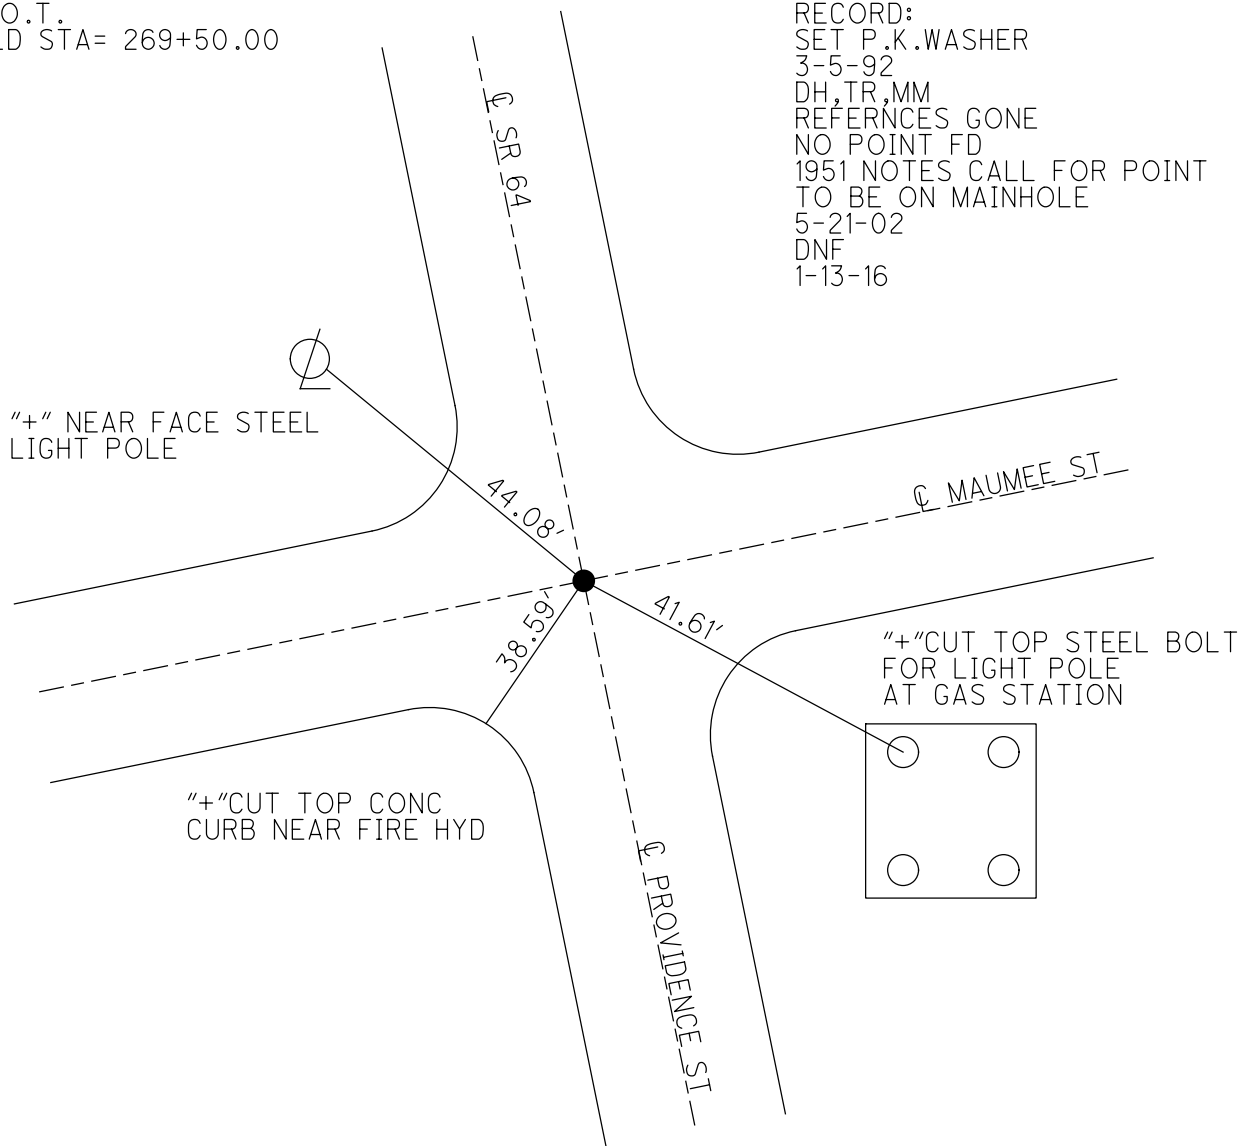


O.D.O.T. DISTRICT 2 SURVEY OFFICE (USE ONLY)


PERSONNEL _____ REFERENCE NO. 33 SHEET 27 OF 50
NOTES RHOADES DATE 6-15-17 ROUTE SR 64
H.C. POORE WEATHER CLOUDY COUNTY LUCAS
R.C. O'DONNELL TEMP. 77° TOWNSHIP WATERVILLE
SECTION 35
T 7 N R 9 E

TYPE MONUMENT MAG/WASHER
ON SURFACE - ~~BELOW~~ ON
LEFT - ℄ PAV'T - ~~RIGHT~~ 4'
22' TO LT EDGE PAVEMENT
S.L.M. 273+69.74

Grid: Northing: 678074.0151 Easting: 1611241.8988

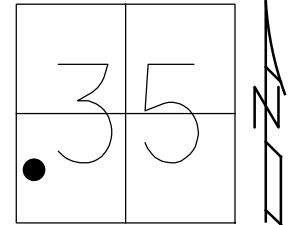

RECORD:
SET MAG/WASHER
12-12-02, DCH
FD MAG/WASHER
REF33
1-13-16, JFO
SET MAG/WASHER
11-29-17, JMR

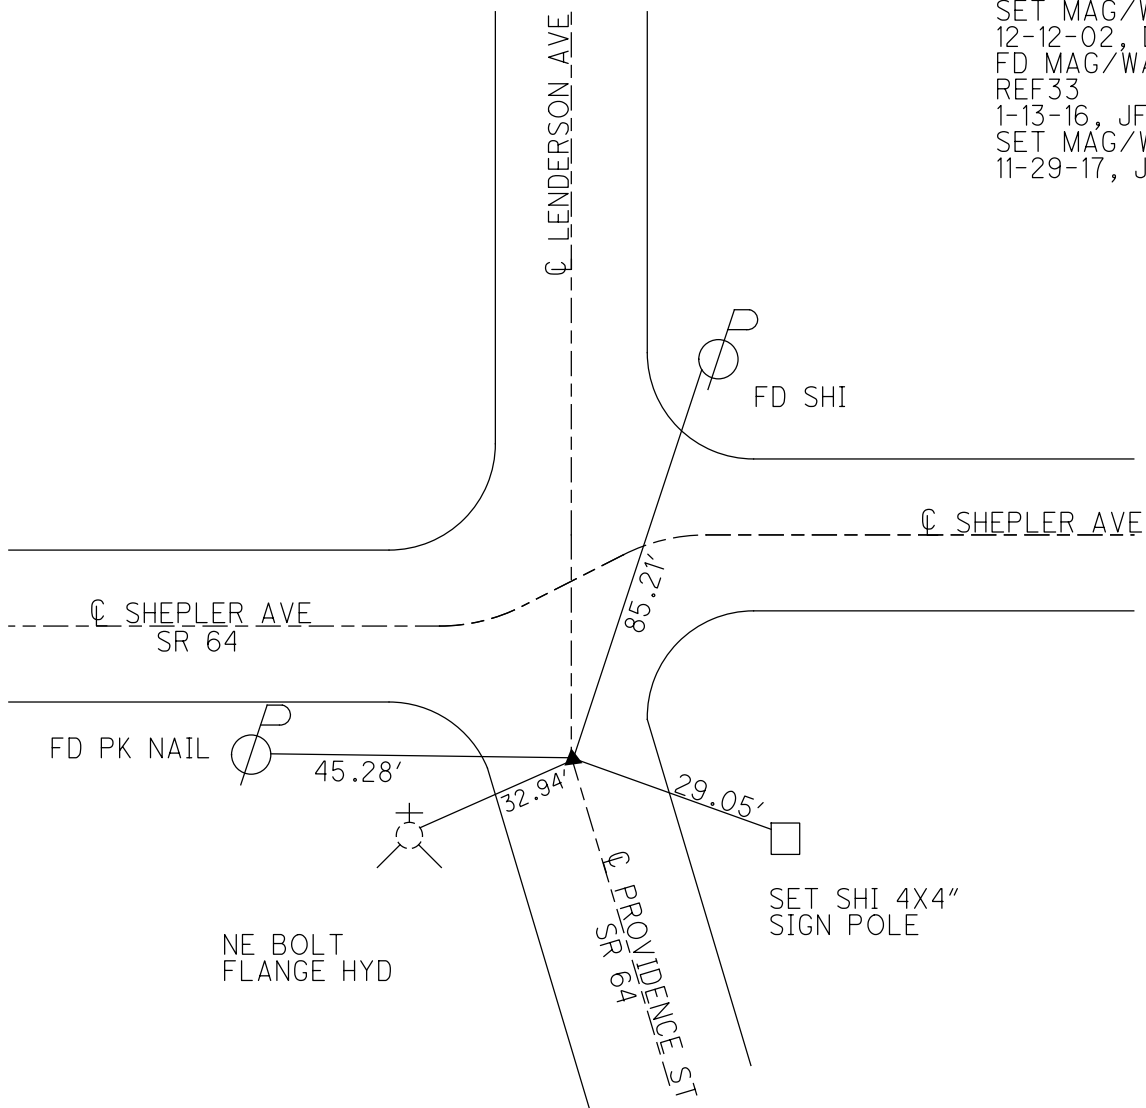

O.D.O.T. DISTRICT 2 SURVEY OFFICE (USE ONLY)

PERSONNEL

REFERENCE NO.

33 A

SHEET

28

OF 50

NOTES

RHOADES

DATE

6-15-17

ROUTE

SR 64

H.C.

POORE

WEATHER

CLOUDY

COUNTY

LUCAS

R.C.

O'DONNELL

TEMP.

77°

TOWNSHIP

WATERVILLE

SECTION

35

T 7 N R 9 E

TYPE MONUMENT MAG/WASHER


ON SURFACE - ~~BELOW~~ ON

~~LEFT~~ - ℄ PAV'T - ~~RIGHT~~ ON


TO EDGE PAVEMENT

S.L.M. 275+98

Grid: Northing: 678099.8574 Easting: 1611037.7539

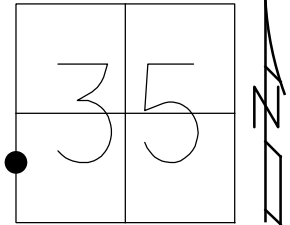

RECORD:
SET MAG/WASHER
12-12-02, DCH
FD MAG/WASHER
REFA33
1-13-16, JFO
SET MAG/WASHER
11-29-17, JMR

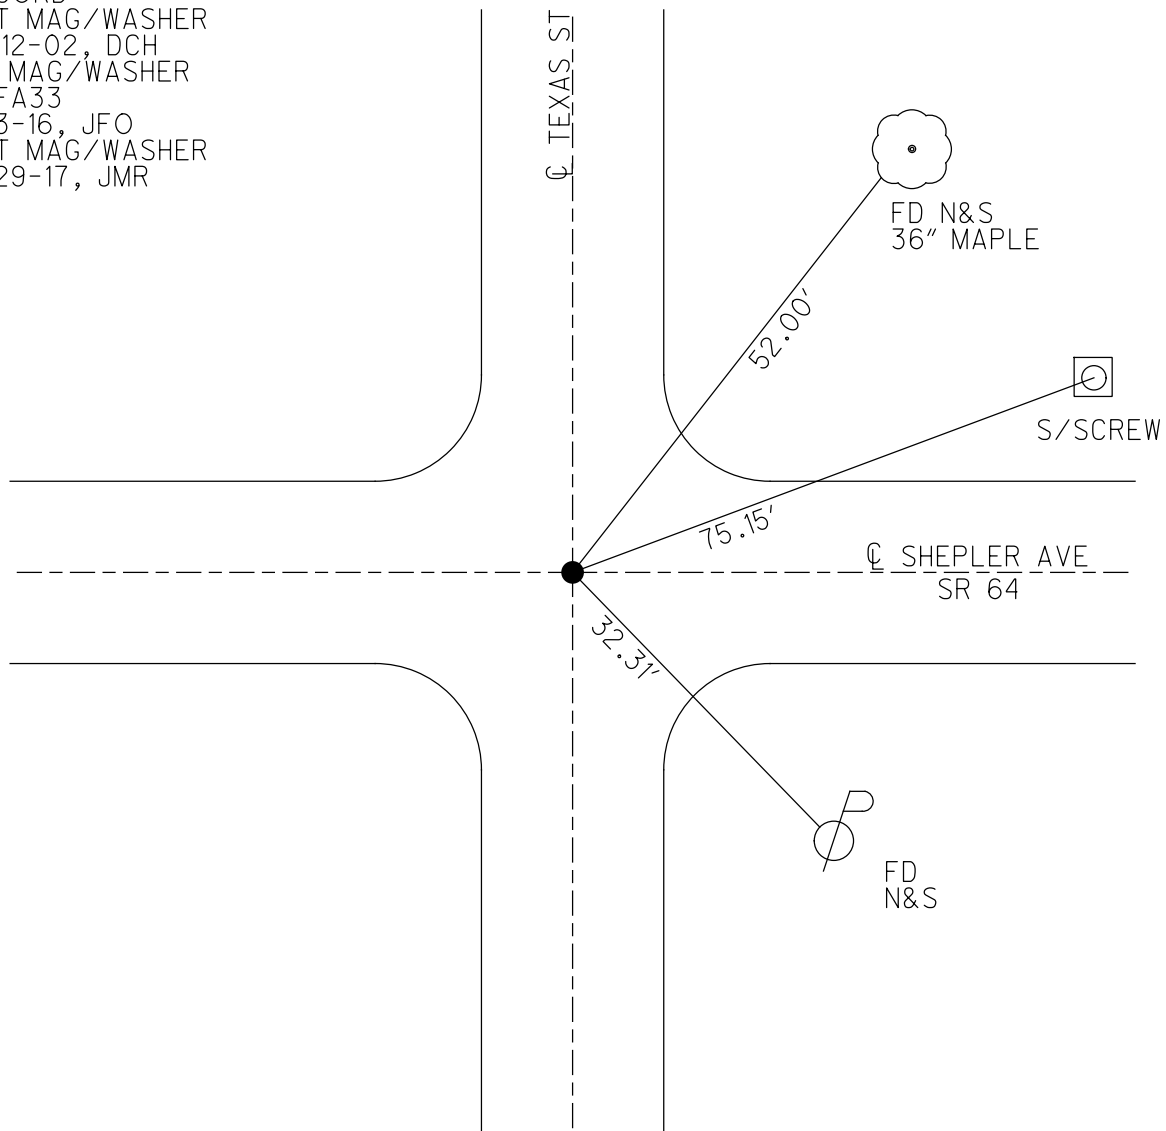

O.D.O.T. DISTRICT 2 SURVEY OFFICE (USE ONLY)

PERSONNEL

REFERENCE NO.

34 A

SHEET 30 OF 50

30 OF 50

NOTES _____ RHOADES

DATE

6-15-17

ROUTE SR 64

SR 64

H.C. POORE

WEATHER

CLOUDY

COUNTY LUCAS

LUCAS

R.C. O'DONNELL

TEMP.

77°

TOWNSHIP WATERVILLEWATERVILLESECTION 34

34

T_7_N R_9_E

R_9E

TYPE MONUMENT MAG/WASHER

MAG/WASHER

ON SURFACE - BELOW _____ ON

ON

LEFT - C PAV'T - RIGHT_ON

○


_____TO_____EDGE PAVEMENT

S.L.M. 280+41

$$\underline{280 + 41}$$

Grid: Northing: 678138.3072 Easting: 1610605.8986

678138.3072

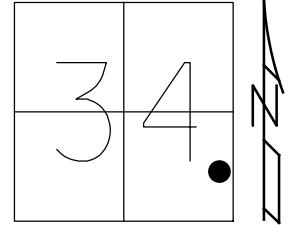Easting: 1610605.8986

RECORD:

SET MAG/WASHER

12-13-02, DCH


FD MAG/WASHER
BEEA 74

REF A34

1-13-16, JFO

SET MÁG/WASHER

11-29-17, JMR

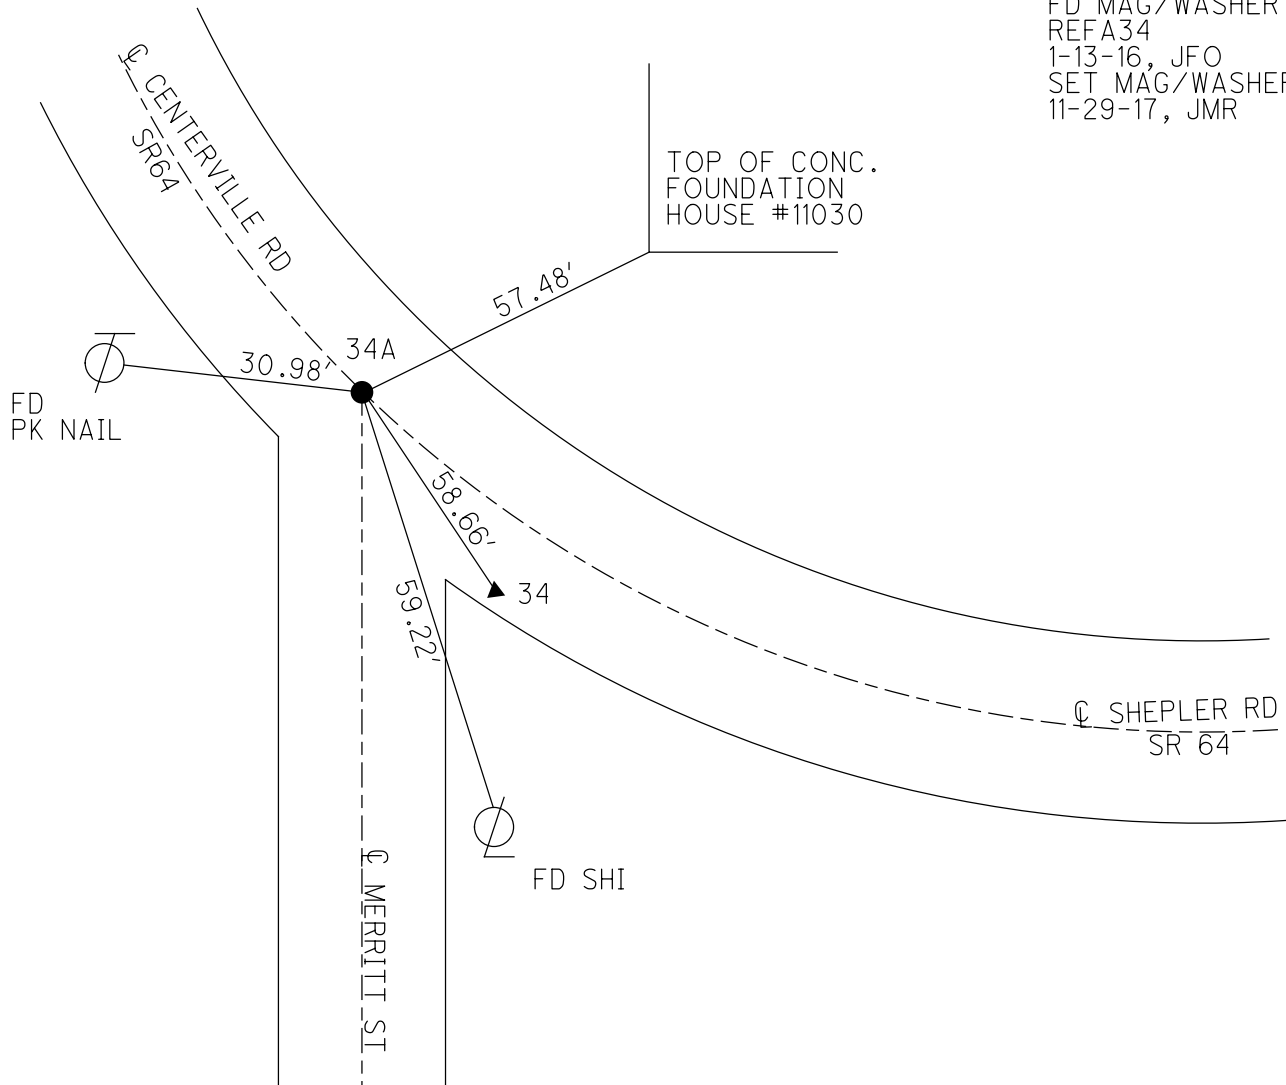

O.D.O.T. DISTRICT 2 SURVEY OFFICE (USE ONLY)

PERSONNEL

REFERENCE NO.

34 B

SHEET

31

OF 50

NOTES

RHOADES

DATE

6-15-17

ROUTE

SR 64

H.C.

POORE

WEATHER

CLOUDY

COUNTY

LUCAS

R.C.

O'DONNELL

TEMP.

77°

TOWNSHIP

WATERVILLE

SECTION

34

T 7 N R 9 E

TYPE MONUMENT MAG/WASHER


ON SURFACE - ~~BELOW~~ ON

~~LEFT - C~~ PAV'T - ~~RIGHT~~ ON


TO EDGE PAVEMENT

S.L.M. 283+45

Grid: Northing: 678317.3453 Easting: 1610360.3816

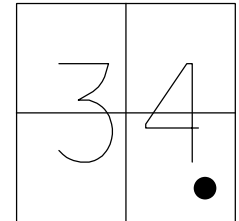

RECORD:
SET MAG/WASHER
12-12-02, DCH
FD MAG/WASHER
REFB34
1-13-16, JFO
SET MAG/WASHER
11-29-17, JMR

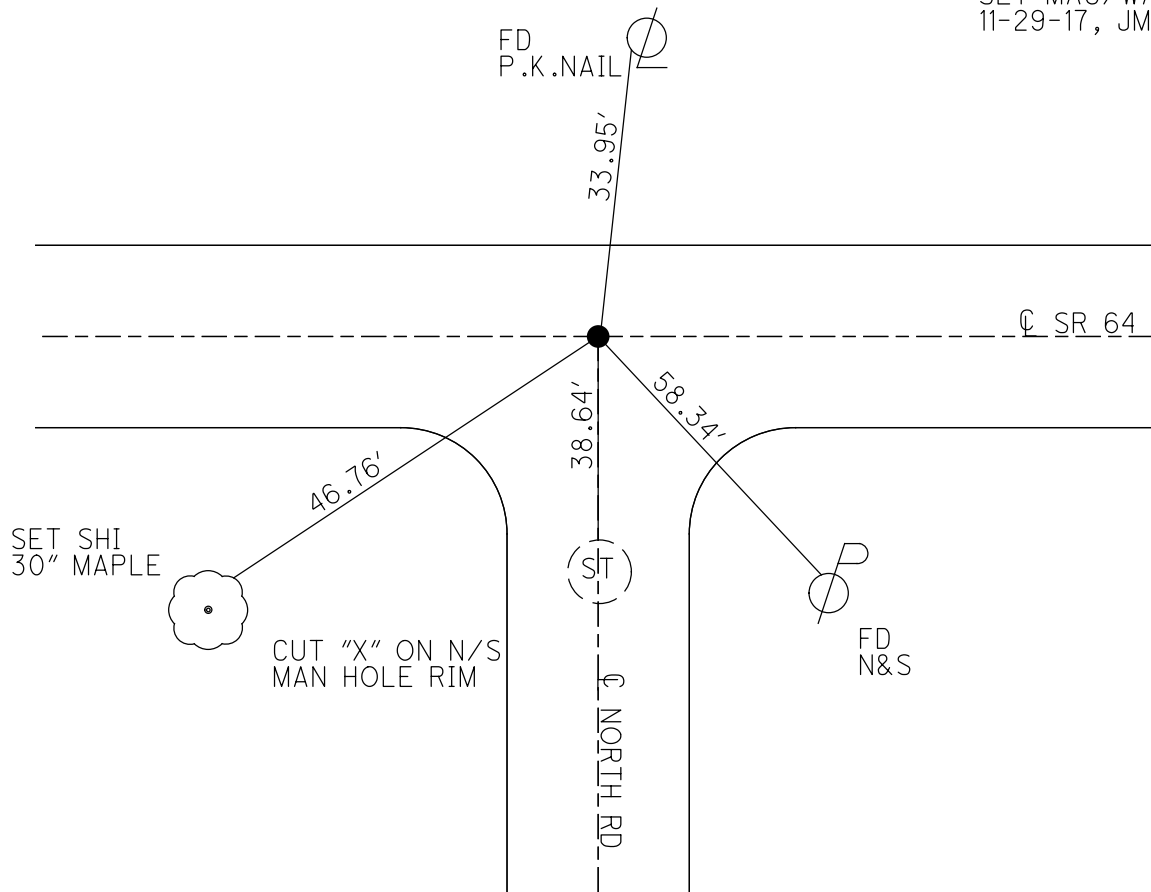

O.D.O.T. DISTRICT 2 SURVEY OFFICE (USE ONLY)

PERSONNEL

REFERENCE NO.

SHEET 32 OF 50

NOTES _____ RHOADES

DATE 6-15-17ROUTE SR 64

H.C. POORE

WEATHER CLOUDY

COUNTY LUCAS

R.C. O'DONNELL

TEMP. 77°

TOWNSHIP WATERVILLESECTION 34

T_7_N R_9_E

TYPE MONUMENT MAG/WASHER


ON SURFACE - ~~BELOW~~ ON

LEFT - C PAV'T - ~~RIGHT~~ 1.6'


11.6' TO RT EDGE PAVEMENT

S.L.M. 285+75

Grid: Northing: 678453.0896 Easting: 1610174.1404

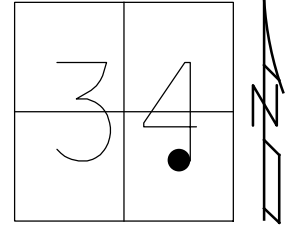

RECORD:
SET MAG/WASHER
12-13-02, DCH
SET MAG/WASHER
REF35
1-14-16, JFO
SET MAG/WASHER
11-29-17, JMR

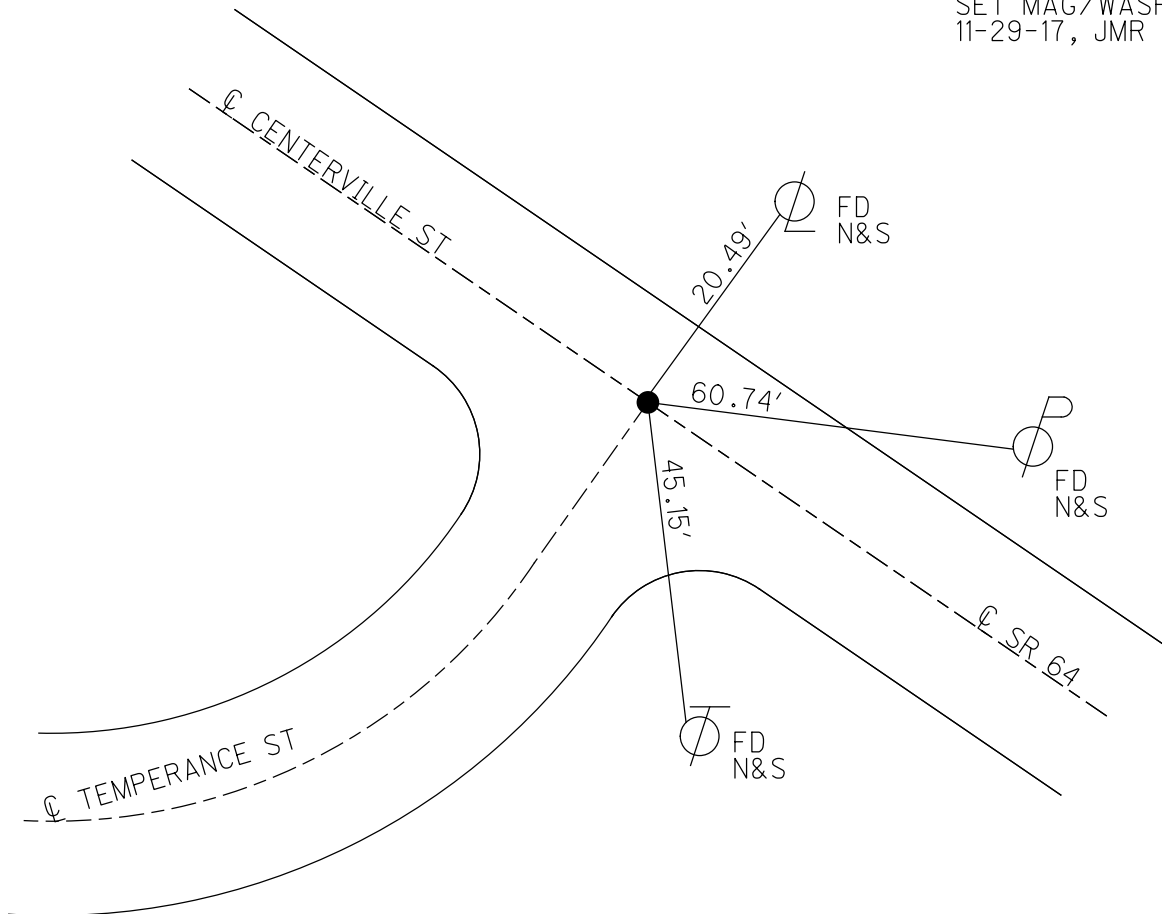

O.D.O.T. DISTRICT 2 SURVEY OFFICE (USE ONLY)

PERSONNEL

REFERENCE NO. 35 A

SHEET 33 OF 50

NOTES RHAODES

DATE 6-15-17

ROUTE SR 64

H.C. POORE

WEATHER CLOUDY

COUNTY LUCAS

R.C. O'DONNELL

TEMP. 74°

TOWNSHIP WATERVILLE

SECTION 34

T 7 N R 9 E

TYPE MONUMENT MAG/WASHER


ON SURFACE - ~~BELOW~~ ON

LEFT - Q PAV'T - ~~RIGHT~~ 1.5'


TO EDGE PAVEMENT

S.L.M. 296+66

Grid: Northing: 679096.3707 Easting: 1609293.5154

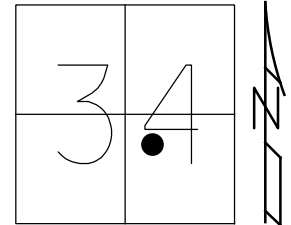

RECORD:
SET MAG/WASHER
12-13-02, DCH
FD MAG/WASHER
REFA35
1-14-16, JFO
SET MAG/WASHER
11-29-17, JMR

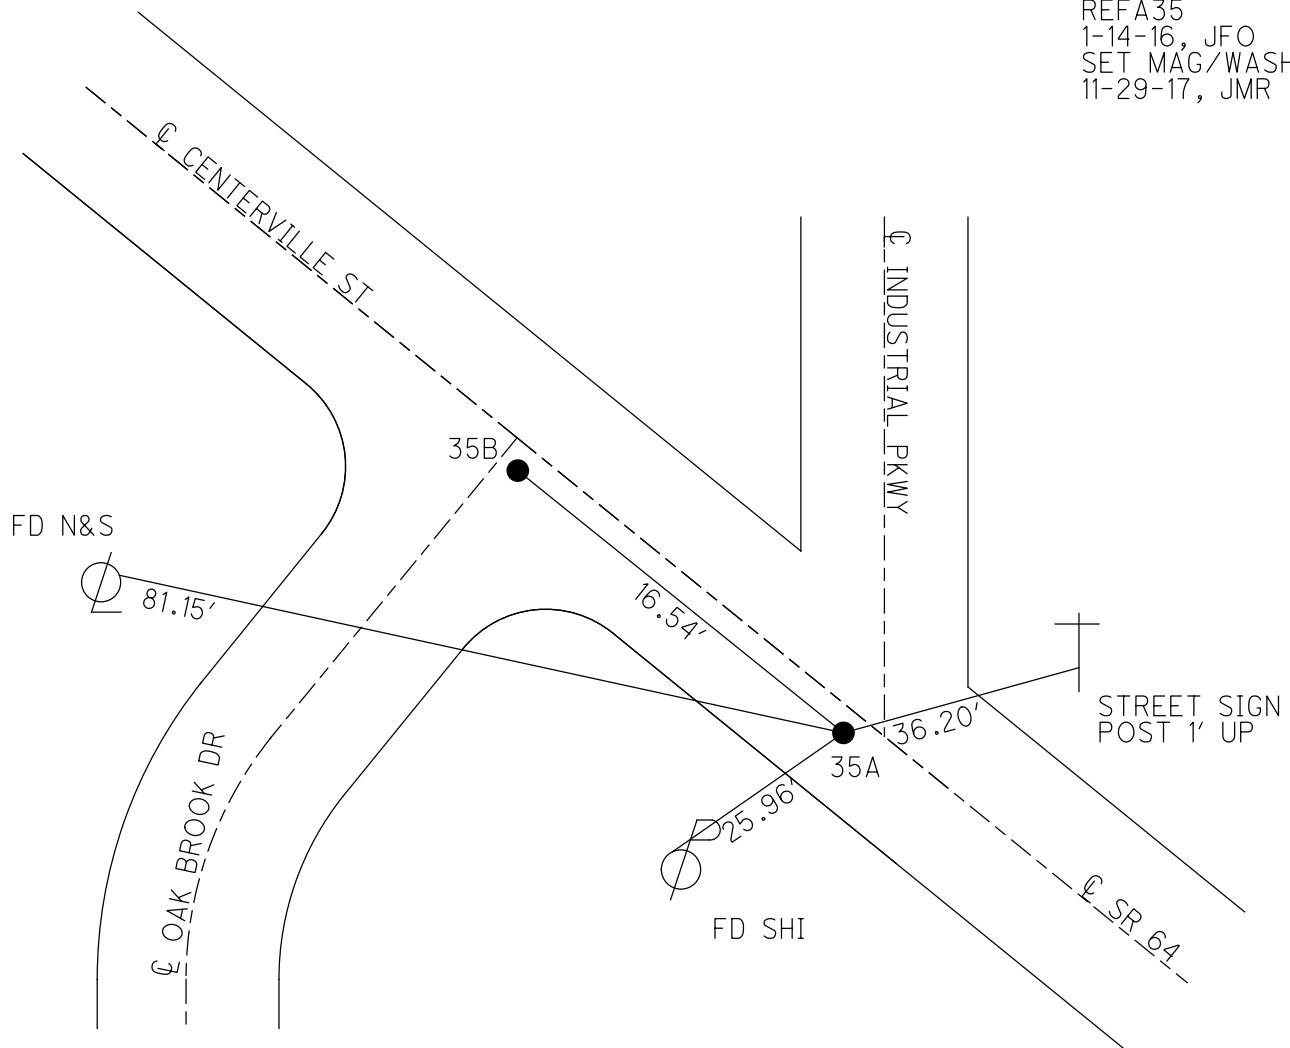

O.D.O.T. DISTRICT 2 SURVEY OFFICE (USE ONLY)

PERSONNEL

REFERENCE NO.

35 B

SHEET

34

OF 50

NOTES

RHOADES

DATE

6-15-17

ROUTE

SR 64

H.C.

POORE

WEATHER

CLOUDY

COUNTY

LUCAS

R.C.

O'DONNELL

TEMP.

74°

TOWNSHIP

WATERVILLE

SECTION

34

T 7 N

R 9 E

TYPE MONUMENT

MAG/WASHER

ON SURFACE - ~~BELOW~~

ON

LEFT - CL PAV'T - ~~RIGHT~~

2.3'

TO EDGE PAVEMENT

S.L.M.


296+82

Grid: Northing:


679105.3000

Easting:

1609279.6505

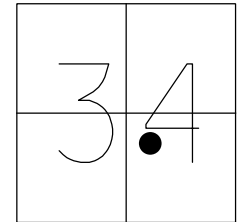

RECORD:
SET MAG/WASHER
12-13-02, DCH
FD MAG/WASHER
REFB35
1-14-16, JFO
SET MAG/WASHER
11-29-17, JMR

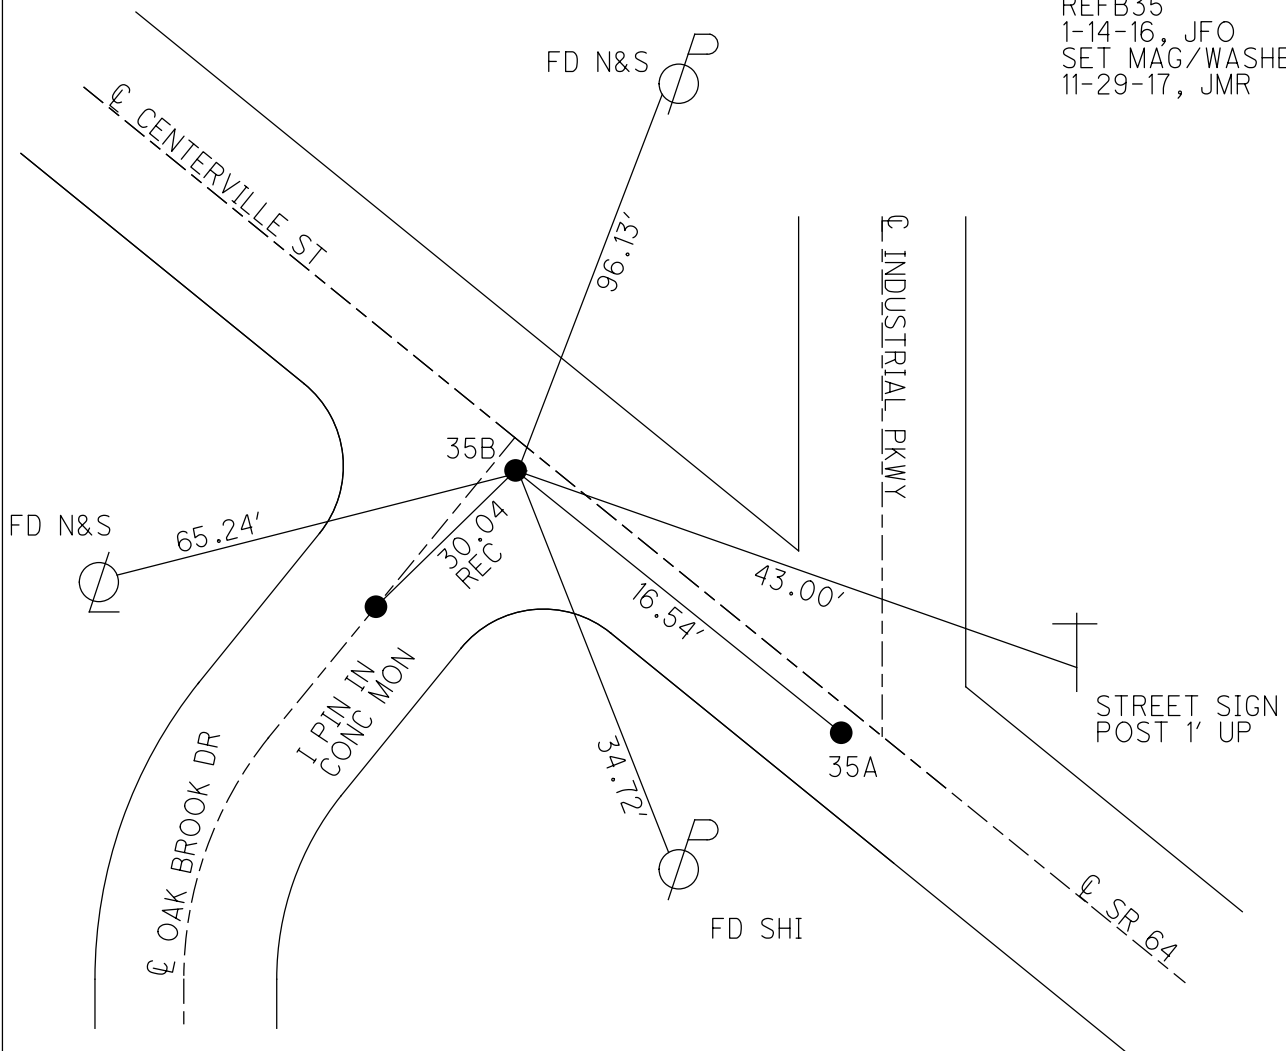

O.D.O.T. DISTRICT 2 SURVEY OFFICE (USE ONLY)

PERSONNEL _____ REFERENCE NO. 36 SHEET 35 OF 50
NOTES RHOADES DATE 6-15-17 ROUTE SR 64
H.C. POORE WEATHER CLOUDY COUNTY LUCAS
R.C. O'DONNELL TEMP. 74° TOWNSHIP WATERVILLE
SECTION 34
T 7 N R 9 E

TYPE MONUMENT MAG/WASHER


ON SURFACE - ~~BELOW~~ ON

~~LEFT~~ - CL PAV'T - RIGHT 3.5'

TO EDGE PAVEMENT


S.L.M. 299+53.96

Grid: Northing: 679265.681 Easting: 1609060.0624

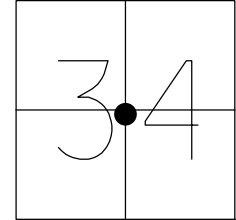

RECORD:
SET MAG/WASHER
12-13-02, DCH
FD MAG/WASHER
REF36
1-14-16, JFO
SET MAG/WASHER
11-29-17, JMR

RES
#11238

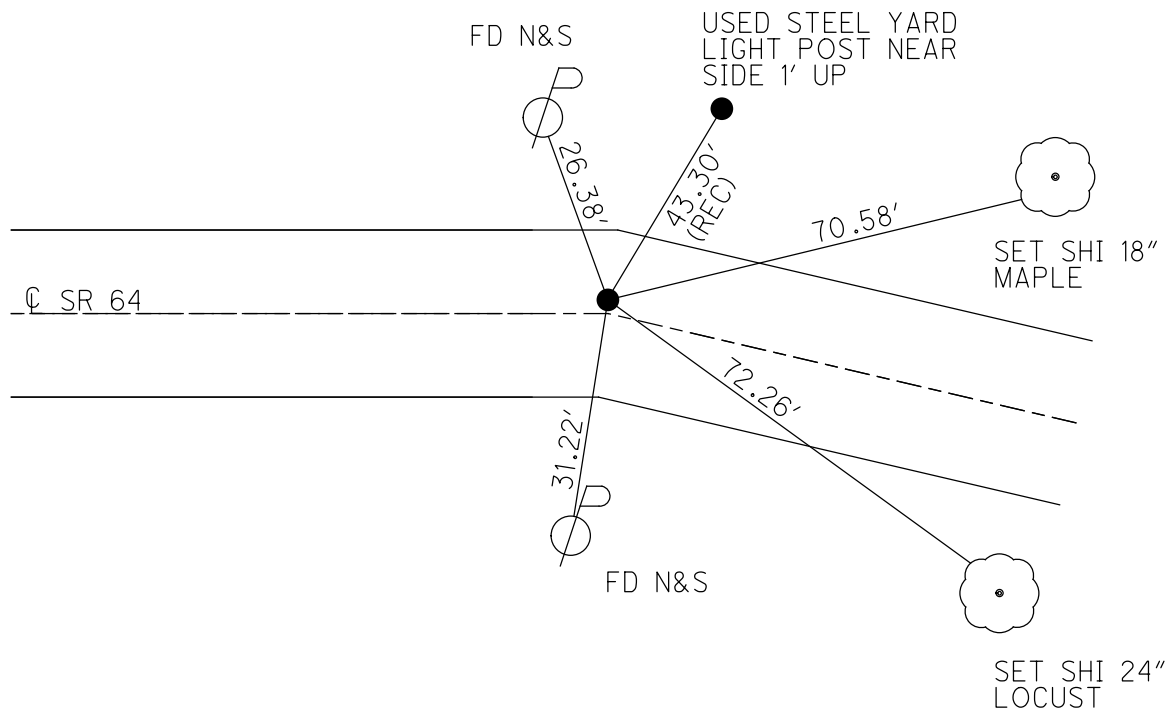


POINT 37 NOT FOUND
(P.K. BY OTHERS)
3.44' WEST (RECORD)


O.D.O.T. DISTRICT 2 SURVEY OFFICE (USE ONLY)

PERSONNEL _____ REFERENCE NO. 38 SHEET 36 OF 50
NOTES RHOADES DATE 6-15-17 ROUTE SR 64
H.C. POORE WEATHER CLOUDY COUNTY LUCAS
R.C. O'DONNELL TEMP. 74° TOWNSHIP WATERVILLE
SECTION 34
T 7 N R 9 E

TYPE MONUMENT MAG/WASHER
ON SURFACE - ~~BELOW~~ ON
~~LEFT~~ - ℄ PAV'T - RIGHT 1.3'
8.2' TO RT EDGE PAVEMENT
S.L.M. 307+13.91
Grid: Northing: 679631.7302 Easting: 1608394.0781

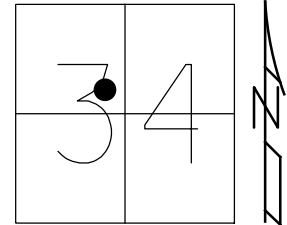

RECORD:
SET MAG/WASHER
12-13-02, DCH
FD MAG/WASHER
REF38
1-14-16, JFO
SET MAG/WASHER
11-29-17, JMR

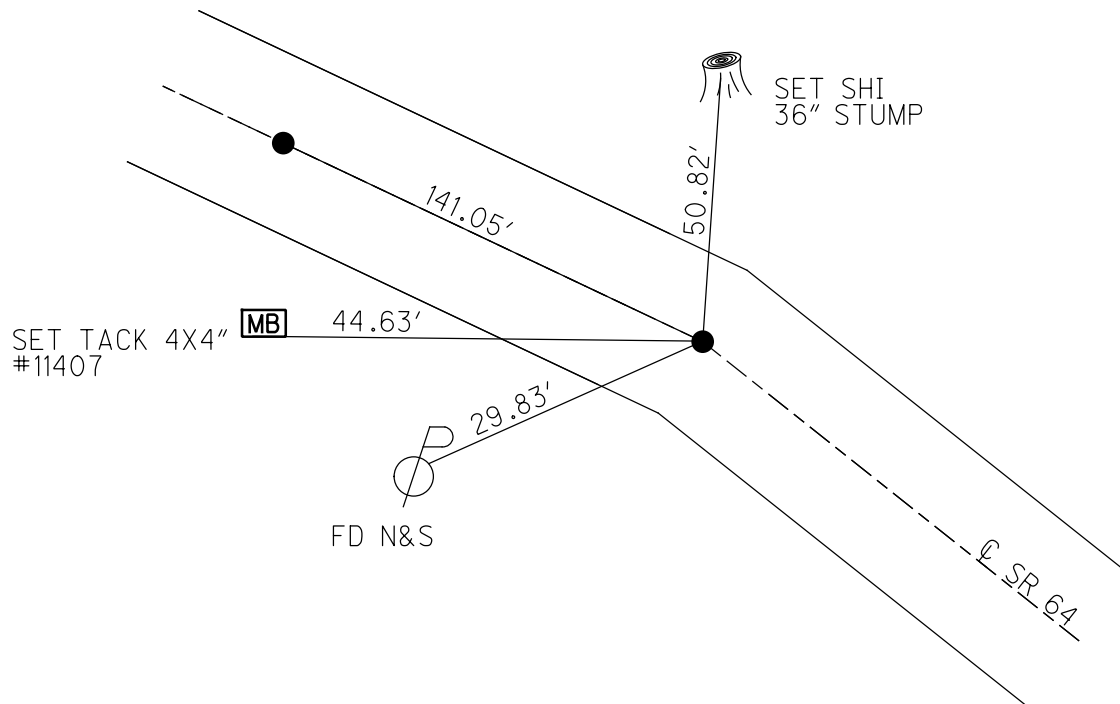

O.D.O.T. DISTRICT 2 SURVEY OFFICE (USE ONLY)

PERSONNEL

REFERENCE NO. 39

SHEET 37 OF 50

NOTES RHOADES

DATE 6-15-17

ROUTE SR 64

H.C. POORE

WEATHER CLOUDY

COUNTY LUCAS

R.C. O'DONNELL

TEMP. 74°

TOWNSHIP WATERVILLE

SECTION 34

T 7 N R 9 E

TYPE MONUMENT MAG/WASHER


ON SURFACE - ~~BELOW~~ ON

~~LEFT~~ - CL PAV'T - RIGHT 1.8'

8.3' TO LT EDGE PAVEMENT

S.L.M. 308+54.88

Grid: Northing: 679699.4767 Easting: 1608270.4536

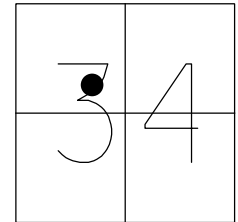


RECORD:
SET MAG/WASHER
8-7-02, DCH
RESET MAG/WASHER
AFTER NEW PIPE
INSTALLED
8-24-06, MB
FD MAG/WASHER
REF39
1-14-16, JFO
SET MAG/WASHER
11-29-17, JMR

SET N&S
50" ELM



52.01'

 DITCH



CL SR 64

REC

41.75'

123.27'



44.06'

FD N&S



SET SHI

DITCH

O.D.O.T. DISTRICT 2 SURVEY OFFICE (USE ONLY)

PERSONNEL

REFERENCE NO.

40

SHEET

38

OF 50

NOTES

RHOADES

DATE

6-15-17

ROUTE

SR 64

H.C.

POORE

WEATHER

CLOUDY

COUNTY

LUCAS

R.C.

O'DONNELL

TEMP.

72°

TOWNSHIP

WATERVILLE

SECTION

34

T 7 N R 9 E

TYPE MONUMENT 3 1/2" BRASS DISK


~~ON SURFACE~~ - BELOW 5"

~~LEFT~~ - CL PAV'T - RIGHT 5.2'

3.9' TO RT EDGE PAVEMENT

S.L.M. 322+15.57

Grid: Northing: 680326.227 Easting: 1607062.7037

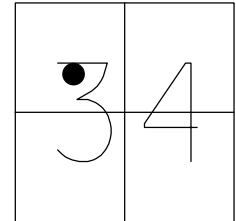

RECORD:

SET P.K.NAIL/WASHER

8-7-02, DCH

FD MAG NAIL

REF40


1-14-16, JFO

REREF40 DISK

6-15-17, JFO

SET MAG/WASHER

11-29-17, JMR

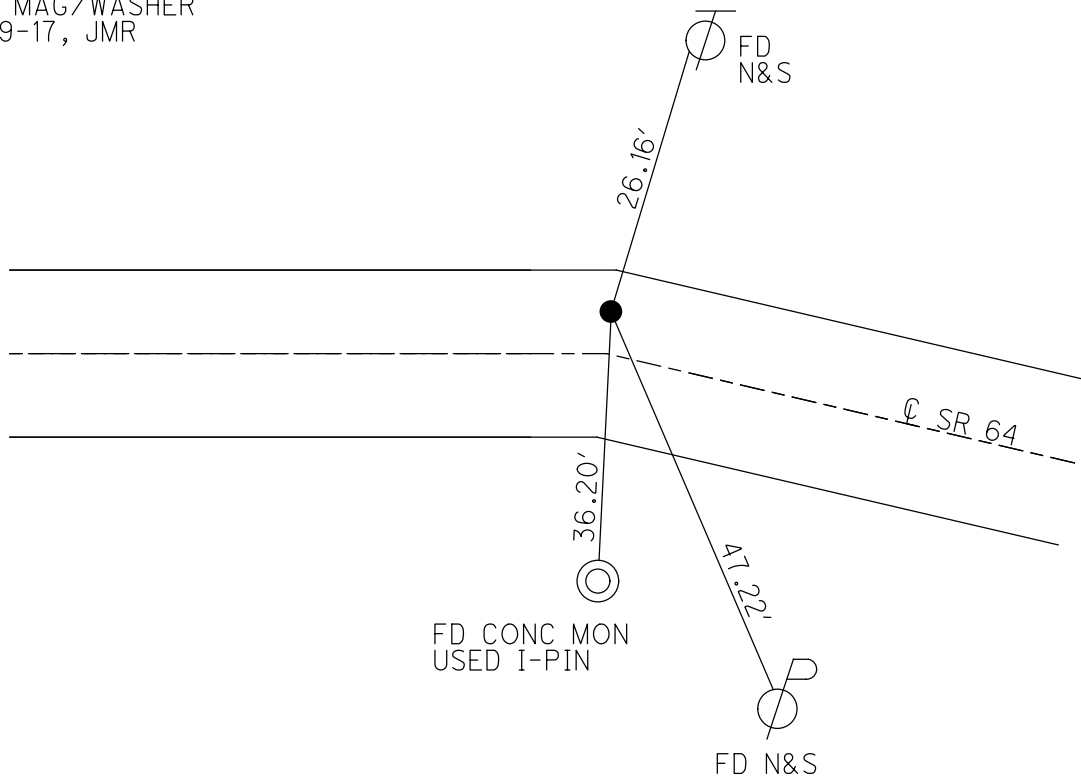

O.D.O.T. DISTRICT 2 SURVEY OFFICE (USE ONLY)

PERSONNEL

REFERENCE NO. 41

SHEET 39 OF 56

NOTES RHOADES

DATE 6/15/17

ROUTE SR 64

H.C. POORE

WEATHER PTLY CLOUDY

COUNTY LUCAS

R.C. O'DONNELL

TEMP. 72°

TOWNSHIP WATERVILLE

DWG BY RHOADES PID R/W

SECTION 33

T 7 N R 5 E

TYPE MONUMENT MAG/WASHER


ON SURFACE - ~~BELOW~~ ON

OFFSET 1.6' LT : ~~RT~~

11.6' TO RT EDGE PAVEMENT

STATION: 335+91

LDP:
N: 301700.457
E: 116149.082

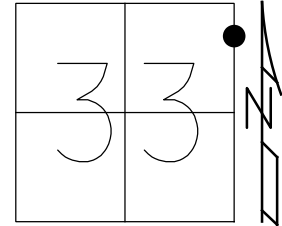


HORIZ.DATUM: NAD83 2011

GEOID: NAVD88 2018

GRID: NORTHING: 680699.620

EASTING: 1605738.546

RECORD:
SET P.K.WASHER
3-5-92
SET MAG/WASHER
12-13-02, DCH
FD MAG/WASHER
REF41
1-14-16, JFO
SET MAG/WASHER
11-28-17, JMR
FD MAG/WASHER
REF41
8/14/23, DSA

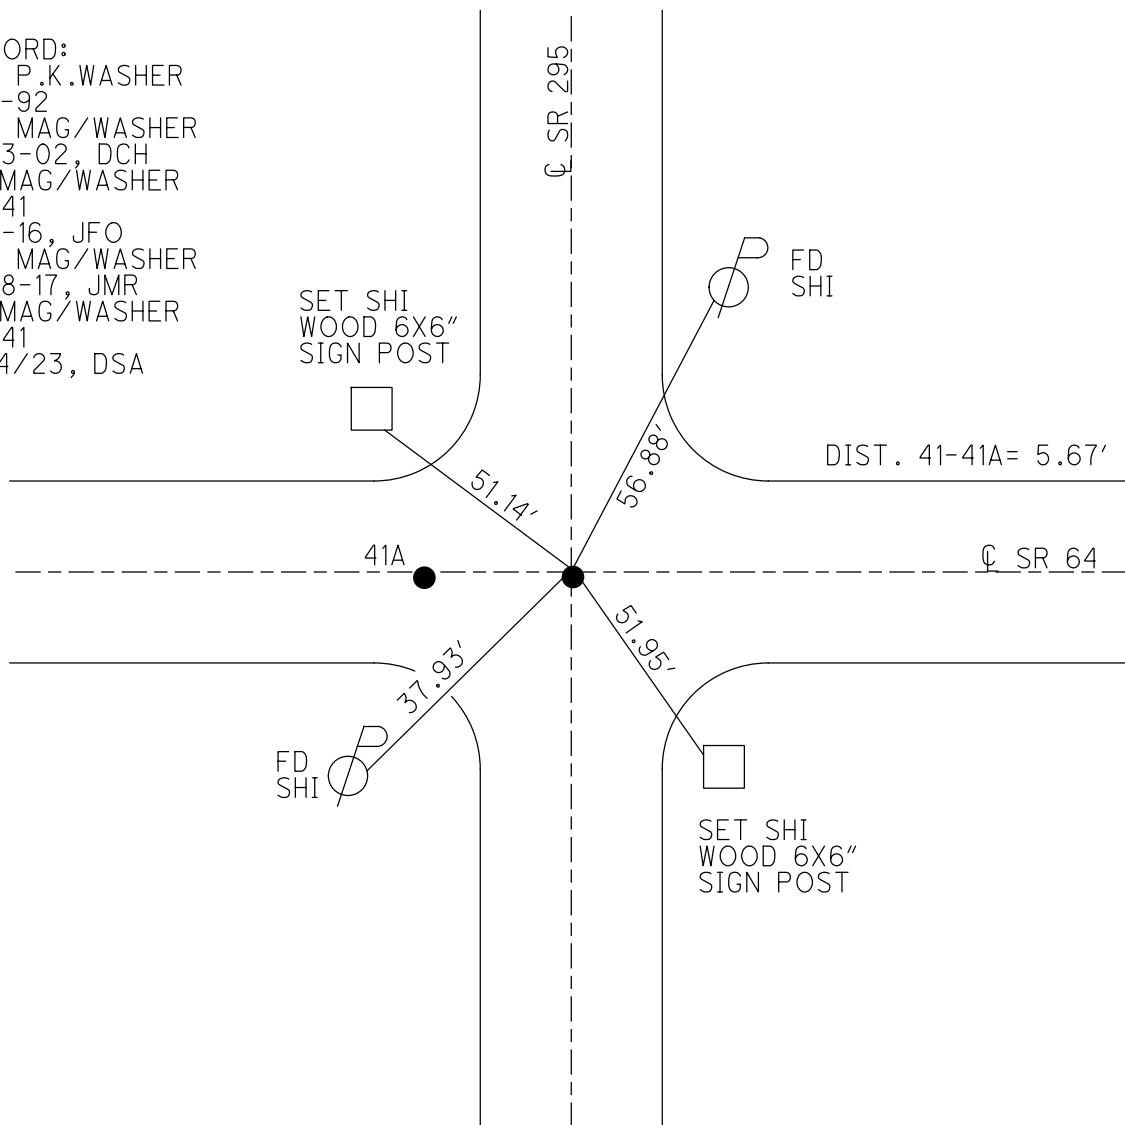

O.D.O.T. DISTRICT 2 SURVEY OFFICE (USE ONLY)

PERSONNEL

REFERENCE NO. 41 A

SHEET 40 OF 56

NOTES RHOADES

DATE 6/15/17

ROUTE SR 64

H.C. POORE

WEATHER PTLY CLOUDY

COUNTY LUCAS

R.C. O'DONNELL

TEMP. 72°

TOWNSHIP WATERVILLE

SECTION 33

DWG BY RHOADES

PID R/W

T 7 N R 5 E

TYPE MONUMENT MAG/WASHER

ON SURFACE - ~~BELOW~~ ON

OFFSET Q PAVEMENT 1.6' LT : ~~RT~~

11.6' TO RT EDGE PAVEMENT

LDP:
N: 301702.049
E: 116143.653


STATION: 335+97

HORZ.DATUM: NAD83 2011

GEOID: NAVD88 2018

GRID: NORTHING: 680701.232

EASTING: 1605733.116

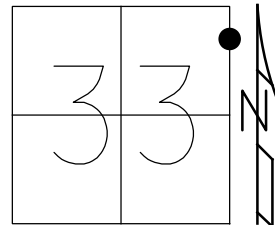

RECORD:

SET P.K./WASHER
3-5-92

SET MAG/WASHER

12-13-02, DCH

FD MAG/WASHER

REF41

1-14-16, JFO


SET MAG/WASHER

11-28-17, JMR

FD MAG/WASHER

REF41A

8/14/23, DSA

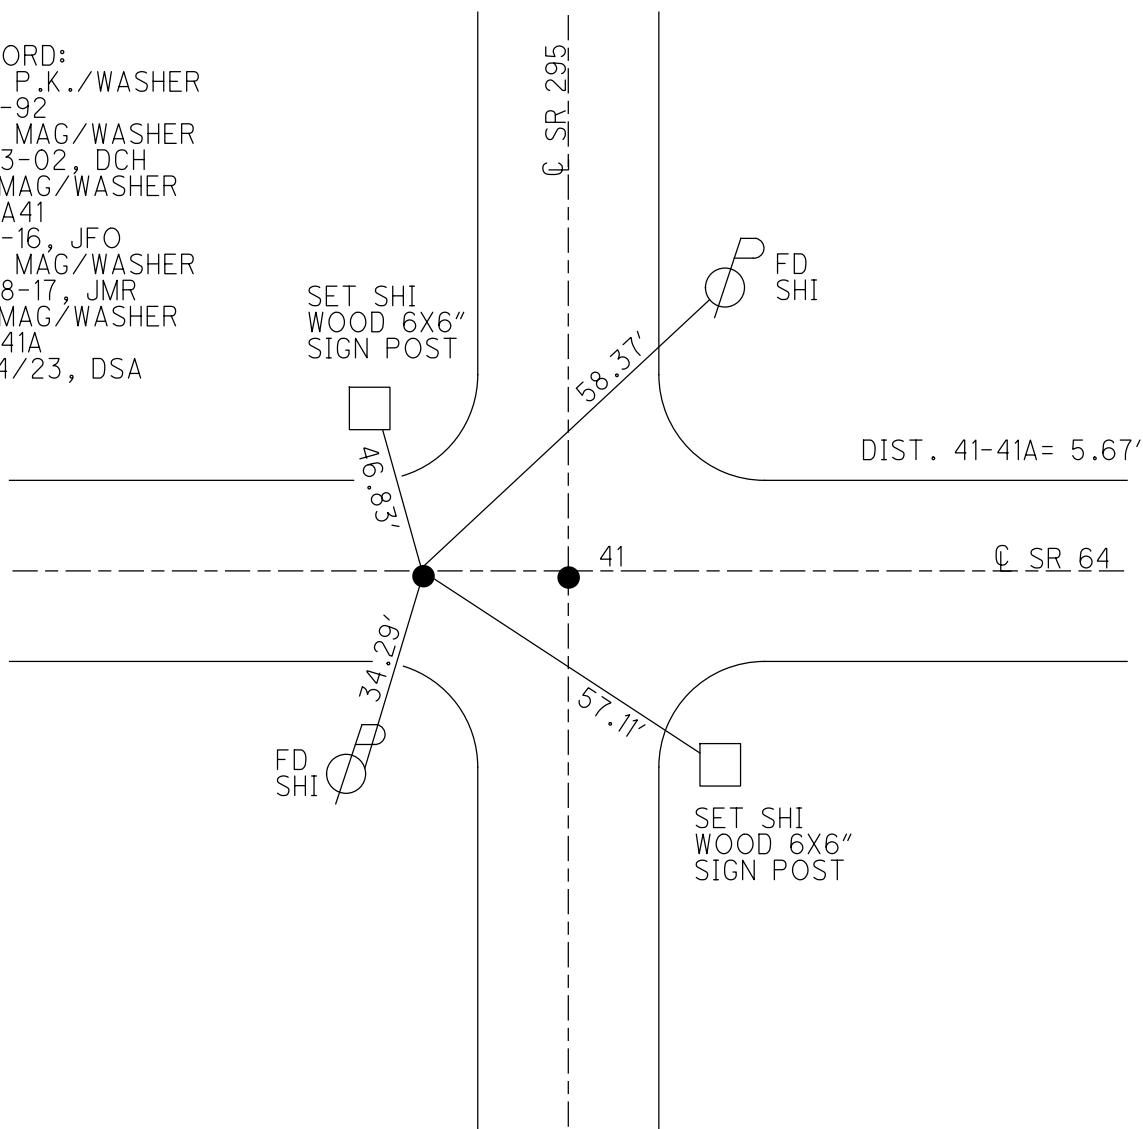

O.D.O.T. DISTRICT 2 SURVEY OFFICE (USE ONLY)

PERSONNEL

REFERENCE NO. 42

SHEET 41 OF 56

NOTES _____ RHOADES

DATE 6/15/17

ROUTE SR 64

H.C. POORE

WEATHER PTLY CLOUDY

COUNTY LUCAS

R.C. O'DONNELL

TEMP. 72°

TOWNSHIP WATERVILLESECTION 33DWG BY RHOADESPID R/W

T_7_N R_5_E

TYPE MONUMENT MAG/WASHER

ON SURFACE - ~~BELOW~~ ON

OFFSET C PAVEMENT 1.0' LT : RT

8.8' TO LT EDGE PAVEMENT


LDP:
N: 301921.238
E: 115325.142

STATION: 344+44.34

HORZ.DATUM: NAD83 2011

GEOID: NAVD88 2018

GRID: NORTHING: 680931.272

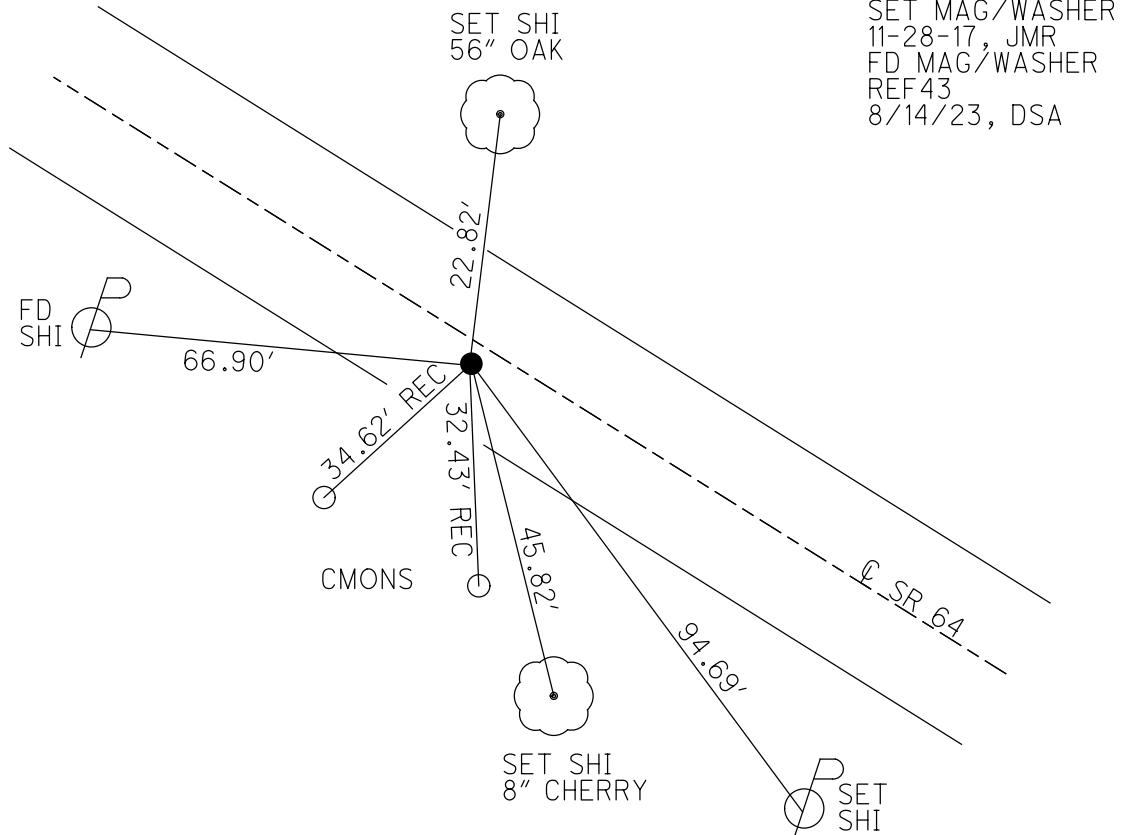EASTING: 160417.631

RECORD:

SET P.K./WASHER
3-5-92

SET P.K./WASHER

6-16-97, SAH
CFT, B.K. (WAC)

SET P.K./WASHER

6-14-99, BWC
ED, BWC, (WAG)

FD P.K./WASHER
REF 12

REF 42

1-15-16, JFO
GETTING ON WITH

SET MAG/WASHER

11-28-17, JMR

FD MAG/WASHER

REF 43

8/14/23, DSA

O.D.O.T. DISTRICT 2 SURVEY OFFICE (USE ONLY)

PERSONNEL

REFERENCE NO. 43

SHEET 42 OF 56

NOTES RHOADES

DATE 6/15/17

ROUTE SR 64

H.C. POORE

WEATHER PTLY CLOUDY

COUNTY LUCAS

R.C. O'DONNELL

TEMP. 72°

TOWNSHIP WATERVILLE

SECTION 33

DWG BY RHOADES

PID R/W

T 7 N R 5 E

TYPE MONUMENT MAG/WASHER

ON SURFACE - ~~BELOW~~ ON

OFFSET CL PAVEMENT 1.2' LT : ~~RT~~

9.2' TO LT EDGE PAVEMENT

LDP:
N: 302577.663
E: 113493.763



STATION: 363+89.67

HORIZ.DATUM: NAD83 2011

GEOID: NAVD88 2018

GRID: NORTHING: 681611.612

EASTING: 1603095.148

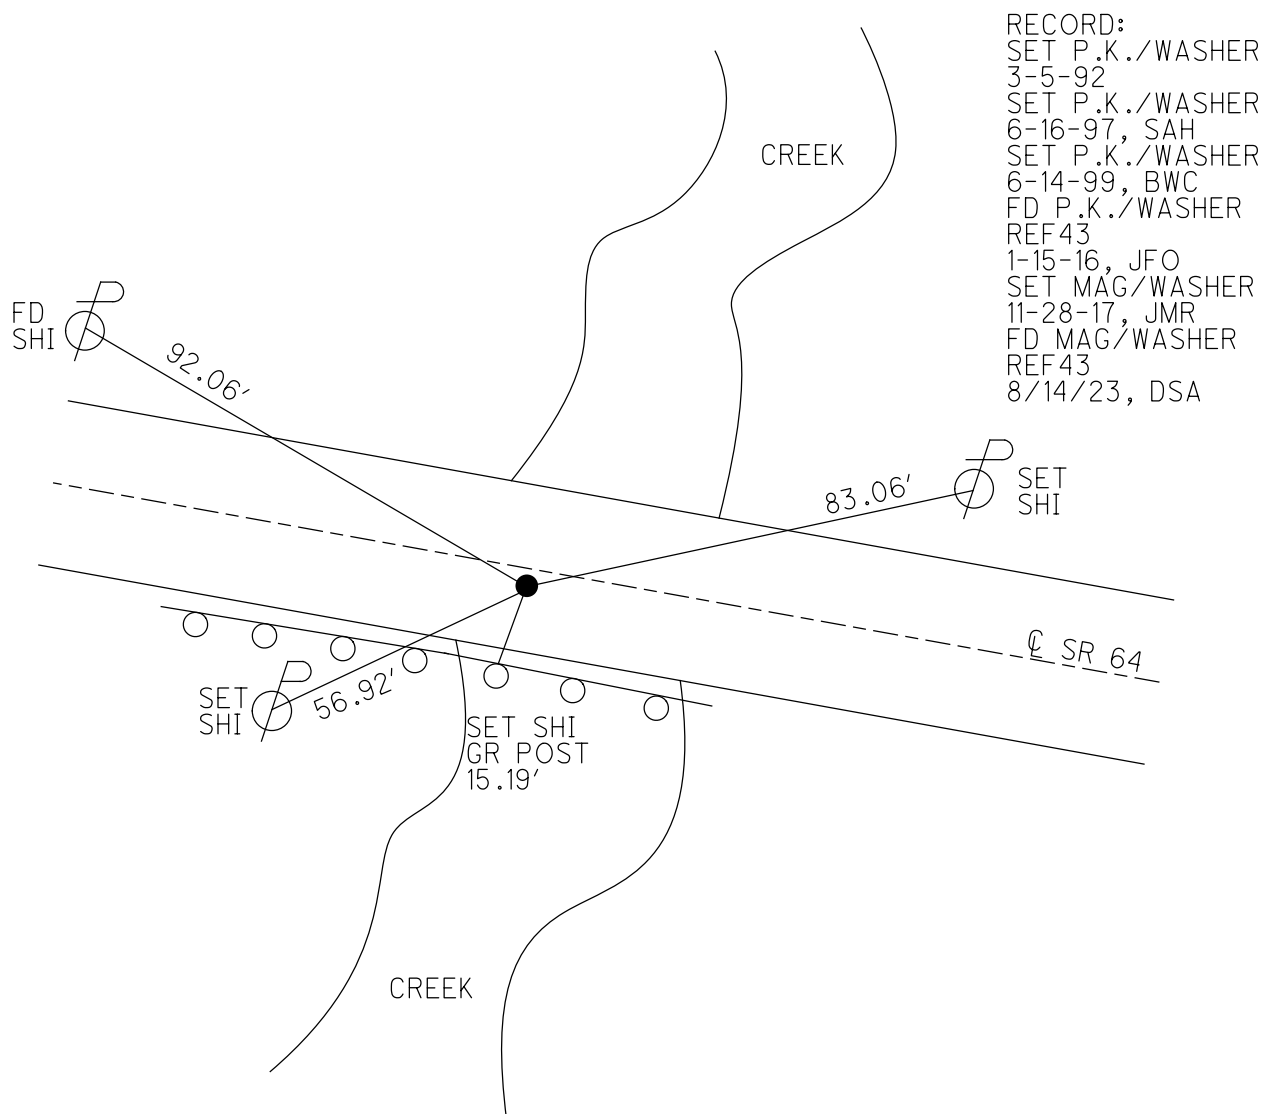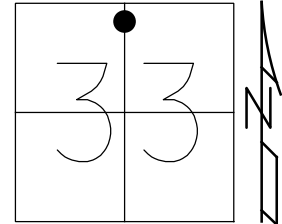

O.D.O.T. DISTRICT 2 SURVEY OFFICE (USE ONLY)

PERSONNEL

REFERENCE NO. 44

SHEET 43 OF 56

NOTES RHOADES

DATE 6/14/17

ROUTE SR 64

H.C. POORE

WEATHER PTLY CLOUDY

COUNTY LUCAS

R.C. O'DONNELL

TEMP. 72°

TOWNSHIP WATERVILLE

DWG BY RHOADES PID R/W

SECTION 33

T 7 N R 5 E

TYPE MONUMENT MAG/WASHER

ON SURFACE - ~~BELOW~~ ON

OFFSET CL PAVEMENT 9.6' ~~LT~~ : RT

ON TO RT EDGE PAVEMENT LDP:

STATION: 377+64.49 N: 302986.747


E: 112181.147

HORZ.DATUM: NAD83 2011

GEOID: NAVD88 2018

GRID: NORTHING: 682037.9968

EASTING: 1601788.1212

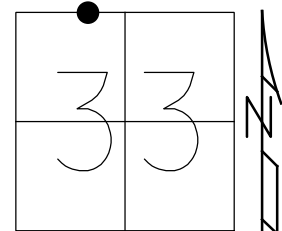

RECORD:

SET P.K./WASHER

6-16-97, SAH

SET P.K./WASHER

6-14-99 BWC

FD P.K./WASHER

REF44

1-15-16, JFO


SET MAG/WASHER

11-28-17, JMR

FD MAG/WASHER

REF44

8/14/23, DSA

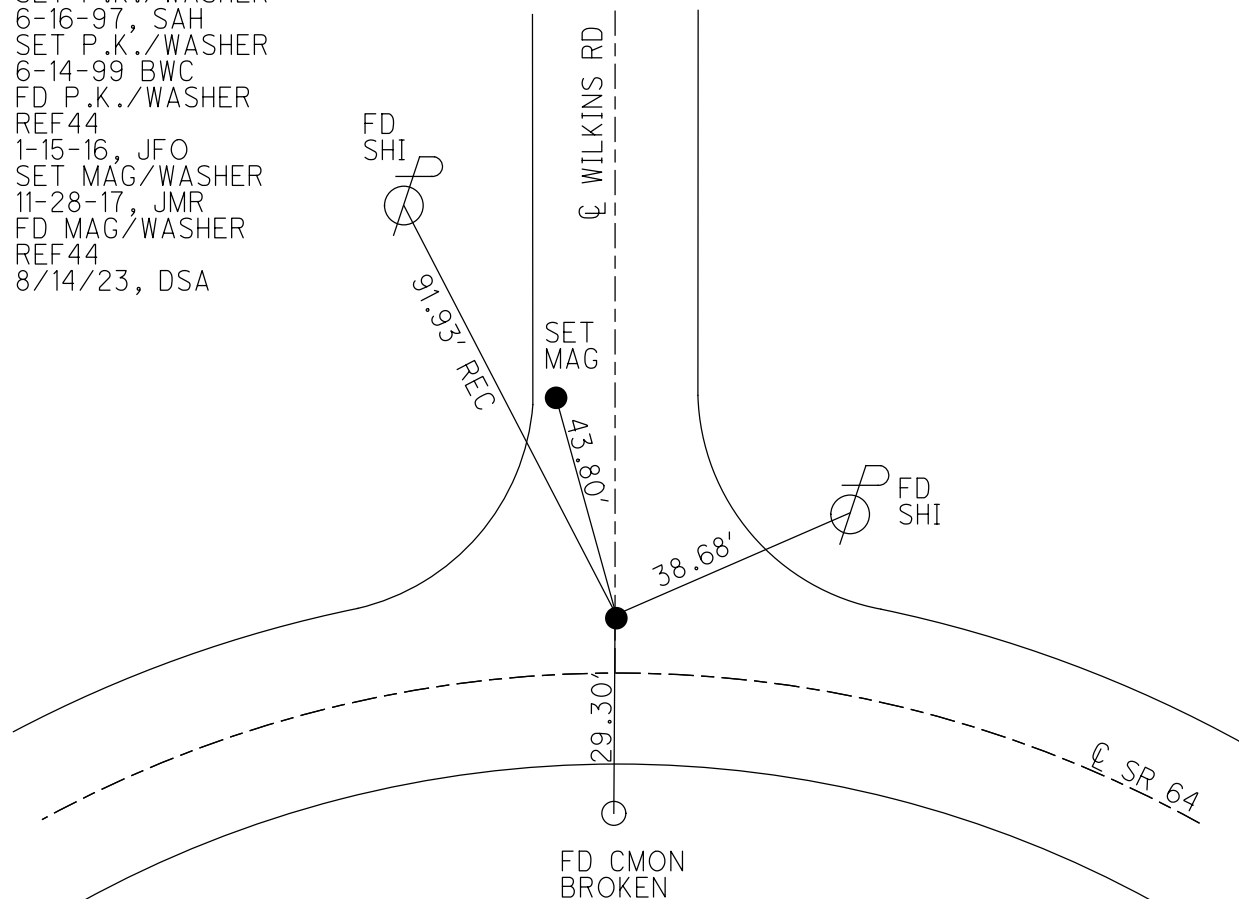

O.D.O.T. DISTRICT 2 SURVEY OFFICE (USE ONLY)

PERSONNEL

REFERENCE NO. 45

SHEET 44 OF 56

NOTES RHOADES

DATE 6/14/17

ROUTE SR 64

H.C. POORE

WEATHER PTLY CLOUDY

COUNTY LUCAS

R.C. O'DONNELL

TEMP. 72°

TOWNSHIP WATERVILLE

SECTION 33

DWG BY RHOADES PID R/W

T 7 N R 5 E

TYPE MONUMENT MAG/WASHER

ON SURFACE - ~~BELOW~~ ON

OFFSET Q PAVEMENT 1.8' ~~LT~~ : RT

8.0' TO RT EDGE PAVEMENT LDP:

STATION: 390+68.54 N: 302998.235


E: 110877.071

HORIZ.DATUM: NAD83 2011


GEOID: NAVD88 2018

GRID: NORTHING: 682066.602

EASTING: 1600484.381

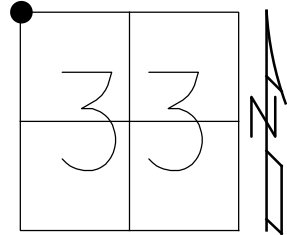

RECORD:
SET P.K./WASHER
6-16-97, SAH
SET P.K./WASHER
6-14-99 BWC
FD P.K./WASHER
REF45
1-15-16, JFO
SET MAG/WASHER
11-28-17, JMR
FD MAG/WASHER
REF45
8/14/23, DSA

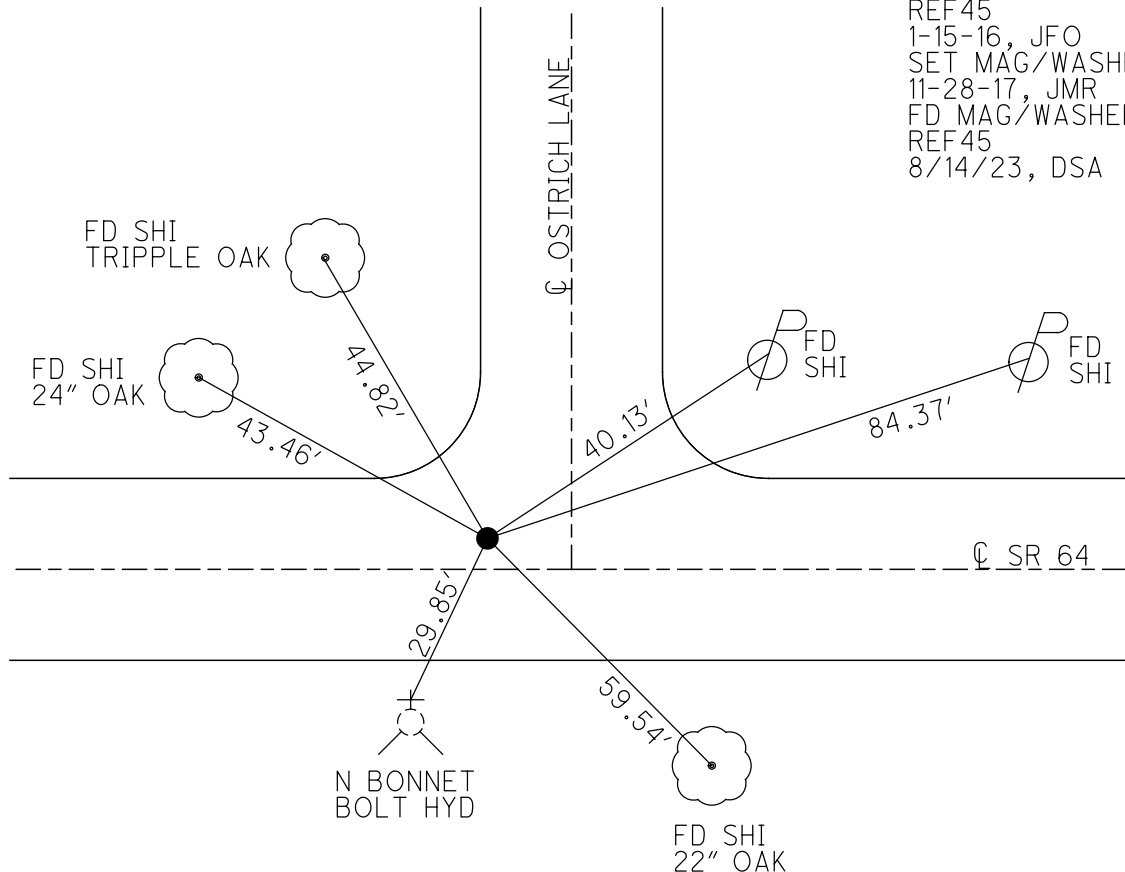

O.D.O.T. DISTRICT 2 SURVEY OFFICE (USE ONLY)

PERSONNEL

REFERENCE NO.

46

SHEET

45

OF 50

NOTES

RHOADES

DATE

6-14-17

ROUTE

SR 64

H.C.

POORE

WEATHER

PT CLOUDY

COUNTY

LUCAS

R.C.

O'DONNELL

TEMP.

72°

TOWNSHIP

WATERVILLE

SECTION

32

T 7 N

R 5 E

TYPE MONUMENT

P.K.WASHER

ON SURFACE - ~~BELOW~~


ON

~~LEFT~~ - CL PAV'T - RIGHT 0.7'

TO EDGE PAVEMENT

S.L.M. 417+12.00

Grid: Northing: 682089.5521 Easting: 1597841.0228

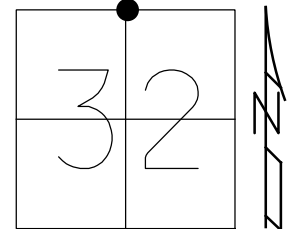

RECORD:

SET P.K.WASHER

6-16-97, SAH

SET P.K.WASHER

6-14-99 BWC


FD P.K.WASHER

REF46

12-30-15, JFO

SET MAG/WASHER

11-28-17, JMR

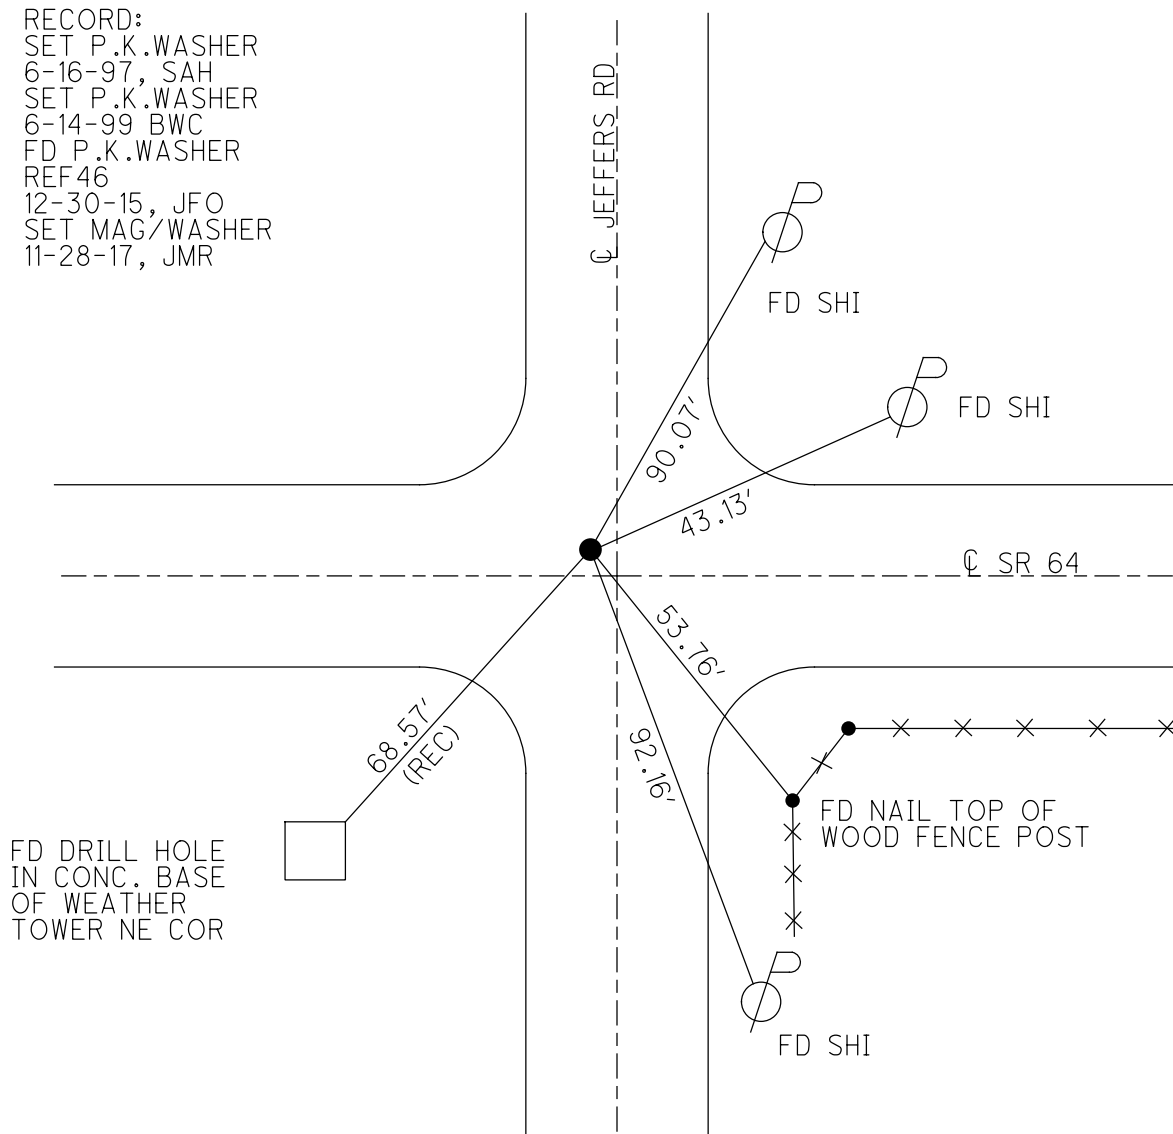

O.D.O.T. DISTRICT 2 SURVEY OFFICE (USE ONLY)

PERSONNEL

REFERENCE NO. 47

SHEET 46 OF 50

NOTES RHOADES

DATE 6-14-17

ROUTE SR 64

H.C. O'DONNELL

WEATHER CLOUDY

COUNTY LUCAS

R.C. POORE

TEMP. 72°

TOWNSHIP WATERVILLE

SECTION 32

T 7 N R 5 E

TYPE MONUMENT P.K.WASHER


ON SURFACE - ~~BELOW~~ ON

LEFT - CL PAV'T - ~~RIGHT~~ 1.6'


TO EDGE PAVEMENT

S.L.M. 443+53.39

Grid: Northing: 682110.5123 Easting: 1595199.7119

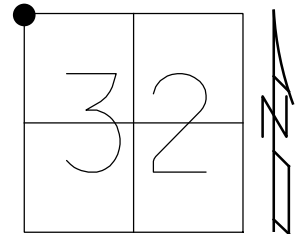

RECORD:
SET P.K.WASHER
6-16-97, SAH
SET P.K.WASHER
6-14-99 BWC
FD P.K.WASHER
REF47
1-15-16, JFO
SET MAG/WASHER
11-28-17, JMR

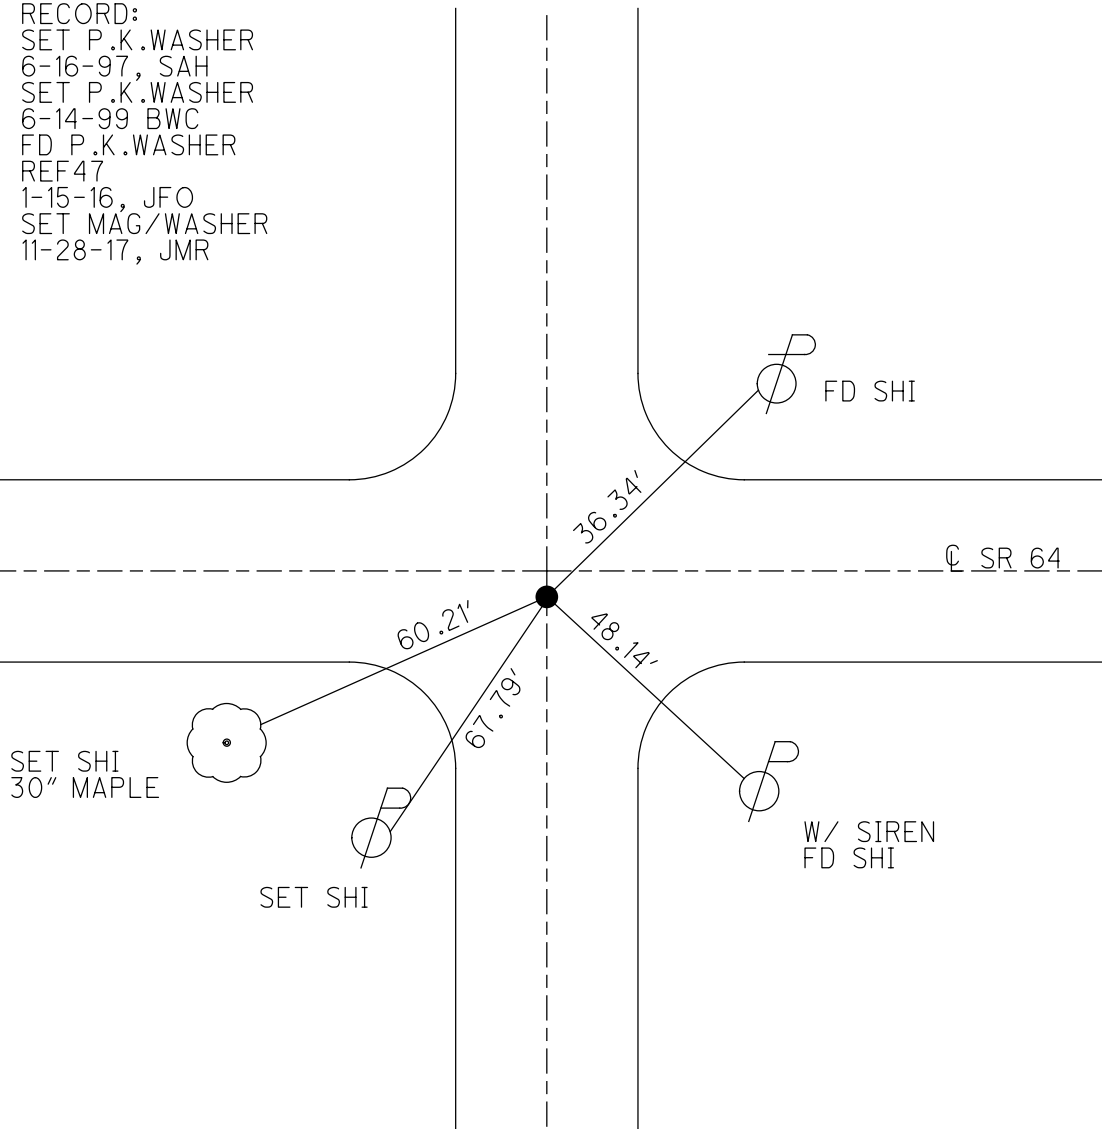

O.D.O.T. DISTRICT 2 SURVEY OFFICE (USE ONLY)

PERSONNEL

REFERENCE NO. 48

SHEET 47 OF 56

NOTES PRESTON-COLVIN

DATE 10-2-24

ROUTE SR 64

H.C.

WEATHER SUNNY

COUNTY LUCAS

R.C.
NIESE

TEMP. 70°

TOWNSHIP SWANTON

DWG BY PRESTON-COLVIN PID PAVING TRAIN

SECTION 31

T 7 N R 5 E

TYPE MONUMENT MAG/WASHER

ON SURFACE - BELOW ON

OFFSET $\mathcal{C}$ PAVEMENT ON LT : RT

- TO - EDGE PAVEMENT

STATION: 470+33.36

HORIZ.DATUM: NAD83 (2011)


GEOID: NAVD88 2018

GRID: NORTHING: 682122.953


EASTING: 1592519.793

LDP: NORTHING: 302949.7684

EASTING: 102912.0121

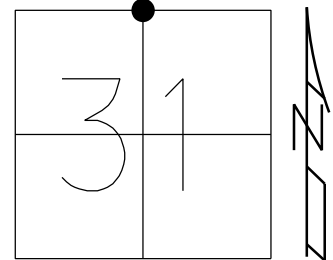

RECORD:
SET MAG/WASHER
10-12-04, MB
FD MAG/WASHER
REF48
1-15-16, JFO
11-28-17, JMR
FD MAG/WASHER
REF48
3-6-2019, JLL
FD MAG/WASHER
NEWREF48
2/6/23, JAM
5/9/23, TDN
2/27/24, JMR
10-2-24, TDN

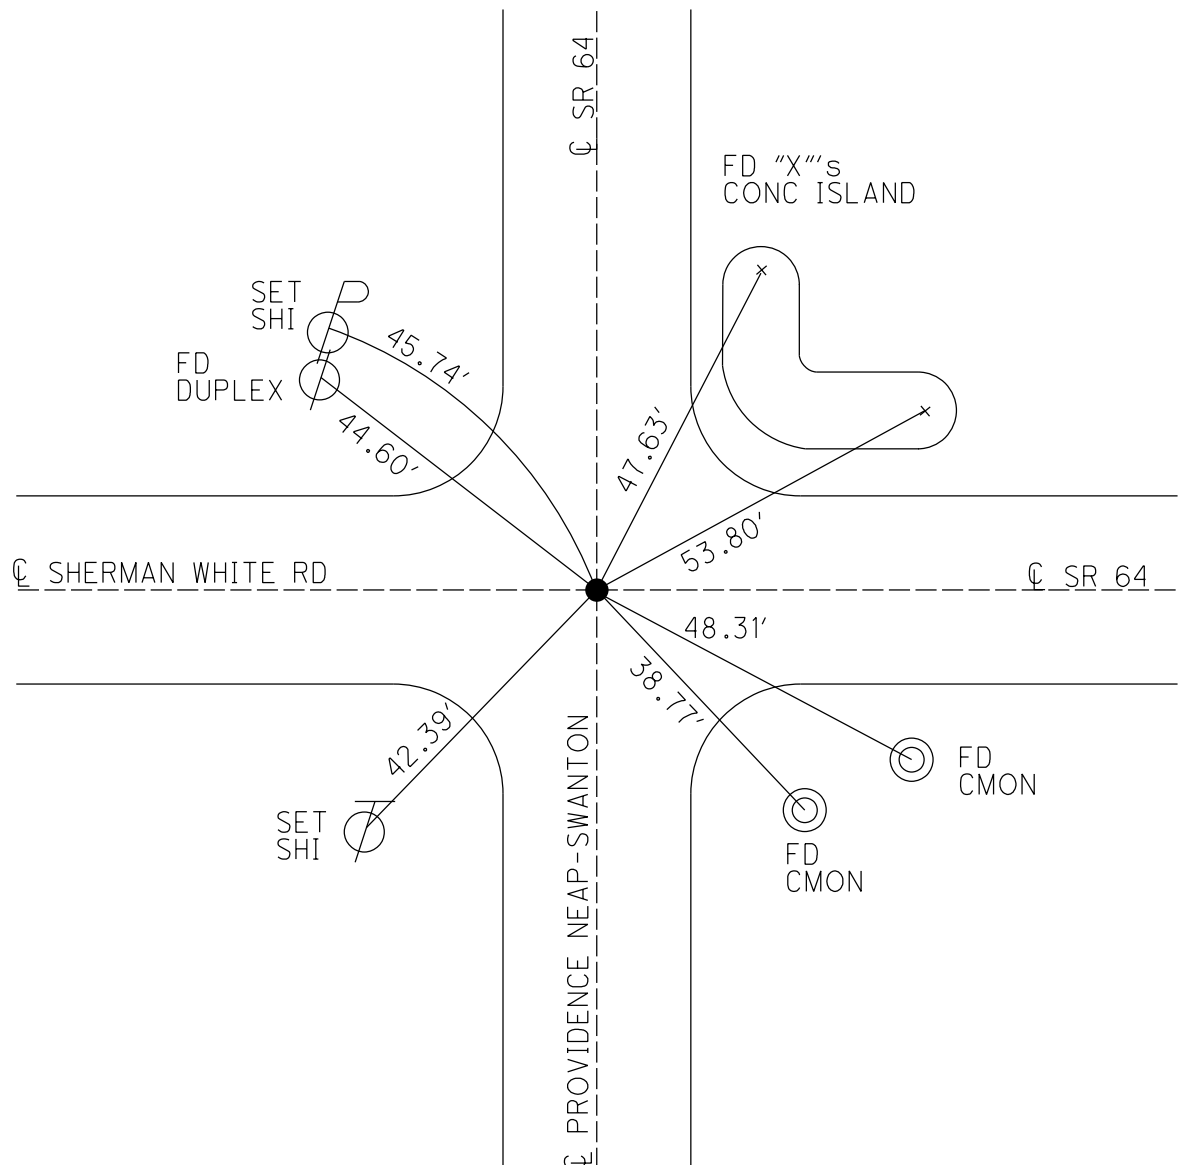

O.D.O.T. DISTRICT 2 SURVEY OFFICE (USE ONLY)

PERSONNEL

REFERENCE NO. 49

SHEET 48 OF 56

NOTES PRESTON-COLVIN

DATE 10-2-24

ROUTE SR 64

H.C.

WEATHER SUNNY

COUNTY LUCAS

R.C.

TEMP. 70°

TOWNSHIP WATERVILLE

NIESE

SECTION 30

DWG BY PRESTON-COLVIN PID PAVING TRAIN

T 7 N R 9 E

TYPE MONUMENT MAG/WASHER

ON SURFACE - BELOW ON

OFFSET Q PAVEMENT 0.5' LT : RT

10' TO LT EDGE PAVEMENT

STATION: 497+11.50

HORIZ.DATUM: NAD83 (2011)


GEOID: NAVD88 2018

GRID: NORTHING: 684800.870


EASTING: 1592554.649

LDP: NORTHING: 305628.0548

EASTING: 102911.6289

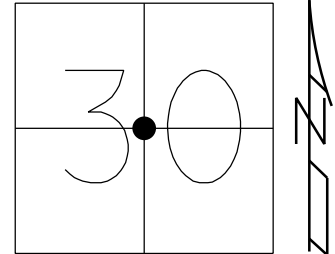

RECORD:
SET MAG/WASHER
10-12-04, MB
FD MAG/WASHER
REF49
1-15-16, JFO
REF49
3-6-19, JLL
REF49
8/23/22, TDN
11/21/22, TDN
FD MAG/WASHER
REF49
2/6/23, JAM
5/9/23, TDN
2/27/24, JMR
10-2-24M, TDN

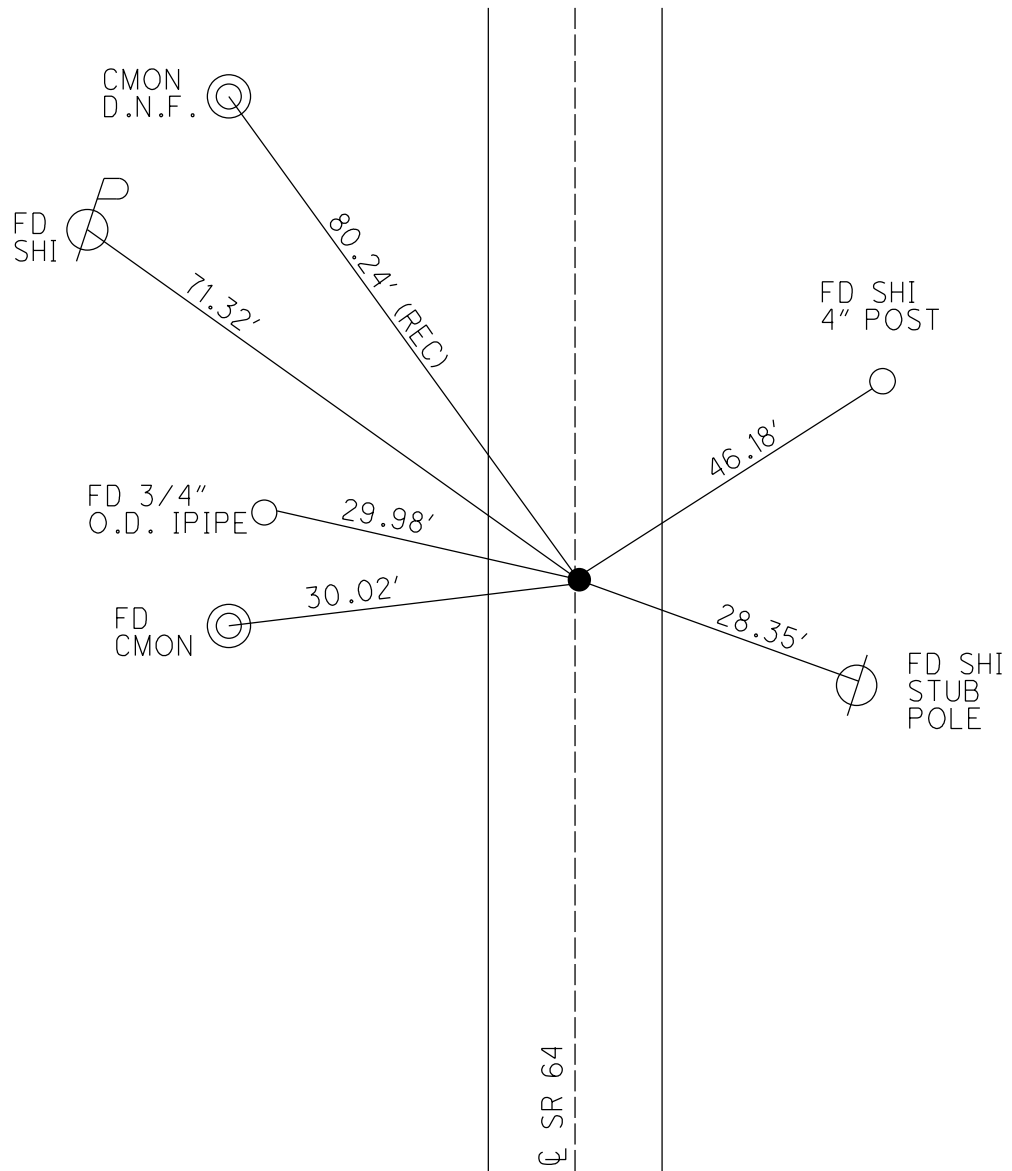

O.D.O.T. DISTRICT 2 SURVEY OFFICE (USE ONLY)

PERSONNEL

REFERENCE NO. 50

SHEET 49 OF 56

NOTES PRESTON-COLVIN

DATE 10-2-24

ROUTE SR 64

H.C.

WEATHER SUNNY

COUNTY LUCAS

R.C.

TEMP. 70°

TOWNSHIP WATERVILLE

NIESE

SECTION 30

DWG BY PRESTON-COLVIN

PID PAVING TRAIN

T 7 N R 9 E

TYPE MONUMENT SHANK

ON SURFACE - BELOW ON

OFFSET $\varnothing$ PAVEMENT 1.0' ~~LT~~ : RT

8.2' TO LT EDGE PAVEMENT

STATION: 523+61.01

HORIZ.DATUM: NAD83 (2011)


GEOID: NAVD88 2018

GRID: NORTHING: 687450.127


EASTING: 1592589.996

LDP: NORTHING: 308277.6859

EASTING: 102912.1132

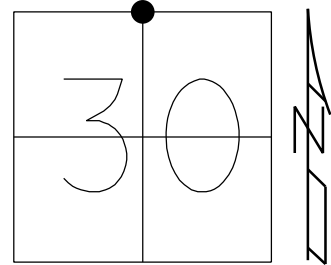

RECORD:
SET MAG/WASHER
10-12-04, MB
FD MAG/WASHER
REF50
1-15-16, JFO
REF50
3-6-19, JLL
REF50
8/23/22, TDN
11/21/22, TDN
FD MAG/WASHER
REF50
2/6/23, JAM
5/9/23, TDN
2/27/24, JMR
FD SHANK
10-2-24, TDN

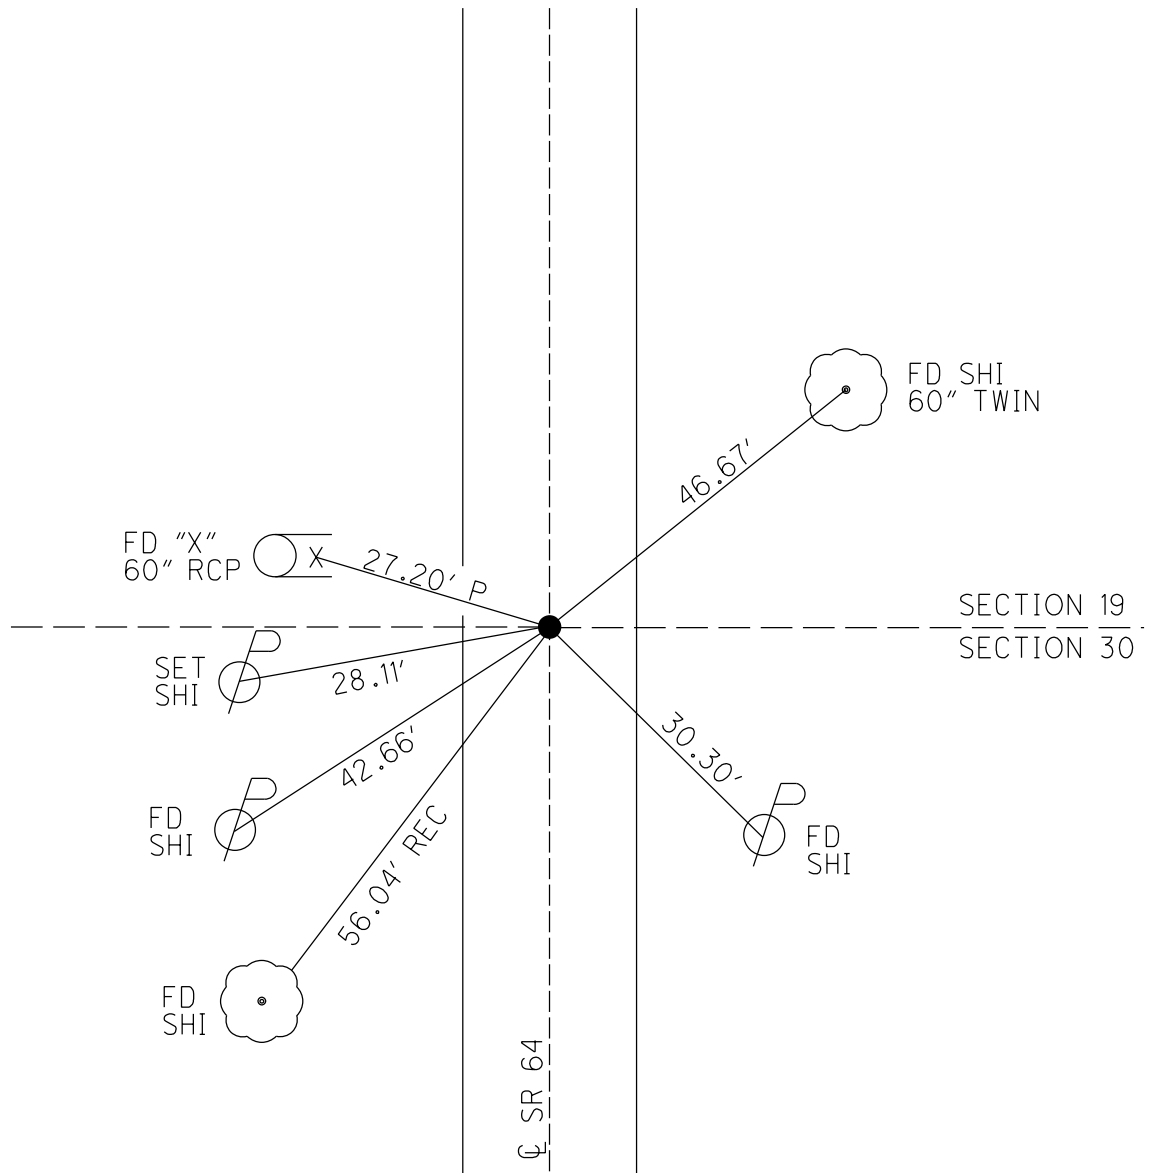

O.D.O.T. DISTRICT 2 SURVEY OFFICE (USE ONLY)

PERSONNEL

REFERENCE NO. 51

SHEET 50 OF 56

NOTES PRESTON-COLVIN

H.C.

R.C.

NIESE

DATE 10-2-24

WEATHER SUNNY

TEMP. 70°

ROUTE SR 64

COUNTY LUCAS

TOWNSHIP WATERVILLE

SECTION 19

DWG BY PRESTON-COLVIN PID PAVING TRAIN

T 7 N R 9 E

TYPE MONUMENT MAG/WASHER

ON SURFACE - BELOW ON

OFFSET $\varnothing$ PAVEMENT 1.2' $\perp$: RT

- TO - EDGE PAVEMENT

STATION: 536+83.88

HORIZ.DATUM: NAD83 (2011)


GEOID: NAVD88 2018

GRID: NORTHING: 688772.742


EASTING: 1592617.302

LDP: NORTHING: 309600.6136

EASTING: 102922.0141

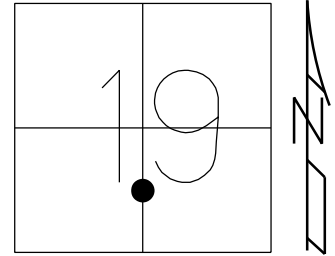

RECORD:
SET MAG/WASHER
10-12-04, MB
FD MAG/WASHER
REF51
1-15-16, JFO
REF51
6-6-19, JLL
REF51
8/23/22, TDN
11/21/22, TDN
FD MAG/WASHER
REF51
2/6/23, JAM
5/9/23, TDN
2/27/24, JMR
10-2-24, TDN

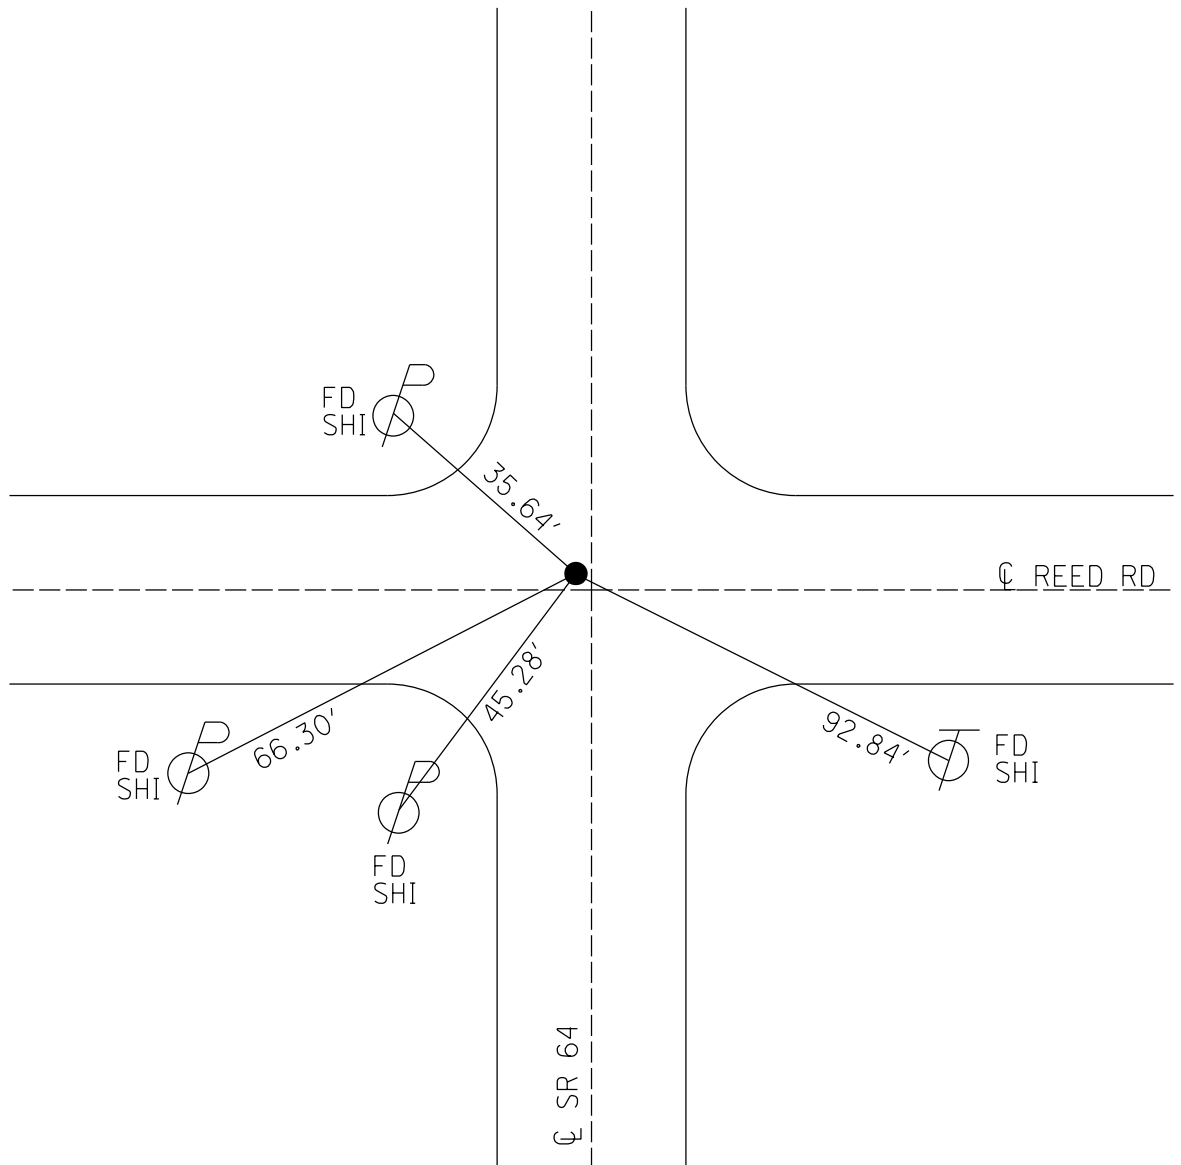

O.D.O.T. DISTRICT 2 SURVEY OFFICE (USE ONLY)

PERSONNEL

REFERENCE NO. 52

SHEET 51 OF 56

NOTES PRESTON-COLVIN

DATE 10-2-24

ROUTE SR 64

H.C.

WEATHER SUNNY

COUNTY LUCAS

R.C.

TEMP. 70°

TOWNSHIP SWANTON

NIESE

SECTION 19

DWG BY PRESTON-COLVIN PID PAVING TRAIN

T 7 N R 9 E

TYPE MONUMENT MAG/WASHER

ON SURFACE - BELOW ON

OFFSET $\odot$ PAVEMENT 1.5' LT : ~~RT~~

8.8' TO LT EDGE PAVEMENT

STATION: 550+06.39

HORIZ.DATUM: NAD83 (2011)


GEOID: NAVD88 2018

GRID: NORTHING: 690094.953


EASTING: 1592644.632

LDP: NORTHING: 310923.1373

EASTING: 102931.9441

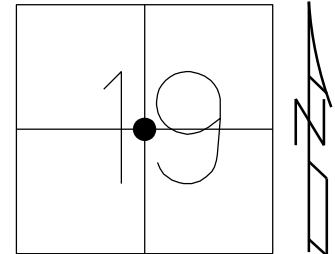

RECORD:
SET MAG/WASHER
10-12-04, MB
FD MAG/WASHER
REF52
3-6-19, JLL
REF52
8/23/22, TDN
11/21/22, TDN
FD MAG/WASHER
REF52
2/6/23, JAM
5/9/23, TDN
2/27/24, JMR
10-2-24, TDN

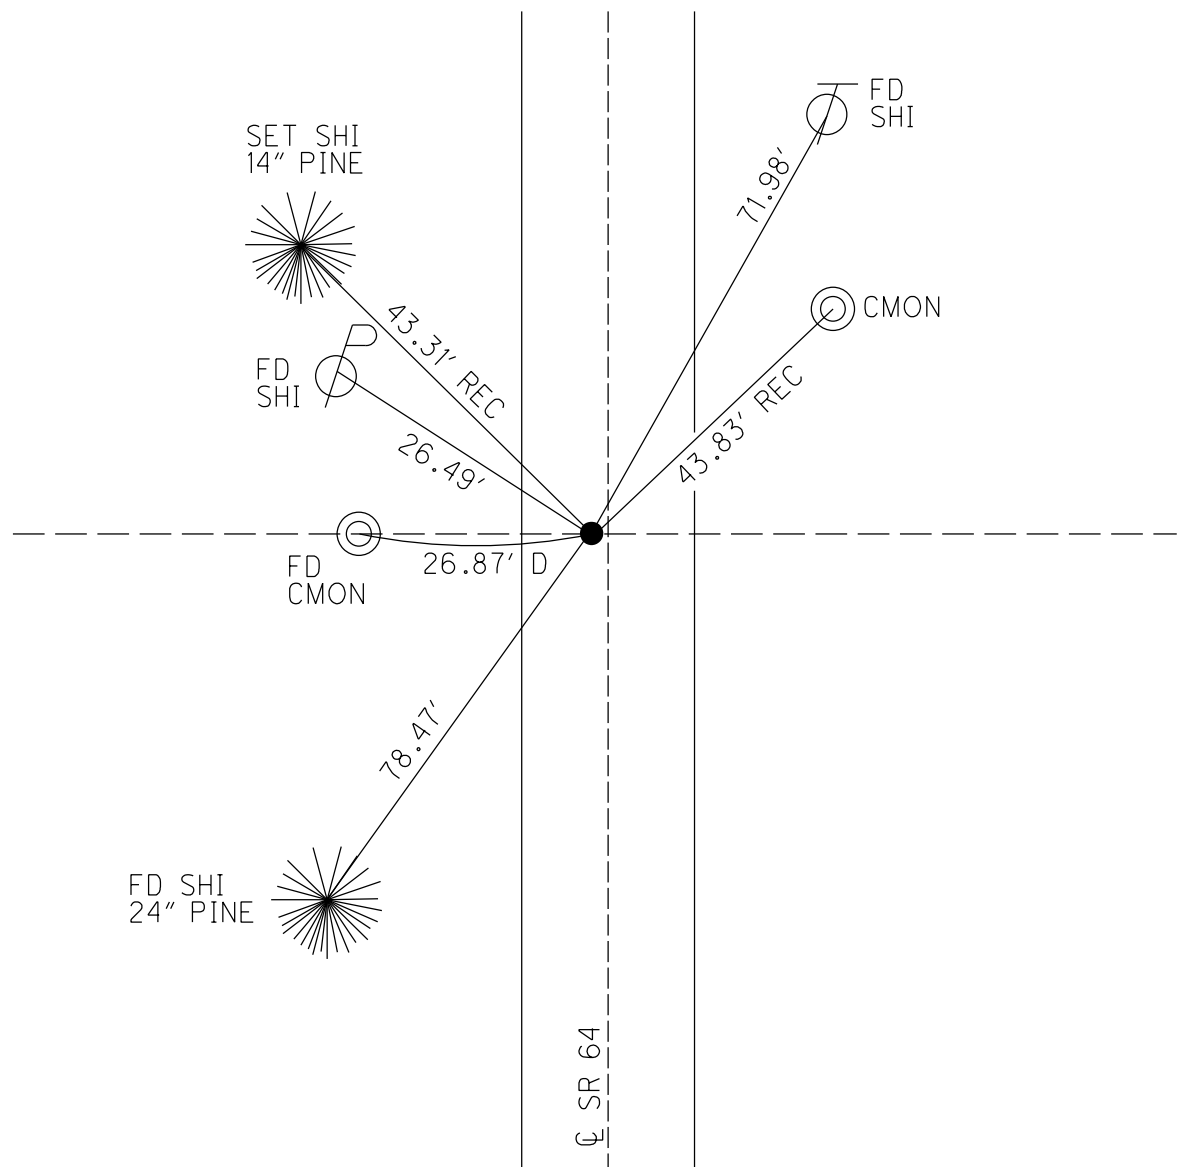

O.D.O.T. DISTRICT 2 SURVEY OFFICE (USE ONLY)

PERSONNEL

REFERENCE NO. 53

SHEET 52 OF 56

NOTES PRESTON-COLVIN

DATE 10-2-24

ROUTE SR 64

H.C.

WEATHER SUNNY

COUNTY LUCAS

R.C.

TEMP. 70°

TOWNSHIP SWANTON

NIESE

SECTION 19

DWG BY PRESTON-COLVIN

PID PAVING TRAIN

T 7 N R 9 E

TYPE MONUMENT MAG/WASHER

ON SURFACE - BELOW ON

OFFSET Q PAVEMENT 1.0' LT : RT

8.9' TO LT EDGE PAVEMENT

STATION: 569+90.12

HORIZ.DATUM: NAD83 (2011)


GEOID: NAVD88 2018

GRID: NORTHING: 692078.244


EASTING: 1592686.588

LDP: NORTHING: 312906.9073

EASTING: 102947.8001

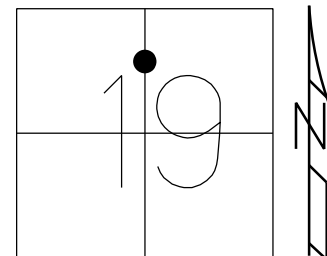

RECORD:
SET MAG/WASHER
10-12-04, MB
FD MAG/WASHER
REF53
3-6-19, JLL
REF53
8/23/22, TDN
11/21/22, TDN
FD MAG/WASHER
REF53
2/6/23, JAM
5/9/23, TDN
2/27/24, JMR
FD MAG/WASHER
10-2-24, TDN

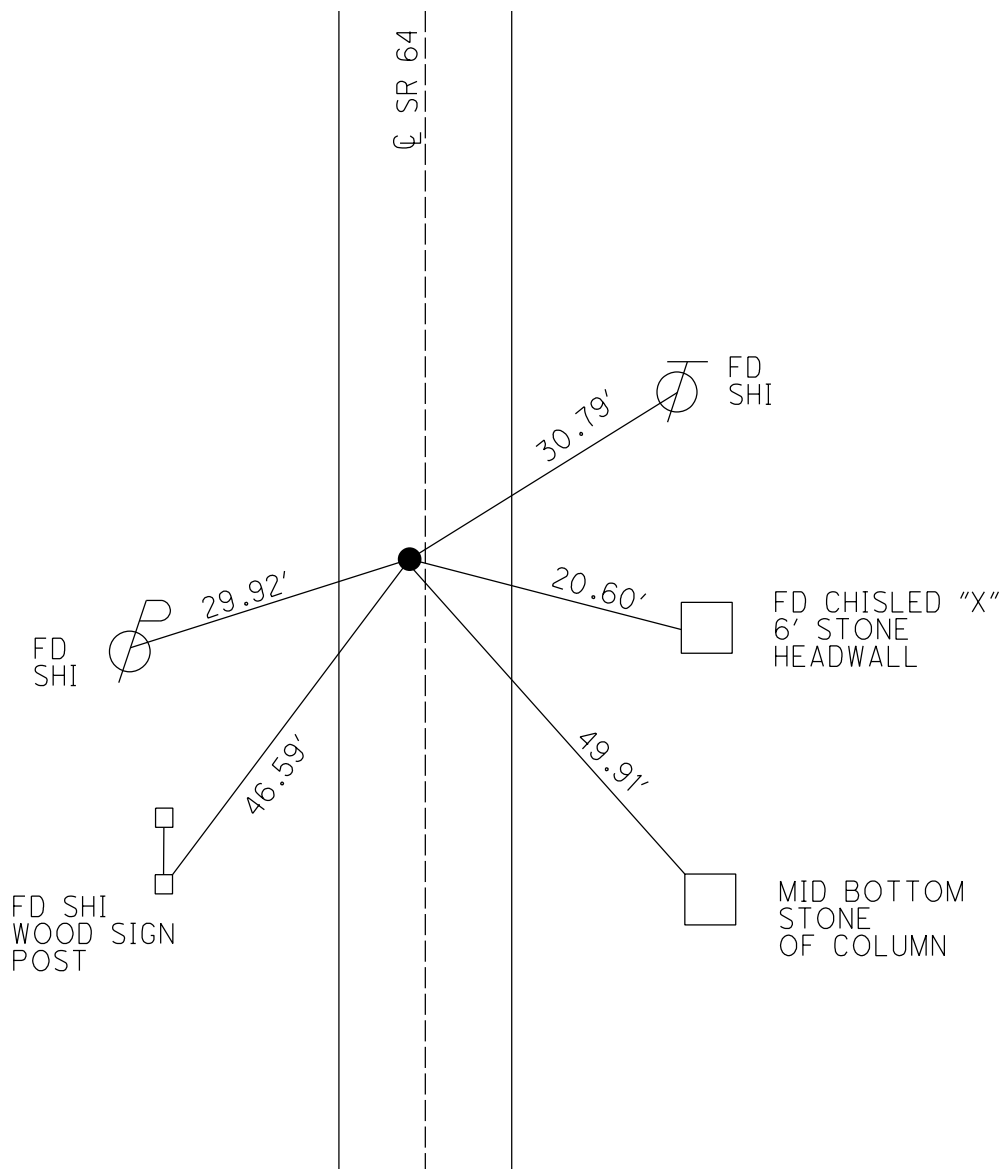

O.D.O.T. DISTRICT 2 SURVEY OFFICE (USE ONLY)

PERSONNEL

REFERENCE NO. 54

SHEET 53 OF 56

NOTES PRESTON-COLVIN

DATE 10-2-24

ROUTE SR 64

H.C.

WEATHER SUNNY

COUNTY LUCAS

R.C.

TEMP. 70°

TOWNSHIP SWANTON

NIESE

SECTION 19

DWG BY PRESTON-COLVIN

PID PAVING TRAIN

T 7 N R 5 E

TYPE MONUMENT SHANK

ON SURFACE - BELOW ON

OFFSET $\mathcal{C}$ PAVEMENT 0.9' ~~LT~~ : RT

- TO - EDGE PAVEMENT

STATION: 576+52.27

HORZ.DATUM: NAD83 (2011)


GEOID: NAVD88 2018

GRID: NORTHING: 692740.240


EASTING: 1592700.807

LDP: NORTHING: 313569.0662

EASTING: 102953.3079

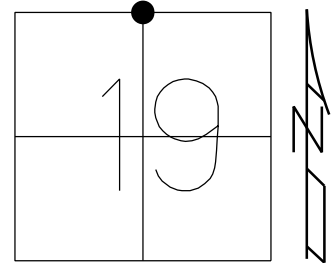

RECORD:
SET MAG/WASHER
10-12-04, MB
FD MAG/WASHER
REF54
3-6-19, JLL
FD MAG SHANK
REF54
8/23/22, TDN
11/21/22, TDN
FD MAG SHANK
REF54
2/6/23, JAM
5/9/23, TDN
2/27/24, JMR
FD SHANK
10-2-24, TDN

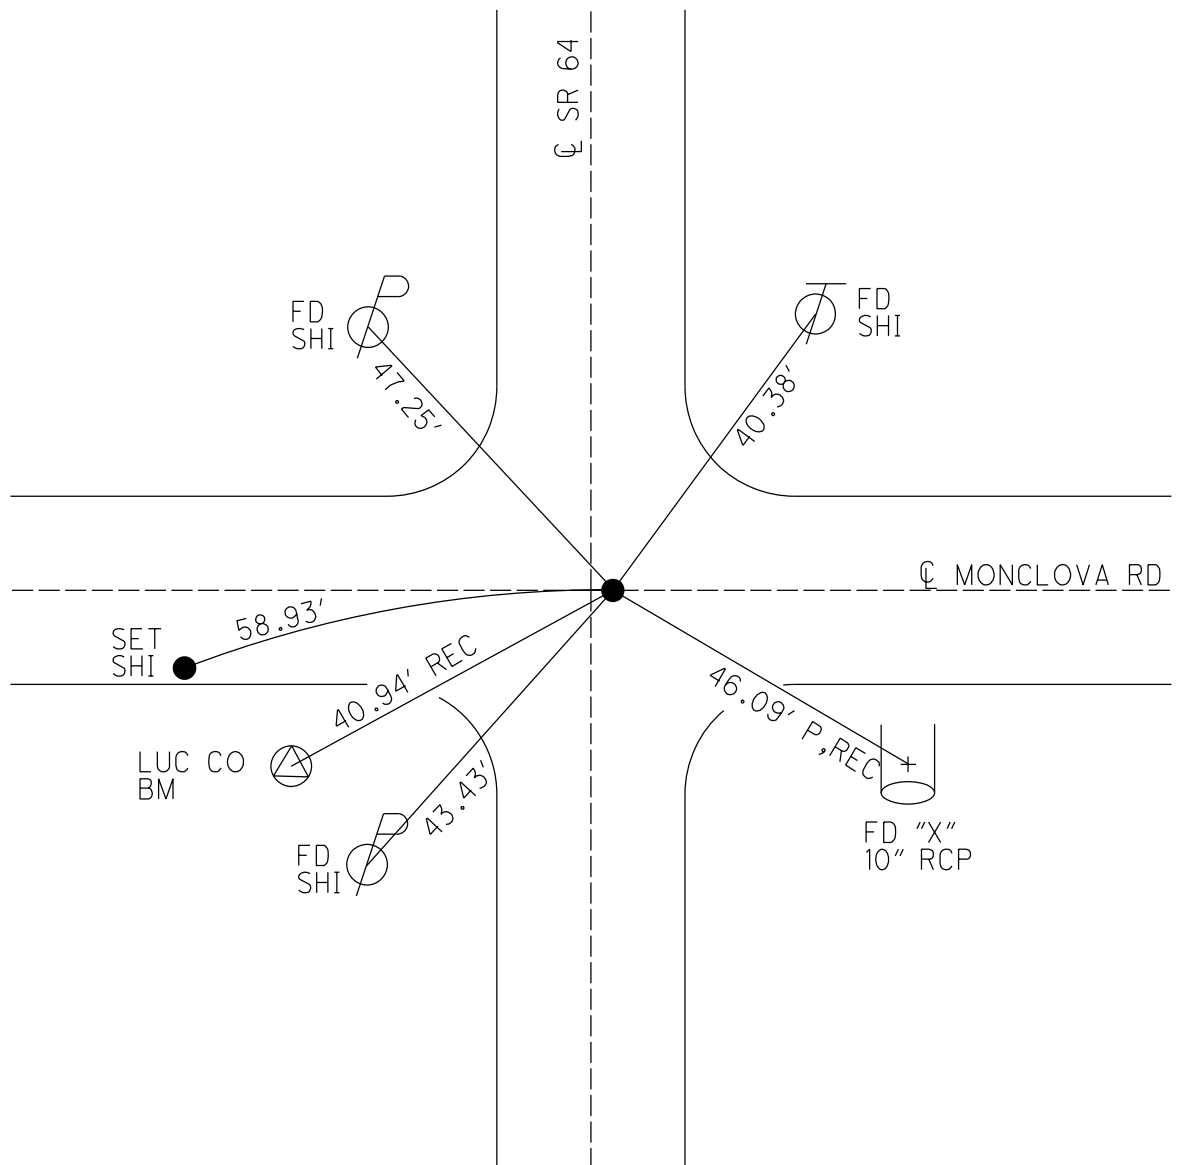

O.D.O.T. DISTRICT 2 SURVEY OFFICE (USE ONLY)

PERSONNEL

REFERENCE NO. 55

SHEET 54 OF 56

NOTES NIESE DATE 5/9/23
H.C. AUBLE WEATHER SUNNY
R.C. ASTON TEMP. 65°

ROUTE SR 64
COUNTY LUCAS
TOWNSHIP SWANTON
SECTION 18
T 7 N R 9 E

DWG BY RHOADES PID PAVING TRAIN

TYPE MONUMENT MAG/WASHER

ON SURFACE - ~~BELOW~~ ON

OFFSET Q PAVEMENT ON LT : RT

9.7 TO RT EDGE PAVEMENT



STATION: 603+14.73

HORZ.DATUM: NAD83 (2011)

GEOID: NAVD88 2018

GRID: NORTHING: 695402.425

EASTING: 1592739.173

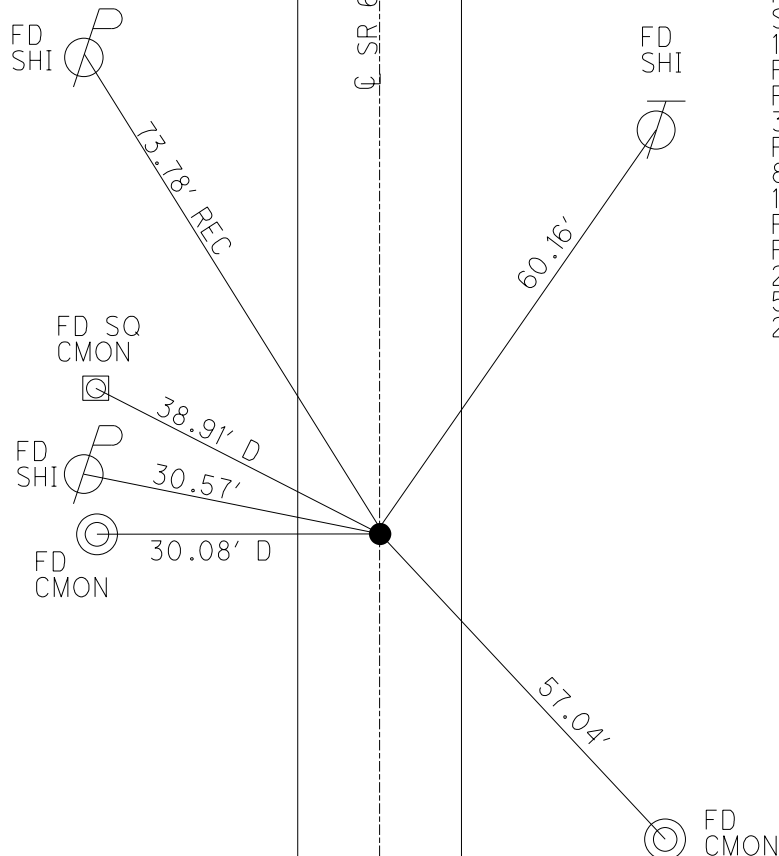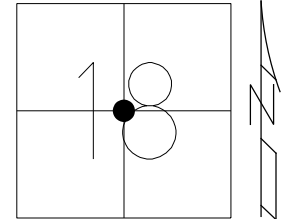

RECORD:
SET MAG/WASHER
10-12-04, MB
FD MAG/WASHER
REF55
3-6-19, JLL
REF55
8/23/22, TDN
11/21/22, TDN
FD MAG/WASHER
REF55
2/6/23, JAM
5/9/23, TDN
2/27/24, JMR

O.D.O.T. DISTRICT 2 SURVEY OFFICE (USE ONLY)

PERSONNEL

REFERENCE NO. 56

SHEET 55 OF 56

NOTES NIESE DATE 5/9/23

H.C. AUBLE WEATHER SUNNY

R.C. ASTON TEMP. 60°

ROUTE SR 64

COUNTY LUCAS

TOWNSHIP SWANTON

SECTION 18

DWG BY RHOADES PID PAVING TRAIN

T 7 N R 9 E

TYPE MONUMENT MAG/WASHER

ON SURFACE - ~~BELOW~~ ON

OFFSET CL PAVEMENT 1.3' LT : ~~RT~~

8.4 TO LT EDGE PAVEMENT



STATION: 629+74.03

HORIZ.DATUM: NAD83 (2011)

GEOID: 2012A

GRID: NORTHING: 698061.617

EASTING: 1592758.940

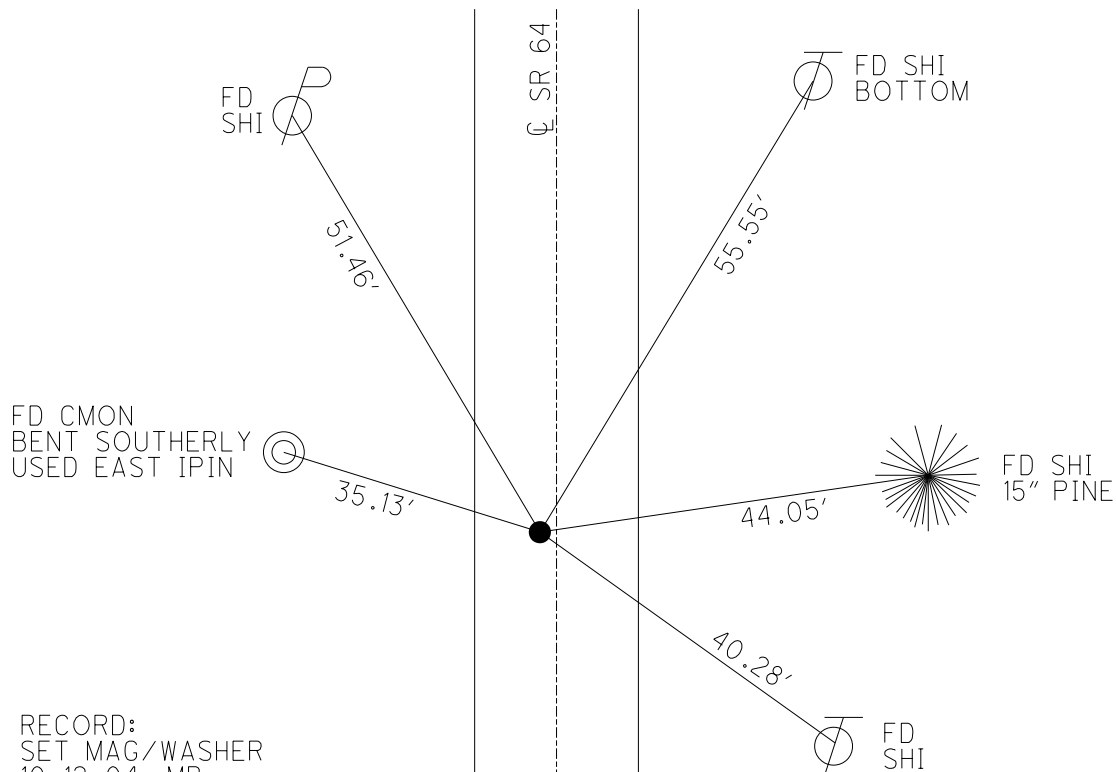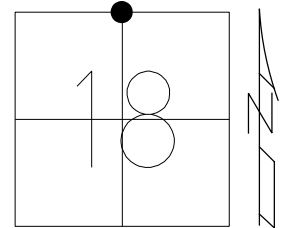

RECORD:
SET MAG/WASHER
10-12-04, MB
FD MAG/WASHER
REF56
3-6-19, JLL
REF56
8/23/22, TDN
11/21/22, TDN
FD MAG/WASHER
REF56
2/6/23, JAM
5/9/23, TDN
2/27/24, JMR

O.D.O.T. DISTRICT 2 SURVEY OFFICE (USE ONLY)

PERSONNEL

REFERENCE NO. 57

SHEET 56 OF 56

NOTES BALBAUGH

DATE 5/11/20

ROUTE SR 64

H.C. LEU

WEATHER CLOUDY

COUNTY LUCAS

R.C. AUBLE

TEMP. 39°

TOWNSHIP SWANTON

DWG BY GARRETT

PID 107059

SECTION 7

T 7 N R 5 E

TYPE MONUMENT MAG/WASHER

ON SURFACE - ~~BELOW~~ ON

OFFSET Q PAVEMENT ON LT : RT

- TO - EDGE PAVEMENT


STATION: 655+24

HORZ.DATUM: NAD83(2011)

GEOID: 2012A

GRID: NORTHING: 700674.256

EASTING: 1592809.771

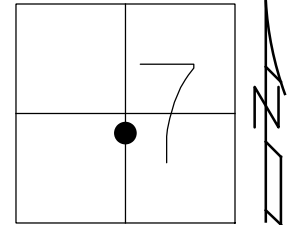

RECORD:
FD MOBORA MON.
6/15/03 DCH
SET MAG/WASHER
1/13/04, DCH
FD MOBORA MON
2" DOWN
REF2
7/29/16
SET MAG/WASHER
NEWREF2
10/05/16, JFO

NOTE:
US 2 REF2

