

O.D.O.T. DISTRICT 2 SURVEY OFFICE (USE ONLY)

PERSONNEL

REFERENCE NO. 48

SHEET 47 OF 56

NOTES PRESTON-COLVIN

DATE 10-2-24

ROUTE SR 64

H.C.

WEATHER SUNNY

COUNTY LUCAS

R.C.

TEMP. 70°

TOWNSHIP SWANTON

NIESE

SECTION 31

DWG BY PRESTON-COLVIN PID PAVING TRAIN

T 7 N R 5 E

TYPE MONUMENT MAG/WASHER

ON SURFACE - BELOW ON

OFFSET $\mathcal{C}$ PAVEMENT ON LT : RT

- TO - EDGE PAVEMENT

STATION: 470+33.36

HORIZ.DATUM: NAD83 (2011)


GEOID: NAVD88 2018

GRID: NORTHING: 682122.953


EASTING: 1592519.793

LDP: NORTHING: 302949.7684

EASTING: 102912.0121

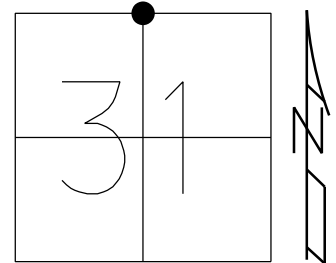

RECORD:
SET MAG/WASHER
10-12-04, MB
FD MAG/WASHER
REF48
1-15-16, JFO
11-28-17, JMR
FD MAG/WASHER
REF48
3-6-2019, JLL
FD MAG/WASHER
NEWREF48
2/6/23, JAM
5/9/23, TDN
2/27/24, JMR
10-2-24, TDN

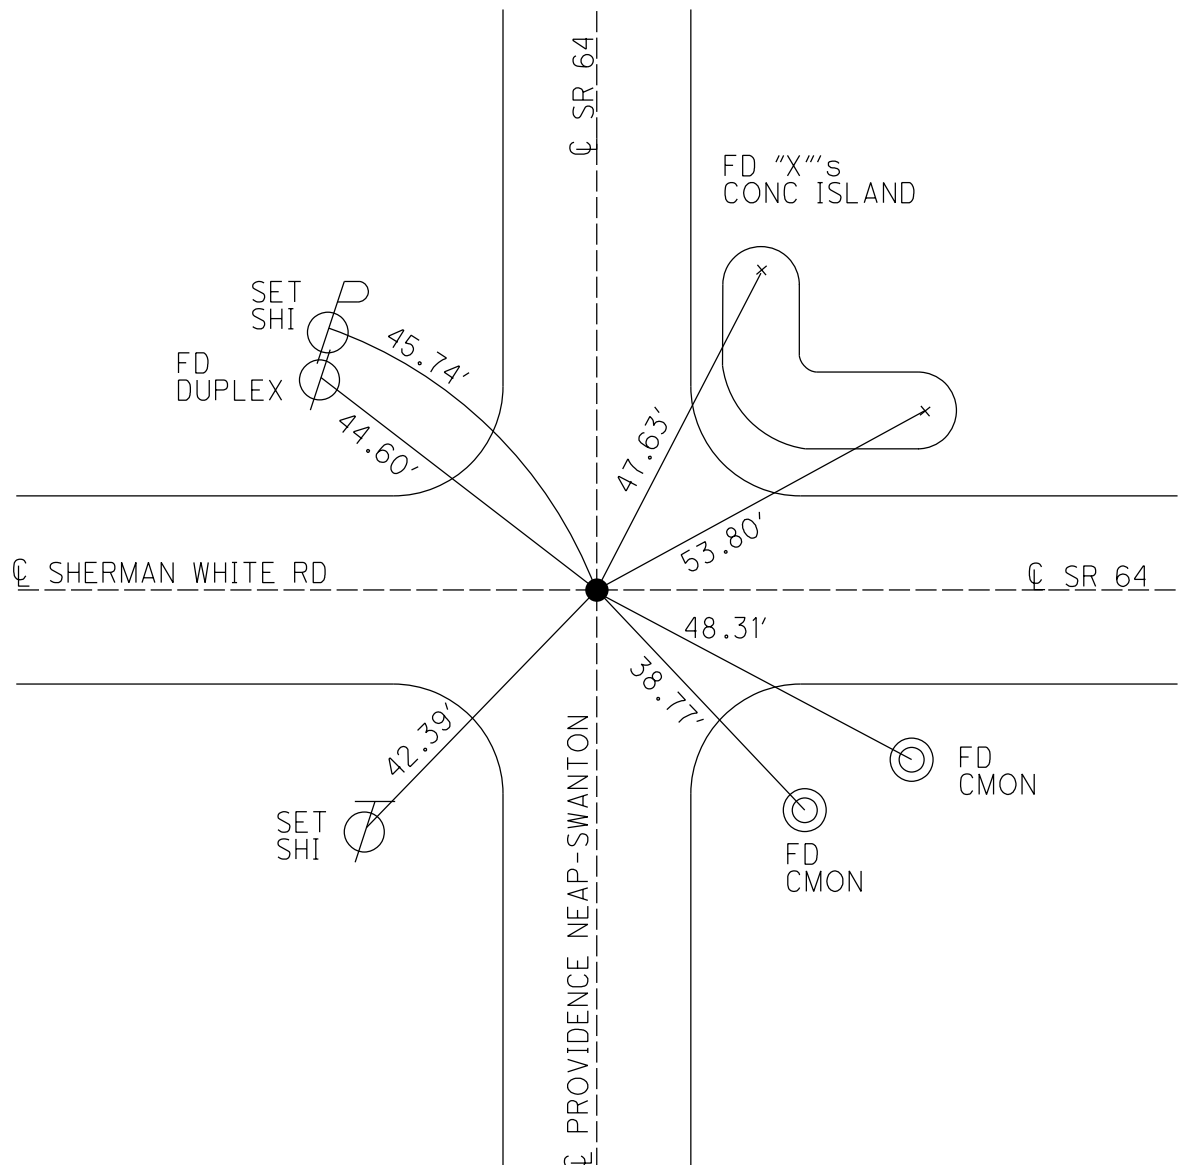

O.D.O.T. DISTRICT 2 SURVEY OFFICE (USE ONLY)

PERSONNEL

REFERENCE NO. 48

SHEET 47 OF 56

NOTES NIESE DATE 5/9/23

H.C. AUBLE WEATHER SUNNY

R.C. ASTON TEMP. 56°

ROUTE SR 64

COUNTY LUCAS

TOWNSHIP SWANTON

SECTION 31

DWG BY RHOADES PID PAVING TRAIN

T 7 N R 5 E

TYPE MONUMENT MAG/WASHER

ON SURFACE - ~~BELOW~~ ON

OFFSET Q PAVEMENT ON LT : RT

- TO - EDGE PAVEMENT



STATION: 470+33.36

HORIZ.DATUM: NAD83 (2011)

GEOID: NAVD88 2018

GRID: NORTHING: 682122.953

EASTING: 1592519.793

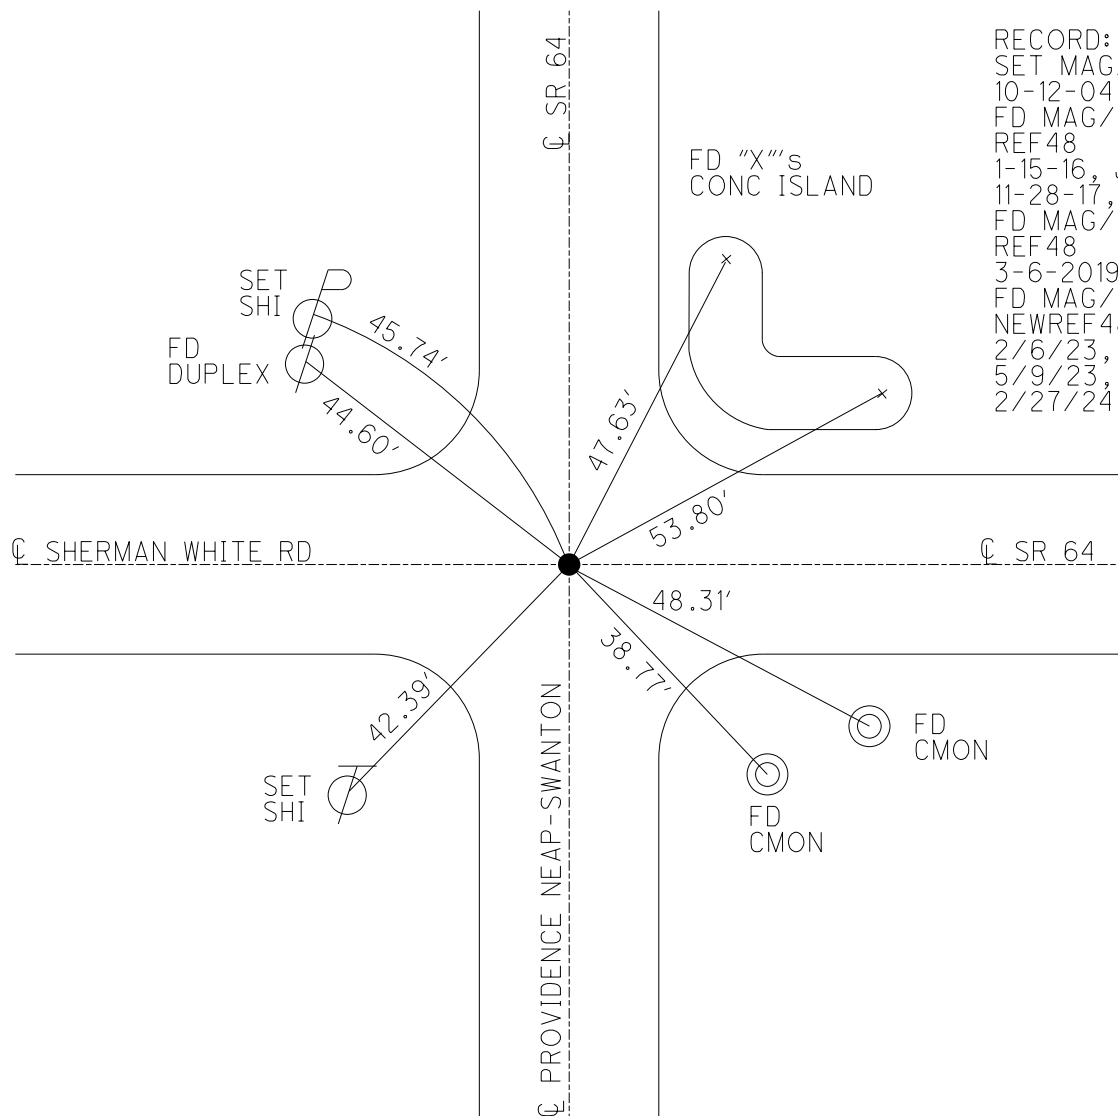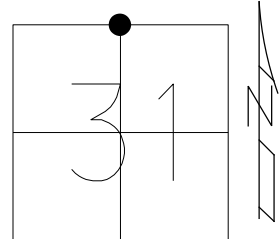

RECORD:
SET MAG/WASHER
10-12-04, MB
FD MAG/WASHER
REF48
1-15-16, JFO
11-28-17, JMR
FD MAG/WASHER
REF48
3-6-2019, JLL
FD MAG/WASHER
NEWREF48
2/6/23, JAM
5/9/23, TDN
2/27/24, JMR

O.D.O.T. DISTRICT 2 SURVEY OFFICE (USE ONLY)

PERSONNEL

REFERENCE NO. 48

SHEET 47 OF 56

NOTES RHOADES

DATE 6/14/17

ROUTE SR 64

H.C. O'DONNELL

WEATHER CLOUDY

COUNTY LUCAS

R.C. POORE

TEMP. 72°

TOWNSHIP WATERVILLE

DWG BY GARRETT PID 107059

SECTION 31

T 7 N R 5 E

TYPE MONUMENT MAG/WASHER

ON SURFACE - ~~BELOW~~ ON

OFFSET Q PAVEMENT ON LT : RT

- TO - EDGE PAVEMENT



STATION: 470+33.36

HORIZ.DATUM: NAD83 (2011)

GEOID: 2012A

GRID: NORTHING: 682122.953

EASTING: 1592519.793

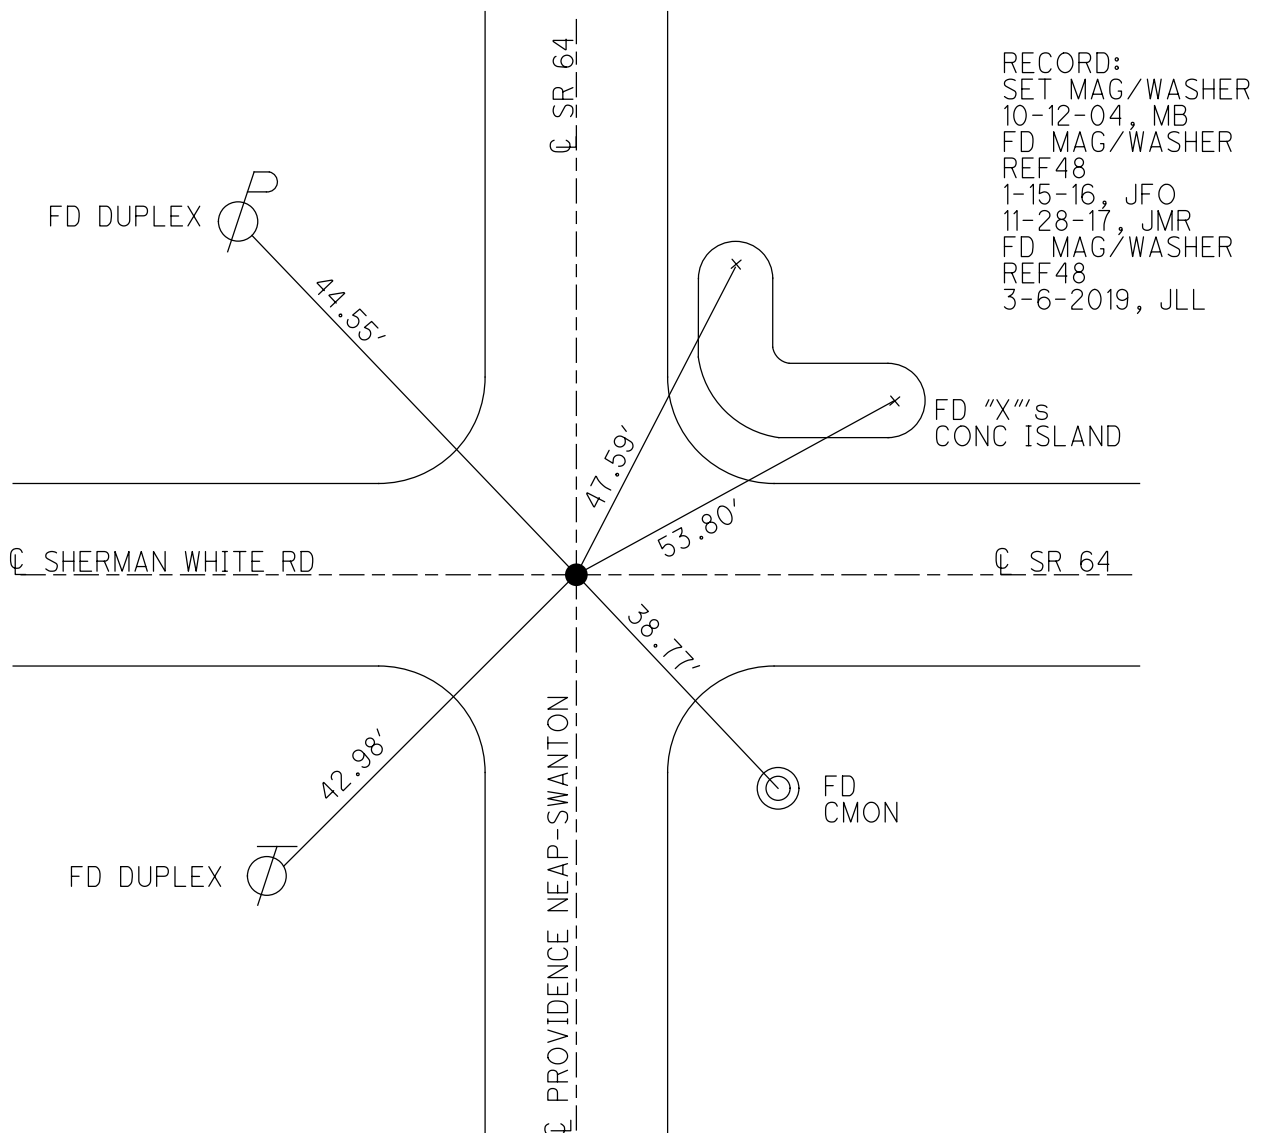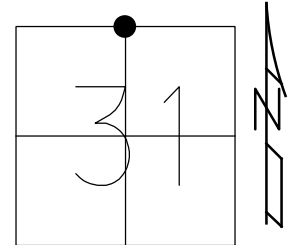


O.D.O.T. DISTRICT 2 SURVEY OFFICE (USE ONLY)


PERSONNEL _____ REFERENCE NO. 48 SHEET 47 OF 50
NOTES RHOADES DATE 6-14-17 ROUTE SR 64
H.C. O'DONNELL WEATHER CLOUDY COUNTY LUCAS
R.C. POORE TEMP. 72° TOWNSHIP WATERVILLE
SECTION 31
T 7 N R 5 E

TYPE MONUMENT MAG/ WASHER
ON SURFACE - ~~BELOW~~ ON
~~LEFT~~ - Q PAV'T - ~~RIGHT~~ ON
TO EDGE PAVEMENT
S.L.M. 470+33.36

Grid: Northing: 682123.0332 Easting: 1592519.7723

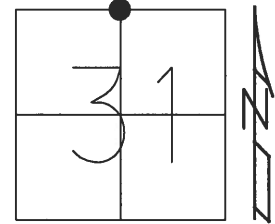

N¹/₄COR SECT 31

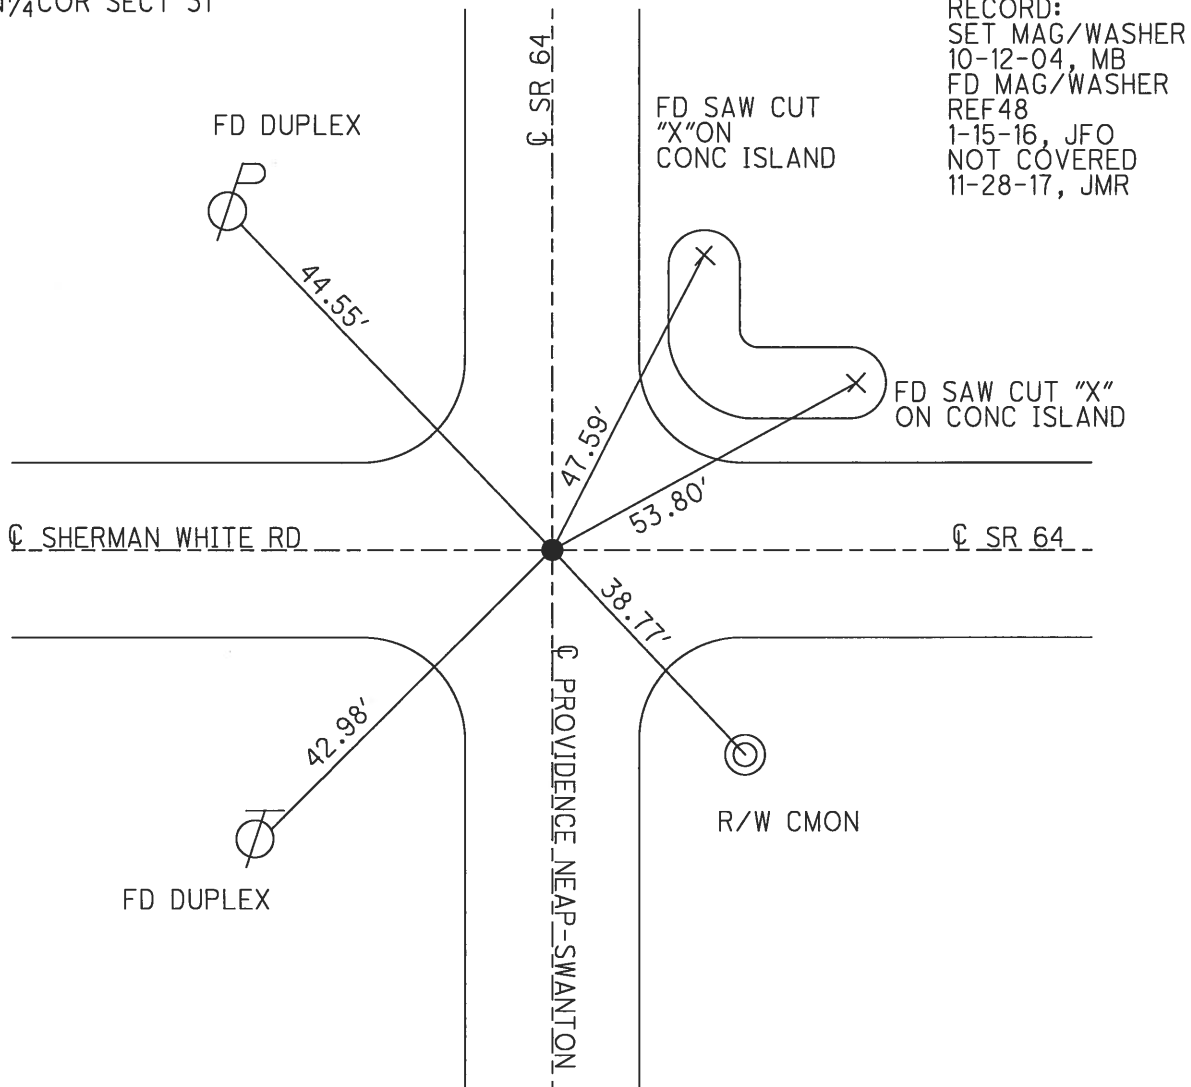

O.D.O.T. DISTRICT 2 SURVEY OFFICE

PERSONNEL

NOTES _____
H.C. _____
R.C. _____


REFERENCE NO. 48

DATE 6-17-04
WEATHER CLOUDY
TEMP. 78°

SHEET 1 OF 10

ROUTE SR 64
COUNTY LUCAS
TOWNSHIP SWANTON
SECTION 31
T 7 N R 5 E

TYPE MONUMENT _____ RR SPIKE
ON SURFACE - ~~BELOW~~ _____ YES
~~LEFT~~ - Q PAV'T ~~RIGHT~~ _____ YES
_____ TO _____ EDGE PAVEMENT
S.L.M. _____ 470+98

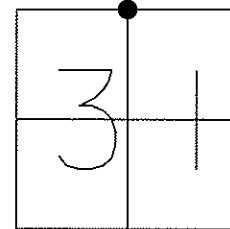

N $\frac{1}{4}$ COR SEC 31

SET MAG NAIL
& WASHER
10-12-04
MB

FD DUPLEX
NAIL



44.61'

Q SR 64
Pavement

SAWED "X" CUT
ON CONC ISLAND

47.60'

53.80'

SAWED "X" CUT
ON CONC ISLAND

Q SHERMAN WHITE RD

Q SR 64

Q PROVIDENCE - NEAP - SWANTON

42.98'

FD DUPLEX
NAIL



Resurfaced 2004

O.D.O.T. DISTRICT 2 SURVEY OFFICE

PERSONNEL

REFERENCE NO. 48

SHEET 1 OF 9

NOTES D. CURTIS

H.C. J. HOUSEHOLDER

R.C. _____

DATE 9-25-86

WEATHER CLOUDY

TEMP. 70°

ROUTE S.R. 64

COUNTY LUCAS

TOWNSHIP SWANTON

SECTION 31

T _____ R _____


TYPE MONUMENT R.R. SPK.

ON SURFACE - BELOW ON SURFACE


LEFT - CL PAV'T. - RIGHT _____

_____ TO _____ EDGE PAVEMENT

S.L.M. _____

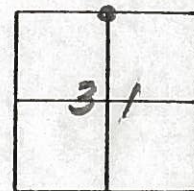

N. $\frac{1}{4}$ COR. SEC. 31

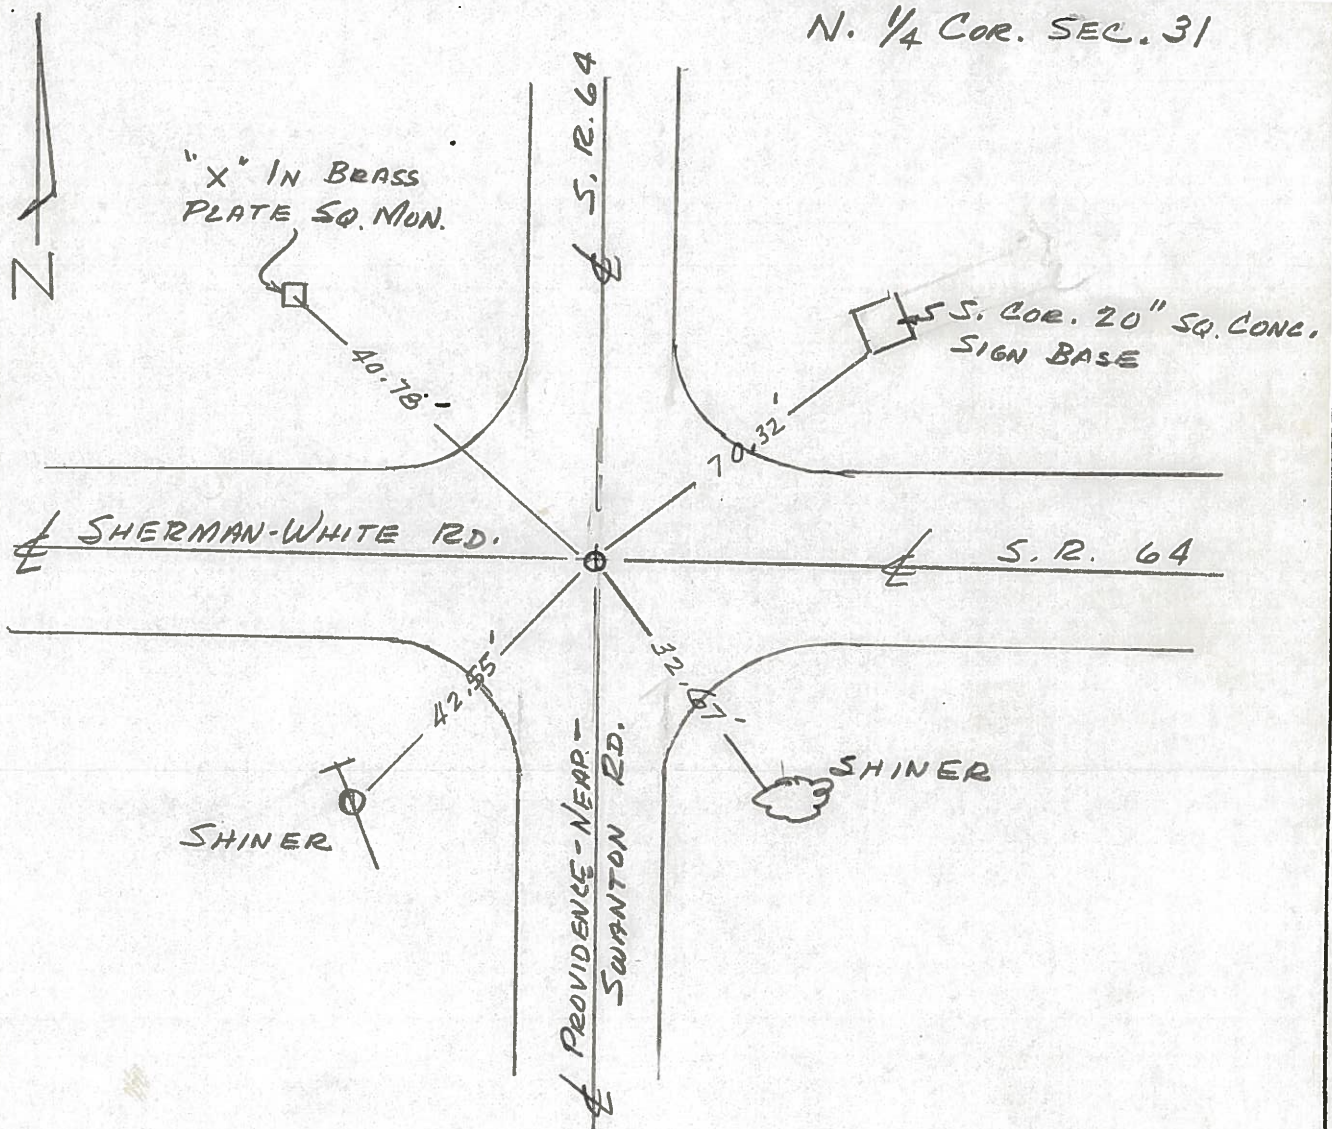

ODOT. DISTRICT 2 SURVEY OFFICE

SHEET 7 OF

County LUCAS S.R. 64

Township SWANTON

Section 31

T7N, R5E

Personnel S. Hoffman


C. Lockke

J. Householder

Date 5-22-81

Weather Clear

Temp. 80°

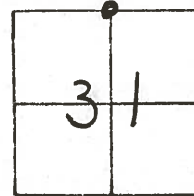

#48

Fd R.R. SPK / "t" @
Surface

SQUARE MON
BRASS PLATE / "X"

WEST
Guard Rail
Post
Shiner SE/S

S. Westerly Edge
20" SQUARE CON.
SIGN BASE (MARATHON)
@ Ground Level

Sherman-White Rd.

64

Shiner
NE/S


SET P.K. NAIL ON OUR

REF. TIES - OVER A GOOD

READING WITH SCHONSTEDT

10-28-81

SWH

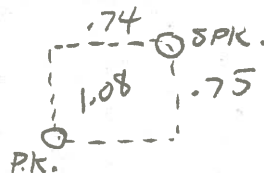


FD. R.R. SPK / t

10-28-81

SWH

SHEET NO. 26

PERSONNEL TITLE PERSONNEL TITLE COUNTY Lucas DATE 17 Nov. 77
Stone Granatg
Michaelok S. R. 64 WEATHER Cool
Neuse SEC. TEMP. 72°
Curtis
 DESCRIPTION References to Control Points JOB NO.

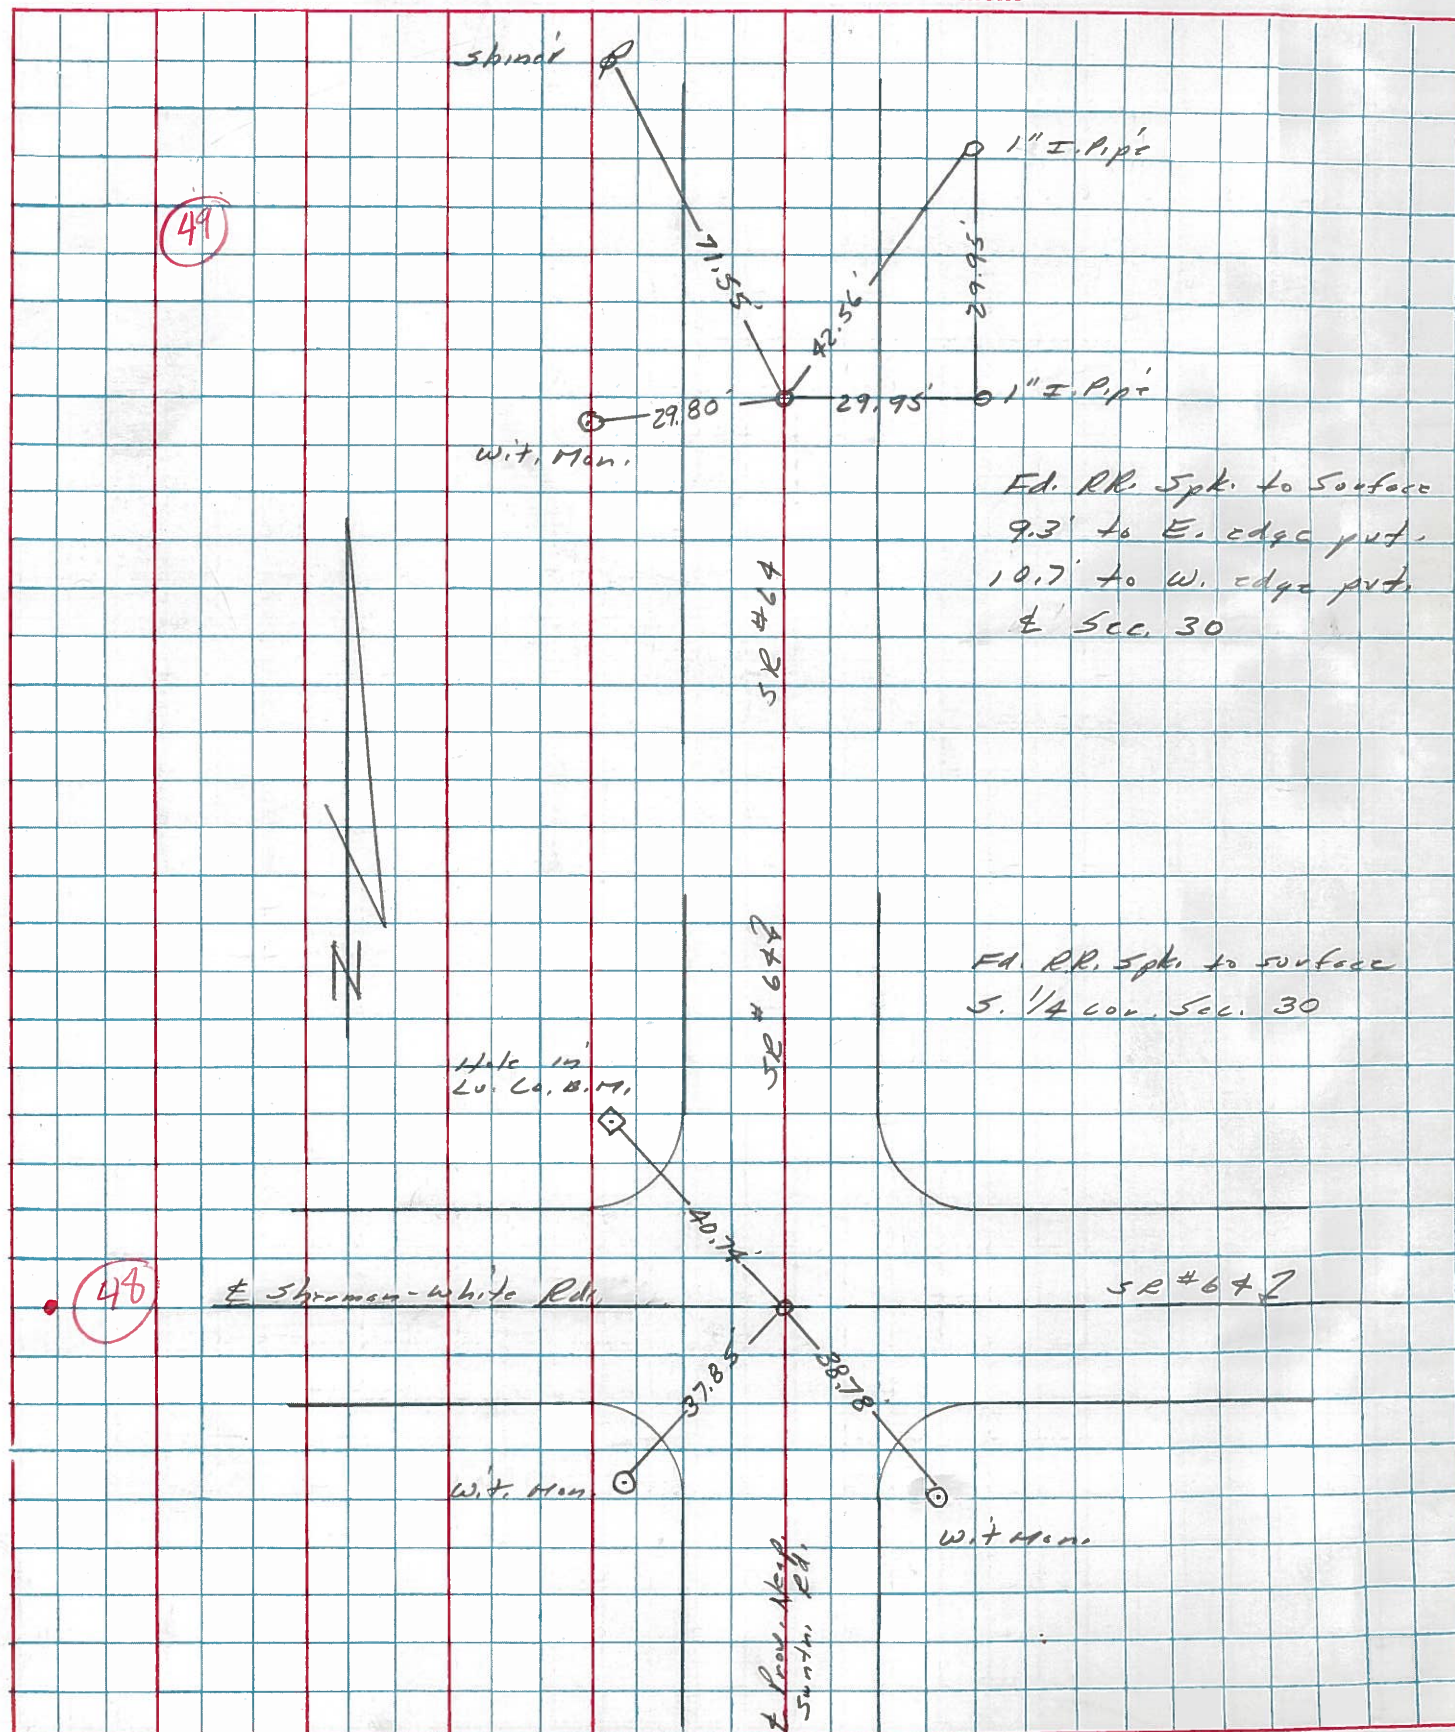

PERSONNEL TITLE PERSONNEL TITLE

W. Danna

J. Teal

J. Brindley

COUNTY Lucas

DATE Aug 16, 1968

S. R. 64


WEATHER Mild

SEC.

TEMP. 80°

DESCRIPTION S.R. 64 - Ref. Mon. & Control Points

JOB NO. 07994 (0)

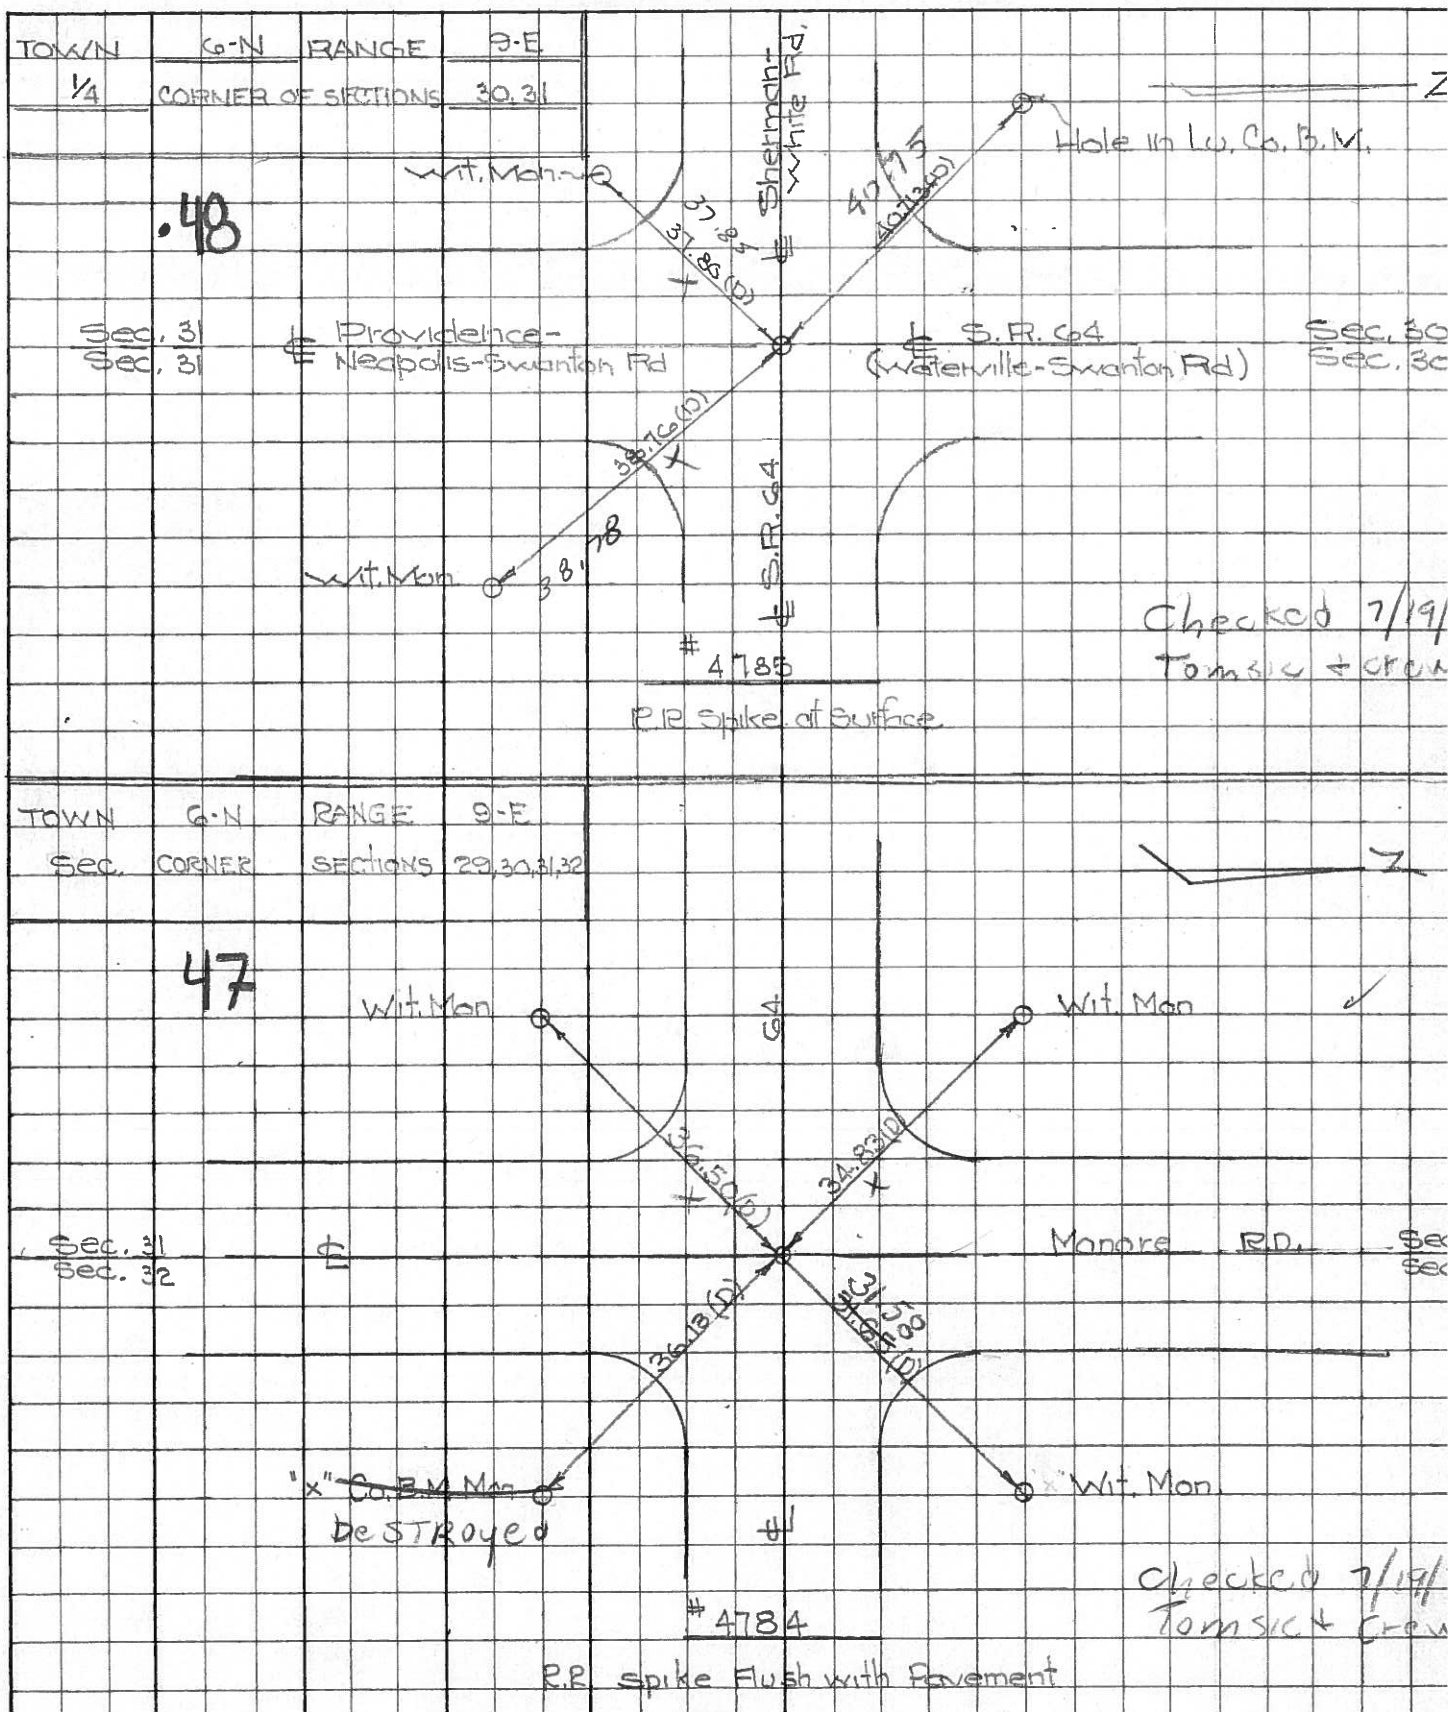

PERSONNEL	TITLE	PERSONNEL	TITLE	COUNTY	DATE	WEATHER	TEMP.
Stone				Lucas	3 Mar. 66		
Beck				S. R.	#64	Mild	
Brindley				SEC.	Whitehouse - W.		60°
Schroder							

DESCRIPTION Rats. To Control Pts. LEFT CENTER LINE RIGHT JOB NO.

44

#205	Int. Wilkens Rd.	29.11'	29.05'	S. To Con. Ref. Mon.	(D)
	4" L. Fd. Stone	37.87'	32.81'	N.E. To Con. Ref. Mon.	(D)
	2" Below Surface	39.58'	39.50'	N.W. To "V" in Lu. Co. B.M.	(D)

45

#204	Int. Ostrich Rd.	43.64'		N.E. To Con. Wrt. Mon.	(D)
	Fd. Brass Plate	32.64'		N.W. To Con. Wrt. Mon.	(D)
	1" Below Surface	30.00'		S. To Con. Wrt. Mon.	(D)

46

#203	Int. Jeffers Rd.	38.15'		N.W. To "T" in Lu. Co. B.M.	(D)
	Fd. Brass Plate	40.62'		N.E. To Con. Wrt. Mon.	(D)
	1 1/2" Below Surface	48.20'		S.W. To Con. Wrt. Mon.	(D)

47

#202	Int. Hamora Rd.	34.76'		N.W. To Con. Wrt. Mon.	(D)
	Fd. Hole in Con.	31.63'		N.E. To Con. Wrt. Mon.	(D)
	2" Below Surface	36.47'		S.W. To Con. Wrt. Mon.	(D)
		36.24'		S.E. To "T" in Lu. Co. B.M.	(D)

48

#201	N.E. & Sec. 30 & 31	37.82'		S.W. To Con. Wrt. Mon.	(D)
	Int. Swanton Rd. N.	38.77'		S.E. To Con. Wrt. Mon.	(D)
	Fd. R.R. Spt.	40.76'		N.W. To Hole in Lu. Co. B.M.	(D)
	To Surface				

49

#200	E.F.W. & Sec. 30	27.86'		E. To Hole in Lu. Co. B.M.	(D)
	Fd. R.R. Spt.	40.26'		N.E. To Con. Wrt. Mon.	(D)
	To Surface	29.93'		N. To Con. Wrt. Mon.	(D)
		71.54'		N.W. To Shiner in P.S.	(D)