

O.D.O.T. DISTRICT 2 SURVEY OFFICE (USE ONLY)

PERSONNEL

REFERENCE NO. 49

SHEET 48 OF 56

NOTES PRESTON-COLVIN

DATE 10-2-24

ROUTE SR 64

H.C.

WEATHER SUNNY

COUNTY LUCAS

R.C.

TEMP. 70°

TOWNSHIP WATERVILLE

NIESE

SECTION 30

DWG BY PRESTON-COLVIN PID PAVING TRAIN

T 7 N R 9 E

TYPE MONUMENT MAG/WASHER

ON SURFACE - BELOW ON

OFFSET Q PAVEMENT 0.5' LT : RT

10' TO LT EDGE PAVEMENT

STATION: 497+11.50

HORIZ.DATUM: NAD83 (2011)


GEOID: NAVD88 2018

GRID: NORTHING: 684800.870


EASTING: 1592554.649

LDP: NORTHING: 305628.0548

EASTING: 102911.6289

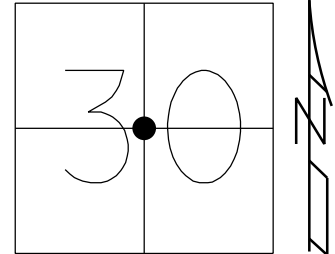

RECORD:
SET MAG/WASHER
10-12-04, MB
FD MAG/WASHER
REF49
1-15-16, JFO
REF49
3-6-19, JLL
REF49
8/23/22, TDN
11/21/22, TDN
FD MAG/WASHER
REF49
2/6/23, JAM
5/9/23, TDN
2/27/24, JMR
10-2-24M, TDN

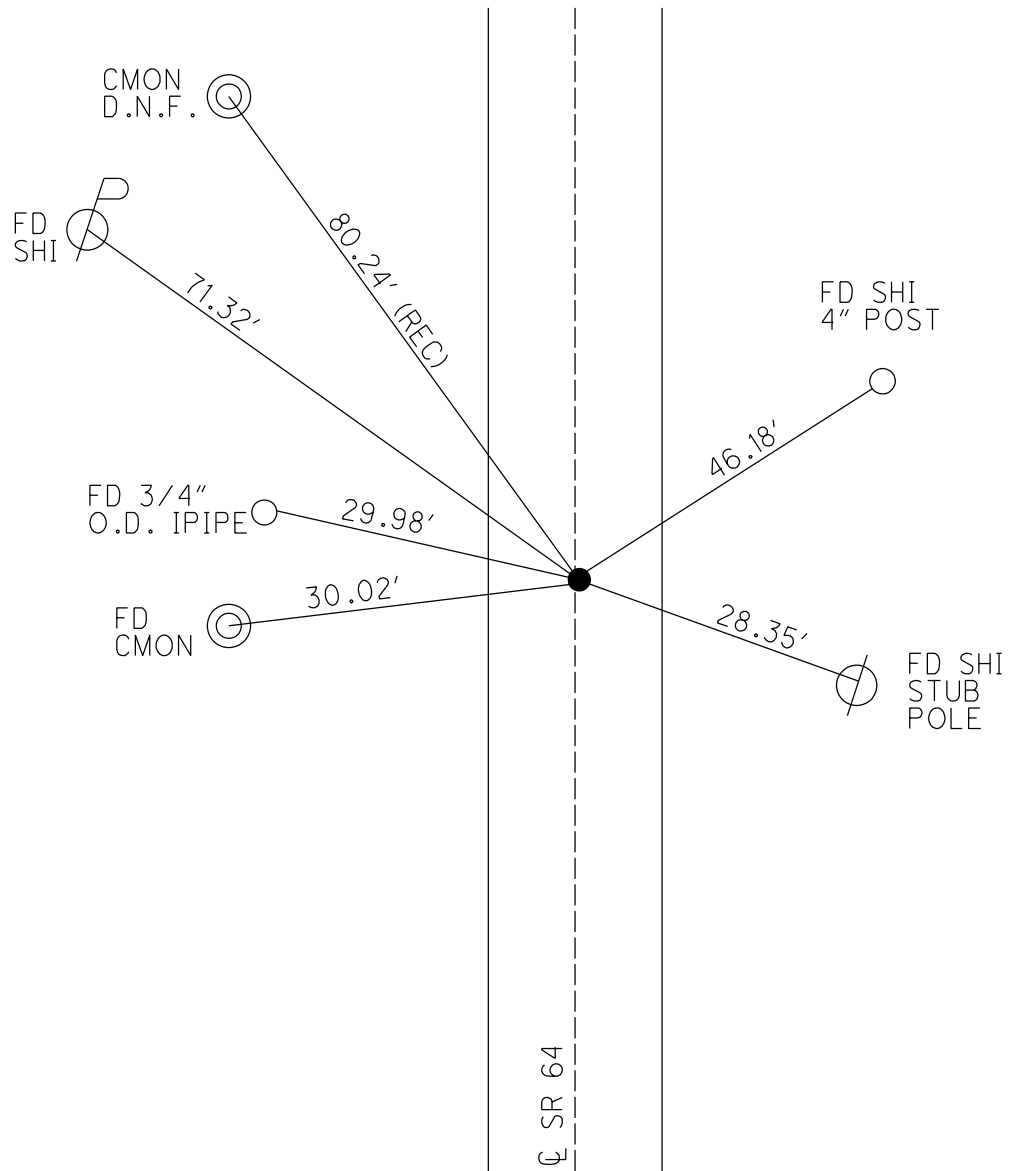

O.D.O.T. DISTRICT 2 SURVEY OFFICE (USE ONLY)

PERSONNEL

REFERENCE NO. 49

SHEET 48 OF 56

NOTES NIESE

DATE 5/9/23

ROUTE SR 64

H.C. AUBLE

WEATHER SUNNY

COUNTY LUCAS

R.C. ASTON

TEMP. 56°

TOWNSHIP WATERVILLE

SECTION 30

DWG BY RHOADES

PID PAVING TRAIN

T 7 N R 9 E

TYPE MONUMENT MAG/WASHER

ON SURFACE - ~~BELOW~~ ON

OFFSET $\odot$ PAVEMENT 0.5' ~~LT~~ : RT

10' TO LT EDGE PAVEMENT



STATION: 497+11.50

HORIZ.DATUM: NAD83 (2011)

GEOID: NAVD88 2018

GRID: NORTHING: 684800.870

EASTING: 1592554.649

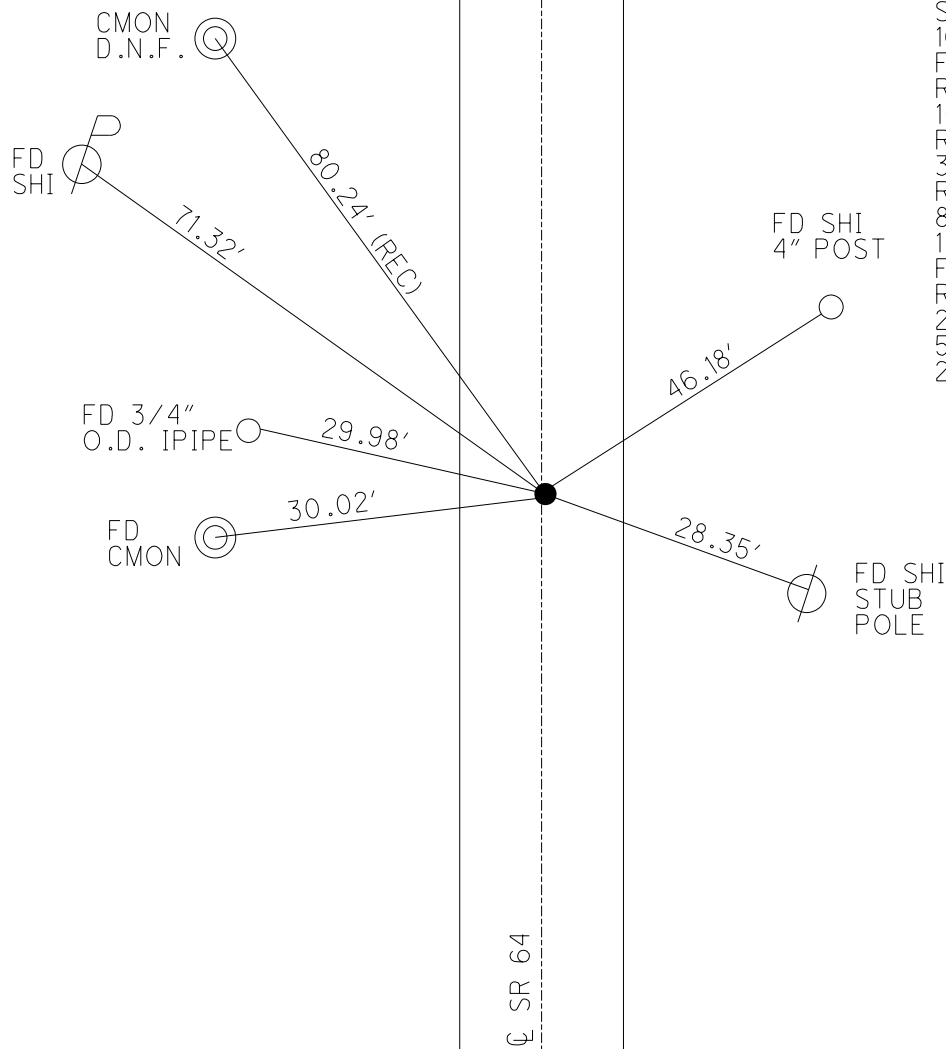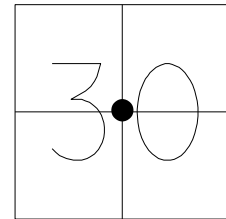

RECORD:
SET MAG/WASHER
10-12-04, MB
FD MAG/WASHER
REF49
1-15-16, JFO
REF49
3-6-19, JLL
REF49
8/23/22, TDN
11/21/22, TDN
FD MAG/WASHER
REF49
2/6/23, JAM
5/9/23, TDN
2/27/24, JMR

O.D.O.T. DISTRICT 2 SURVEY OFFICE (USE ONLY)

PERSONNEL

REFERENCE NO. 49

SHEET 48 OF 56

NOTES AUBLE

DATE 5/7/20

ROUTE SR 64

H.C. LEU

WEATHER WINDY

COUNTY LUCAS

R.C. BALBAUGH

TEMP. 66°

TOWNSHIP WATERVILLE

SECTION 30

DWG BY GARRETT

PID 107059

T 7 N R 9 E

TYPE MONUMENT MAG/WASHER

ON SURFACE - ~~BELOW~~ ON

OFFSET Q PAVEMENT ON LT : RT

10' TO LT EDGE PAVEMENT



STATION: 497+11.50

HORZ.DATUM: NAD83 (2011)

GEOID: 2012A

GRID: NORTHING: 684800.870

EASTING: 1592554.649

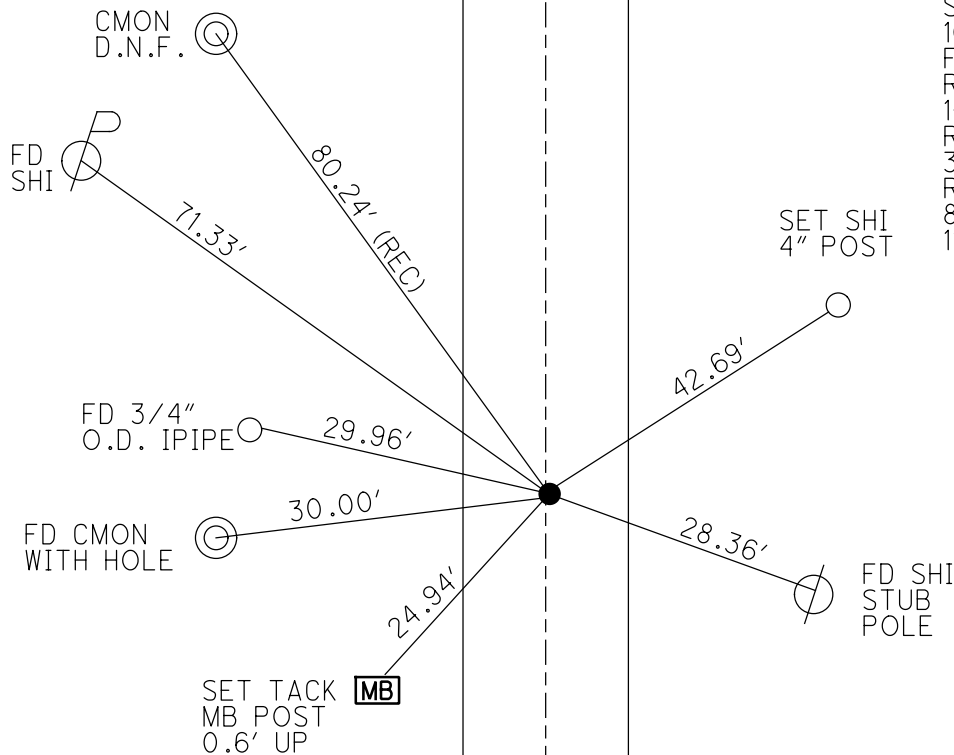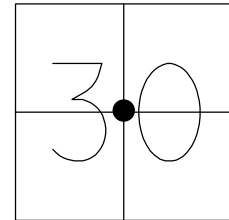

RECORD:
SET MAG/WASHER
10-12-04, MB
FD MAG/WASHER
REF49
1-15-16, JFO
REF49
3-6-19, JLL
REF49
8/23/22, TDN
11/21/22, TDN

Q SR 64

O.D.O.T. DISTRICT 2 SURVEY OFFICE (USE ONLY)

PERSONNEL

REFERENCE NO. 49

SHEET 48 OF 56

NOTES AUBLE

DATE 5/7/20

ROUTE SR 64

H.C. LEU

WEATHER WINDY

COUNTY LUCAS

R.C. BALBAUGH

TEMP. 66°

TOWNSHIP WATERVILLE

DWG BY GARRETT

PID 107059

SECTION 30

T 7 N R 9 E

TYPE MONUMENT MAG/WASHER

ON SURFACE - ~~BELOW~~ ON

OFFSET Q PAVEMENT ON LT : RT

10' TO LT EDGE PAVEMENT



STATION: 497+11.50

HORZ.DATUM: NAD83 (2011)

GEOID: 2012A

GRID: NORTHING: 684800.870

EASTING: 1592554.649

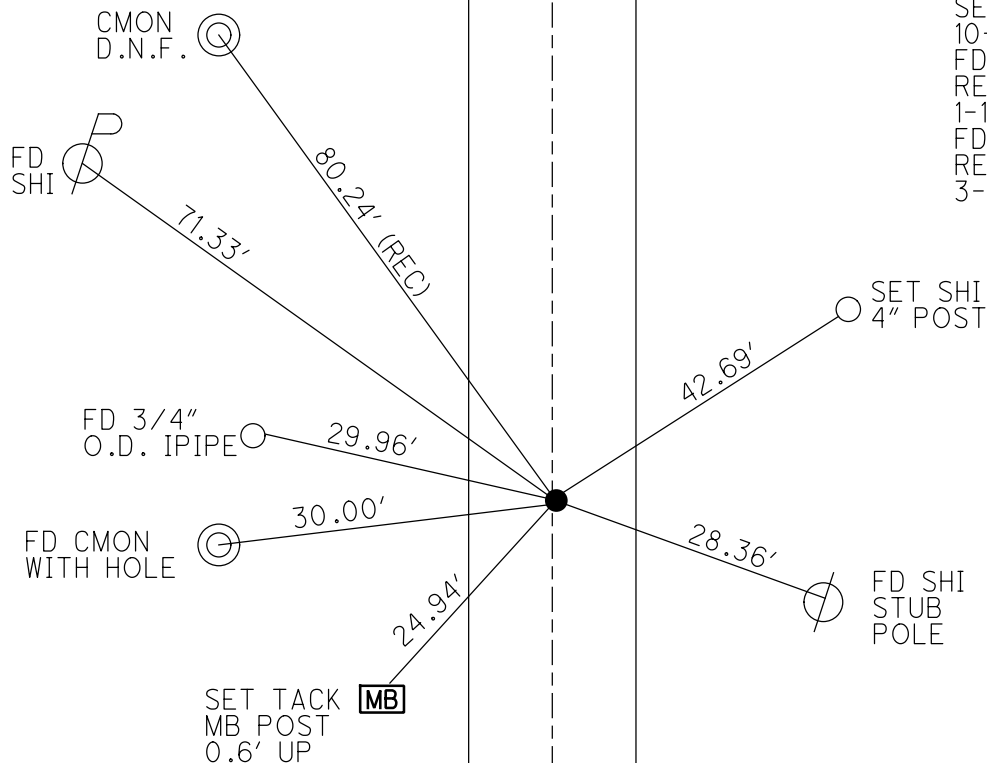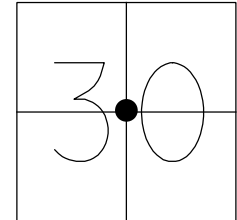

RECORD:
SET MAG/WASHER
10-12-04, MB
FD MAG/WASHER
REF49
1-15-16, JFO
FD MAG/WASHER
REF49
3-6-19, JLL


Q SR 64

O.D.O.T. DISTRICT 2 SURVEY OFFICE (USE ONLY)

PERSONNEL _____ REFERENCE NO. 49 SHEET 48 OF 50
NOTES HUSS DATE 6-16-04 ROUTE SR 64
H.C. HOMAN WEATHER CLOUDY COUNTY LUCAS
R.C. HUSS TEMP. 70° TOWNSHIP WATERVILLE
SECTION 30
T 7 N R 9 E

TYPE MONUMENT SM.R.R.SPIKE
ON SURFACE - ~~BELOW~~ ON _____
~~LEFT - C~~ PAV'T - ~~RIGHT~~ ON _____
10' TO LT EDGE PAVEMENT
S.L.M. 497+96.13

Grid: Northing: 684800.9177 Easting: 1592554.6516

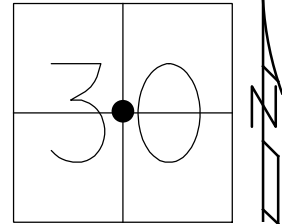

CONC MON
WITH HOLE

FD N&S
71.46' (REC)

CONC MON
WITH HOLE

SET TACK NE COR
MAIL BOX POST

80.24'

30.00'

23.40'

MB

C SR 64

RECORD:
SET MAG/WASHER
10-12-04, MB
FD MAG/WASHER
REF49
1-15-16, JFO

45.63'

FD N&S
IN GUARD RAIL POST

28.38'

FD N&S
W/S STUB
POLE

O.D.O.T. DISTRICT 2 SURVEY OFFICE

PERSONNEL

REFERENCE NO. 49

SHEET 2 OF 10

NOTES HUSS

DATE 6-16-04

ROUTE SR 64

H.C. HOMAN

WEATHER CLOUDY

COUNTY LUCAS

R.C. HUSS

TEMP. 70°

TOWNSHIP SWANTON

SECTION 30

T 7 N R 9 E




TYPE MONUMENT SM RR SPIKE

ON SURFACE - ~~BELOW~~ YES

~~LEFT~~ - Q PAV'T - ~~RIGHT~~ YES

10' TO LT EDGE PAVEMENT

S.L.M. 497+75

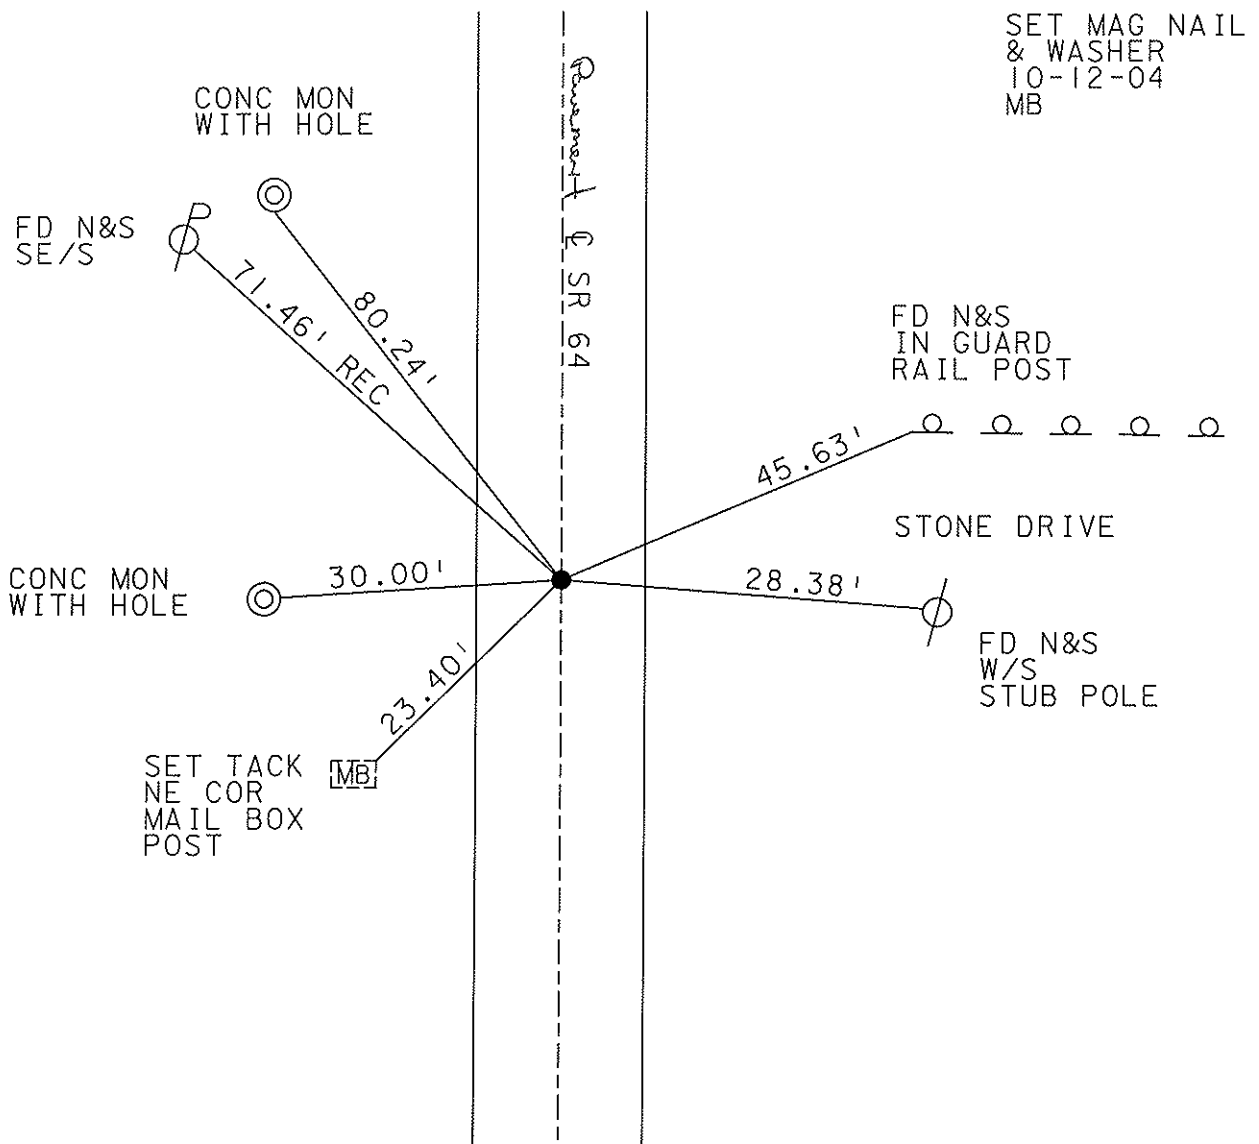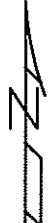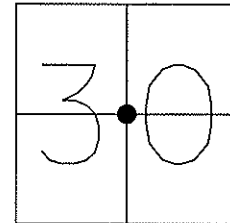

O.D.O.T. DISTRICT 2 SURVEY OFFICE

PERSONNEL

REFERENCE NO. 49

SHEET 2 OF 9

NOTES D. CURTIS

H.C. J. HOUSEHOLDER

R.C. _____

DATE 9-25-86

WEATHER CLOUDY

TEMP. 70°

ROUTE S.R. 64

COUNTY LUCAS

TOWNSHIP SWANTON

SECTION 30

T____R____



TYPE MONUMENT R.R. SPK.

ON SURFACE - BELOW 1" BELOW SURF.

LEFT- & PAV'T. - RIGHT 1' RT. & PAV'T

TO EDGE PAVEMENT

S.L.M. 497 + 75

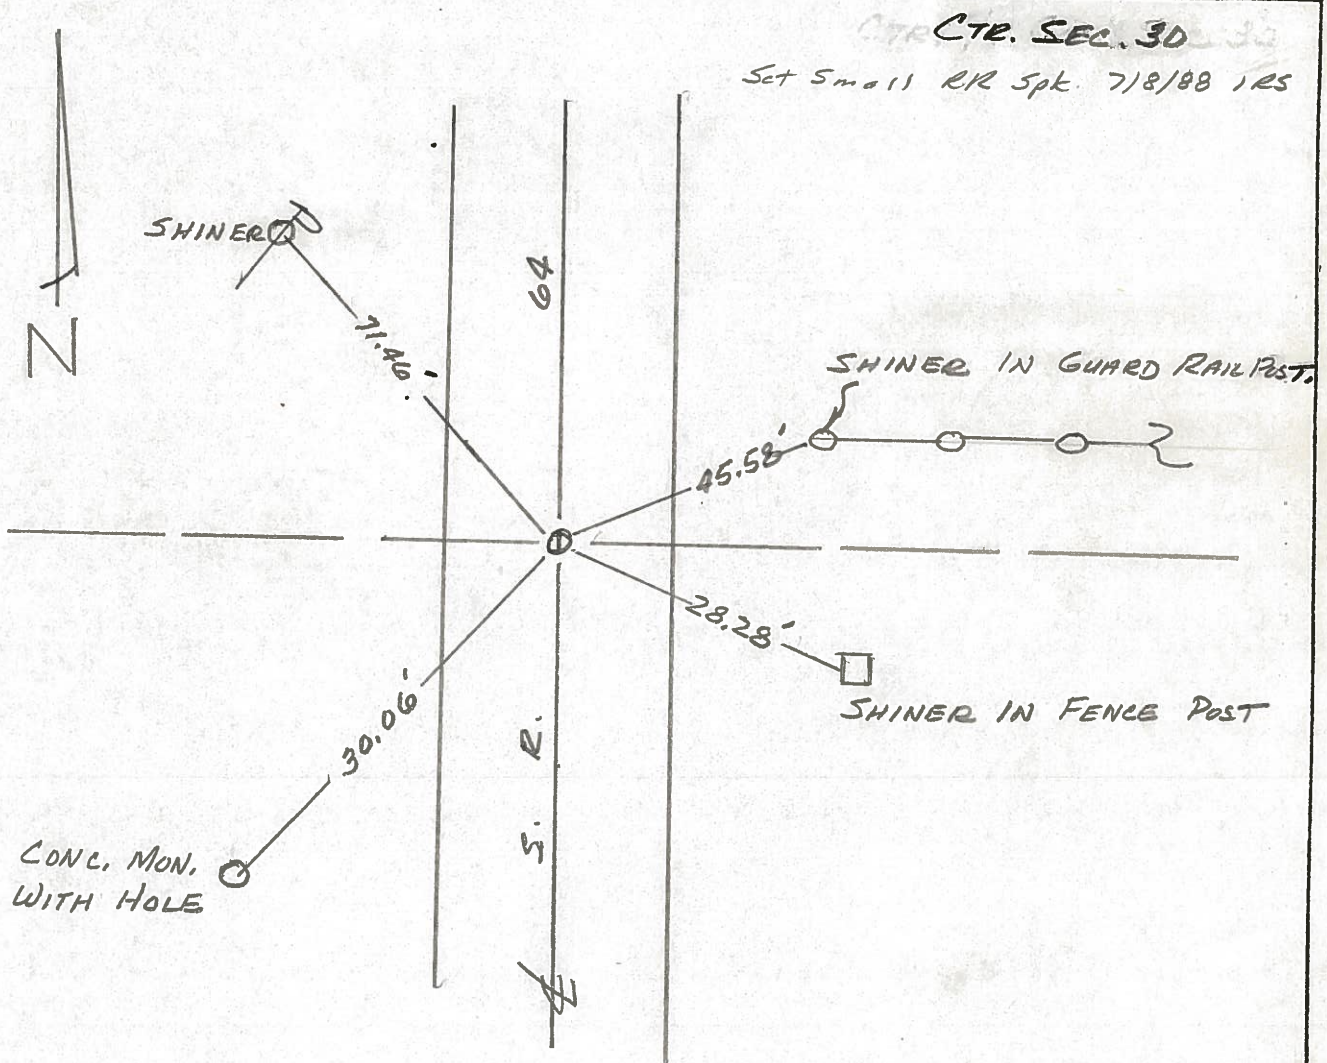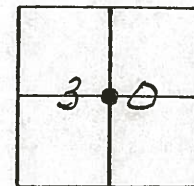

O.D.O.T. DISTRICT 2 SURVEY OFFICE

SHEET

OF

County LUCAS S.R. 64

Township SWANTON

Section 30

T1N, R5E

Personnel S. Hoffman


C. Loehrke

J. Householder

Date 5-22-81


Weather Clear

Temp. 80°

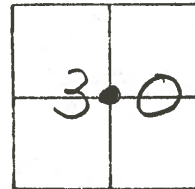

#49


Fd. R.R. SPK 1" Below
Surface
9.3' to E. EDGE PUT
10.7' to W. EDGE PUT

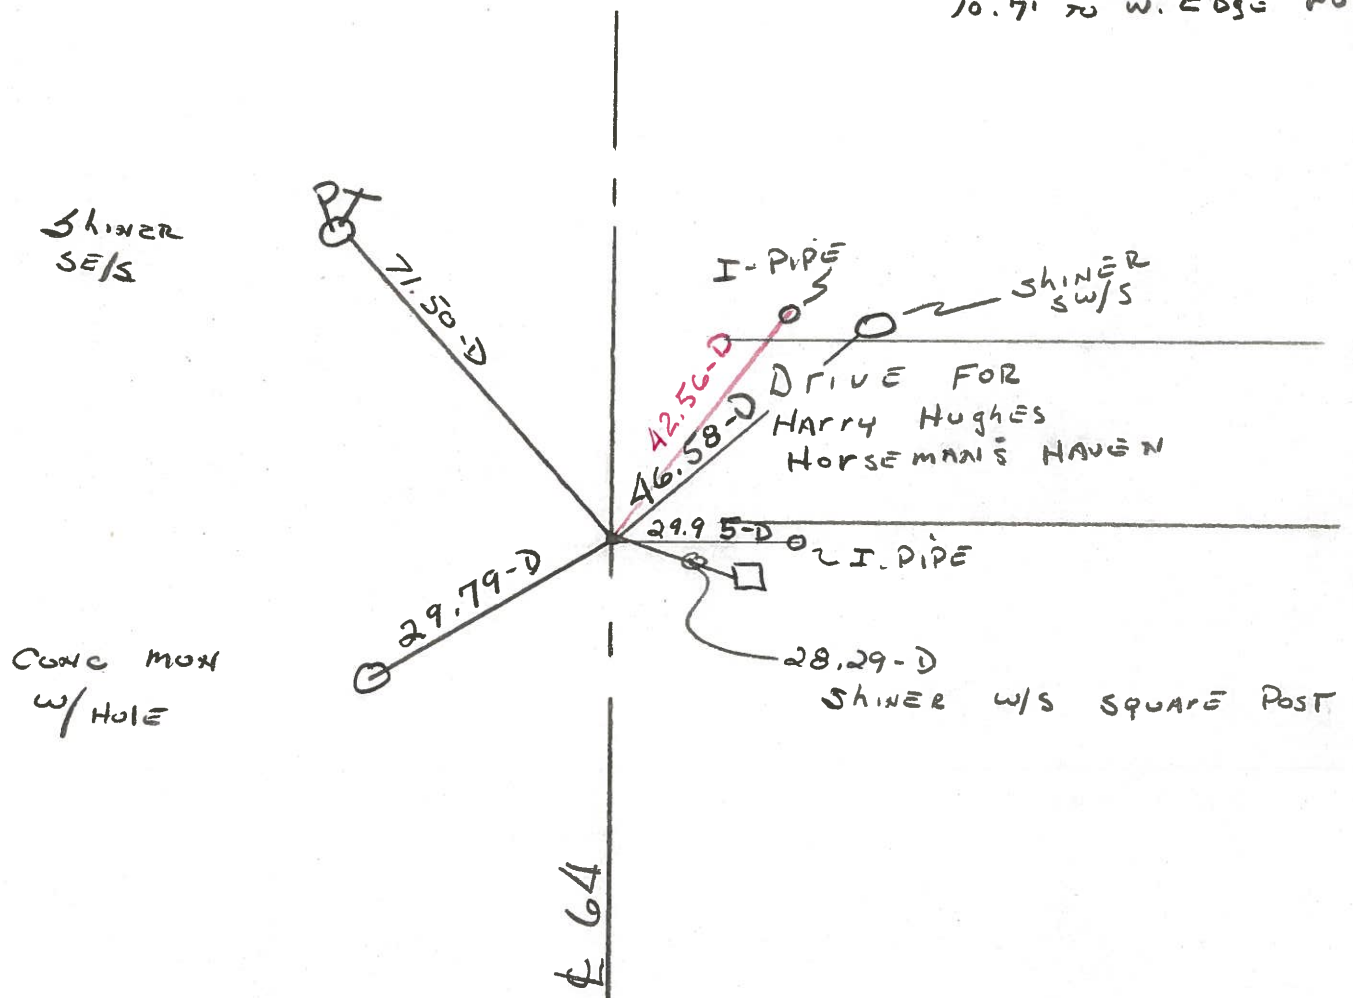

PERSONNEL	TITLE	PERSONNEL	TITLE	COUNTY	DATE	WEATHER	TEMP.
Stone		Gronatg		Lucas	17 Nov. 7	Cool	72°
Michaelok				S. R. 64			
Neuse				SEC.			
Curtis							


DESCRIPTION References to Control Points JOB NO. _____

LEFT CENTER LINE RIGHT

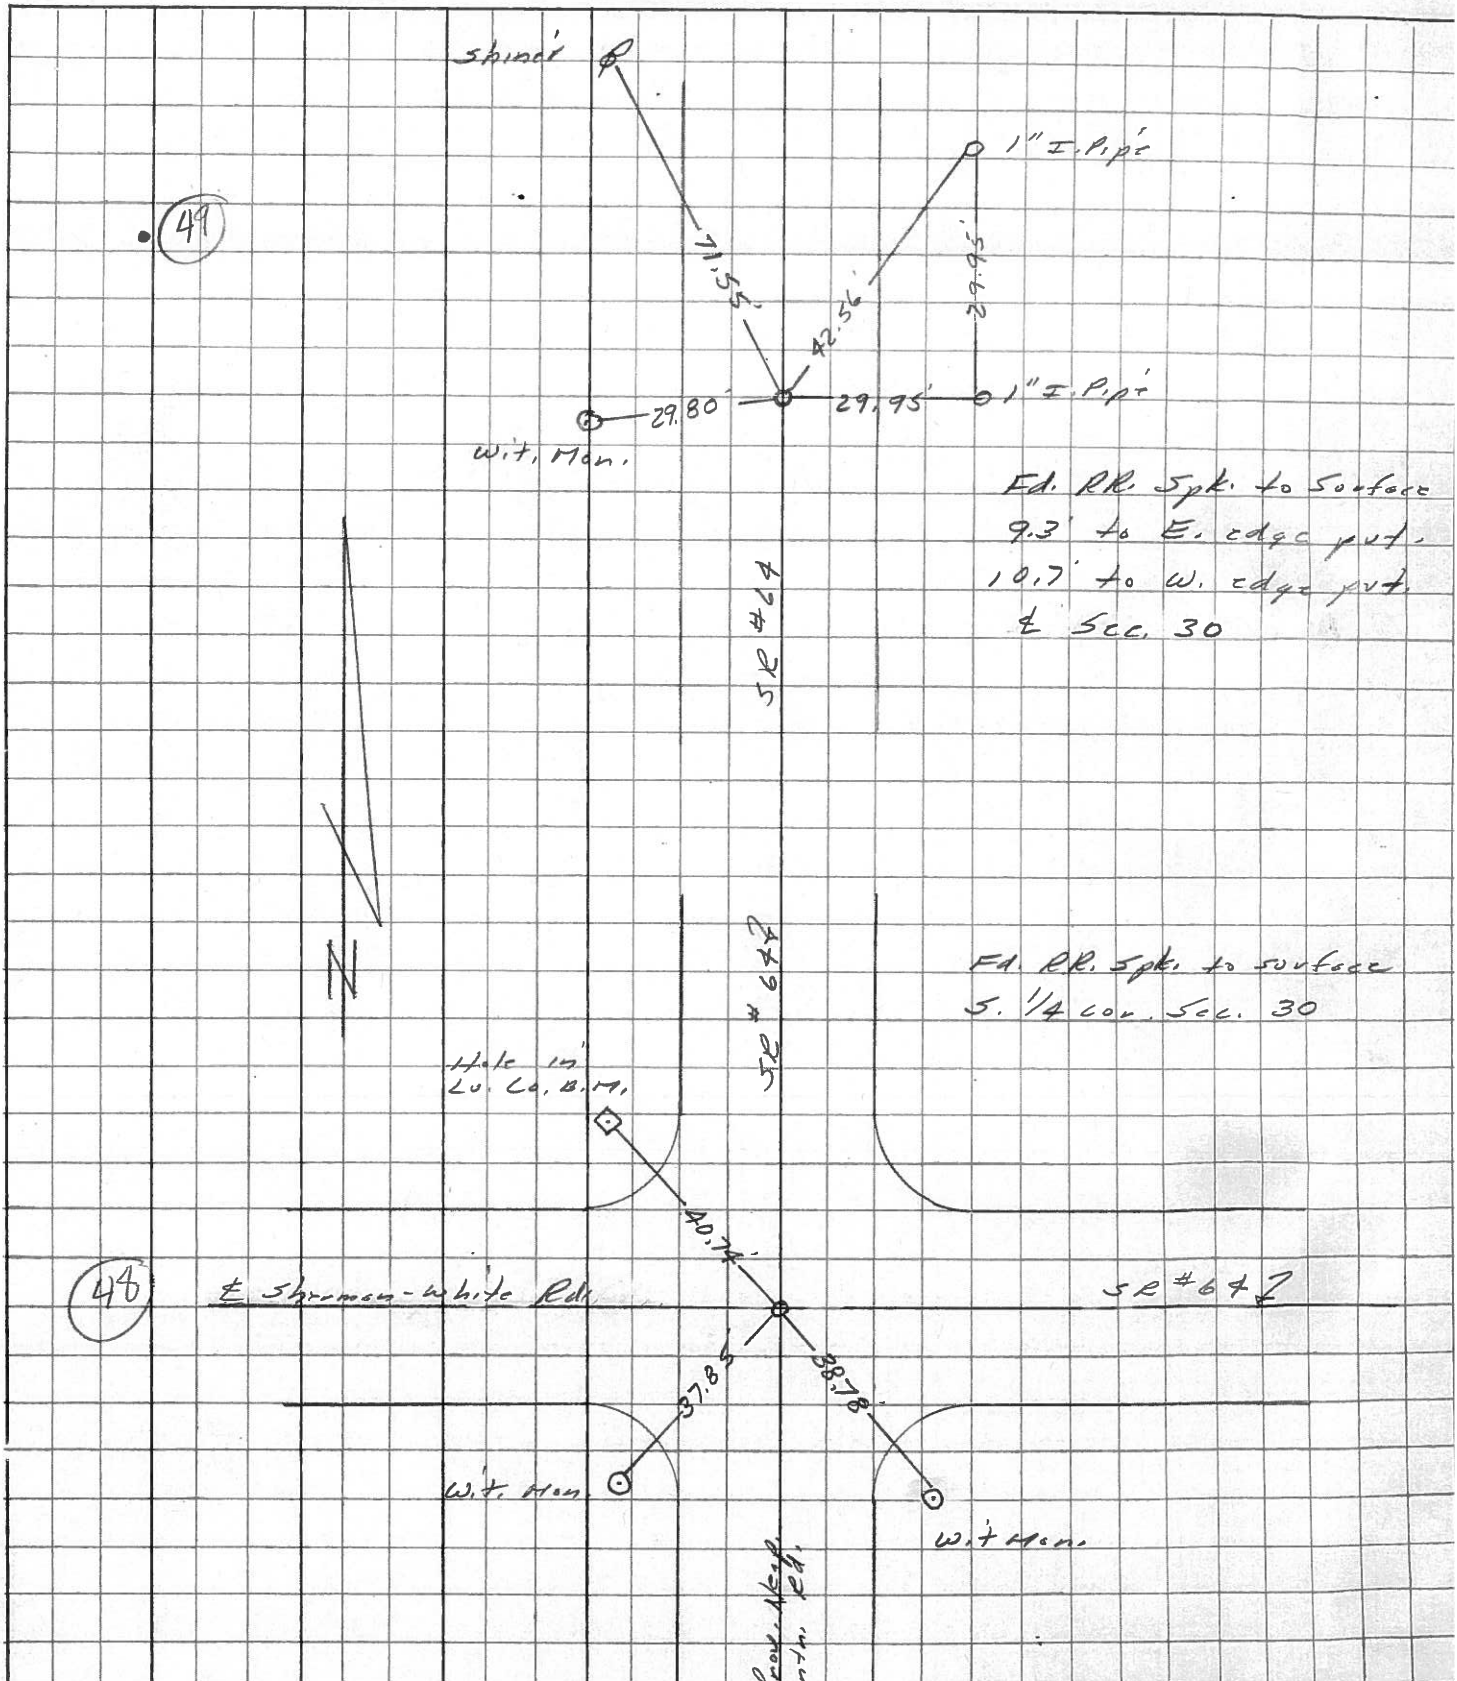

PERSONNEL	TITLE	PERSONNEL	TITLE	COUNTY	DATE	WEATHER
W. Denna				Lucas	Aug. 19, 190	warm
D. Curtis				S. R.	Co 4	
J. Teal				SEC.		TEMP. 85°±
J. Brindley						

DESCRIPTION S.R. 64-Ref. Mon. & Control Points JOB NO. 02994(n)

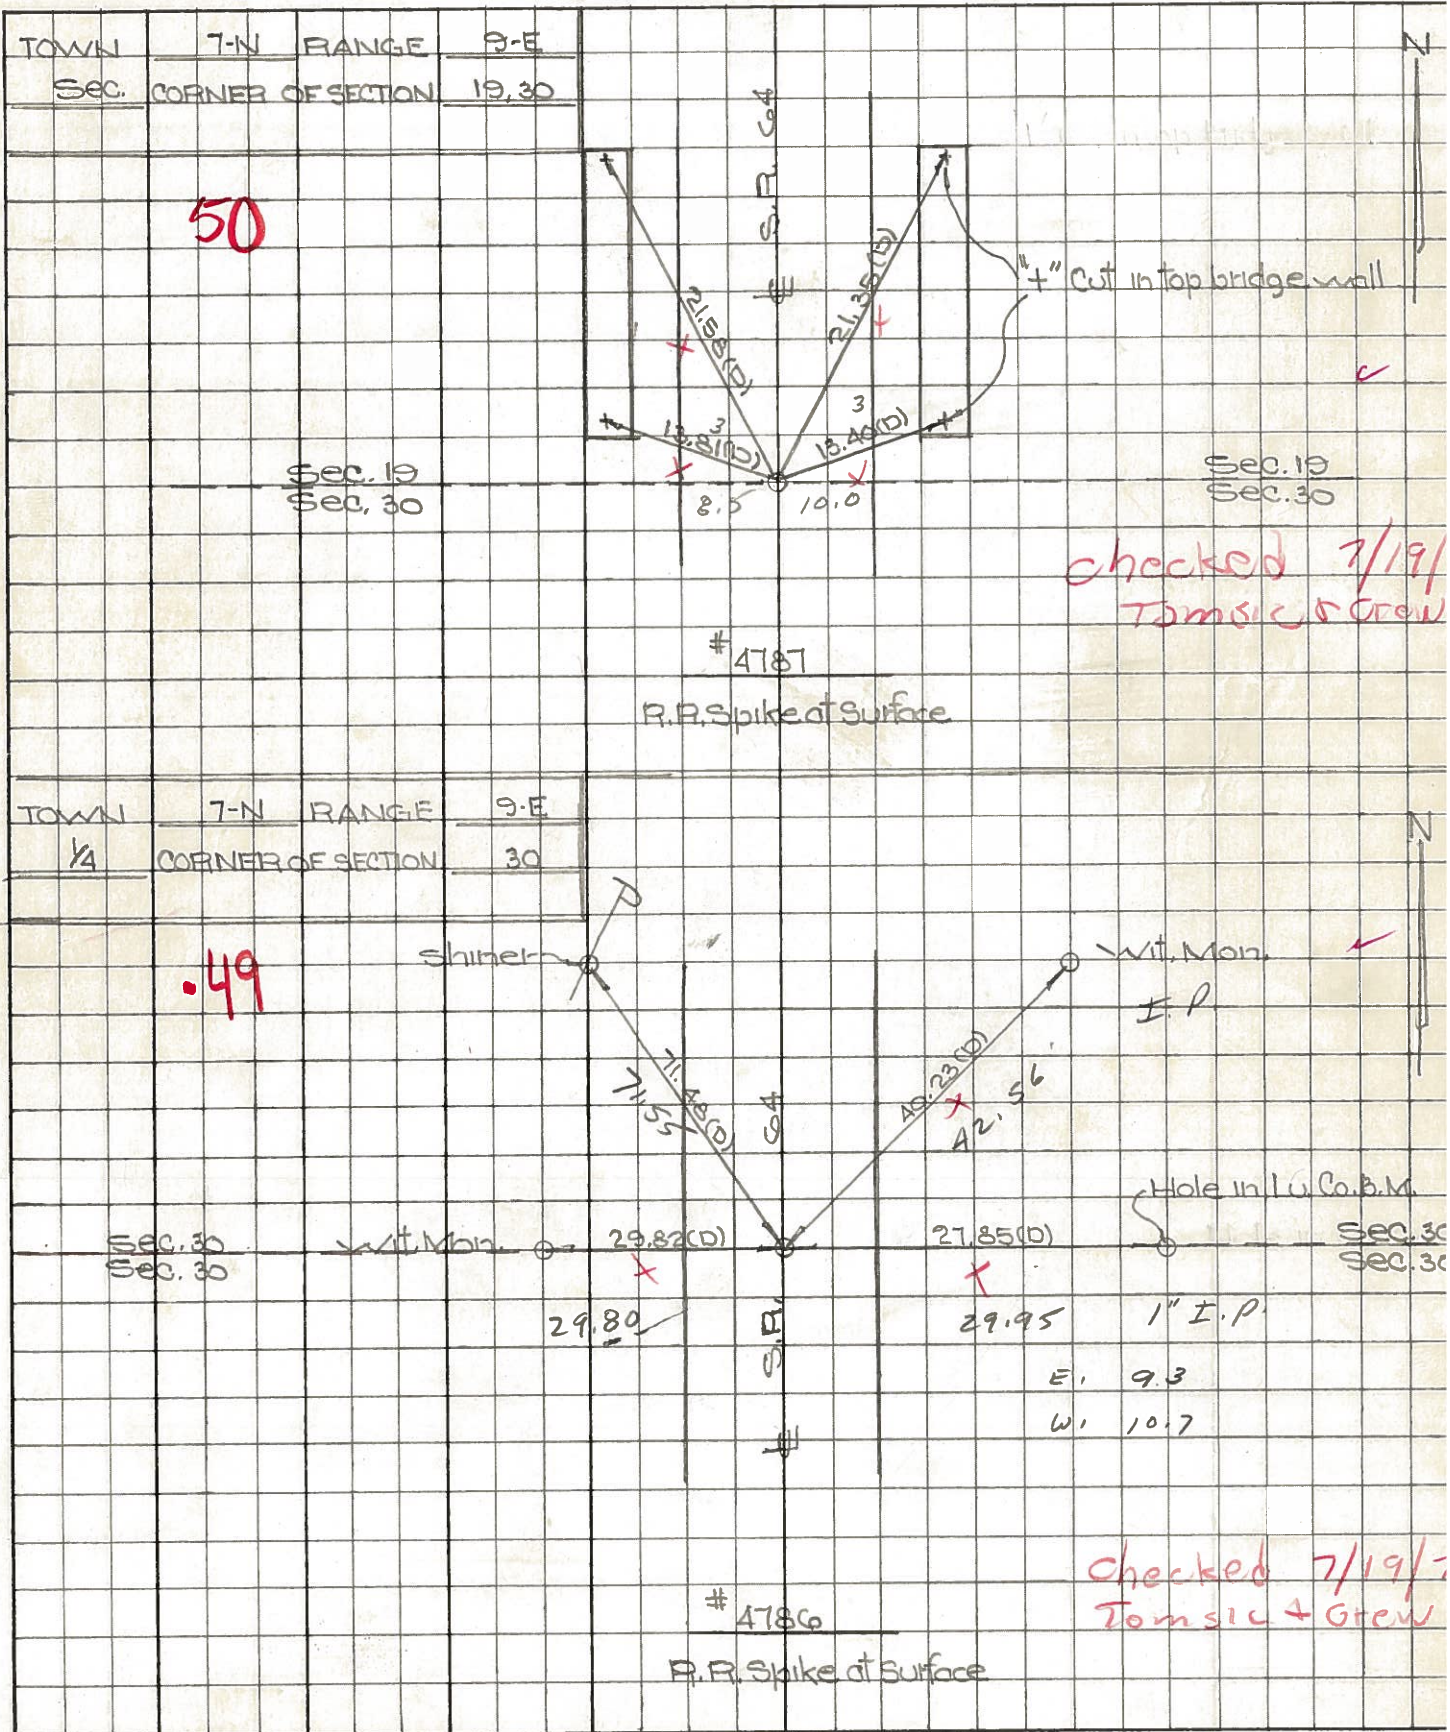

PERSONNEL	TITLE	PERSONNEL	TITLE	COUNTY	DATE	WEATHER	TEMP.
Stone				Lucas	3 Mar. 66		
Beck				S. R. #64		Mild	
Brindley							
Schroder				SEC. Whitehouse - W.			60°
DESCRIPTION				Rets. To Control Pts.		JOB NO.	
LEFT		CENTER LINE		RIGHT			

44

#205	Int. Wilkens Rd.	29.11'	29.05'	S. To Con. Ret. Mon.	(D)
	4" L. Fd. Stone	37.87'	32.81'	N.E. To Con. Ret. Mon.	(D)
	2" Below Surface	37.58'	39.50'	N.W. To "V" in Lu. Co. B.M.	(D)

45

#204	Int. Ostrich Rd.	43.64'		N.E. To Con. Wrt. Mon.	(D)
	Fd. Brass Plate	32.64'		N.W. To Con. Wrt. Mon.	(D)
	1" Below Surface	30.00'		S. To Con. Wrt. Mon.	(D)

46

#203	Int. Jeffers Rd.	38.15'		N.W. To "T" in Lu. Co. B.M.	(D)
	Fd. Brass Plate	40.62'		N.E. To Con. Wrt. Mon.	(D)
	1 1/2" Below Surface	48.20'		S.W. To Con. Wrt. Mon.	(D)

47

#202	Int. Hamora Rd.	34.76'		N.W. To Con. Wrt. Mon.	(D)
	Fd. Hole in Con.	31.63'		N.E. To Con. Wrt. Mon.	(D)
	2" Below Surface	36.47'		S.W. To Con. Wrt. Mon.	(D)
		36.24'		S.E. To "T" in Lu. Co. B.M.	(D)

48

#201	N.E. & Sec. 30 & 31	37.82'		S.W. To Con. Wrt. Mon.	(D)
	Int. Swanton Rd. N.	38.77'		S.E. To Con. Wrt. Mon.	(D)
	Fd. R.R. Spt.	40.76'		N.W. To Hole in Lu. Co. B.M.	(D)
	To Surface				

49

#200	E.F.W. & Sec. 30	27.86'		E. To Hole in Lu. Co. B.M.	(D)
	Fd. R.R. Spt.	40.26'		N.E. To Con. Wrt. Mon.	(D)
	To Surface	29.93'		N. To Con. Wrt. Mon.	(D)
		71.54'		N.W. To Shiner in P.S.	(D)