

O.D.O.T. DISTRICT 2 SURVEY OFFICE (USE ONLY)

PERSONNEL

REFERENCE NO. 50

SHEET 49 OF 56

NOTES PRESTON-COLVIN

DATE 10-2-24

ROUTE SR 64

H.C.

WEATHER SUNNY

COUNTY LUCAS

R.C.

TEMP. 70°

TOWNSHIP WATERVILLE

NIESE

SECTION 30

DWG BY PRESTON-COLVIN

PID PAVING TRAIN

T 7 N R 9 E

TYPE MONUMENT SHANK

ON SURFACE - BELOW ON

OFFSET $\varnothing$ PAVEMENT 1.0' ~~LT~~ : RT

8.2' TO LT EDGE PAVEMENT

STATION: 523+61.01

HORIZ.DATUM: NAD83 (2011)


GEOID: NAVD88 2018

GRID: NORTHING: 687450.127


EASTING: 1592589.996

LDP: NORTHING: 308277.6859

EASTING: 102912.1132

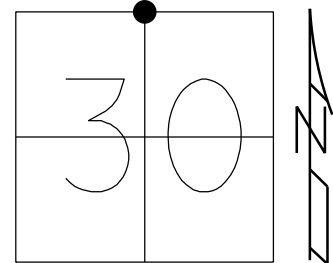

RECORD:
SET MAG/WASHER
10-12-04, MB
FD MAG/WASHER
REF50
1-15-16, JFO
REF50
3-6-19, JLL
REF50
8/23/22, TDN
11/21/22, TDN
FD MAG/WASHER
REF50
2/6/23, JAM
5/9/23, TDN
2/27/24, JMR
FD SHANK
10-2-24, TDN

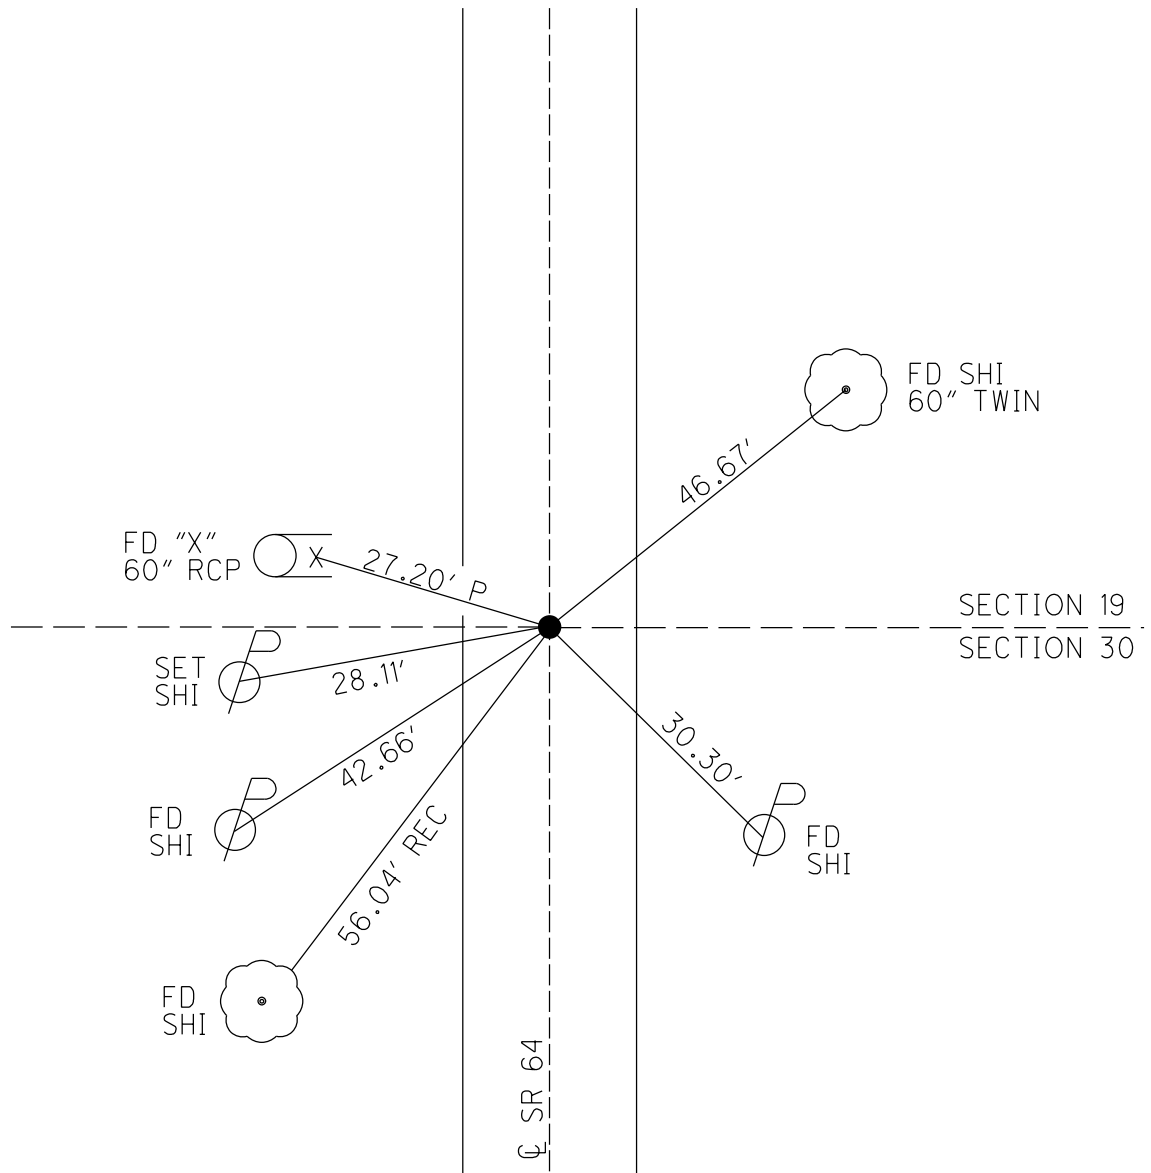

O.D.O.T. DISTRICT 2 SURVEY OFFICE (USE ONLY)

PERSONNEL

REFERENCE NO. 50

SHEET 49 OF 56

NOTES NIESE

DATE 5/9/23

ROUTE SR 64

H.C. AUBLE

WEATHER SUNNY

COUNTY LUCAS

R.C. ASTON

TEMP. 60°

TOWNSHIP WATERVILLE

SECTION 19 & 30

DWG BY RHOADES PID PAVING TRAIN

T 7 N R 9 E

TYPE MONUMENT MAG/WASHER

ON SURFACE - ~~BELOW~~ ON

OFFSET CL PAVEMENT 1.0' LT : ~~RT~~

8.2' TO LT EDGE PAVEMENT


STATION: 523+61.01

HORIZ.DATUM: NAD83 (2011)


GEOID: NAVD88 2018

GRID: NORTHING: 687450.127

EASTING: 1592589.996

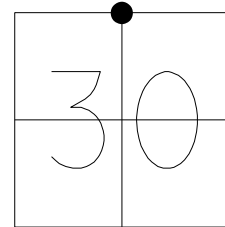

RECORD:
SET MAG/WASHER
10-12-04, MB
FD MAG/WASHER
REF50
1-15-16, JFO
REF50
3-6-19, JLL
REF50
8/23/22, TDN
11/21/22, TDN
FD MAG/WASHER
REF50
2/6/23, JAM
5/9/23, TDN
2/27/24, JMR

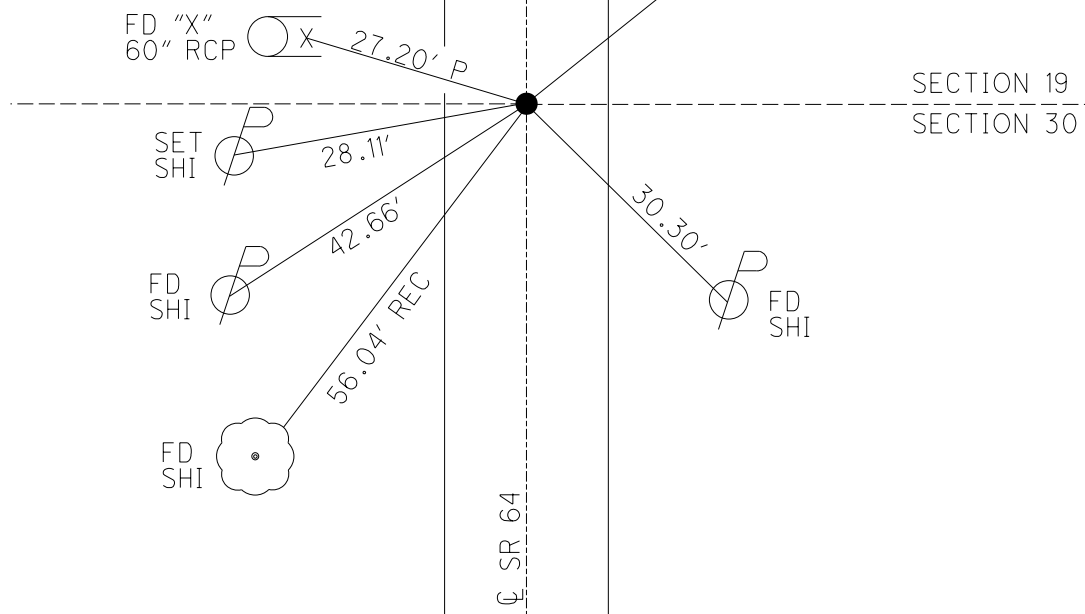

O.D.O.T. DISTRICT 2 SURVEY OFFICE (USE ONLY)

PERSONNEL

REFERENCE NO. 50

SHEET 49 OF 56

NOTES AUBLE

DATE 5/7/20

ROUTE SR 64

H.C. LEU

WEATHER WINDY

COUNTY LUCAS

R.C. BALBAUGH

TEMP. 66°

TOWNSHIP WATERVILLE

SECTION 19 & 30

DWG BY GARRETT

PID 107059

T 7 N R 9 E

TYPE MONUMENT MAG NAIL

ON SURFACE - ~~BELOW~~ ON

OFFSET Q PAVEMENT 1.0' LT : ~~RT~~

8.2' TO LT EDGE PAVEMENT


STATION: 523+61.01

HORIZ.DATUM: NAD83 (2011)


GEOID: 2012A

GRID: NORTHING: 687450.127

EASTING: 1592589.996

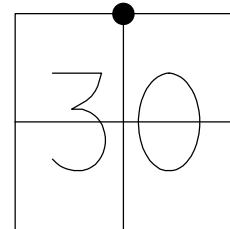

RECORD:
SET MAG/WASHER
10-12-04, MB
FD MAG/WASHER
REF50
1-15-16, JFO
REF50
3-6-19, JLL
REF50
8/23/22, TDN
11/21/22, TDN

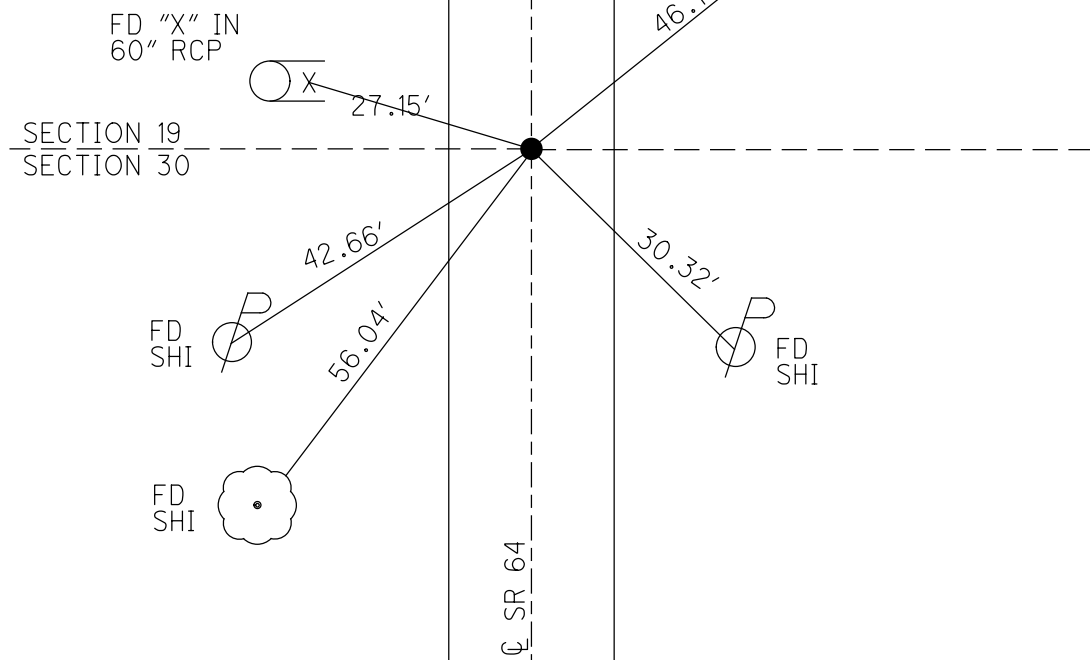

O.D.O.T. DISTRICT 2 SURVEY OFFICE (USE ONLY)

PERSONNEL

REFERENCE NO. 50

SHEET 49 OF 56

NOTES AUBLE

DATE 5/7/20

ROUTE SR 64

H.C. LEU

WEATHER WINDY

COUNTY LUCAS

R.C. BALBAUGH

TEMP. 66°

TOWNSHIP WATERVILLE

DWG BY GARRETT

PID 107059

SECTION 19 & 30

T 7 N R 9 E

TYPE MONUMENT MAG NAIL

ON SURFACE - ~~BELOW~~ ON

OFFSET Q PAVEMENT 1.0' LT : ~~RT~~

8.2' TO LT EDGE PAVEMENT


STATION: 523+61.01

HORZ.DATUM: NAD83 (2011)


GEOID: 2012A

GRID: NORTHING: 687450.135

EASTING: 1592590.096

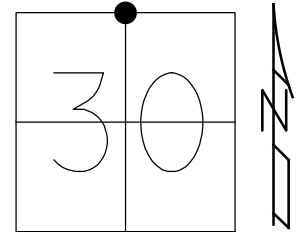

RECORD:
SET MAG/WASHER
10-12-04, MB
FD MAG/WASHER
REF50
1-15-16, JFO
FD MAG/WASHER
RECRE50
3-6-19, JLL

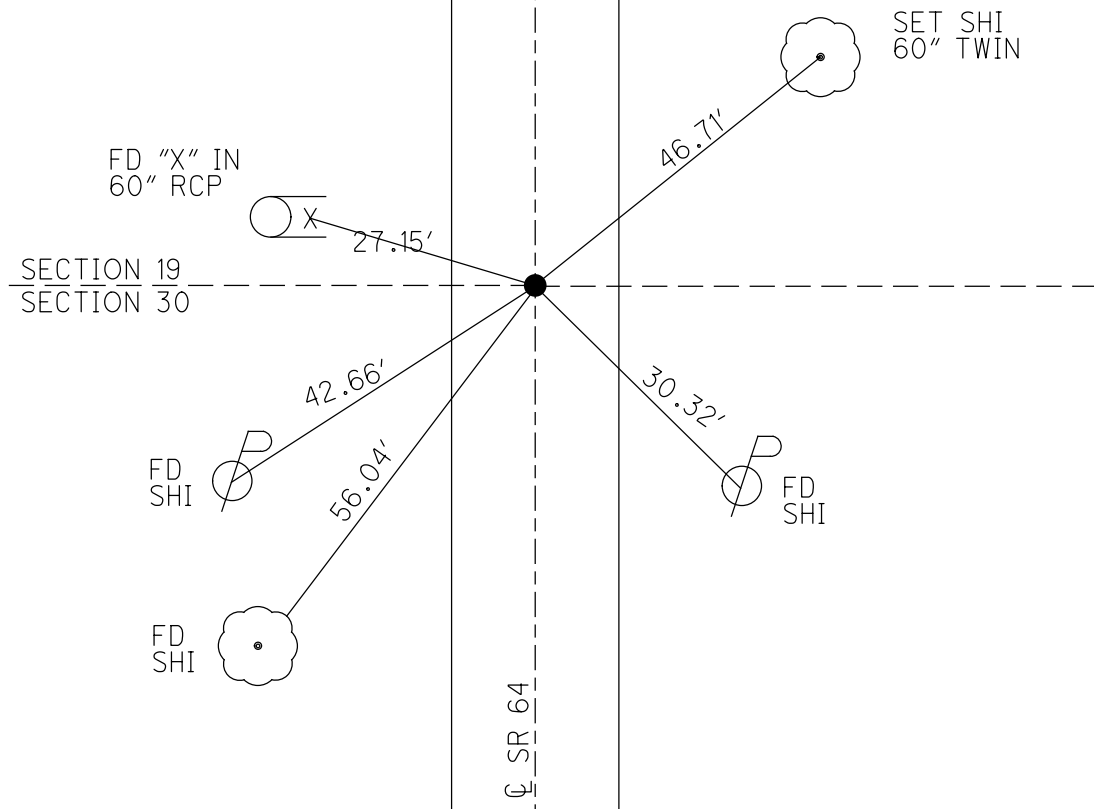

O.D.O.T. DISTRICT 2 SURVEY OFFICE (USE ONLY)

PERSONNEL

REFERENCE NO. 50

SHEET 49 OF 50

NOTES HUSS

DATE 6-16-04

ROUTE SR 64

H.C. HOMAN

WEATHER CLOUDY

COUNTY LUCAS

R.C. HUSS

TEMP. 74°

TOWNSHIP WATERVILLE

SECTION 19 & 30

T 7 N R 9 E

TYPE MONUMENT SM.R.R.SPIKE


ON SURFACE - ~~BELOW~~ ON

LEFT - ℄ PAV'T - ~~RIGHT~~ 1.0'


8.2' TO LT EDGE PAVEMENT

S.L.M. 524+45.58

Grid: Northing: 687450.1347 Easting: 1592590.0959

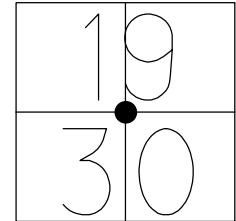

RECORD:
SET MAG/WASHER
10-12-04, MB
FD MAG/WASHER
REF50
1-15-16, JFO

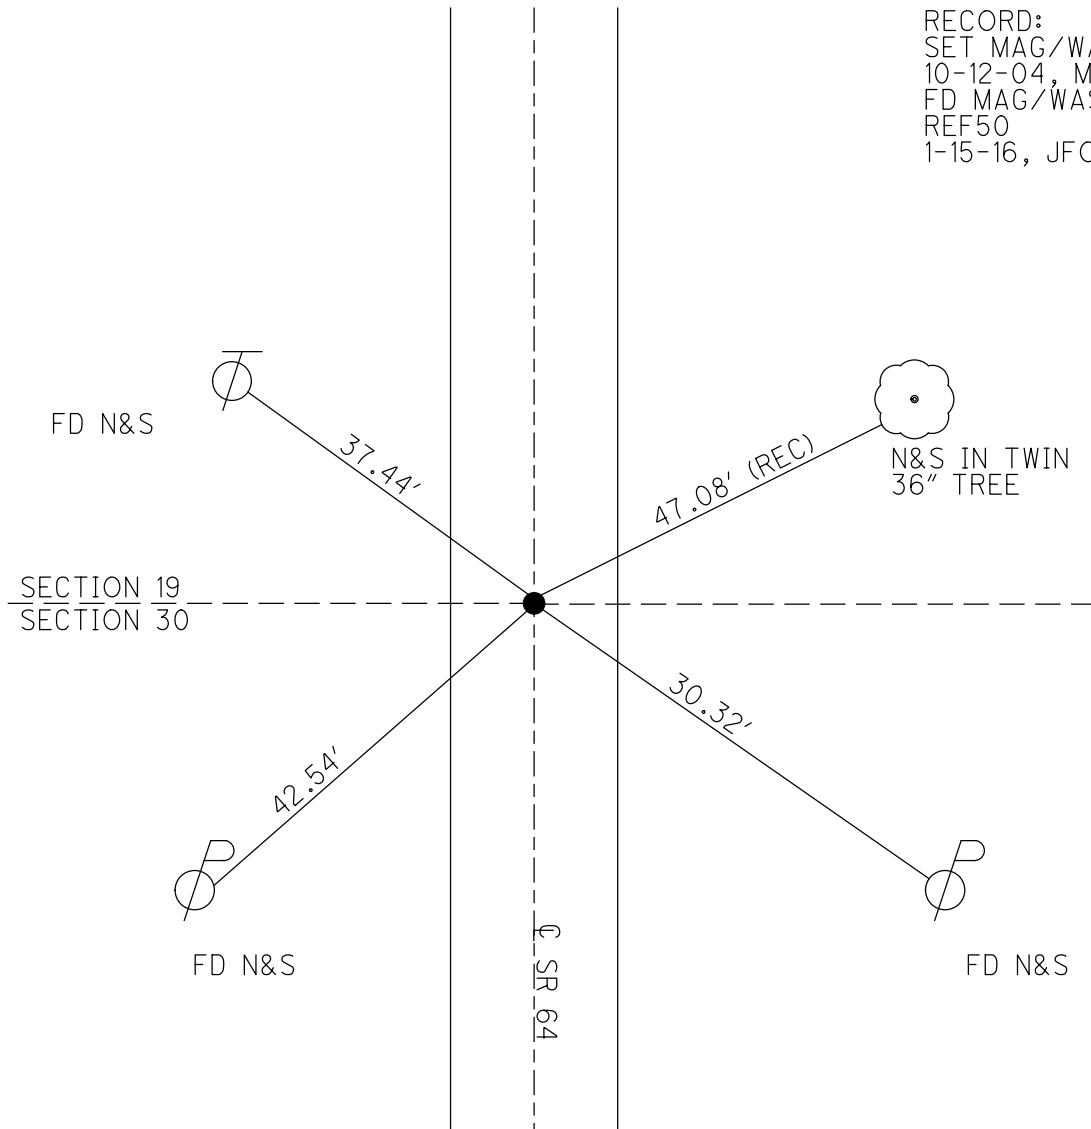

O.D.O.T. DISTRICT 2 SURVEY OFFICE

PERSONNEL

REFERENCE NO. 50

SHEET 3 OF 10

NOTES HUSS

DATE 6-16-04

ROUTE SR 64

H.C. HOMAN

WEATHER CLOUDY

COUNTY LUCAS

R.C. HUSS

TEMP. 74°

TOWNSHIP SWANTON

SECTION 19 & 30

T 7 N R 9 E


TYPE MONUMENT SM RR SPIKE

ON SURFACE - ~~BELOW~~ YES

LEFT - ~~C PAV'T - RIGHT~~ 1.0' LT


8.2 TO LT EDGE PAVEMENT

S.L.M. 524+25

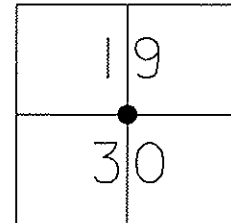

1/4 COR 19 & 30

SET MAG NAIL
& WASHER
10-12-04
MB

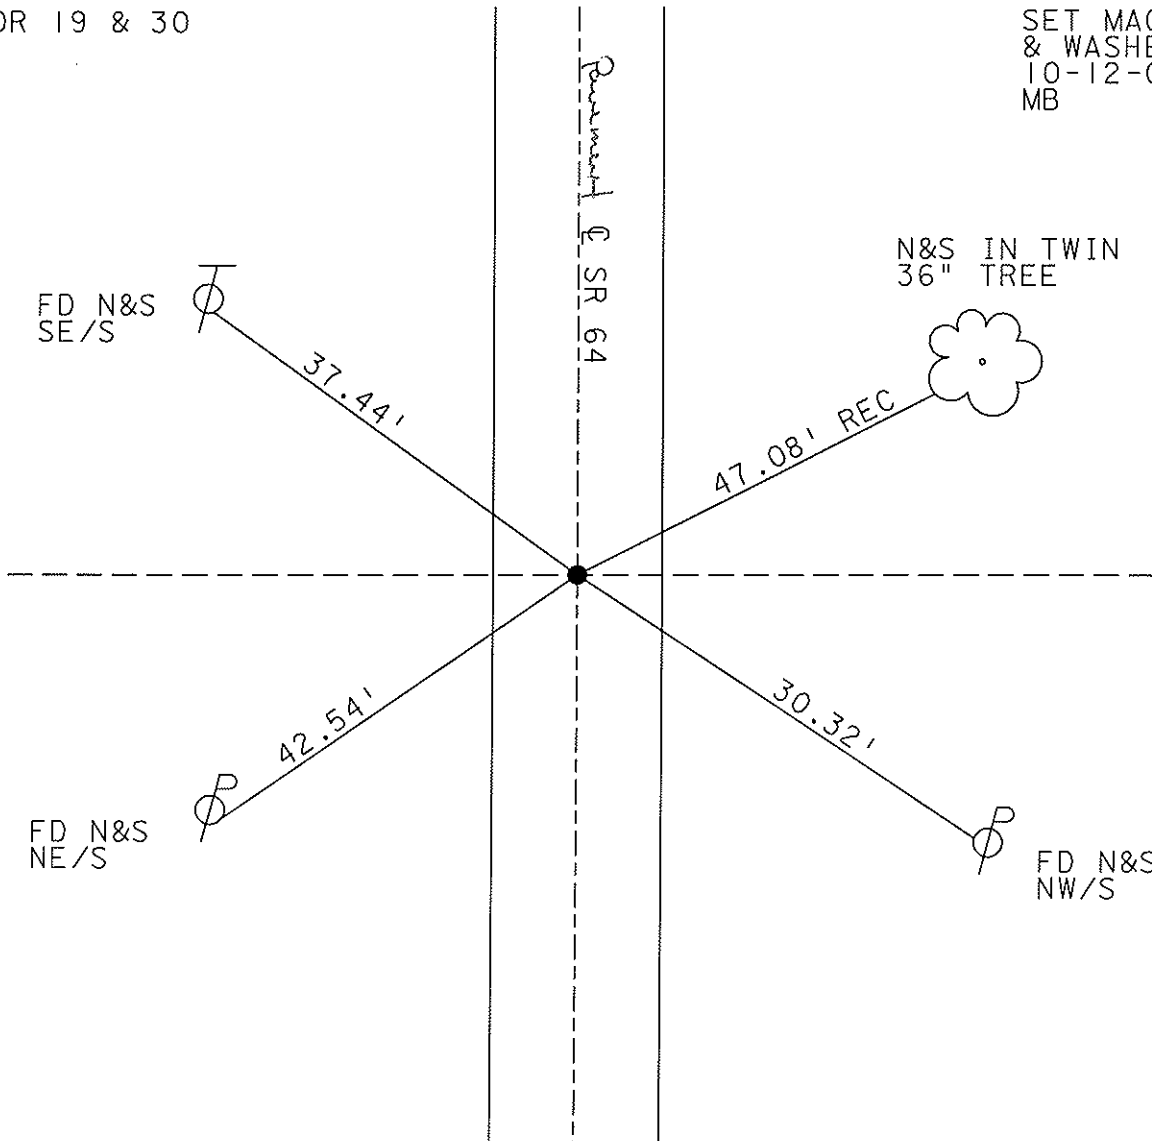

O.D.O.T. DISTRICT 2 SURVEY OFFICE

PERSONNEL

REFERENCE NO. 50

SHEET 3 OF 9

NOTES D. CURTIS

H.C. J. HOUSEHOLDER

R.C. _____

DATE 9-25-86

WEATHER CLOUDY

TEMP. 70°

ROUTE 64

COUNTY LUCAS

TOWNSHIP SWANTON

SECTION _____

T _____ R _____


TYPE MONUMENT R. R. SPK.

ON SURFACE - BELOW 2" BELOW SURF.


LEFT - CL PAV'T. - RIGHT CL PAV'T

_____ TO _____ EDGE PAVEMENT

S.L.M. 524 + 25

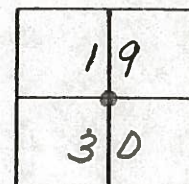


*Cor. 1/4 Cor. 19-30
Set Small RR Spk. 7/8/88 IRS*

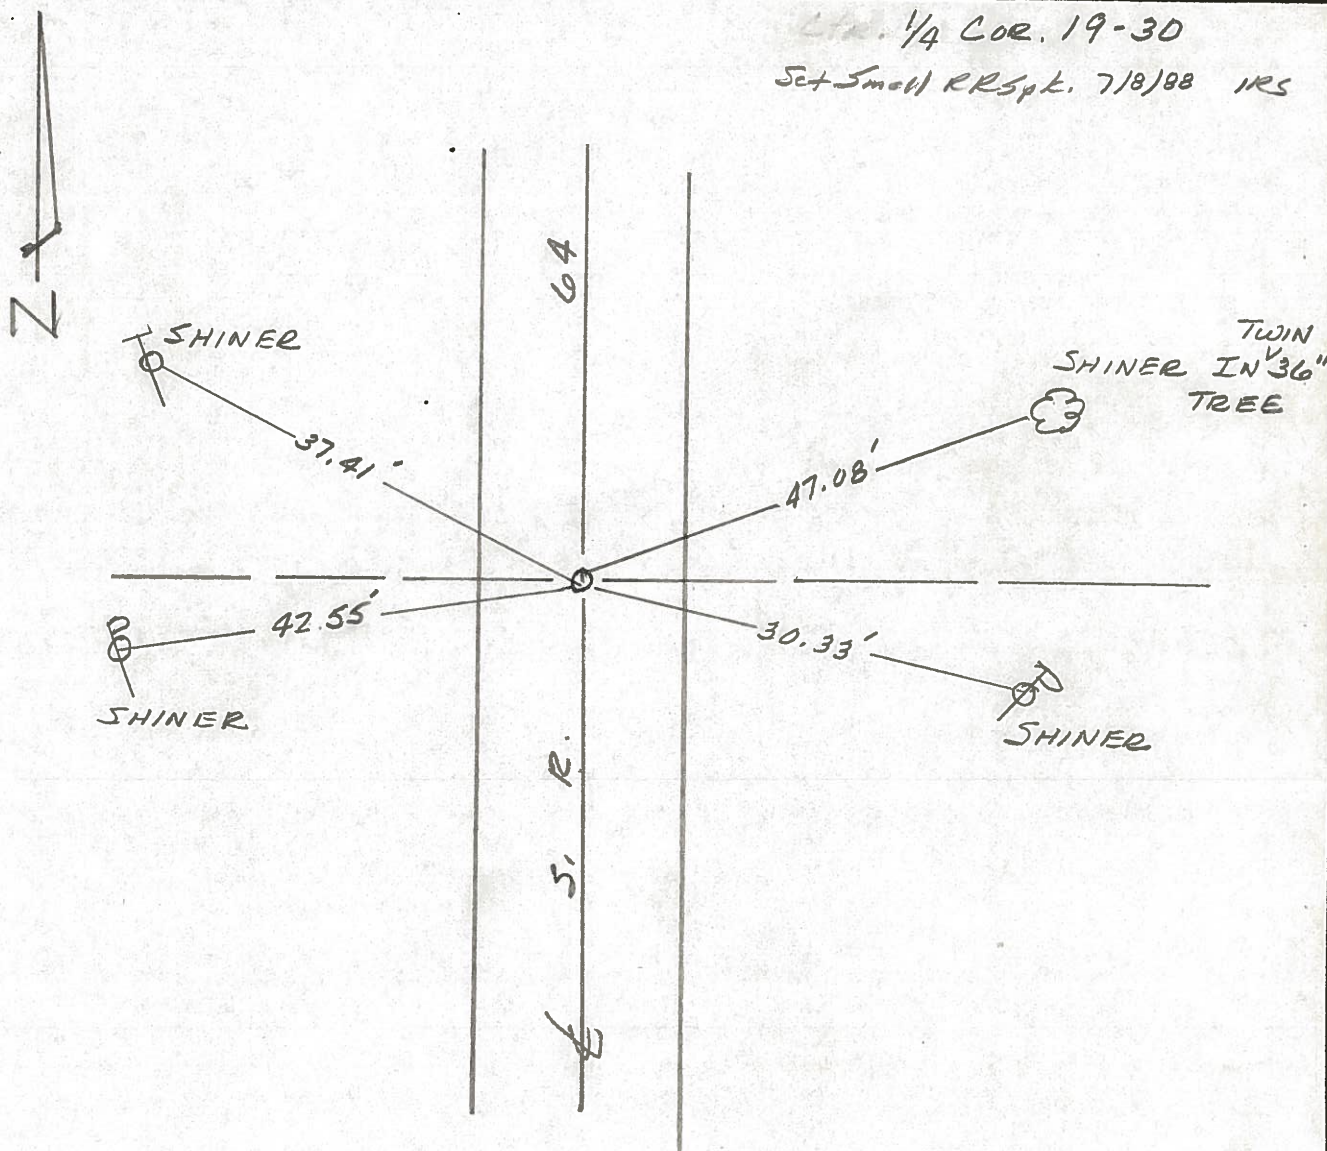

PERSONNEL	TITLE	PERSONNEL	TITLE	COUNTY	DATE	WEATHER	TEMP.
Stone		Grandy		Lucas	17 Mar. 77	Cool	78°
Michalak				S. R. 64			
Neuse				SEC.			
Curtis							

DESCRIPTION References to Control Points JOB NO. _____

LEFT CENTER LINE RIGHT

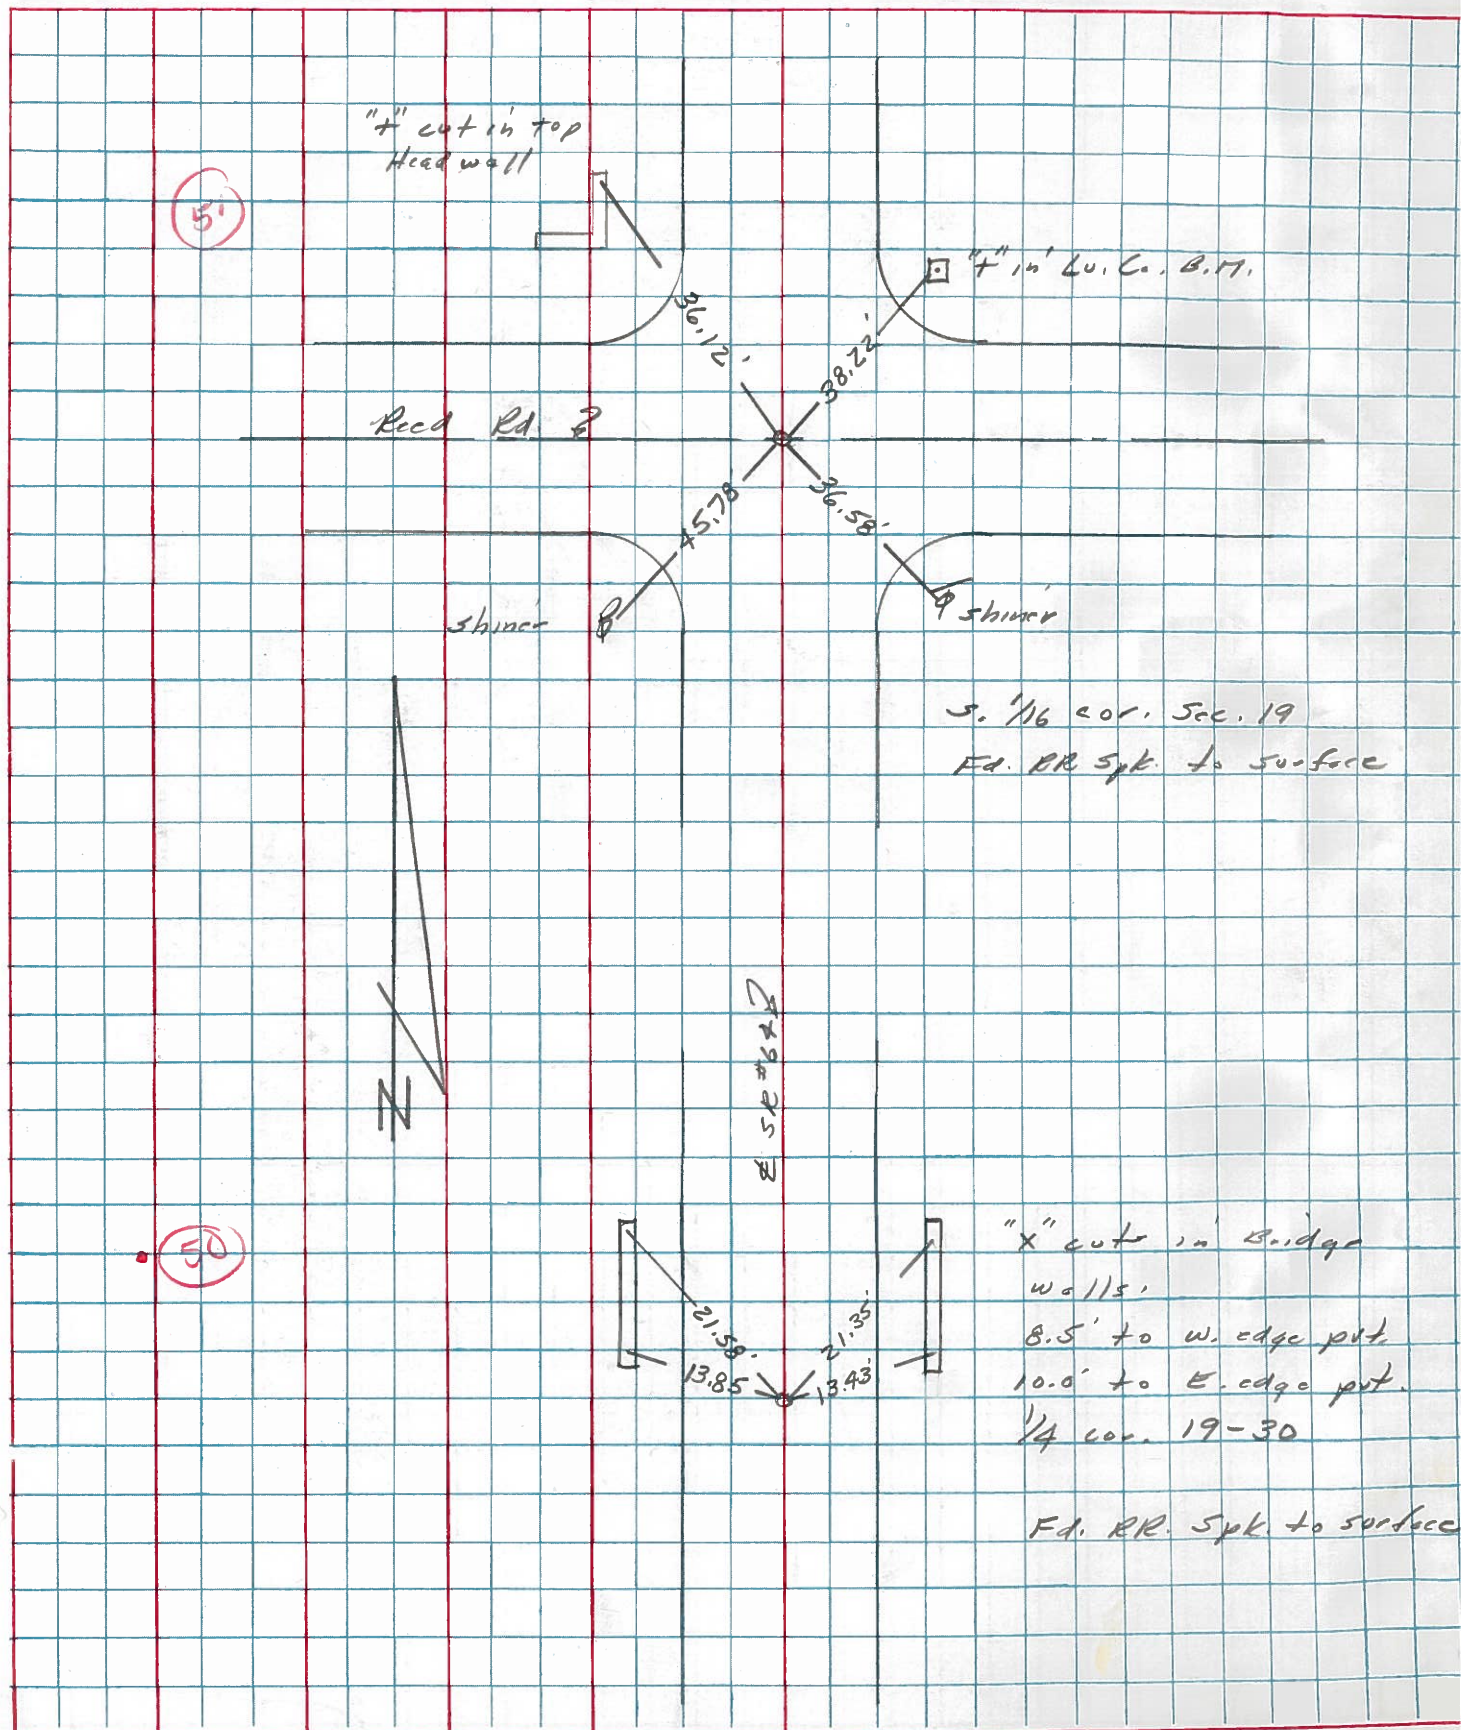


PERSONNEL	TITLE	PERSONNEL	TITLE	COUNTY	DATE	WEATHER	TEMP.
Tomsic				Lucas	July 22, 19	Fair	80°
Vanyo				S. R. #64			
Granata				SEC.			
Jackson							

DESCRIPTION Reference Monumenting S.R. #64 JOB NO. _____

Point is Located 2640 ± South of Recd Rd.

50

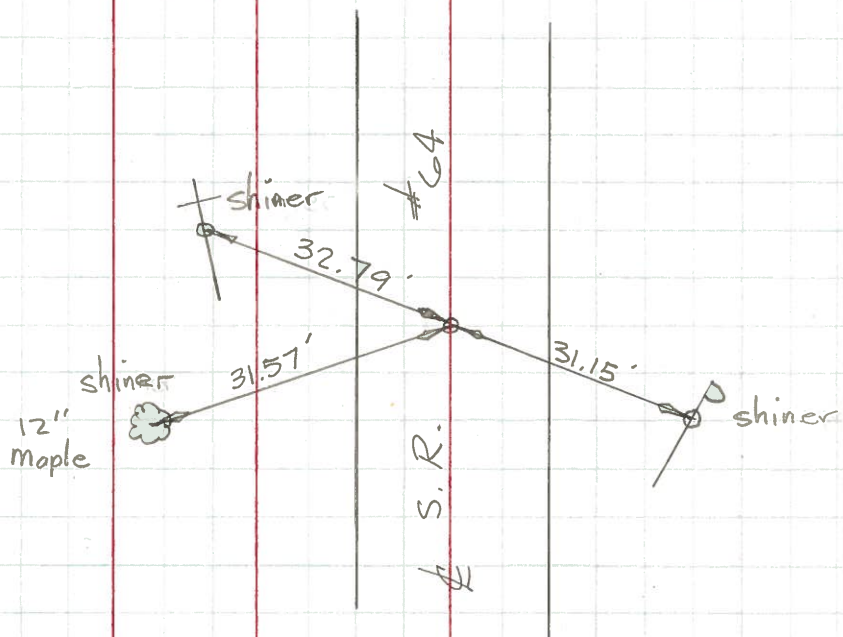

Found R.R. Spike at Surface

Point Located at Intesection of Wabash R.R. & S.R. #64

Oak Openings
Park Area

shiner

P

#64

shiner

Wabash

R.R.

S.R.

20.33'


shiner in base of wooden
"Railroad Crossing" sign
post.

Found Skinner in R.R. Track flush with Surface

PERSONNEL	TITLE	PERSONNEL	TITLE	COUNTY	DATE	WEATHER	TEMP.
W. Dennis				Lucas	Aug. 19, 19	warm	85°±
D. Curtis				S. R.	64		
J. Teal				SEC.			
J. Brindley							

DESCRIPTION S.R. 64-Ref. Mon. & Control Points

JOB NO. 02994(n)

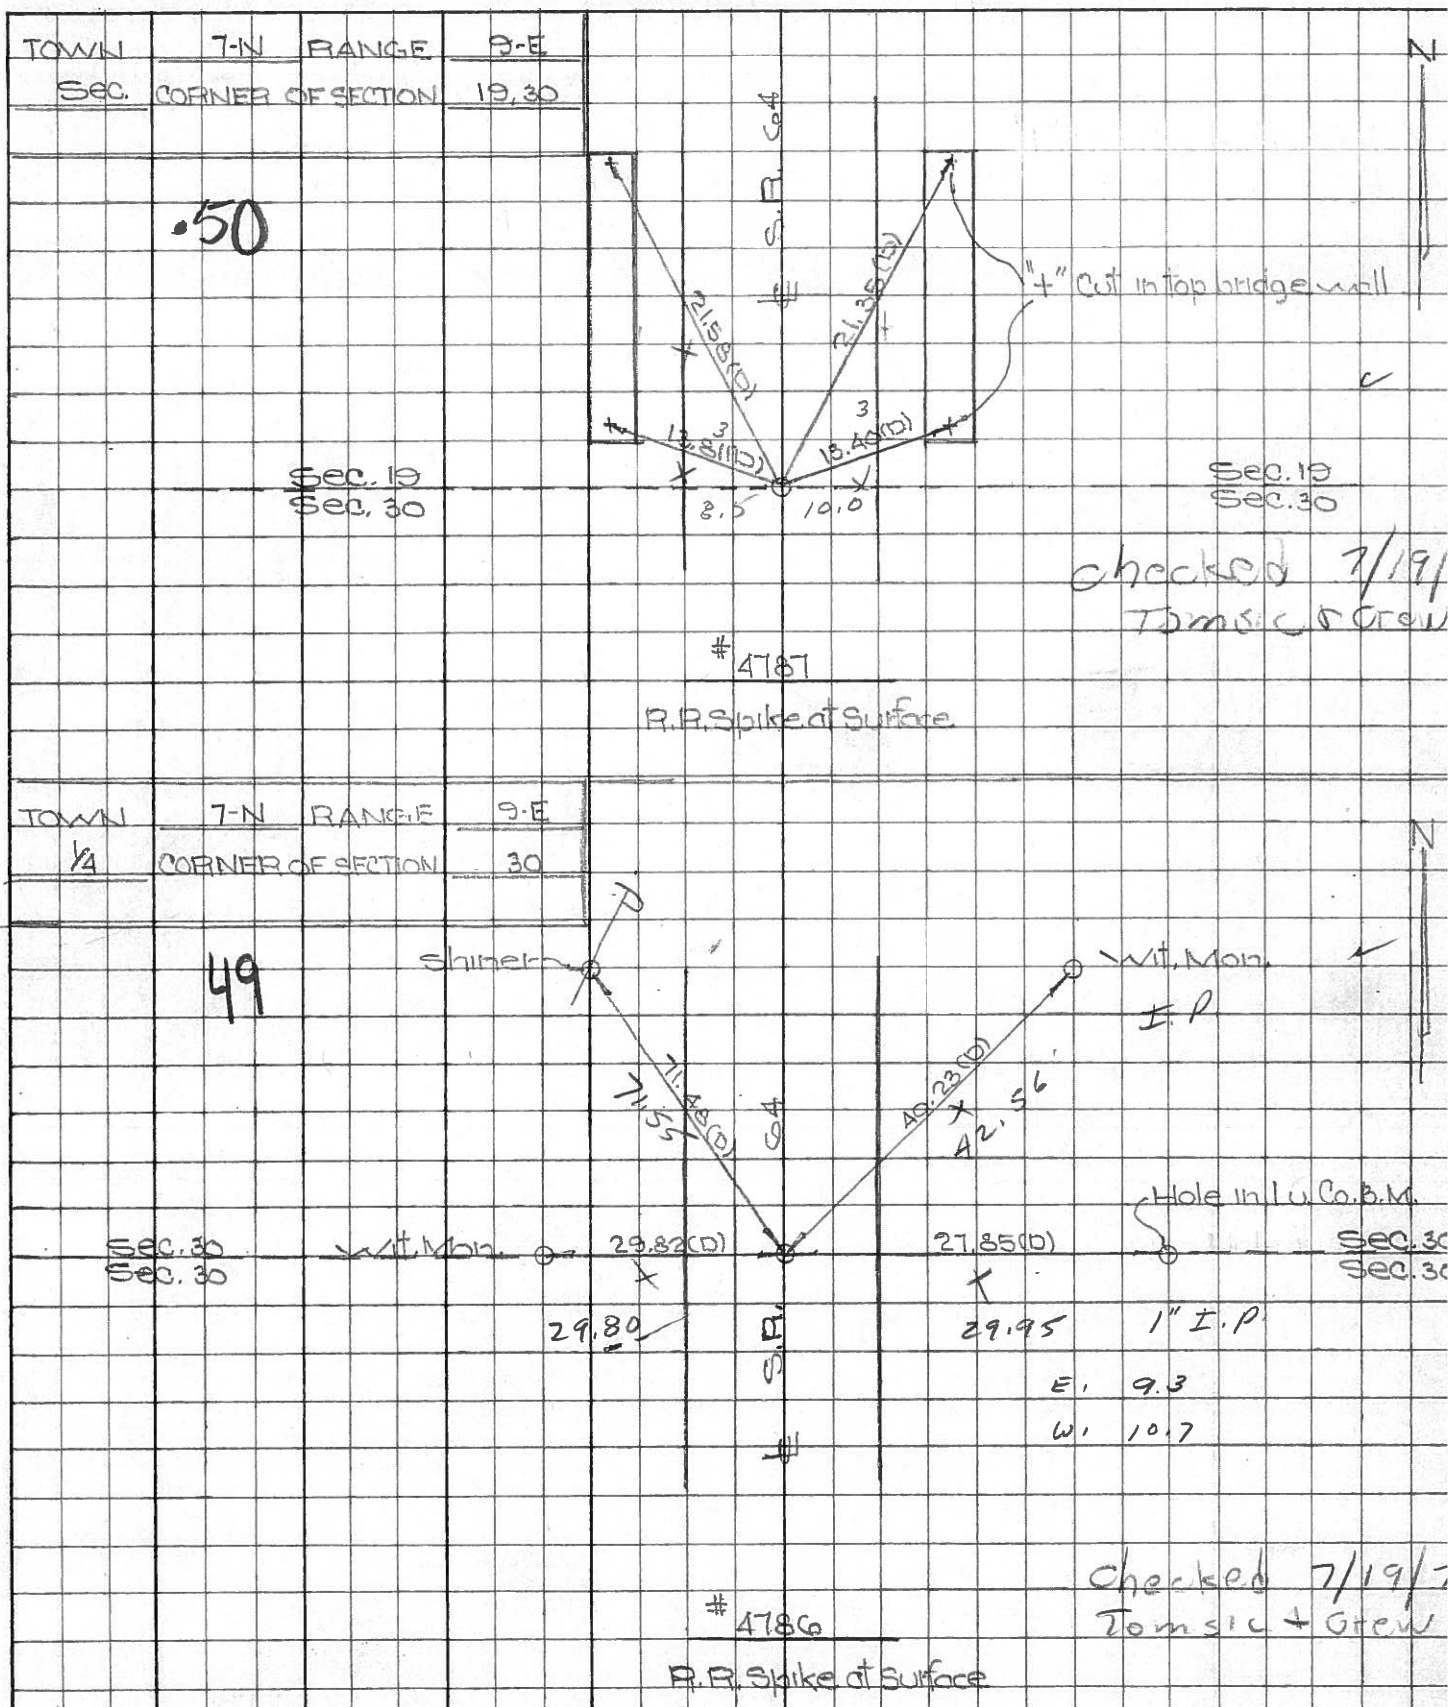

PERSONNEL	TITLE	PERSONNEL	TITLE	COUNTY	DATE	WEATHER	TEMP.
Slone				Lucas	4 Mar. 66	Windy	78°
Reck				S. R. #64			
Brindley							
Schroeder				SEC. N. From Sunshine Cons.			

DESCRIPTION	LEFT	CENTER LINE	RIGHT	JOB NO.
-------------	------	-------------	-------	---------

.50				
#199	N Line Sec. 30		13.41'	E. To "+" on S.E. Cor. Bridge Wall
	Fd. R.R. Spk.		13.82'	W. To "+" on S.W. Cor. Bridge Wall
	To Surface		21.32'	N.E. To "+" on N.E. Cor. Bridge Wall
			21.51'	N.W. To "+" on N.W. Cor. Bridge Wall
51				
#198	Int. Reel Rd.	44.02	22.78	S.W. To Cor. W. T. Mon. (D)
	Fd. R.R. Spk.	40.91	36.52	S.E. To Cor. W. T. Mon. (D)
	To Surface	38.22	28.25	N.E. To Holcom Lu. Co. R.M. (D)
			34.25	N.W. To Shiner in T.P. (D)
		36.08		N.W. "+" Cut in top Headwall
52				
#197	E & W. Sec. 19		27.46'	W. To Cor. W. T. Mon. (D)
	Fd. R.R. Spk.		43.98'	N.E. To Cor. W. T. Mon. (D)
	To Surface		39.48'	S.E. To Cor. W. T. Mon. (D)
			34.77	W.S.W. To Shiner in 8" Tree (D)
53				
#196	Between Wabash R.R. & Monclova Rd.	29.80	29.81'	W. S.W. To Shiner in T.P. (D)
	Fd. R.R. Spk.	28.71	29.07	N.E. To Shiner in T.P. (D)
	To Surface	36.75	28.69	E. To Cor. W. T. Mon. (D)
			37.05	N.W. To Cor. W. T. Mon. (D)
54				
#195	Int. Monclova Rd.		35.56'	S.E. To "+" on Cor. Head Wall (D)
	Fd. R.R. Spk.		39.30' OK	N.E. To "+" on Cor. Head Wall (D)
	To Surface		34.07	S.W. To Bottom of "V" in 2" Lumber (D)
			38.65	N.W. To "+" on Cor. Head Wall (D)
#194	Between Monclova Rd. & E & W. Sec. 18			
	Could Not Find			