

O.D.O.T. DISTRICT 2 SURVEY OFFICE (USE ONLY)

PERSONNEL

REFERENCE NO. 51

SHEET 50 OF 56

NOTES PRESTON-COLVIN

DATE 10-2-24

ROUTE SR 64

H.C.

WEATHER SUNNY

COUNTY LUCAS

R.C.

TEMP. 70°

TOWNSHIP WATERVILLE

NIESE

SECTION 19

DWG BY PRESTON-COLVIN PID PAVING TRAIN

T 7 N R 9 E

TYPE MONUMENT MAG/WASHER

ON SURFACE - BELOW ON

OFFSET $\varnothing$ PAVEMENT 1.2' $\perp$: RT

- TO - EDGE PAVEMENT

STATION: 536+83.88

HORIZ.DATUM: NAD83 (2011)


GEOID: NAVD88 2018

GRID: NORTHING: 688772.742


EASTING: 1592617.302

LDP: NORTHING: 309600.6136

EASTING: 102922.0141

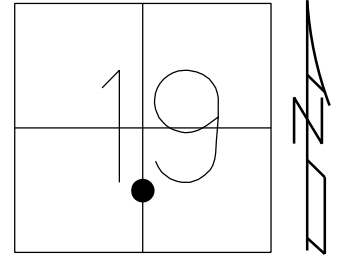


RECORD:
SET MAG/WASHER
10-12-04, MB
FD MAG/WASHER
REF51
1-15-16, JFO
REF51
6-6-19, JLL
REF51
8/23/22, TDN
11/21/22, TDN
FD MAG/WASHER
REF51
2/6/23, JAM
5/9/23, TDN
2/27/24, JMR
10-2-24, TDN

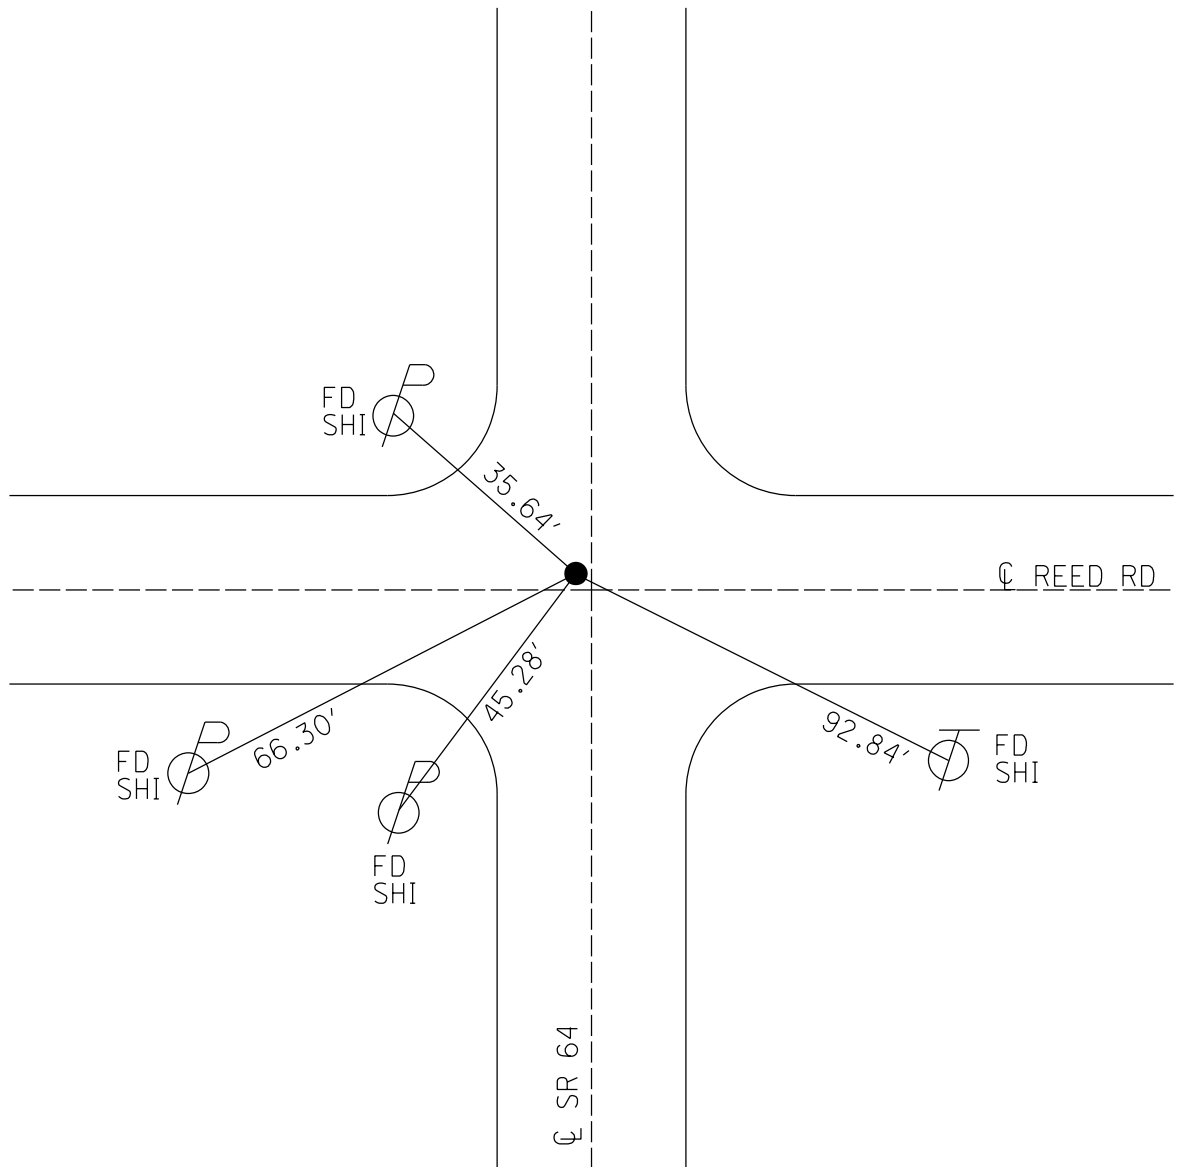


O.D.O.T. DISTRICT 2 SURVEY OFFICE (USE ONLY)

PERSONNEL	REFERENCE NO. <u>51</u>	SHEET <u>50</u> OF <u>56</u>
NOTES <u>NIESE</u>	DATE <u>5/9/23</u>	ROUTE <u>SR 64</u>
H.C. <u>AUBLE</u>	WEATHER <u>SUNNY</u>	COUNTY <u>LUCAS</u>
R.C. <u>ASTON</u>	TEMP. <u>60°</u>	TOWNSHIP <u>WATERVILLE</u>
		SECTION <u>19</u>
DWG BY <u>RHOADES</u>	PID <u>PAVING TRAIN</u>	T <u>7</u> N R <u>9</u> E
TYPE MONUMENT <u>MAG/WASHER</u>		
ON SURFACE - BELOW <u>ON</u>		
OFFSET <u>℄</u> PAVEMENT <u>1.2'</u> LT : RT		
<u>-</u> TO <u>-</u> EDGE PAVEMENT		
STATION: <u>536+83.88</u>		
HORZ.DATUM: <u>NAD83 (2011)</u>		GEOID: <u>NAVD88 2018</u>
GRID: NORTHING: <u>688772.742</u>		EASTING: <u>1592617.302</u>

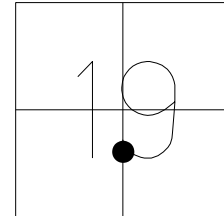

RECORD:
 SET MAG/WASHER
 10-12-04, MB
 FD MAG/WASHER
 REF51
 1-15-16, JFO
 REF51
 6-6-19, JLL
 REF51
 8/23/22, TDN
 11/21/22, TDN
 FD MAG/WASHER
 REF51
 2/6/23, JAM
 5/9/23, TDN
 2/27/24, JMR

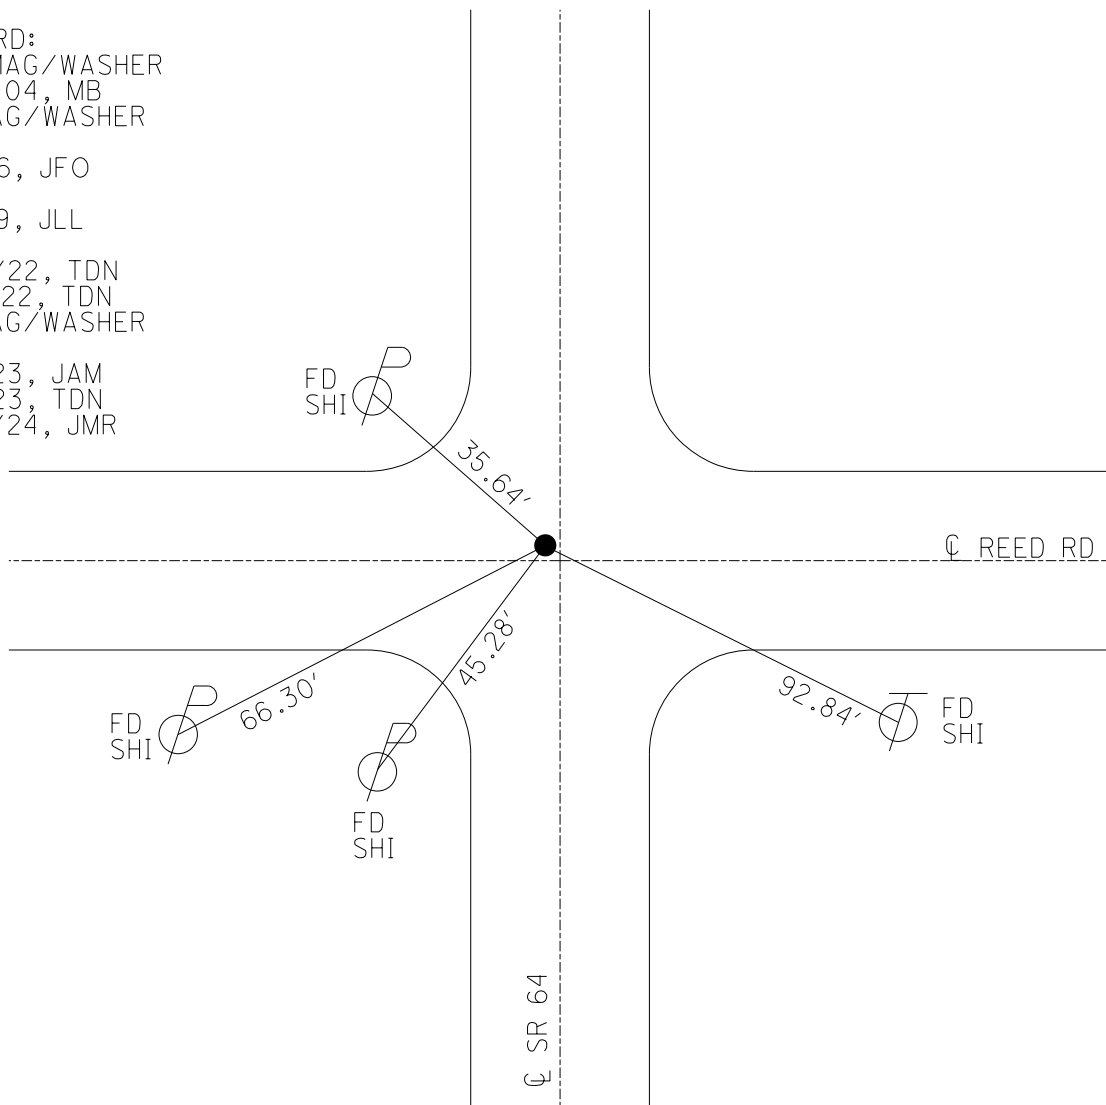

O.D.O.T. DISTRICT 2 SURVEY OFFICE (USE ONLY)

PERSONNEL

REFERENCE NO. 51

SHEET 50 OF 56

NOTES AUBLE

DATE 5/7/20

ROUTE SR 64

H.C. LEU

WEATHER WINDY

COUNTY LUCAS

R.C. BALBAUGH

TEMP. 66°

TOWNSHIP WATERVILLE

DWG BY GARRETT

PID 107059

SECTION 19

T 7 N R 9 E

TYPE MONUMENT MAG/WASHER

ON SURFACE - ~~BELOW~~ ON

OFFSET CL PAVEMENT 1.2' LT : ~~RT~~

- TO - EDGE PAVEMENT


STATION: 536+83.88

HORZ.DATUM: NAD83 (2011)


GEOID: 2012A

GRID: NORTHING: 688772.742

EASTING: 1592617.302

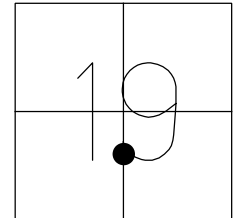

RECORD:
SET MAG/WASHER
10-12-04, MB
FD MAG/WASHER
REF51
1-15-16, JFO
REF51
6-6-19, JLL
REF51
8/23/22, TDN
11/21/22, TDN

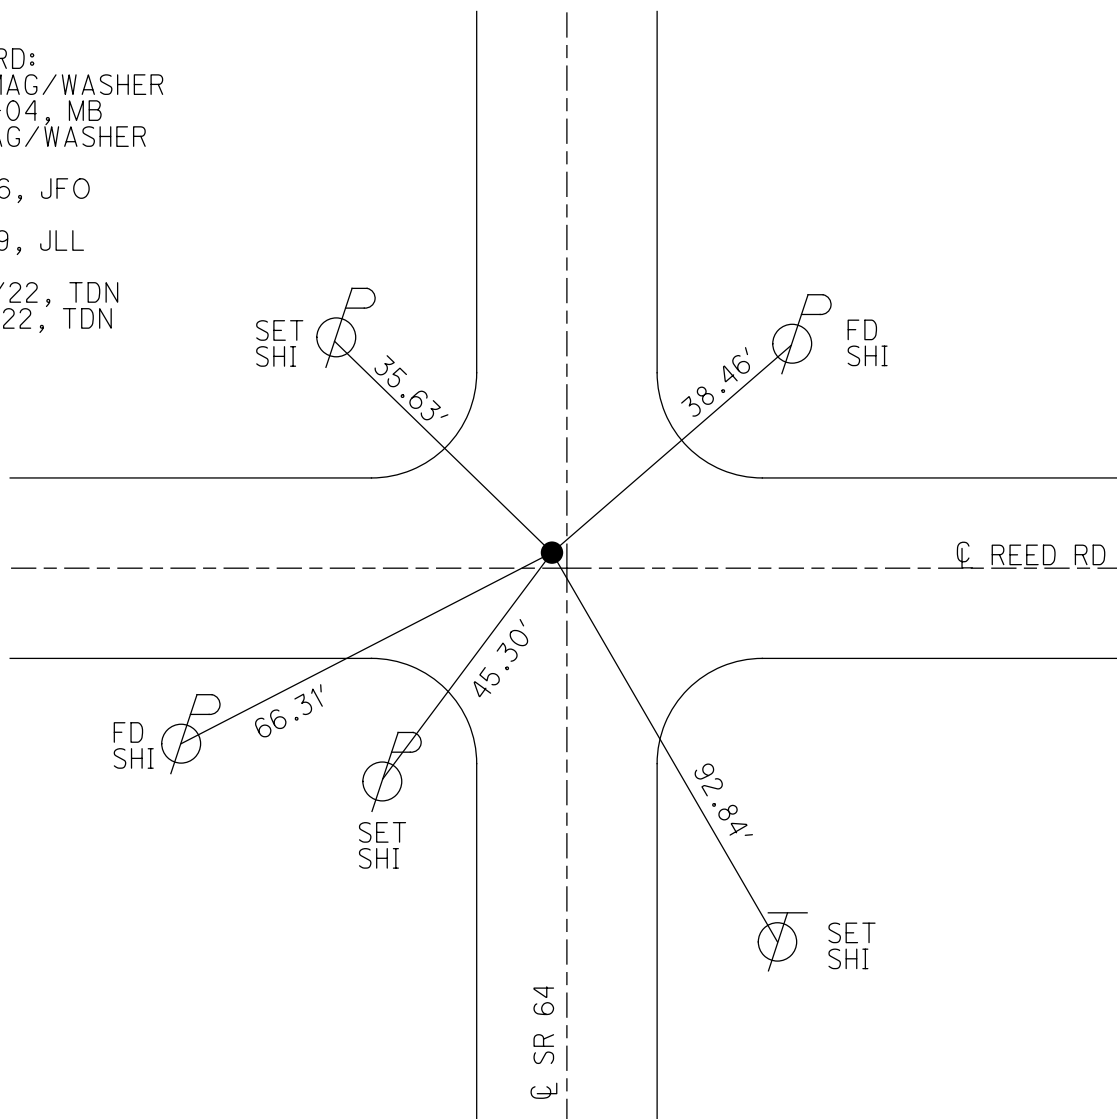

O.D.O.T. DISTRICT 2 SURVEY OFFICE (USE ONLY)

PERSONNEL

REFERENCE NO. 51

SHEET 50 OF 56

NOTES AUBLE

DATE 5/7/20

ROUTE SR 64

H.C. LEU

WEATHER WINDY

COUNTY LUCAS

R.C. BALBAUGH

TEMP. 66°

TOWNSHIP WATERVILLE

DWG BY GARRETT

PID 107059

SECTION 19

T 7 N R 9 E

TYPE MONUMENT MAG NAIL

ON SURFACE - ~~BELOW~~ ON

OFFSET Q PAVEMENT 1.2' LT : ~~RT~~

- TO - EDGE PAVEMENT


STATION: 536+83.88

HORIZ.DATUM: NAD83 (2011)


GEOID: 2012A

GRID: NORTHING: 688772.726

EASTING: 1592617.317

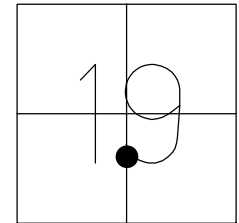

RECORD:
SET MAG/WASHER
10-12-04, MB
FD MAG/WASHER
REF51
1-15-16, JFO
FD MAG/WASHER
RECRE51
6-6-19, JLL

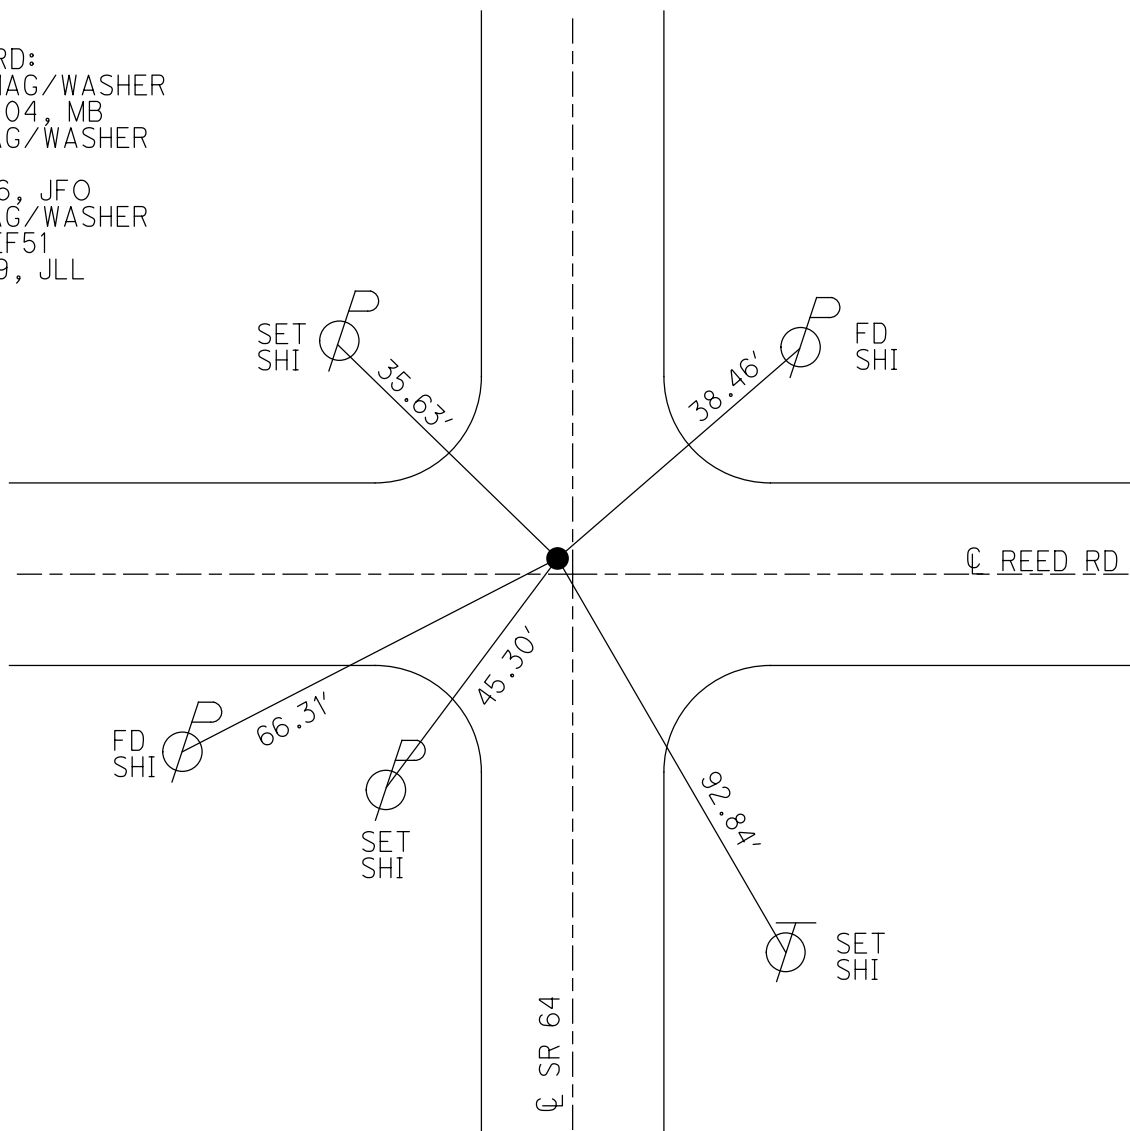

O.D.O.T. DISTRICT 2 SURVEY OFFICE (USE ONLY)

PERSONNEL

REFERENCE NO. 51

SHEET 50 OF 50

NOTES HUSS

DATE 6-16-04

ROUTE SR 64

H.C. HOMAN

WEATHER CLOUDY

COUNTY LUCAS

R.C. HUSS

TEMP. 74°

TOWNSHIP WATERVILLE

SECTION 19

T 7 N R 5 E

TYPE MONUMENT SM.R.R.SPIKE


ON SURFACE - ~~BELOW~~ ON

LEFT - ℄ PAV'T - ~~RIGHT~~ 1.2'


TO EDGE PAVEMENT

S.L.M. 537+68.45

Grid: Northing: 688772.726 Easting: 1592617.3174

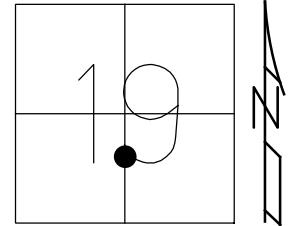

S¹/₁₆COR SEC 19

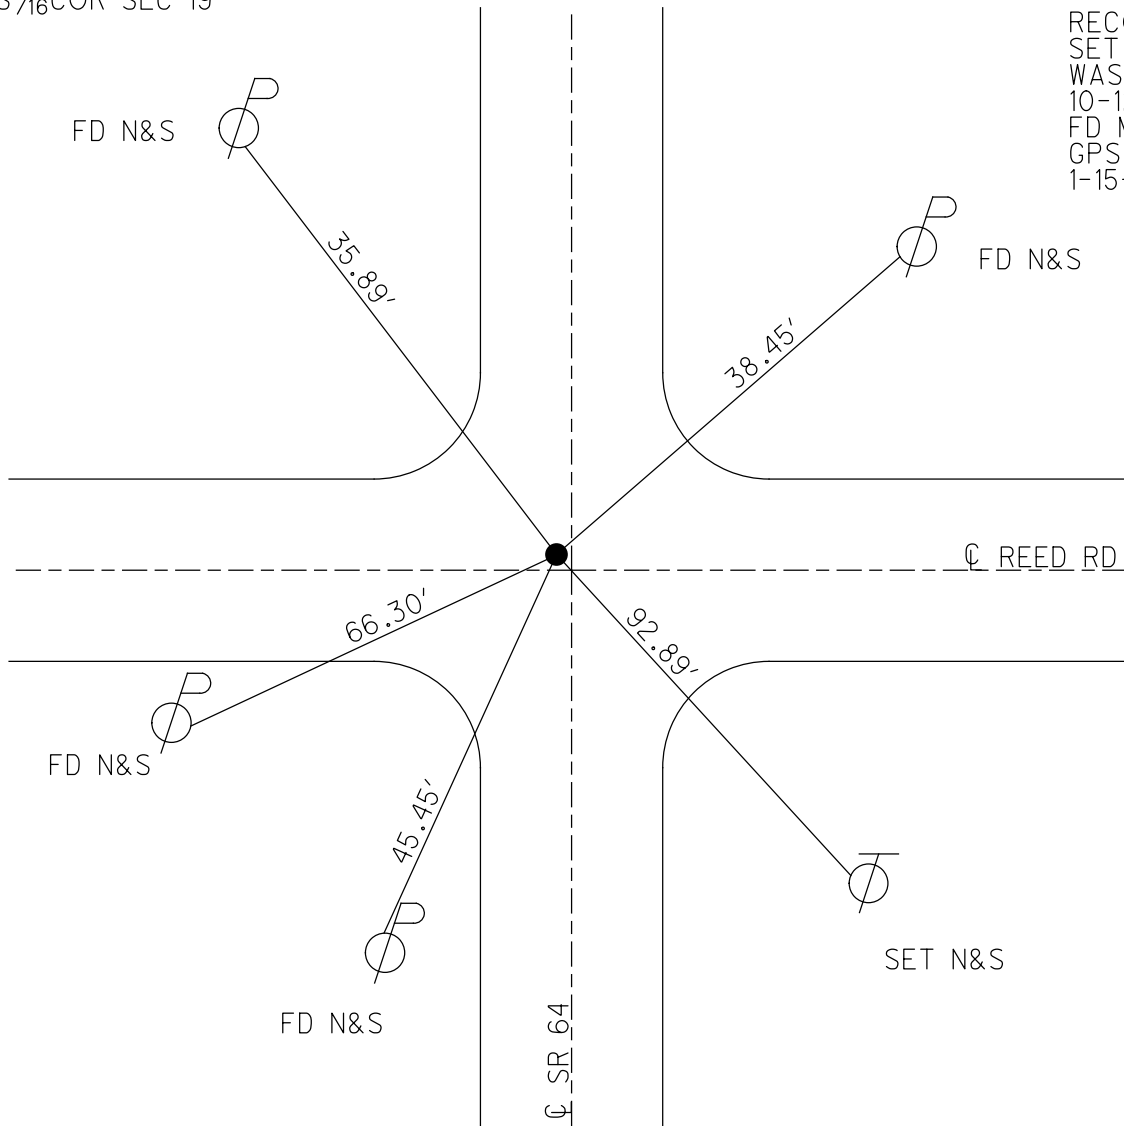

RECORD:
SET MAG NAIL &
WASHER
10-12-04, MB
FD MAG/W
GPS REF51
1-15-16, JFO

O.D.O.T. DISTRICT 2 SURVEY OFFICE

PERSONNEL

NOTES _____
H.C. _____
R.C. _____


REFERENCE NO. 51

DATE 6-16-04
WEATHER CLOUDY
TEMP. 74°

SHEET 4 OF 10


ROUTE SR 64
COUNTY LUCAS
TOWNSHIP SWANTON
SECTION 19
T 7 N R 5 E

TYPE MONUMENT _____ SM RR SPIKE
ON SURFACE - ~~BELOW~~ _____ YES
LEFT - ~~C PAVT~~ RIGHT 1.2' LT
_____ TO _____ EDGE PAVEMENT
S.L.M. _____ 537+48

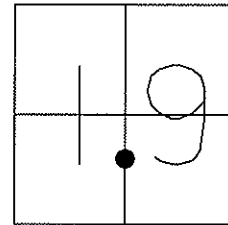

S¹/₁₆ COR SEC 19

SET MAG NAIL
& WASHER
10-12-04
MB

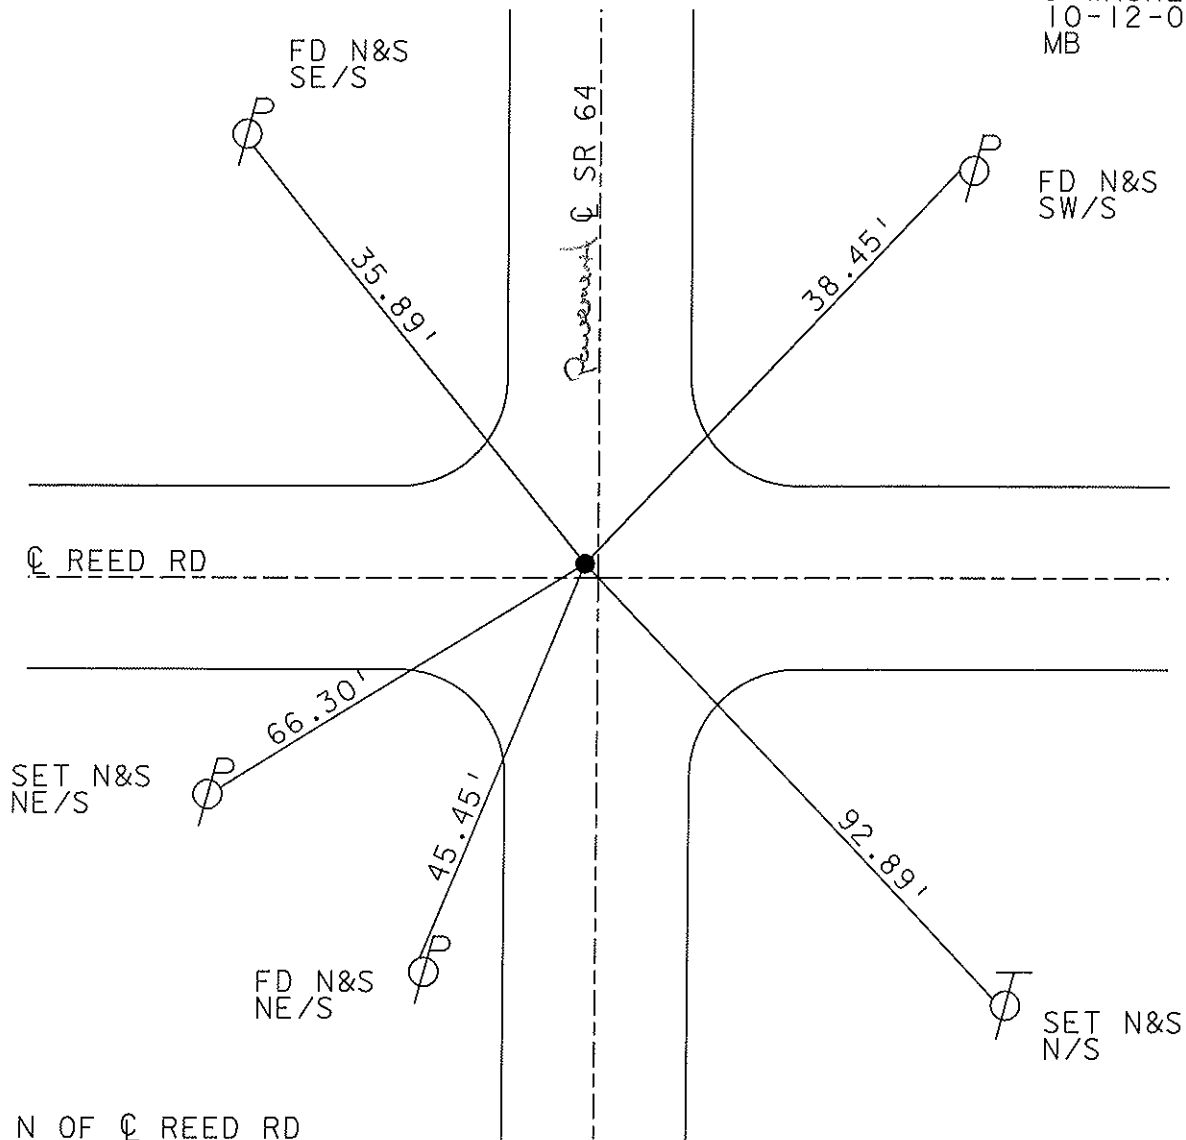

1.5' N OF C REED RD

O.D.O.T. DISTRICT 2 SURVEY OFFICE

PERSONNEL

REFERENCE NO. 51

SHEET 4 OF 9

NOTES D. CURTIS

H.C. J. HOUSEHOLDER

R.C. _____

DATE 9-25-86

WEATHER CLOUDY

TEMP. 70°

ROUTE 64

COUNTY LUCAS

TOWNSHIP SWANTON

SECTION _____

T _____ R _____


TYPE MONUMENT R. R. SPK.

ON SURFACE - BELOW 2" BELOW SURF.

LEFT- & PAV'T. - RIGHT & BOTH PAV'T


TO _____ EDGE PAVEMENT

S.L.M. 537 + 48

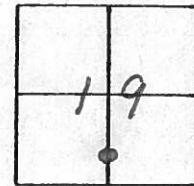

S. 1/16 COR. SEC. 19


Set Small RR Spk. 7/8/86 IRS

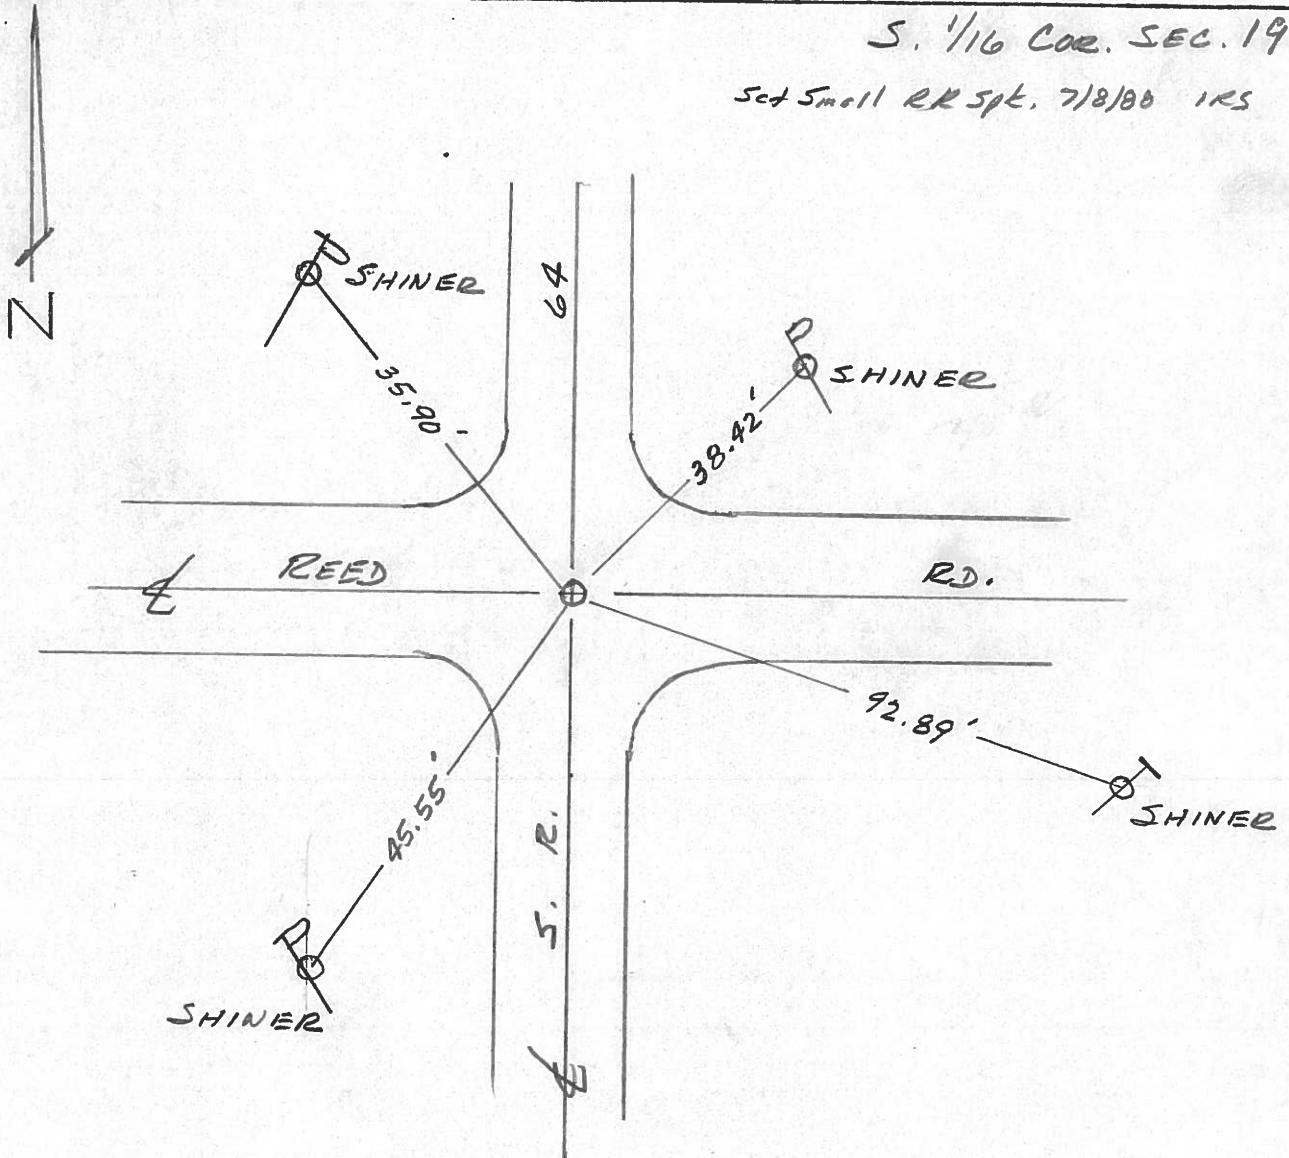

SHEET NO. 27

PERSONNEL TITLE PERSONNEL TITLE COUNTY Lucas DATE 17 Mar. 7
Stone Grandy
Michaelak S. R. 64 WEATHER Cool
Neuse SEC. _____ TEMP. 78°
Curtis
 DESCRIPTION References to Control Points JOB NO. _____
 LEFT CENTER LINE RIGHT

PERSONNEL	TITLE	PERSONNEL	TITLE
W. Denno			
D. Curtis			
J. Teal			
J. Brindley			

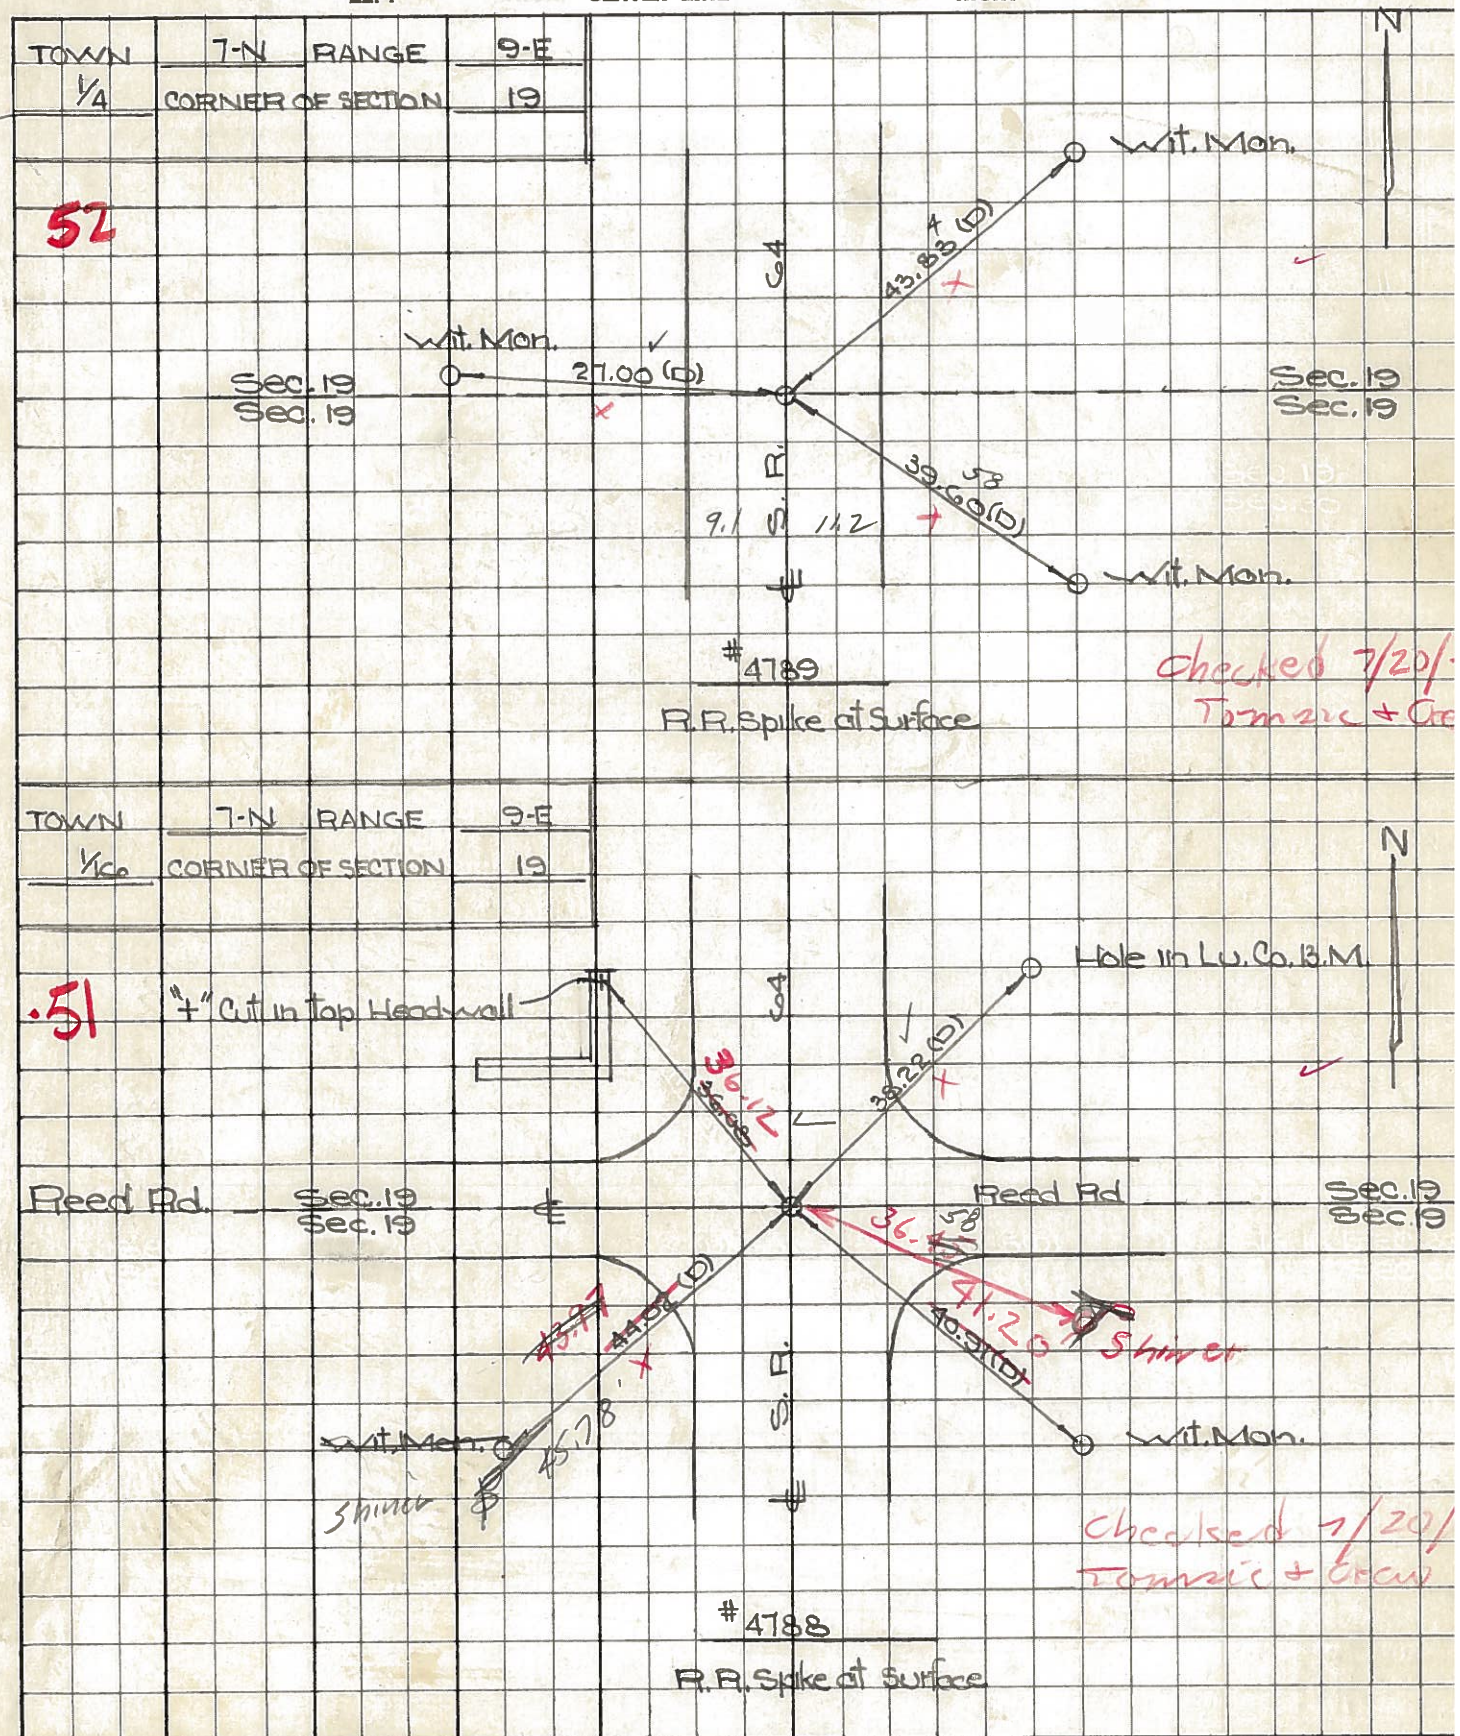COUNTY Lucas DATE Aug. 19, 1966S. R. G4 WEATHER warmSEC. 19 TEMP. 85°±DESCRIPTION S.R. G4 - Ref. Mon. & Control Points JOB NO. 02994(0)

PERSONNEL	TITLE	PERSONNEL	TITLE	COUNTY	DATE	WEATHER	TEMP.
Slone				Lucas	4 Mar. 66	Windy	78°
Reck				S. R. #64			
Brindley							
Schroeder				SEC. N. From Sunshine Cons.			

DESCRIPTION	LEFT	CENTER LINE	RIGHT	JOB NO.
-------------	------	-------------	-------	---------

.50				
#199	N Line Sec. 30		13.41'	E. To "+" on S.E. Cor. Bridge Wall
	Fd. R.R. Spk.		13.82'	W. To "+" on S.W. Cor. Bridge Wall
	To Surface		21.32'	N.E. To "+" on N.E. Cor. Bridge Wall
			21.51'	N.W. To "+" on N.W. Cor. Bridge Wall
51				
#198	Int. Reel Rd.	44.02	22.78	S.W. To Cor. W. T. Mon. (D)
	Fd. R.R. Spk.	40.91	36.52	S.E. To Cor. W. T. Mon. (D)
	To Surface	38.22	28.25	N.E. To Holcom Lu. Co. R.M. (D)
			34.25	N.W. To Shiner in T.P. (D)
		36.08		N.W. "+" Cut in top Headwall
52				
#197	E & W. Sec. 19		27.46'	W. To Cor. W. T. Mon. (D)
	Fd. R.R. Spk.		43.98'	N.E. To Cor. W. T. Mon. (D)
	To Surface		39.48'	S.E. To Cor. W. T. Mon. (D)
			34.77	W.S.W. To Shiner in 8" Tree (D)
53				
#196	Between Wabash R.R. & Monclova Rd.	29.80	29.81'	W. S.W. To Shiner in T.P. (D)
	Fd. R.R. Spk.	28.71	29.07	N.E. To Shiner in T.P. (D)
	To Surface	36.75	28.69'	E. To Cor. W. T. Mon. (D)
			37.05	N.W. To Cor. W. T. Mon. (D)
54				
#195	Int. Monclova Rd.		35.56'	S.E. To "+" on Cor. Head Wall (D)
	Fd. R.R. Spk.		39.30' OK	N.E. To "+" on Cor. Head Wall (D)
	To Surface		34.07	S.W. To Bottom of "V" in 2" Lumber (D)
			38.65	N.W. To "+" on Cor. Head Wall (D)
#194	Between Monclova Rd. & E & W. Sec. 18			
	Could Not Find			