

O.D.O.T. DISTRICT 2 SURVEY OFFICE (USE ONLY)

PERSONNEL

REFERENCE NO. 52

SHEET 51 OF 56

NOTES PRESTON-COLVIN

DATE 10-2-24

ROUTE SR 64

H.C.

WEATHER SUNNY

COUNTY LUCAS

R.C.

TEMP. 70°

TOWNSHIP SWANTON

NIESE

SECTION 19

DWG BY PRESTON-COLVIN PID PAVING TRAIN

T 7 N R 9 E

TYPE MONUMENT MAG/WASHER

ON SURFACE - BELOW ON

OFFSET Q PAVEMENT 1.5' LT : RT

8.8' TO LT EDGE PAVEMENT

STATION: 550+06.39

HORIZ.DATUM: NAD83 (2011)


GEOID: NAVD88 2018

GRID: NORTHING: 690094.953


EASTING: 1592644.632

LDP: NORTHING: 310923.1373

EASTING: 102931.9441

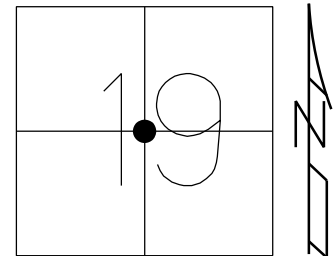

RECORD:
SET MAG/WASHER
10-12-04, MB
FD MAG/WASHER
REF52
3-6-19, JLL
REF52
8/23/22, TDN
11/21/22, TDN
FD MAG/WASHER
REF52
2/6/23, JAM
5/9/23, TDN
2/27/24, JMR
10-2-24, TDN


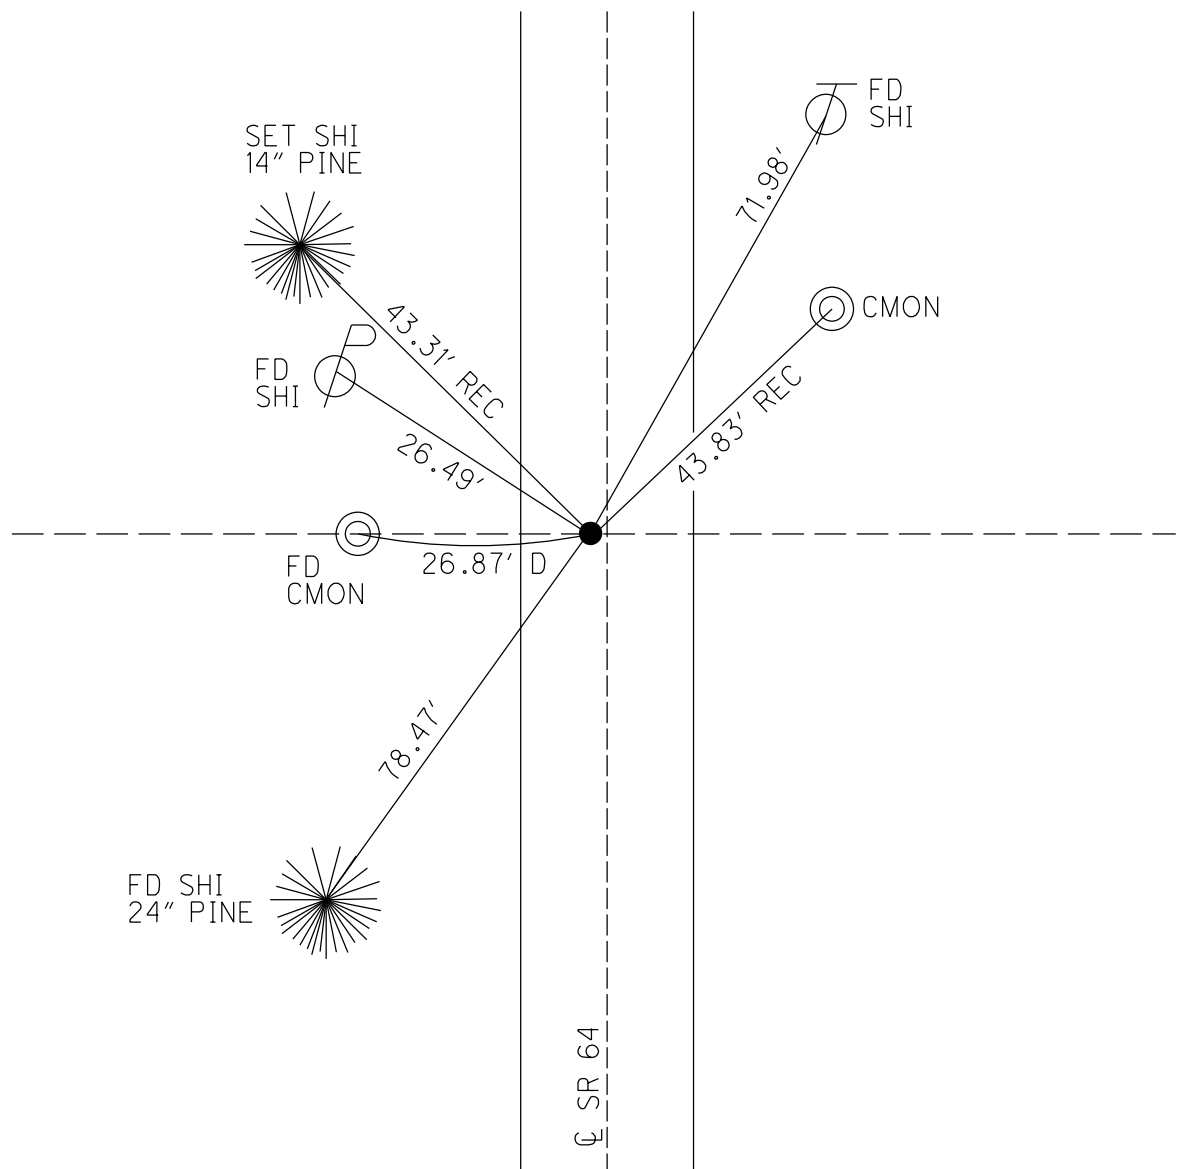


O.D.O.T. DISTRICT 2 SURVEY OFFICE (USE ONLY)

PERSONNEL _____ REFERENCE NO. 52 SHEET 51 OF 56
NOTES NIESE DATE 5/9/23 ROUTE SR 64
H.C. AUBLE WEATHER SUNNY COUNTY LUCAS
R.C. ASTON TEMP. 60° TOWNSHIP SWANTON
SECTION 19
DWG BY RHOADES PID PAVING TRAIN T 7 N R 9 E

TYPE MONUMENT MAG/WASHER
ON SURFACE - ~~BELOW~~ ON
OFFSET CL PAVEMENT 1.5' LT : ~~RT~~
8.8' TO LT EDGE PAVEMENT
STATION: 550+06.39

HORIZ.DATUM: NAD83 (2011) GEOID: NAVD88 2018
GRID: NORTHING: 690094.953 EASTING: 1592644.632

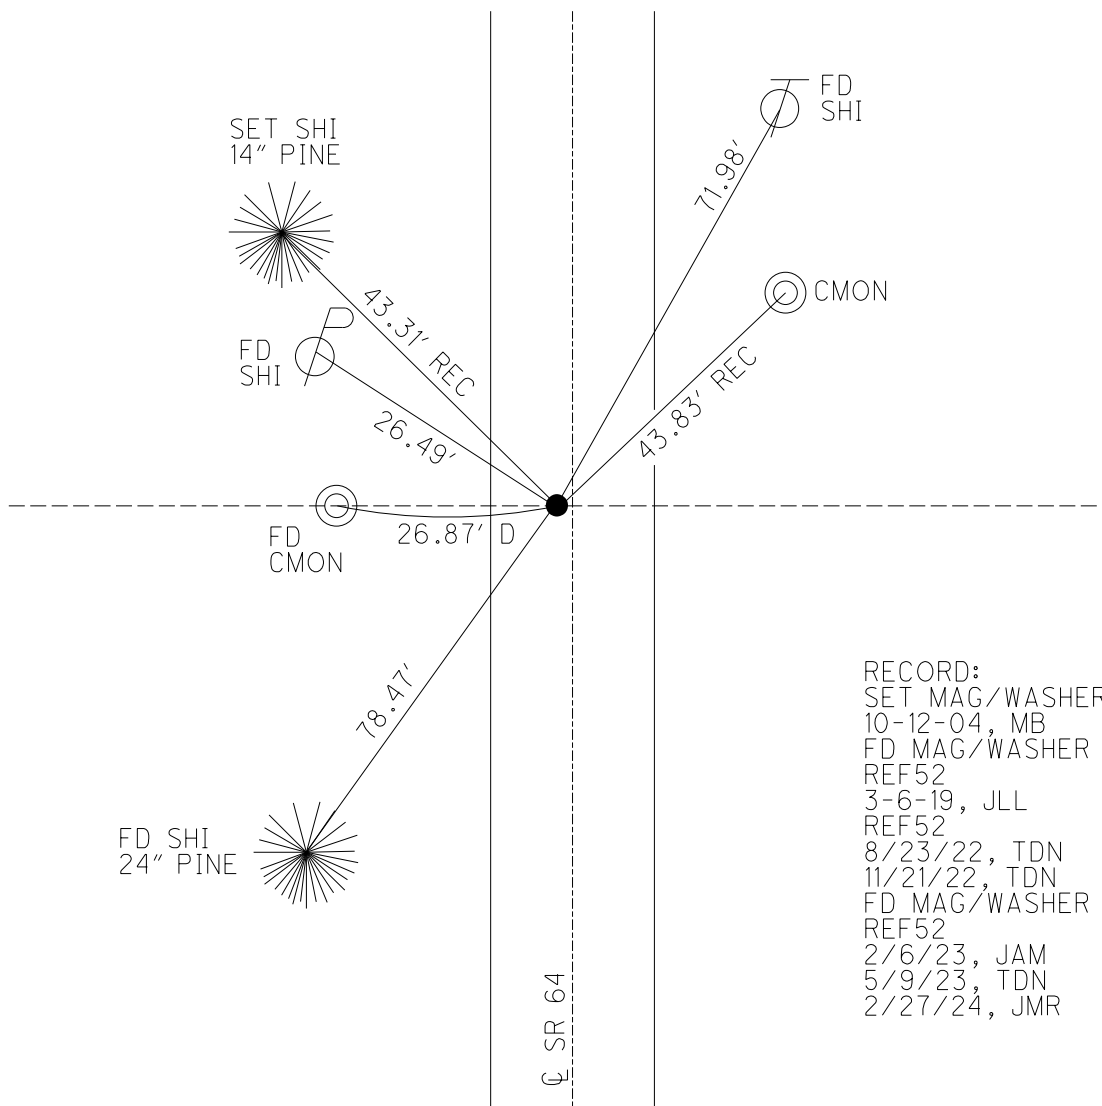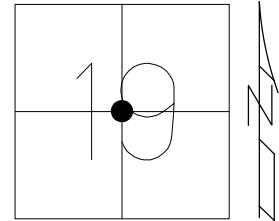

RECORD:
SET MAG/WASHER
10-12-04, MB
FD MAG/WASHER
REF52
3-6-19, JLL
REF52
8/23/22, TDN
11/21/22, TDN
FD MAG/WASHER
REF52
2/6/23, JAM
5/9/23, TDN
2/27/24, JMR

O.D.O.T. DISTRICT 2 SURVEY OFFICE (USE ONLY)

PERSONNEL

REFERENCE NO. 52

SHEET 51 OF 56

NOTES AUBLE

DATE 5/7/20

ROUTE SR 64

H.C. LEU

WEATHER WINDY

COUNTY LUCAS

R.C. BALBAUGH

TEMP. 66°

TOWNSHIP SWANTON

DWG BY GARRETT

PID 107059

SECTION 19

T 7 N R 9 E

TYPE MONUMENT MAG/WASHER

ON SURFACE - ~~BELOW~~ ON

OFFSET Q PAVEMENT 1.5' LT : ~~RT~~

8.8' TO LT EDGE PAVEMENT


STATION: 550+06.39

HORIZ.DATUM: NAD83 (2011)


GEOID: 2012A

GRID: NORTHING: 690094.953

EASTING: 1592644.632

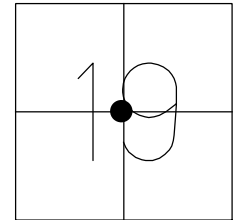

RECORD:
SET MAG/WASHER
10-12-04, MB
FD MAG/WASHER
REF52
3-6-19, JLL
REF52
8/23/22, TDN
11/21/22, TDN

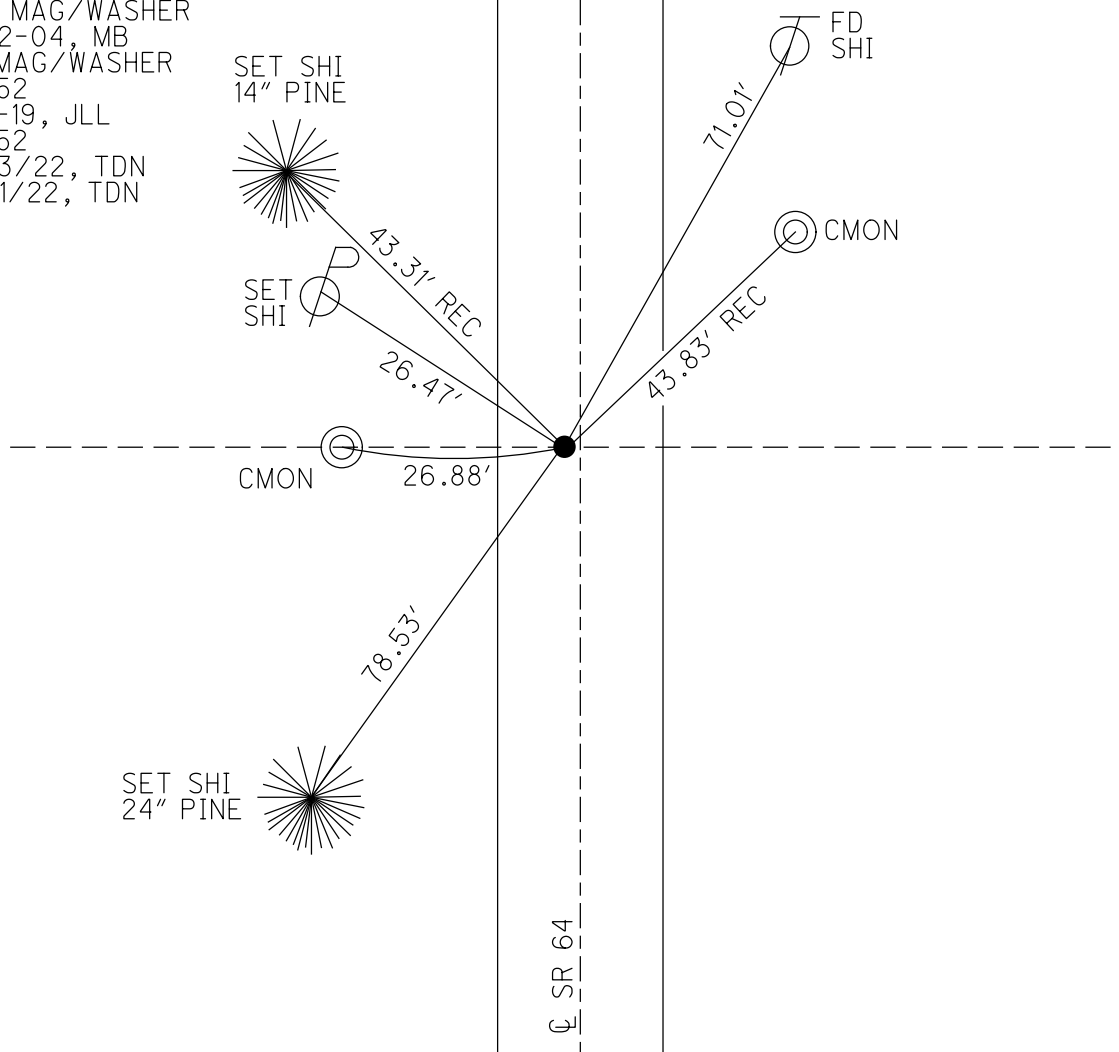

O.D.O.T. DISTRICT 2 SURVEY OFFICE (USE ONLY)

PERSONNEL

REFERENCE NO. 52

SHEET 51 OF 56

NOTES AUBLE

DATE 5/7/20

ROUTE SR 64

H.C. LEU

WEATHER WINDY

COUNTY LUCAS

R.C. BALBAUGH

TEMP. 66°

TOWNSHIP SWANTON

DWG BY GARRETT

PID 107059

SECTION 19

T 7 N R 9 E

TYPE MONUMENT MAG/WASHER

ON SURFACE - ~~BELOW~~ ON

OFFSET CL PAVEMENT 1.5' LT : ~~RT~~

8.8' TO LT EDGE PAVEMENT


STATION: 550+06.39

HORIZ.DATUM: NAD83 (2011)


GEOID: 2012A

GRID: NORTHING: 690094.953

EASTING: 159264.632

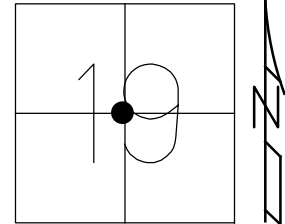

RECORD:
SET MAG/WASHER
10-12-04, MB
FD MAG/WASHER
REF52
3-6-19, JLL

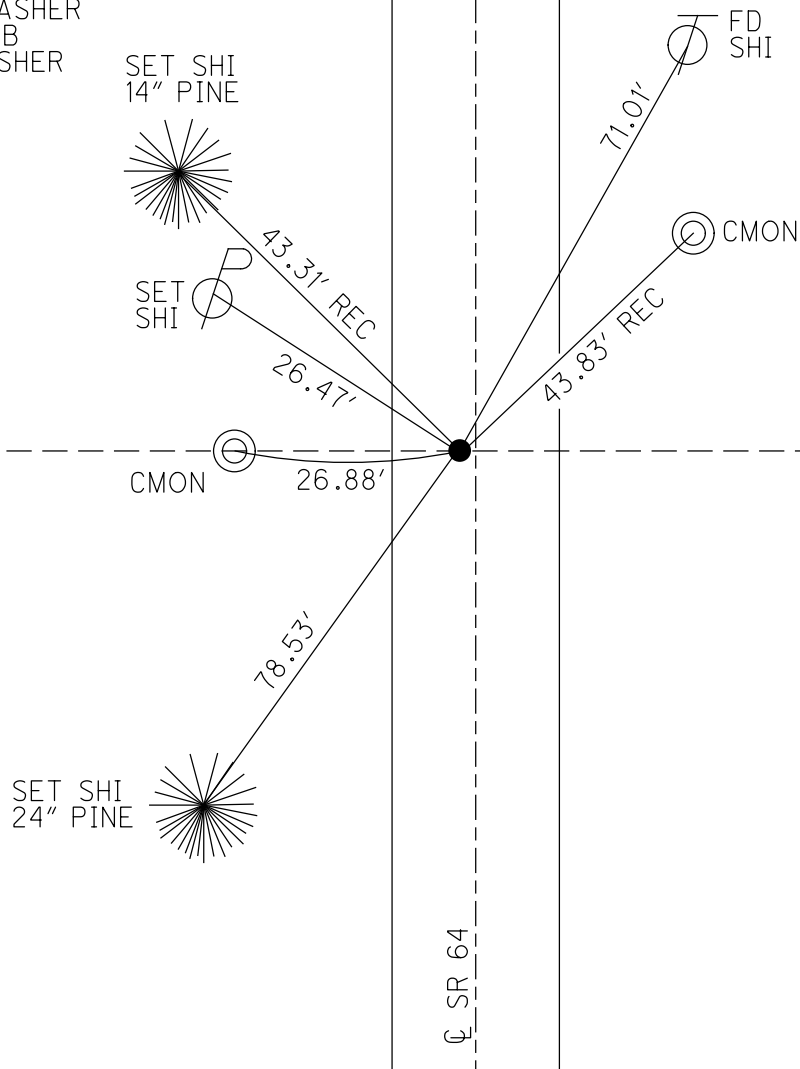

O.D.O.T. DISTRICT 2 SURVEY OFFICE

PERSONNEL

REFERENCE NO. 52

SHEET 5 OF 10

NOTES HUSS

DATE 6-16-04

ROUTE SR 64

H.C. HOMAN

WEATHER CLOUDY

COUNTY LUCAS

R.C. HUSS

TEMP. 78°

TOWNSHIP SWANTON

SECTION 19

T 7 N R 9 E


TYPE MONUMENT PK NAIL & WASHER

ON SURFACE - ~~BELOW~~ YES


LEFT - ~~C PAVT~~ - ~~RIGHT~~ 1.5' LT

8.8 TO LT EDGE PAVEMENT

S.L.M. 550+70

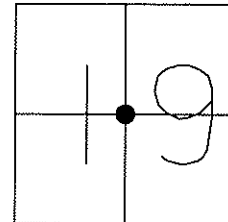

CTR SEC 19

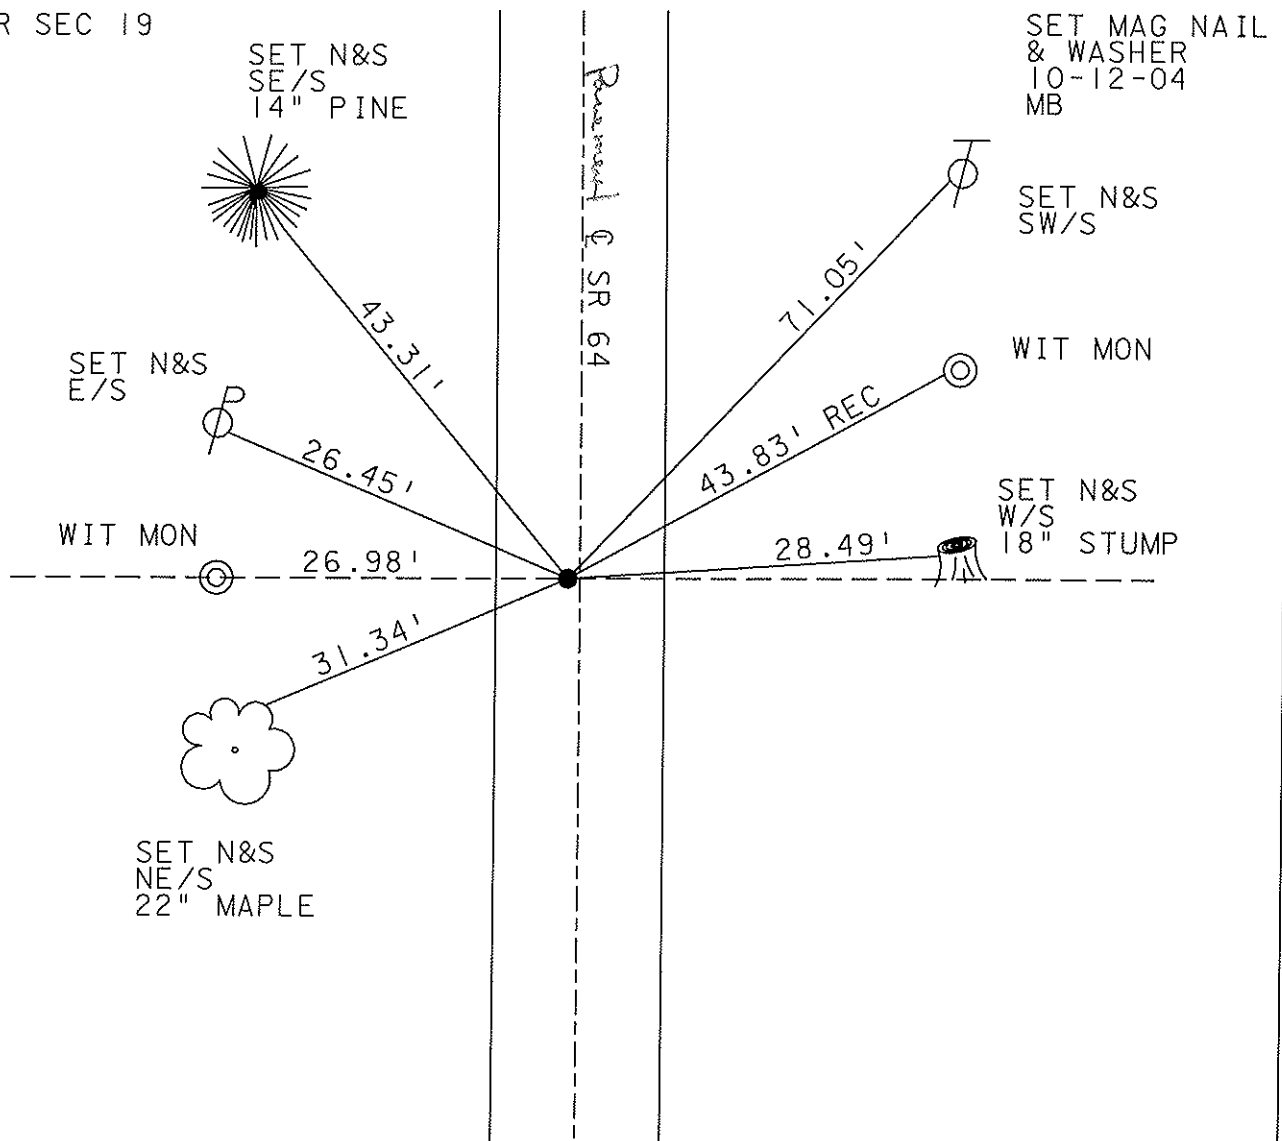

O.D.O.T. DISTRICT 2 SURVEY OFFICE

PERSONNEL

REFERENCE NO. 52

SHEET 5 OF 9

NOTES D. CURTIS

H.C. J. HOUSEHOLDER

R.C. _____

DATE 9-25-86

WEATHER CLOUDY

TEMP. 70°

ROUTE 64

COUNTY LUCAS

TOWNSHIP SWANTON

SECTION _____

T _____ R _____


TYPE MONUMENT P.K. NAIL

ON SURFACE - BELOW ON SURFACE

LEFT - & PAV'T. - RIGHT 1'-LT' & PAVM'T


_____ TO _____ EDGE PAVEMENT

S.L.M. 550 + 70

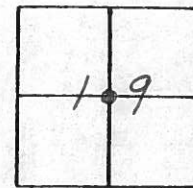


CTR. SEC. 19

Set PK Nail 7/8/88 IRS

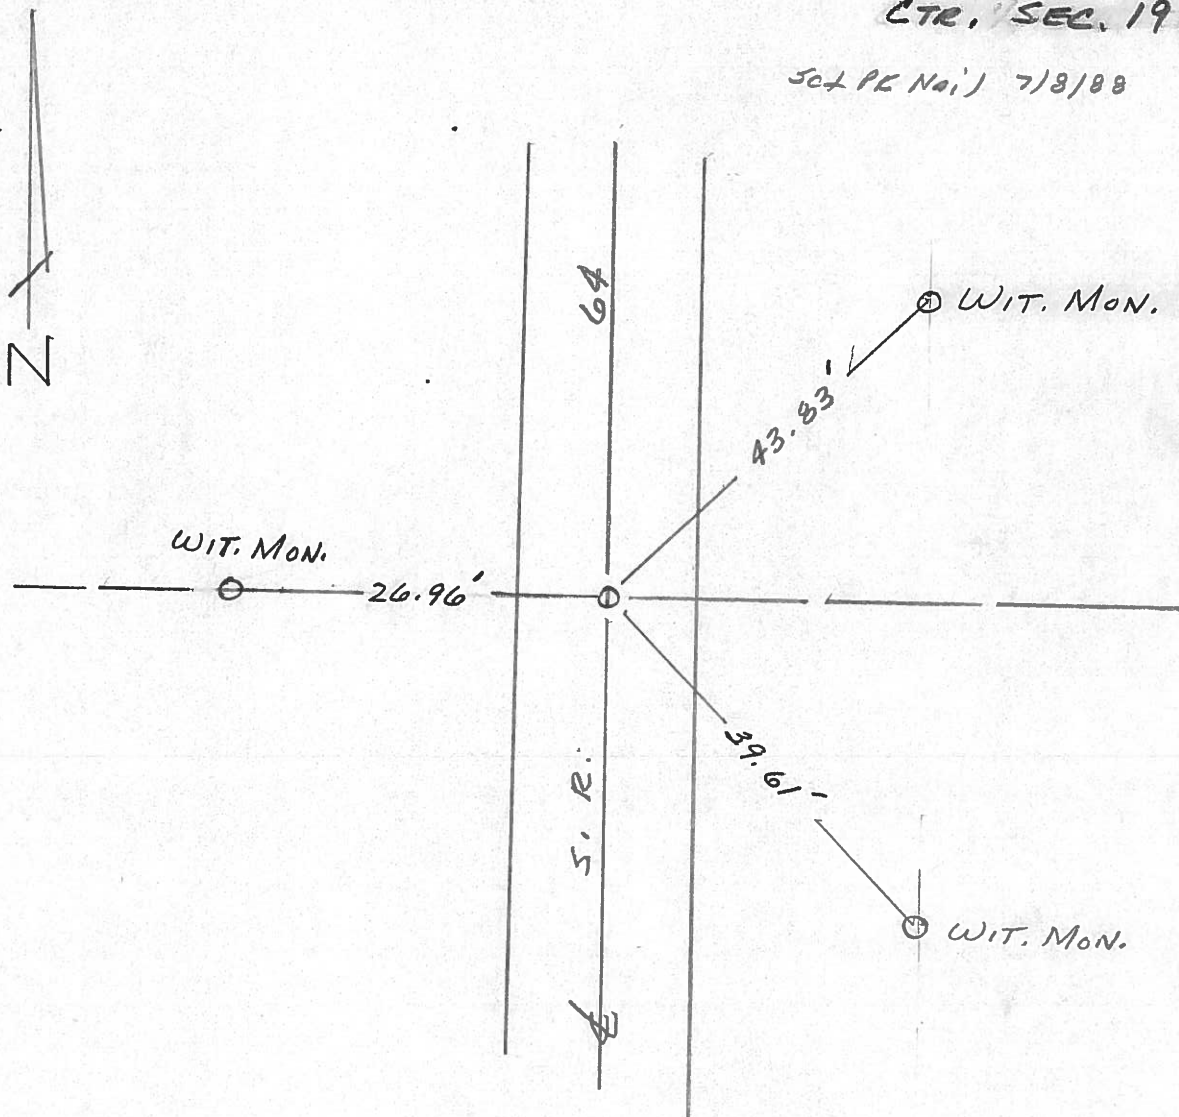

PERSONNEL	TITLE	PERSONNEL	TITLE	COUNTY	DATE	WEATHER	TEMP.
Stone				Lucas	21 March 7	Cold	32°
E				S. R. 64			
Crew				SEC.			

DESCRIPTION References to Control Points JOB NO.

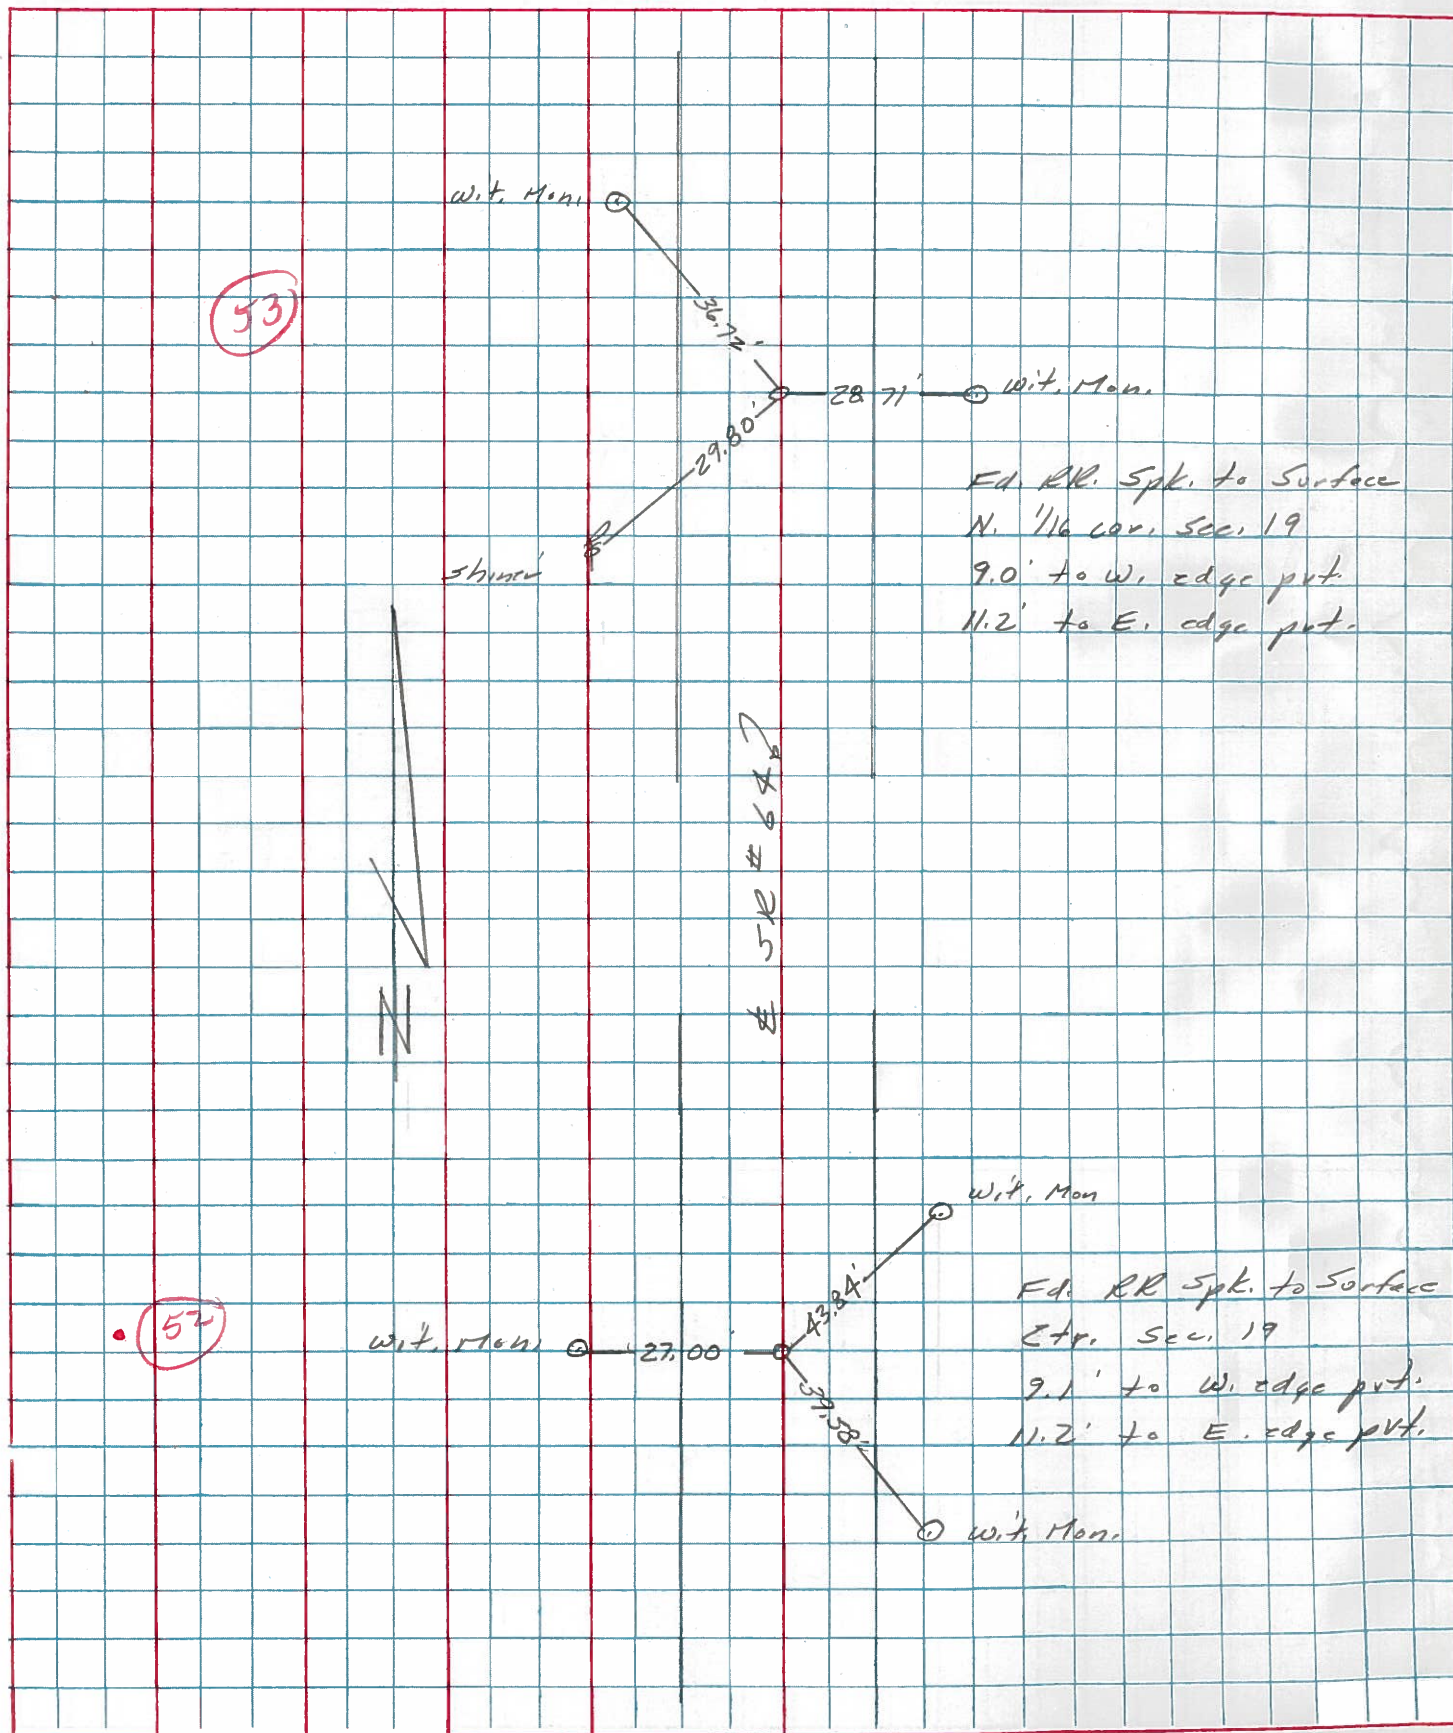

PERSONNEL TITLE PERSONNEL TITLE

COUNTY Lucas DATE Aug. 19, 1960

S. R. Co4 WEATHER warm

SEC. TEMP. 85°±

DESCRIPTION S.R. Co4 - Ref. Mon. & Control Points

JOB NO. 02994(0)

