

O.D.O.T. DISTRICT 2 SURVEY OFFICE (USE ONLY)

PERSONNEL

REFERENCE NO. 53

SHEET 52 OF 56

NOTES PRESTON-COLVIN

DATE 10-2-24

ROUTE SR 64

H.C.

WEATHER SUNNY

COUNTY LUCAS

R.C.

TEMP. 70°

TOWNSHIP SWANTON

NIESE

SECTION 19

DWG BY PRESTON-COLVIN PID PAVING TRAIN

T 7 N R 9 E

TYPE MONUMENT MAG/WASHER

ON SURFACE - BELOW ON

OFFSET $\varnothing$ PAVEMENT 1.0' LT : RT

8.9' TO LT EDGE PAVEMENT

STATION: 569+90.12

HORIZ.DATUM: NAD83 (2011)


GEOID: NAVD88 2018

GRID: NORTHING: 692078.244


EASTING: 1592686.588

LDP: NORTHING: 312906.9073

EASTING: 102947.8001

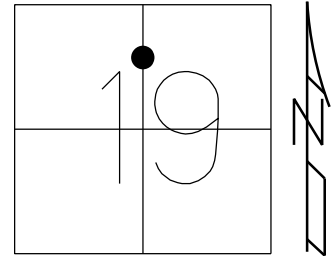


RECORD:
SET MAG/WASHER
10-12-04, MB
FD MAG/WASHER
REF53
3-6-19, JLL
REF53
8/23/22, TDN
11/21/22, TDN
FD MAG/WASHER
REF53
2/6/23, JAM
5/9/23, TDN
2/27/24, JMR
FD MAG/WASHER
10-2-24, TDN

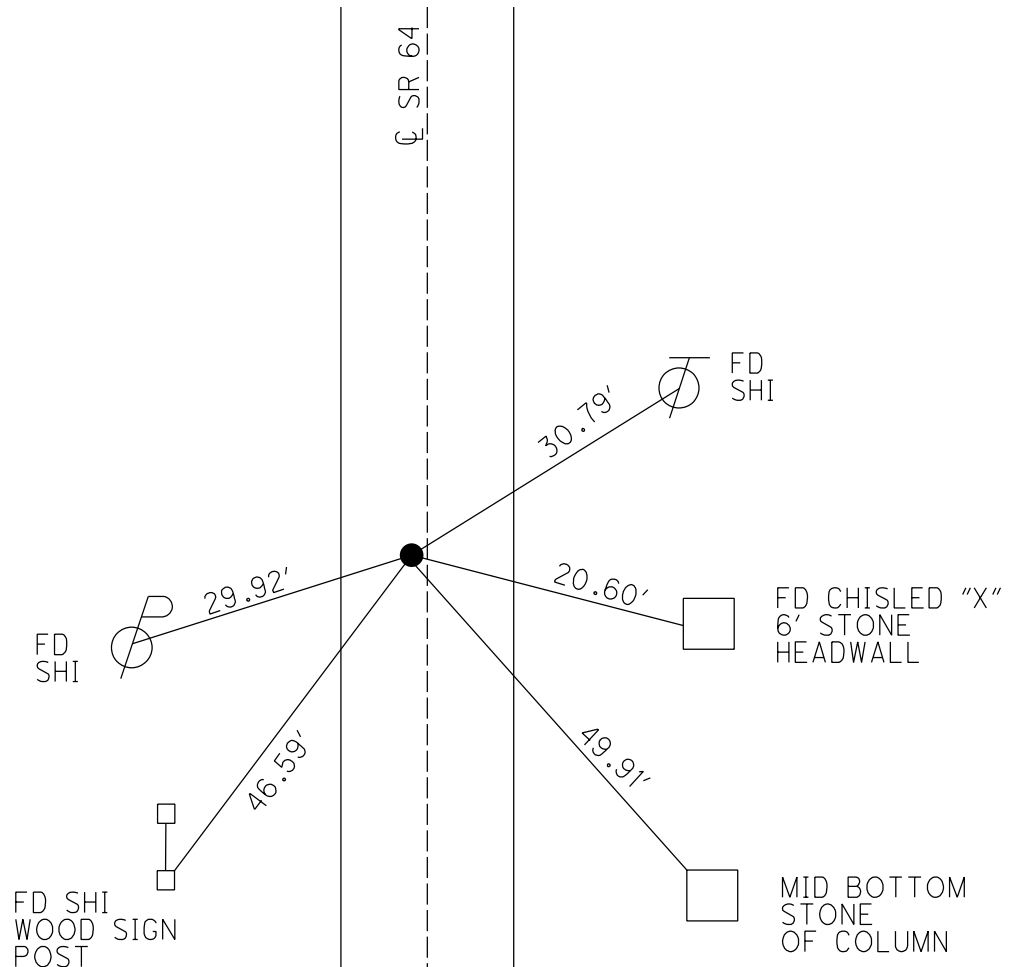

O.D.O.T. DISTRICT 2 SURVEY OFFICE (USE ONLY)


PERSONNEL	REFERENCE NO. <u>53</u>	SHEET <u>52</u> OF <u>56</u>
NOTES <u>NIESE</u>	DATE <u>5/9/23</u>	ROUTE <u>SR 64</u>
H.C. <u>AUBLE</u>	WEATHER <u>SUNNY</u>	COUNTY <u>LUCAS</u>
R.C. <u>ASTON</u>	TEMP. <u>60°</u>	TOWNSHIP <u>SWANTON</u>
		SECTION <u>19</u>
DWG BY <u>RHOADES</u>	PID <u>PAVING TRAIN</u>	T <u>7</u> N R <u>9</u> E

TYPE MONUMENT MAG/WASHER
ON SURFACE - ~~BELOW~~ ON
OFFSET Q PAVEMENT 1.0' LT : ~~RT~~
8.9 TO LT EDGE PAVEMENT
STATION: 569+90.12

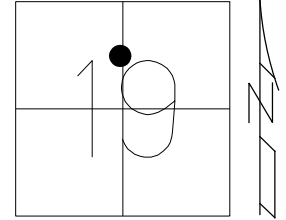

HORZ.DATUM: NAD83 (2011) GEOID: NAVD88 2018
GRID: NORTHING: 692078.244 EASTING: 1592686.588

RECORD:
SET MAG/WASHER
10-12-04, MB
FD MAG/WASHER
REF53
3-6-19, JLL
REF53
8/23/22, TDN
11/21/22, TDN
FD MAG/WASHER
REF53
2/6/23, JAM
5/9/23, TDN
2/27/24, JMR

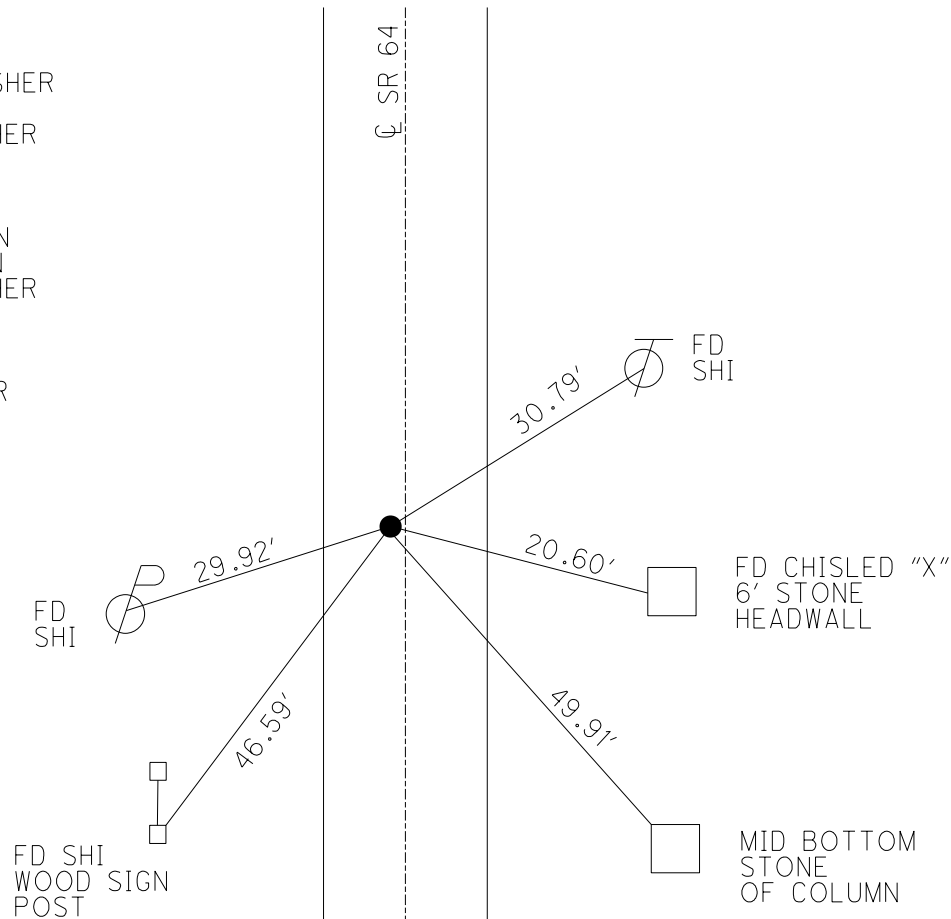

O.D.O.T. DISTRICT 2 SURVEY OFFICE (USE ONLY)

PERSONNEL

REFERENCE NO. 53

SHEET 52 OF 56

NOTES BALBAUGH

DATE 5/11/20

ROUTE SR 64

H.C. LEU

WEATHER CLOUDY

COUNTY LUCAS

R.C. AUBLE

TEMP. 39°

TOWNSHIP SWANTON

DWG BY GARRETT

PID 107059

SECTION 19

T 7 N R 9 E

TYPE MONUMENT MAG/WASHER

ON SURFACE - ~~BELOW~~ ON

OFFSET Q PAVEMENT 1.0' LT : ~~RT~~

8.9 TO LT EDGE PAVEMENT


STATION: 569+90.12

HORZ.DATUM: NAD83 (2011)


GEOID: 2012A

GRID: NORTHING: 692078.244

EASTING: 1592686.588

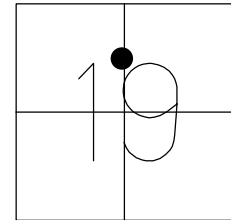

RECORD:
SET MAG/WASHER
10-12-04, MB
FD MAG/WASHER
REF53
3-6-19, JLL
REF53
8/23/22, TDN
11/21/22, TDN

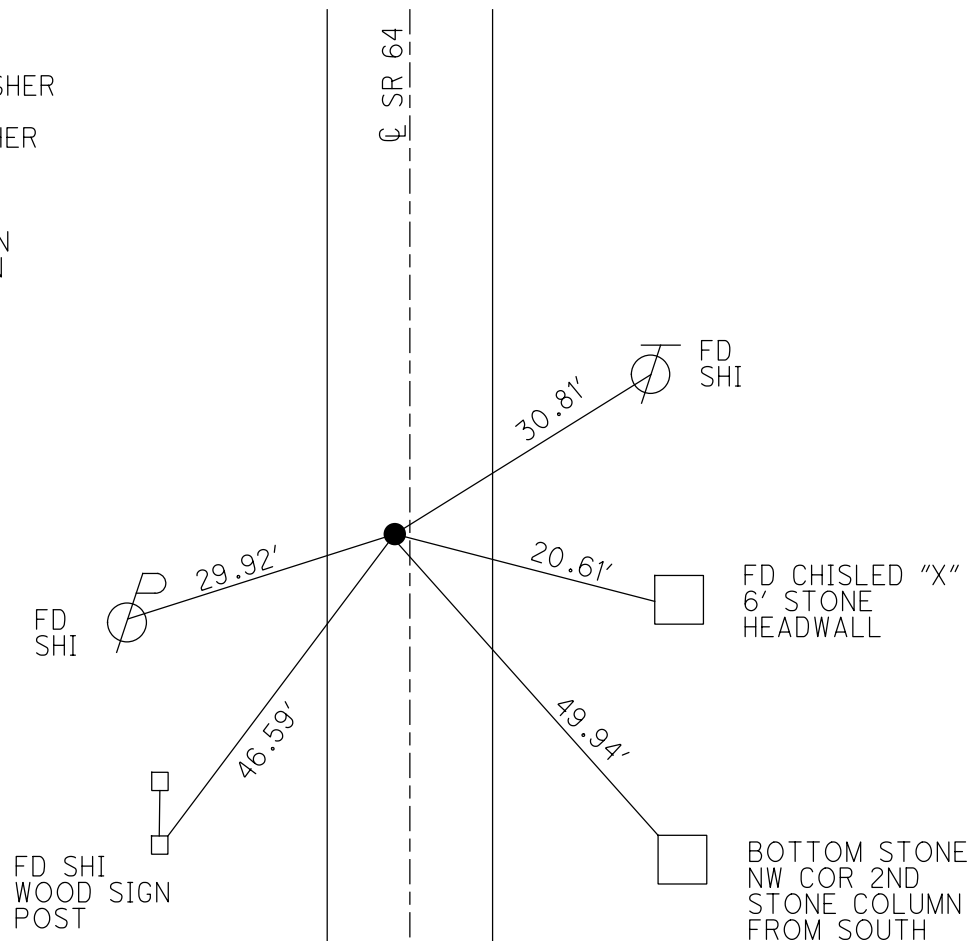

O.D.O.T. DISTRICT 2 SURVEY OFFICE (USE ONLY)

PERSONNEL

REFERENCE NO. 53

SHEET 52 OF 56

NOTES BALBAUGH

DATE 5/11/20

ROUTE SR 64

H.C. LEU

WEATHER CLOUDY

COUNTY LUCAS

R.C. AUBLE

TEMP. 39°

TOWNSHIP SWANTON

SECTION 19

DWG BY GARRETT

PID 107059

T 7 N R 9 E

TYPE MONUMENT MAG/WASHER

ON SURFACE - ~~BELOW~~ ON

OFFSET Q PAVEMENT 1.0' LT : ~~RT~~

8.9 TO LT EDGE PAVEMENT


STATION: 569+90.12

HORIZ.DATUM: NAD83 (2011)


GEOID: 2012A

GRID: NORTHING: 692078.244

EASTING: 1592686.588

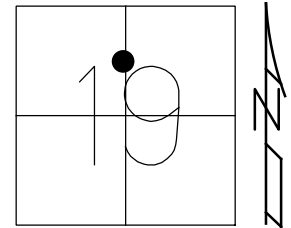

RECORD:
SET MAG/WASHER
10-12-04, MB
FD MAG/WASHER
REF53
3-6-19, JLL

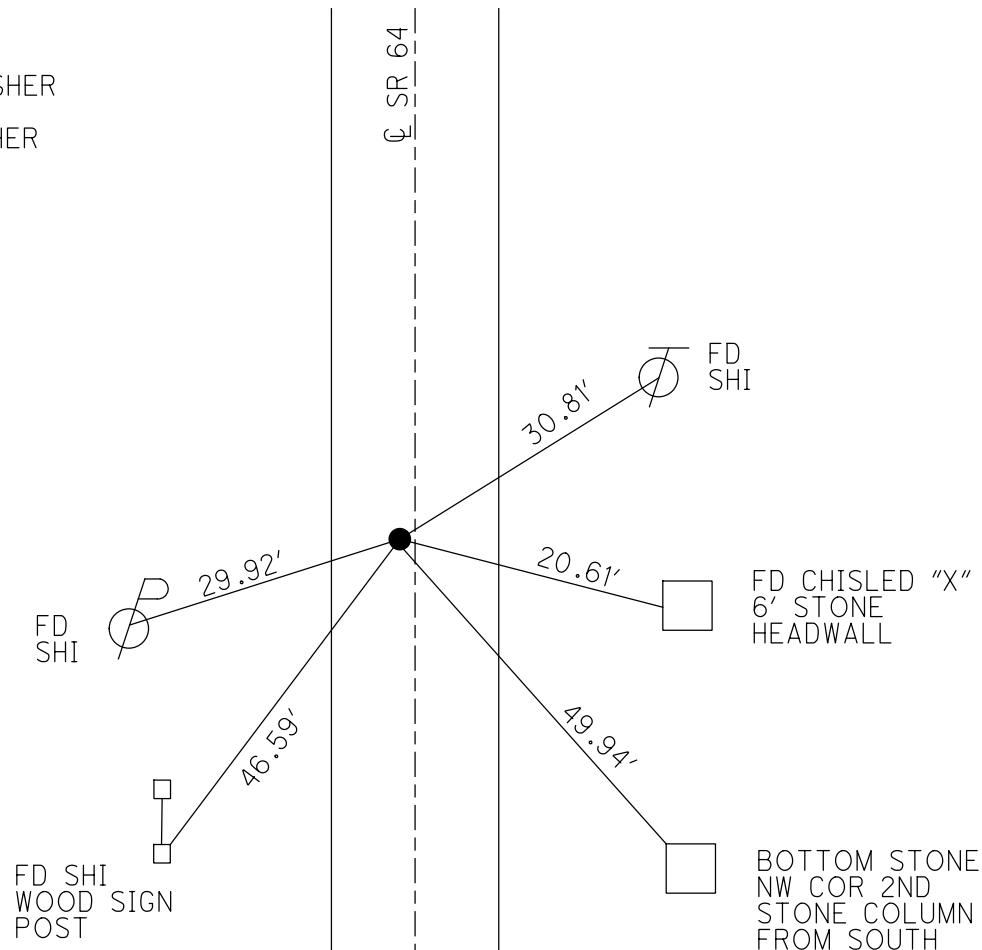

O.D.O.T. DISTRICT 2 SURVEY OFFICE

PERSONNEL

REFERENCE NO. 53

SHEET 6 OF 10

NOTES HUSS

DATE 6-16-04

ROUTE SR 64

H.C. HOMAN

WEATHER CLOUDY

COUNTY LUCAS

R.C. HUSS

TEMP. 78°

TOWNSHIP SWANTON

SECTION 19

T 7 N R 9 E



TYPE MONUMENT SM RR SPIKE

ON SURFACE - ~~BELOW~~ YES


LEFT - ~~C PAVT - RIGHT~~ 1.0' LT

8.9 TO LT EDGE PAVEMENT

S.L.M. 570+55

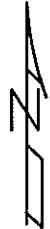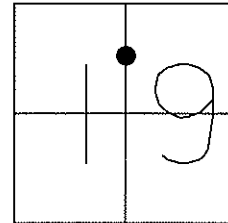

N $\frac{1}{16}$ COR SEC 19

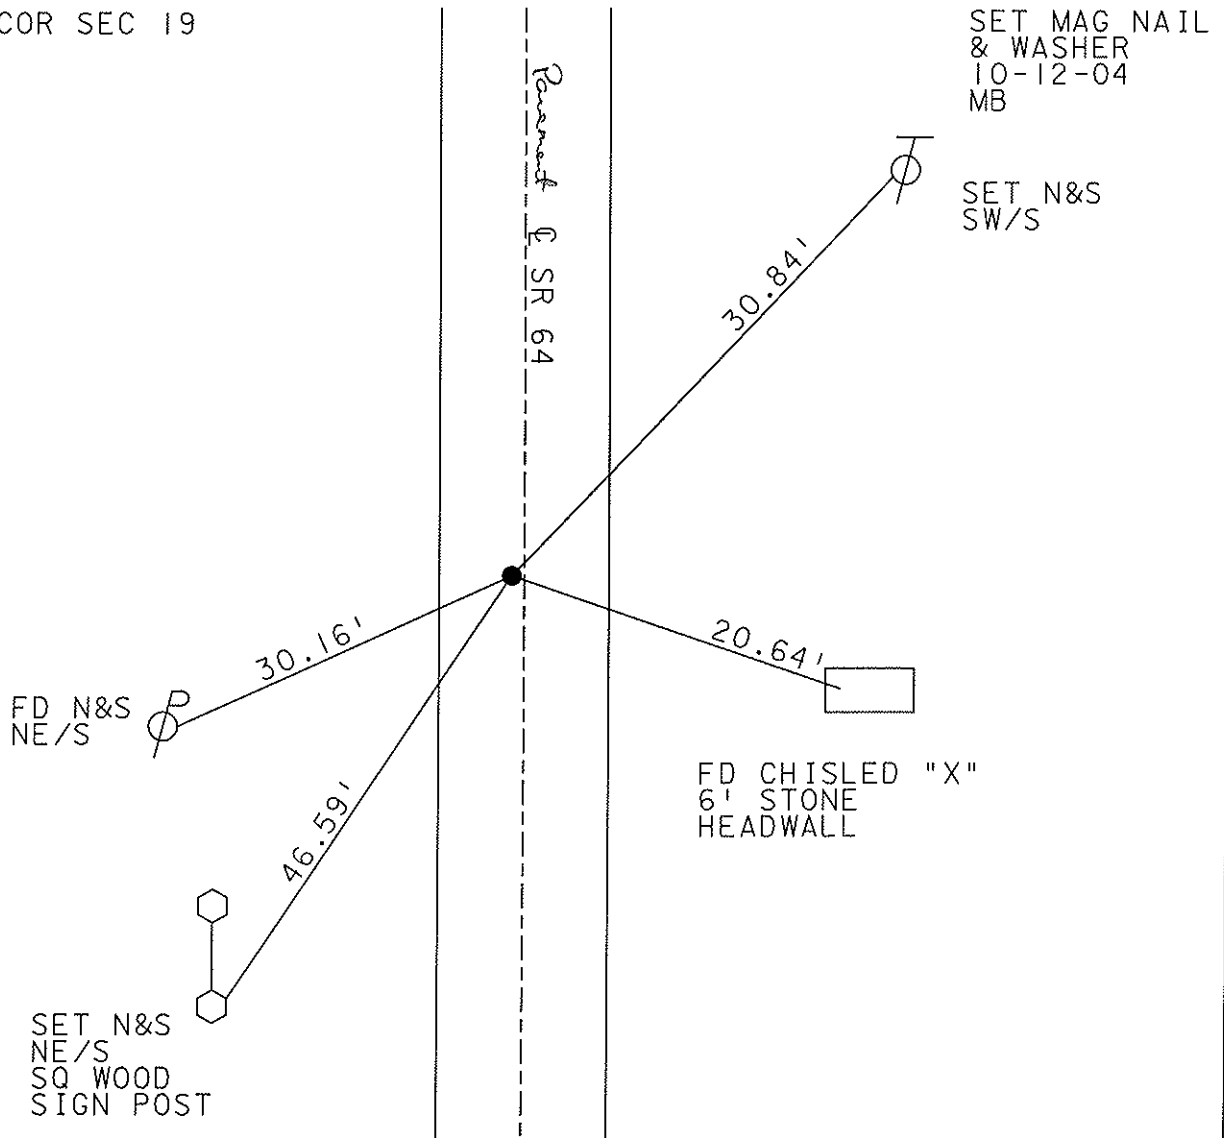

O.D.O.T. DISTRICT 2 SURVEY OFFICE

PERSONNEL

REFERENCE NO. 53

SHEET 6 OF 9

NOTES J. Householder

H.C. D. Curtis

DATE Sept. 25, 1986

ROUTE S.R. 64

R.C. _____

WEATHER Cloudy

COUNTY Lucas

TEMP. ± 72°

TOWNSHIP Swanton

SECTION 19

T _____ R _____


TYPE MONUMENT R.R. Spike

ON SURFACE - BELOW on surface


LEFT - CL PAV'T. - RIGHT 1' Left

TO EDGE PAVEMENT

S.L.M. 570 + 55

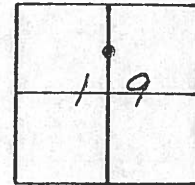

N. 1/16 Corner Sec. 19
Set Small RR Spk 7/8/88 IRS

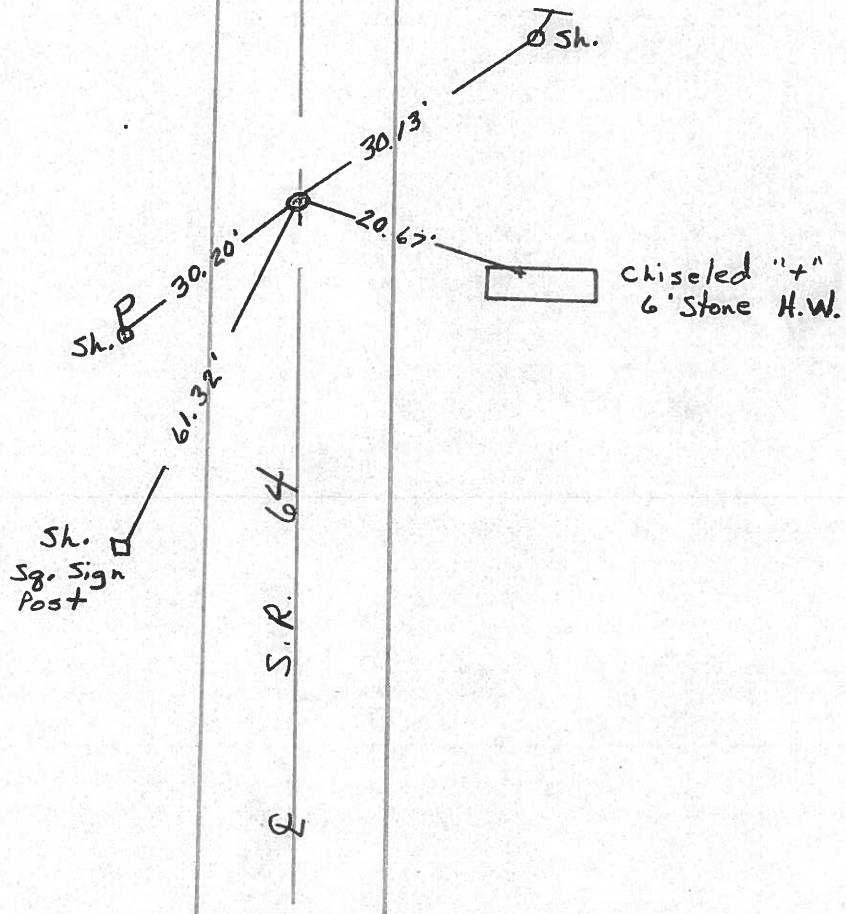

PERSONNEL	TITLE	PERSONNEL	TITLE
Stone			
E			
Crew			


COUNTY Lucas DATE 21 March

S. R. 64 WEATHER Cold

SEC. _____ TEMP. 32°

DESCRIPTION References to Control Points JOB NO. _____


LEFT CENTER LINE RIGHT

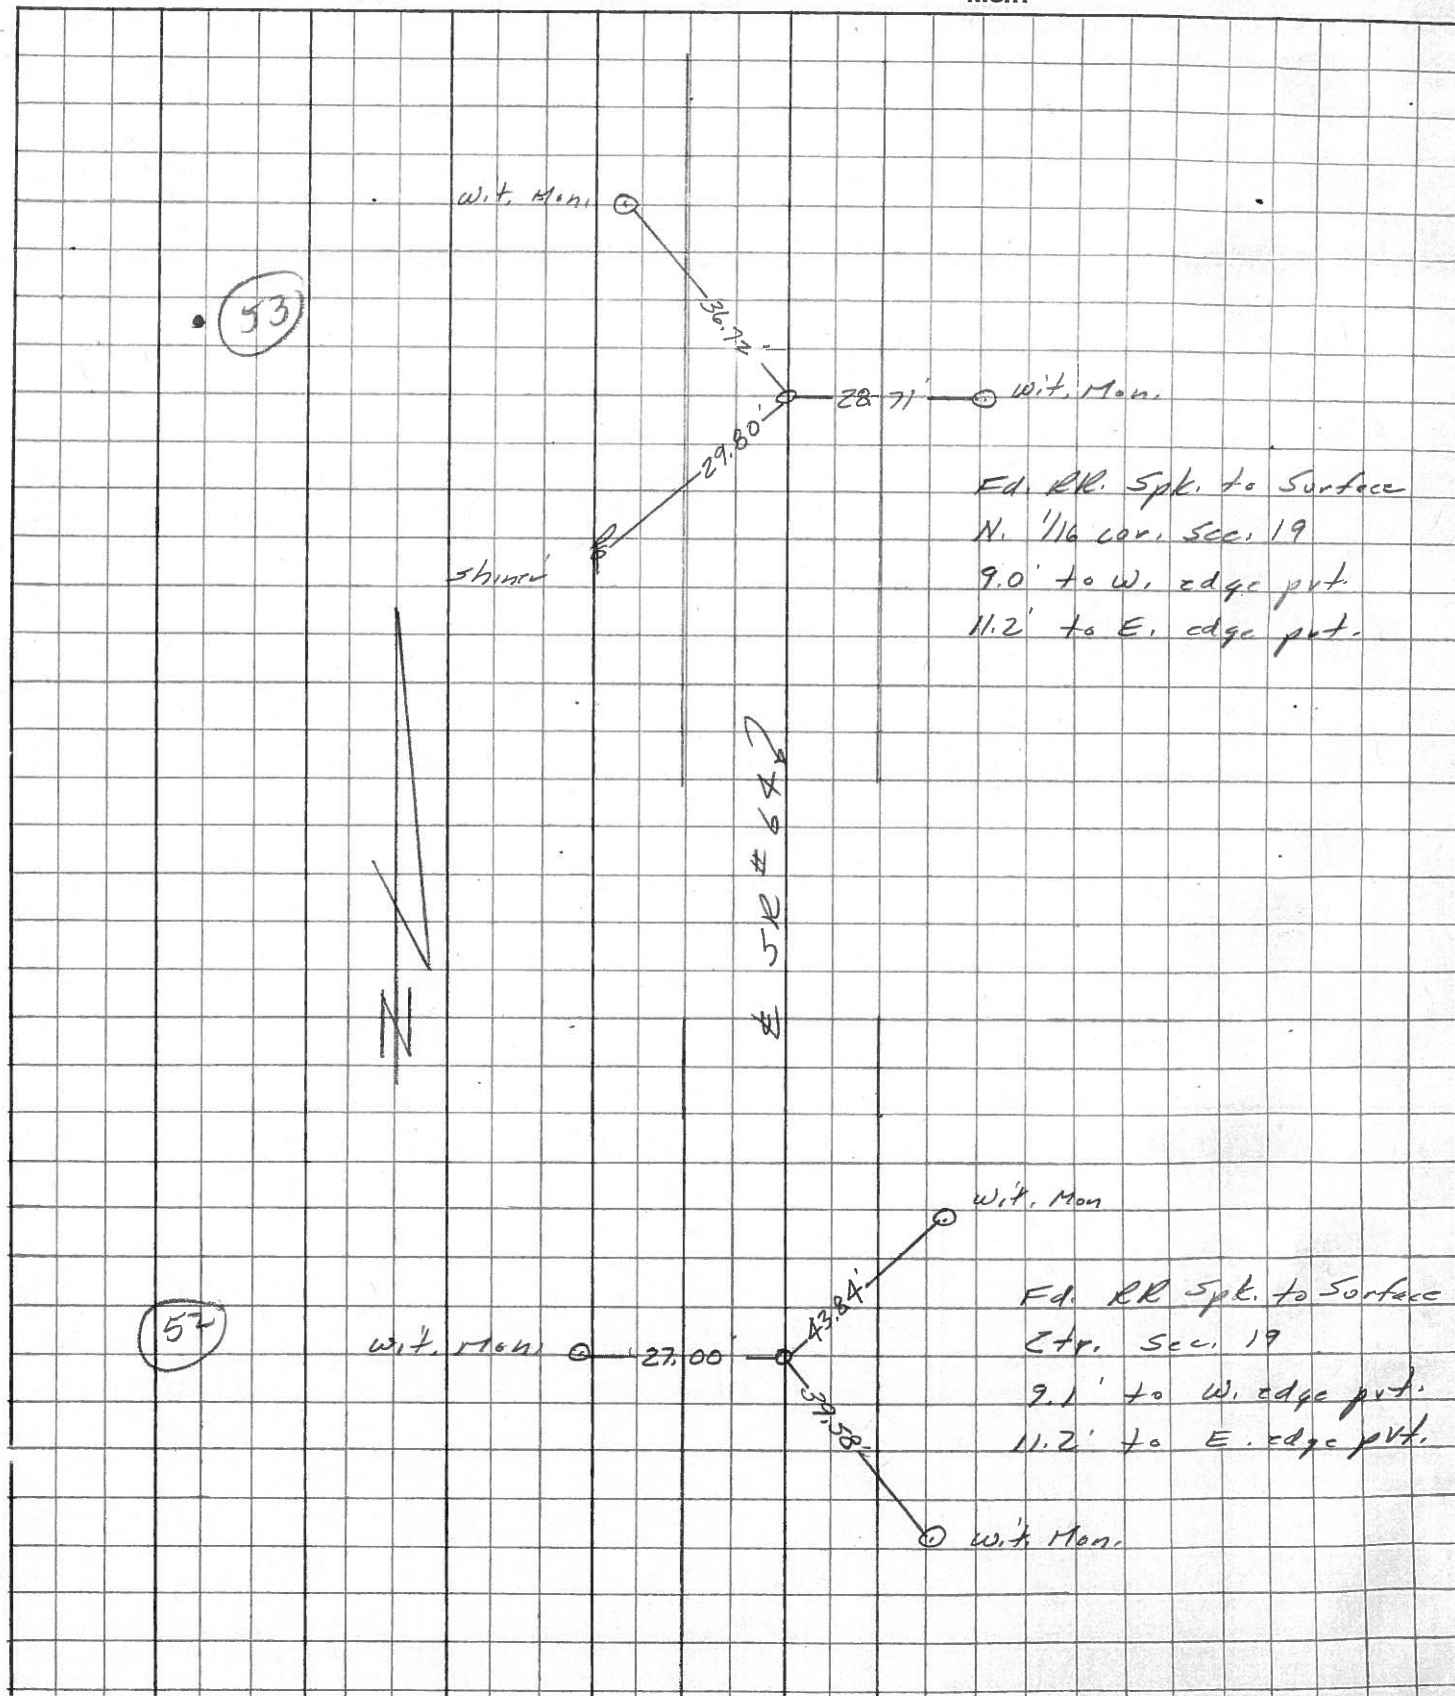

PERSONNEL TITLE PERSONNEL TITLE
 W. Denna _____
 D. Curtis _____
 J. Teal _____
 J. Brindley _____

COUNTY Lucas DATE Aug. 20, 1964
 S. R. Co4 WEATHER warm
 SEC. _____ TEMP. 85° ±

DESCRIPTION S.R. Co4 - Ref. Mon. & Control Points JOB NO. 02994 (C)

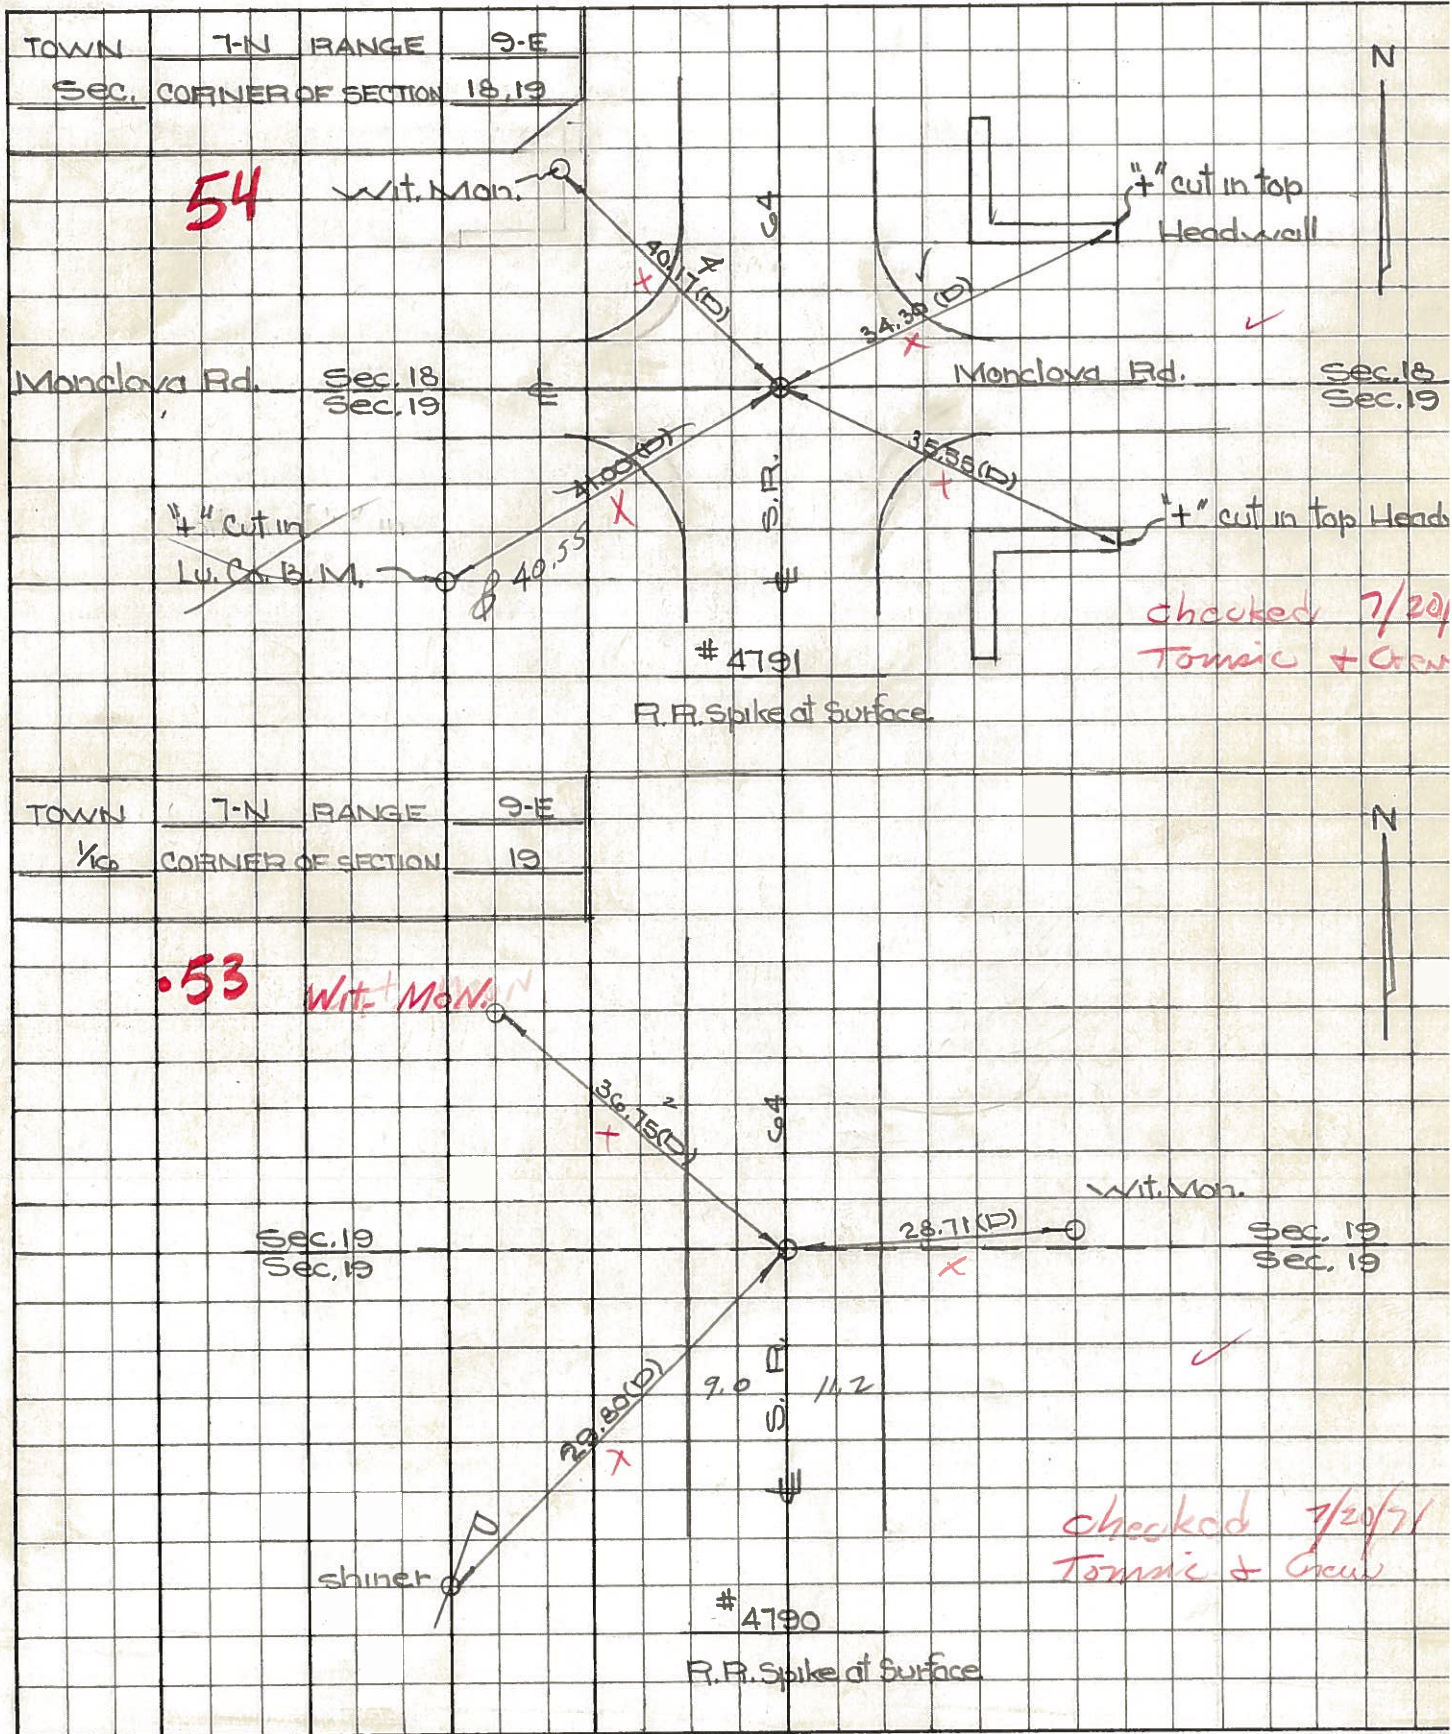

PERSONNEL	TITLE	PERSONNEL	TITLE	COUNTY	DATE	WEATHER	TEMP.
Slone				Lucas	4 Mar. 66	Windy	78°
Reck				S. R. #64			
Brindley							
Schroeder				SEC. N. From Sunshine Cons.			

DESCRIPTION	LEFT	CENTER LINE	RIGHT	JOB NO.
-------------	------	-------------	-------	---------

.50				
#199	N Line Sec. 30		13.41'	E. To "+" on S.E. Cor. Bridge Wall
	Fd. R.R. Spk.		13.82'	W. To "+" on S.W. Cor. Bridge Wall
	To Surface		21.32'	N.E. To "+" on N.E. Cor. Bridge Wall
			21.51'	N.W. To "+" on N.W. Cor. Bridge Wall
51				
#198	Int. Reel Rd.	44.02	22.78	S.W. To Cor. W. T. Mon. (D)
	Fd. R.R. Spk.	40.91	36.52	S.E. To Cor. W. T. Mon. (D)
	To Surface	38.22	28.25	N.E. To Holcom Lu. Co. R.M. (D)
			34.25	N.W. To Shiner in T.P. (D)
		36.08		N.W. "+" Cut in top Headwall
52				
#197	E & W. Sec. 19		27.46'	W. To Cor. W. T. Mon. (D)
	Fd. R.R. Spk.		43.98'	N.E. To Cor. W. T. Mon. (D)
	To Surface		39.48'	S.E. To Cor. W. T. Mon. (D)
			34.77	W.S.W. To Shiner in 8" Tree (D)
53				
#196	Between Wabash R.R. & Monclova Rd.	29.80	29.81'	W. S.W. To Shiner in T.P. (D)
	Fd. R.R. Spk.	28.71	29.07	N.E. To Shiner in T.P. (D)
	To Surface	36.75	28.69	E. To Cor. W. T. Mon. (D)
			37.05	N.W. To Cor. W. T. Mon. (D)
54				
#195	Int. Monclova Rd.		35.56'	S.E. To "+" on Cor. Head Wall (D)
	Fd. R.R. Spk.		39.30' OK	N.E. To "+" on Cor. Head Wall (D)
	To Surface		34.07	S.W. To Bottom of "V" in 2" Lumber (D)
			38.65	N.W. To "+" on Cor. Head Wall (D)
#194	Between Monclova Rd. & E & W. Sec. 18			
	Could Not Find			