

O.D.O.T. DISTRICT 2 SURVEY OFFICE (USE ONLY)

PERSONNEL

REFERENCE NO. 54

SHEET 53 OF 56

NOTES PRESTON-COLVIN

DATE 10-2-24

ROUTE SR 64

H.C.

WEATHER SUNNY

COUNTY LUCAS

R.C.

TEMP. 70°

TOWNSHIP SWANTON

NIESE

SECTION 19

DWG BY PRESTON-COLVIN

PID PAVING TRAIN

T 7 N R 5 E

TYPE MONUMENT SHANK

ON SURFACE - BELOW ON

OFFSET $\mathcal{C}$ PAVEMENT 0.9' ~~LT~~ : RT

- TO - EDGE PAVEMENT

STATION: 576+52.27

HORIZ.DATUM: NAD83 (2011)


GEOID: NAVD88 2018

GRID: NORTHING: 692740.240


EASTING: 1592700.807

LDP: NORTHING: 313569.0662

EASTING: 102953.3079

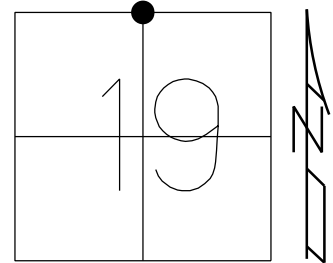

RECORD:
SET MAG/WASHER
10-12-04, MB
FD MAG/WASHER
REF54
3-6-19, JLL
FD MAG SHANK
REF54
8/23/22, TDN
11/21/22, TDN
FD MAG SHANK
REF54
2/6/23, JAM
5/9/23, TDN
2/27/24, JMR
FD SHANK
10-2-24, TDN

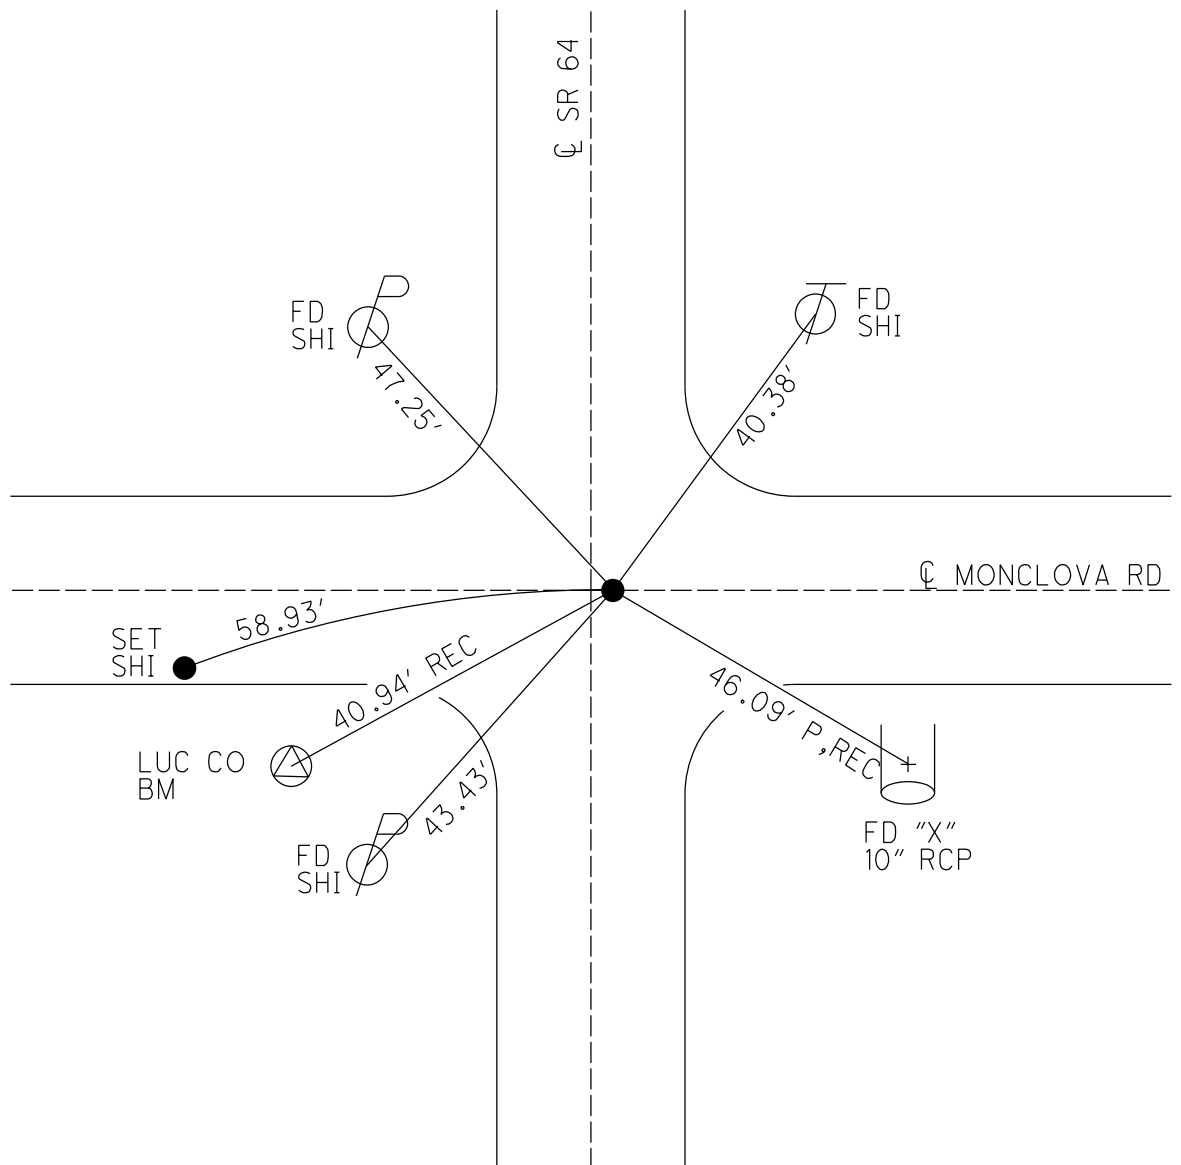

O.D.O.T. DISTRICT 2 SURVEY OFFICE (USE ONLY)

PERSONNEL

REFERENCE NO. 54

SHEET 53 OF 56

NOTES NIESE

DATE 5/9/23

ROUTE SR 64

H.C. AUBLE

WEATHER SUNNY

COUNTY LUCAS

R.C. ASTON

TEMP. 60°

TOWNSHIP SWANTON

DWG BY RHOADES

PID PAVING TRAIN

SECTION 19

T 7 N R 5 E

TYPE MONUMENT MAG/WASHER

ON SURFACE - ~~BELOW~~ ON

OFFSET $\odot$ PAVEMENT 0.9' ~~LT~~ : RT

- TO - EDGE PAVEMENT


STATION: 576+52.27

HORZ.DATUM: NAD83 (2011)


GEOID: NAVD88 2018

GRID: NORTHING: 692740.240

EASTING: 1592700.807

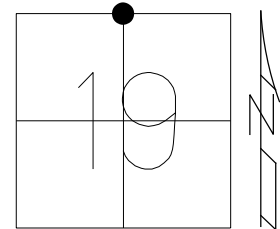

RECORD:
SET MAG/WASHER
10-12-04, MB
FD MAG/WASHER
REF54
3-6-19, JLL
FD MAG SHANK
REF54
8/23/22, TDN
11/21/22, TDN
FD MAG SHANK
REF54
2/6/23, JAM
5/9/23, TDN
2/27/24, JMR

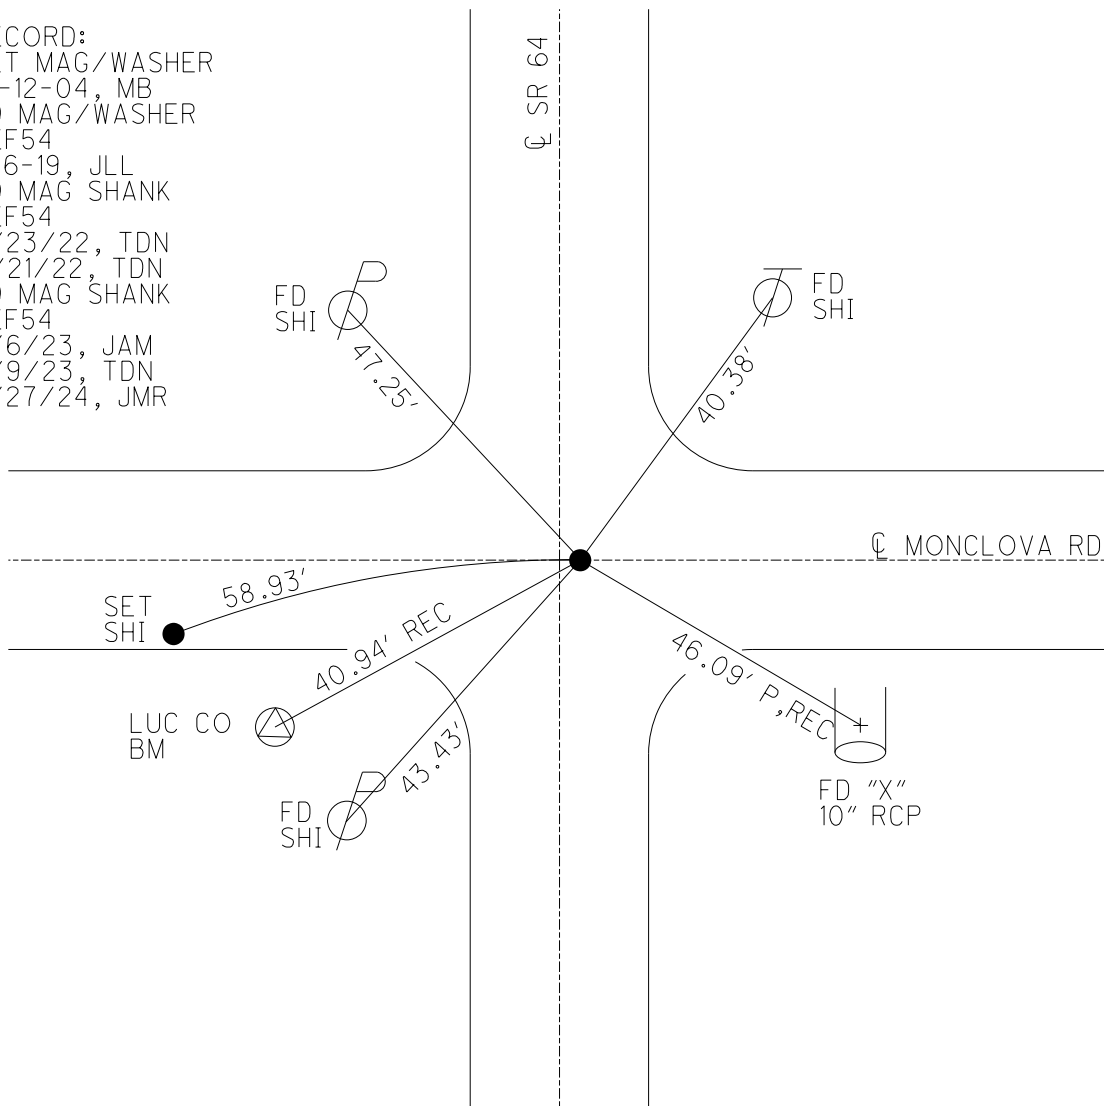

O.D.O.T. DISTRICT 2 SURVEY OFFICE (USE ONLY)

PERSONNEL

REFERENCE NO. 54

SHEET 53 OF 56

NOTES BALBAUGH

DATE 5/11/20

ROUTE SR 64

H.C. LEU

WEATHER CLOUDY

COUNTY LUCAS

R.C. AUBLE

TEMP. 39°

TOWNSHIP SWANTON

SECTION 19

DWG BY GARRETT

PID 107059

T 7 N R 5 E

TYPE MONUMENT MAG/WASHER

ON SURFACE - ~~BELOW~~ ON

OFFSET CL PAVEMENT 0.9' ~~LT~~ : RT

- TO - EDGE PAVEMENT


STATION: 576+52.27

HORZ.DATUM: NAD83 (2011)


GEOID: 2012A

GRID: NORTHING: 692740.240

EASTING: 1592700.807

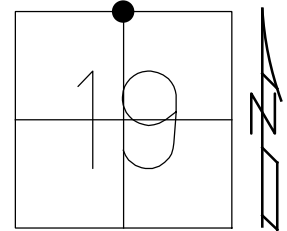

RECORD:
SET MAG/WASHER
10-12-04, MB
FD MAG/WASHER
REF54
3-6-19, JLL
FD MAG SHANK
REF54
8/23/22, TDN
11/21/22, TDN

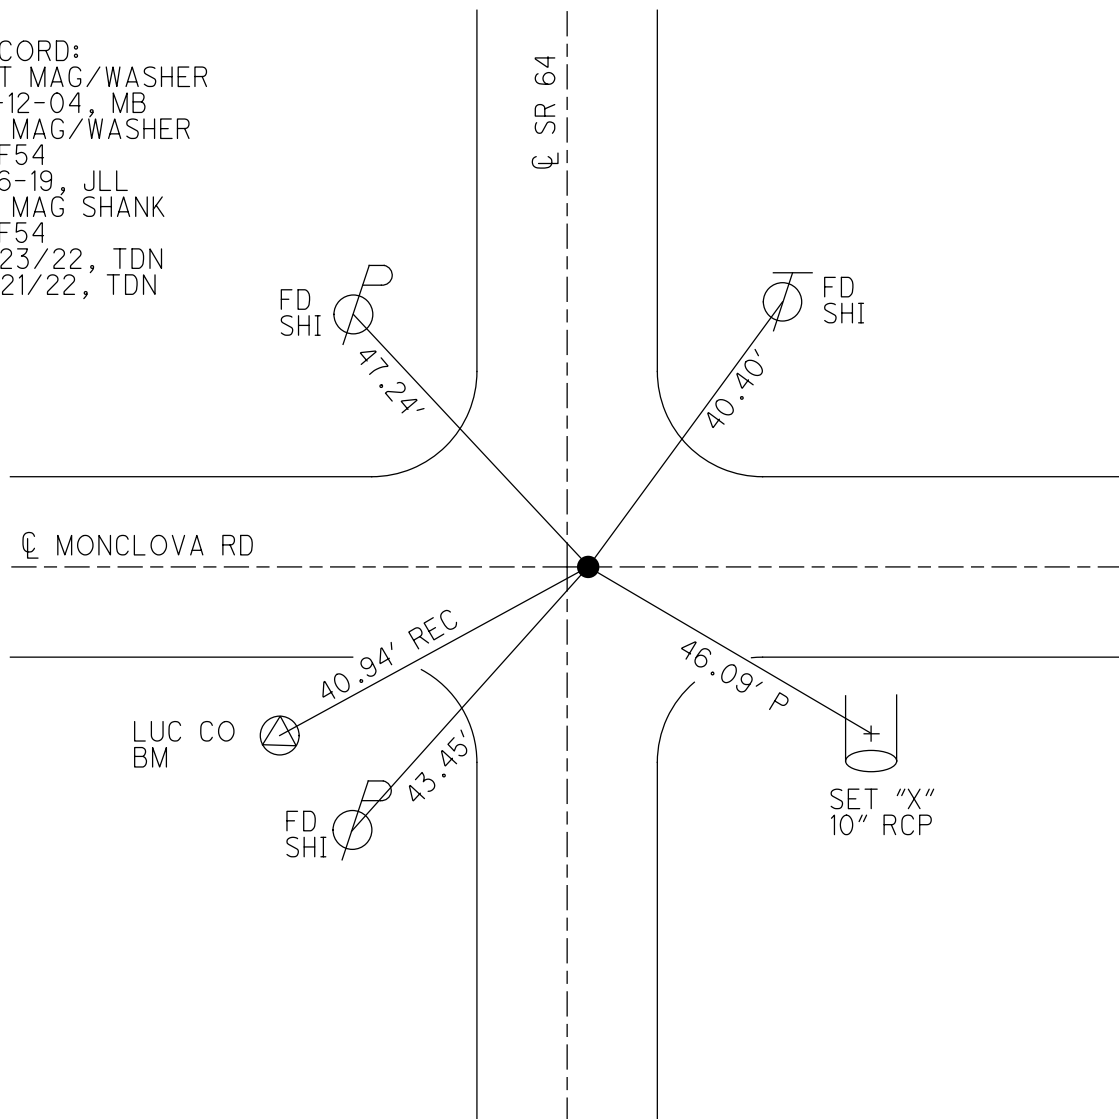

O.D.O.T. DISTRICT 2 SURVEY OFFICE (USE ONLY)

PERSONNEL

REFERENCE NO. 54

SHEET 53 OF 56

NOTES BALBAUGH

DATE 5/11/20

ROUTE SR 64

H.C. LEU

WEATHER CLOUDY

COUNTY LUCAS

R.C. AUBLE

TEMP. 39°

TOWNSHIP SWANTON

DWG BY GARRETT

PID 107059

SECTION 19

T 7 N R 5 E

TYPE MONUMENT MAG/WASHER

ON SURFACE - ~~BELOW~~ ON

OFFSET CL PAVEMENT 0.9' ~~LT~~ : RT

- TO - EDGE PAVEMENT


STATION: 576+52.27

HORZ.DATUM: NAD83 (2011)


GEOID: 2012A

GRID: NORTHING: 692740.240

EASTING: 1592700.807

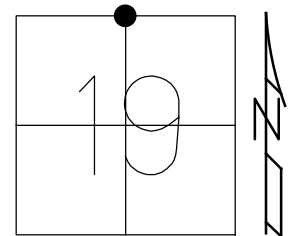

RECORD:
SET MAG/WASHER
10-12-04, MB
FD MAG/WASHER
REF54
3-6-19, JLL

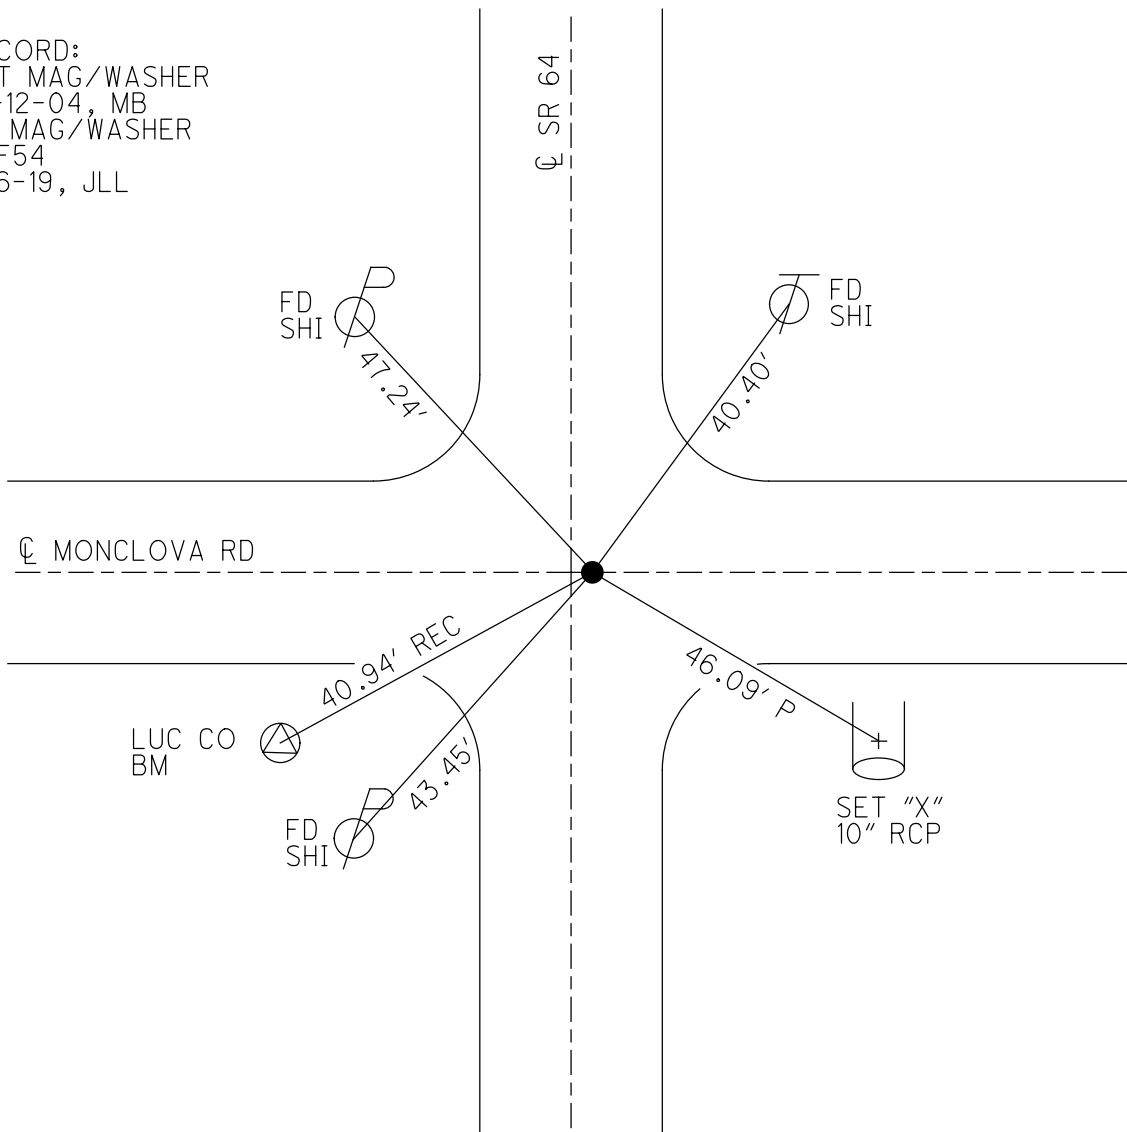

O.D.O.T. DISTRICT 2 SURVEY OFFICE

PERSONNEL

REFERENCE NO. 54

SHEET 7 OF 10

NOTES HUSS

DATE 6-16-04

ROUTE SR 64

H.C. HOMAN

WEATHER CLOUDY

COUNTY LUCAS

R.C. HUSS

TEMP. 78°

TOWNSHIP SWANTON

SECTION 19

T 7 N R 5 E



TYPE MONUMENT SM RR SPIKE

ON SURFACE ~~-BELOW~~ YES

~~LEFT - C PAVT~~ - RIGHT 0.9' RT

TO EDGE PAVEMENT

S.L.M. 577+16

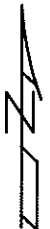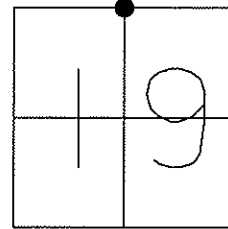

N $\frac{1}{4}$ COR 18-19

SET MAG NAIL
& WASHER
10-12-04
MB

FD N&S
SE/S



47.19'

Pavement C SR 64

40.39'

SET N&S
SW/S



C MONCLOVA RD

LUCAS CO
B.M.

40.94' REC

43.37'

FD N&S
NE/S



35.53'



FD CHISLED "X"
CONC HEADWALL

ON C MONCLOVA RD

O.D.O.T. DISTRICT 2 SURVEY OFFICE

PERSONNEL

REFERENCE NO. 54

SHEET 7 OF 9

NOTES J. Householder

H.C. D. Curtis

DATE Sept. 25, 1986

ROUTE S.R. 64

R.C. _____

WEATHER P. Cloudy

COUNTY Lucas

TEMP. + 75°

TOWNSHIP Swanton

SECTION 19

T _____ R _____



TYPE MONUMENT R.R. Spike

ON SURFACE - BELOW Surface

LEFT - ℄ PAV'T. - RIGHT 1' Right

TO _____ EDGE PAVEMENT


S.L.M. 577 + 16

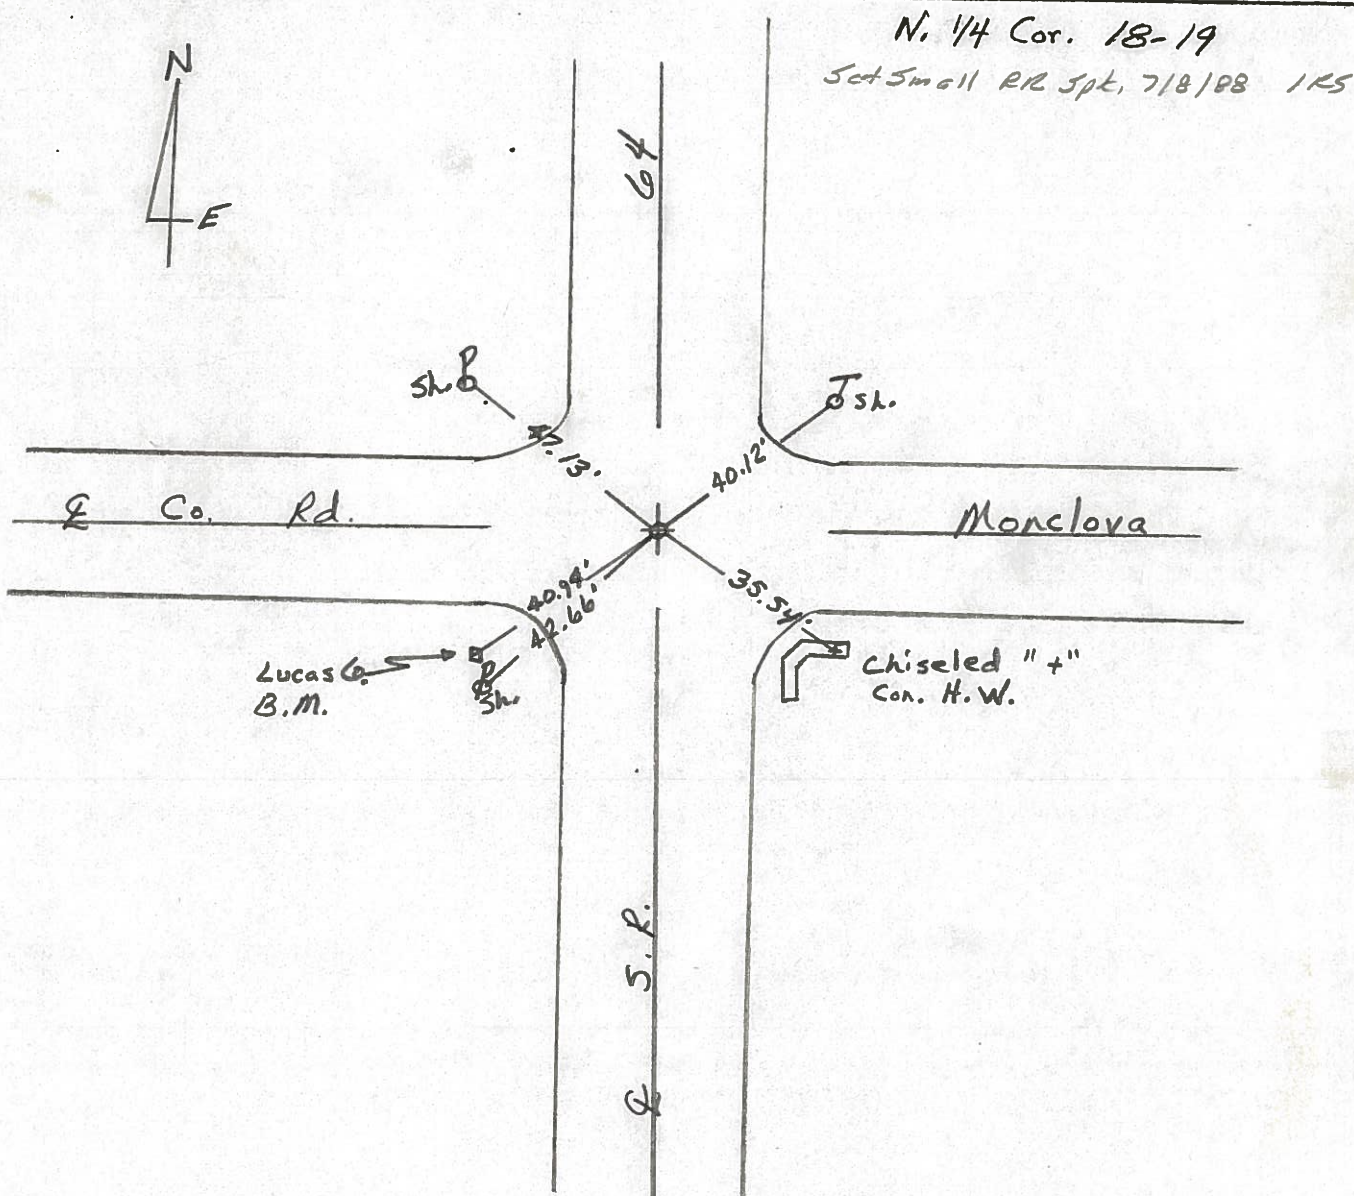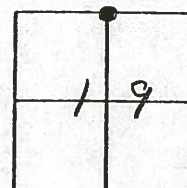

PERSONNEL	TITLE	PERSONNEL	TITLE	COUNTY	DATE	WEATHER	TEMP.
Stone				Lucas	21 March	Cold	33°
				S. R. 64			
Crew				SEC.			


DESCRIPTION References to Control Points JOB NO. _____

LEFT CENTER LINE RIGHT

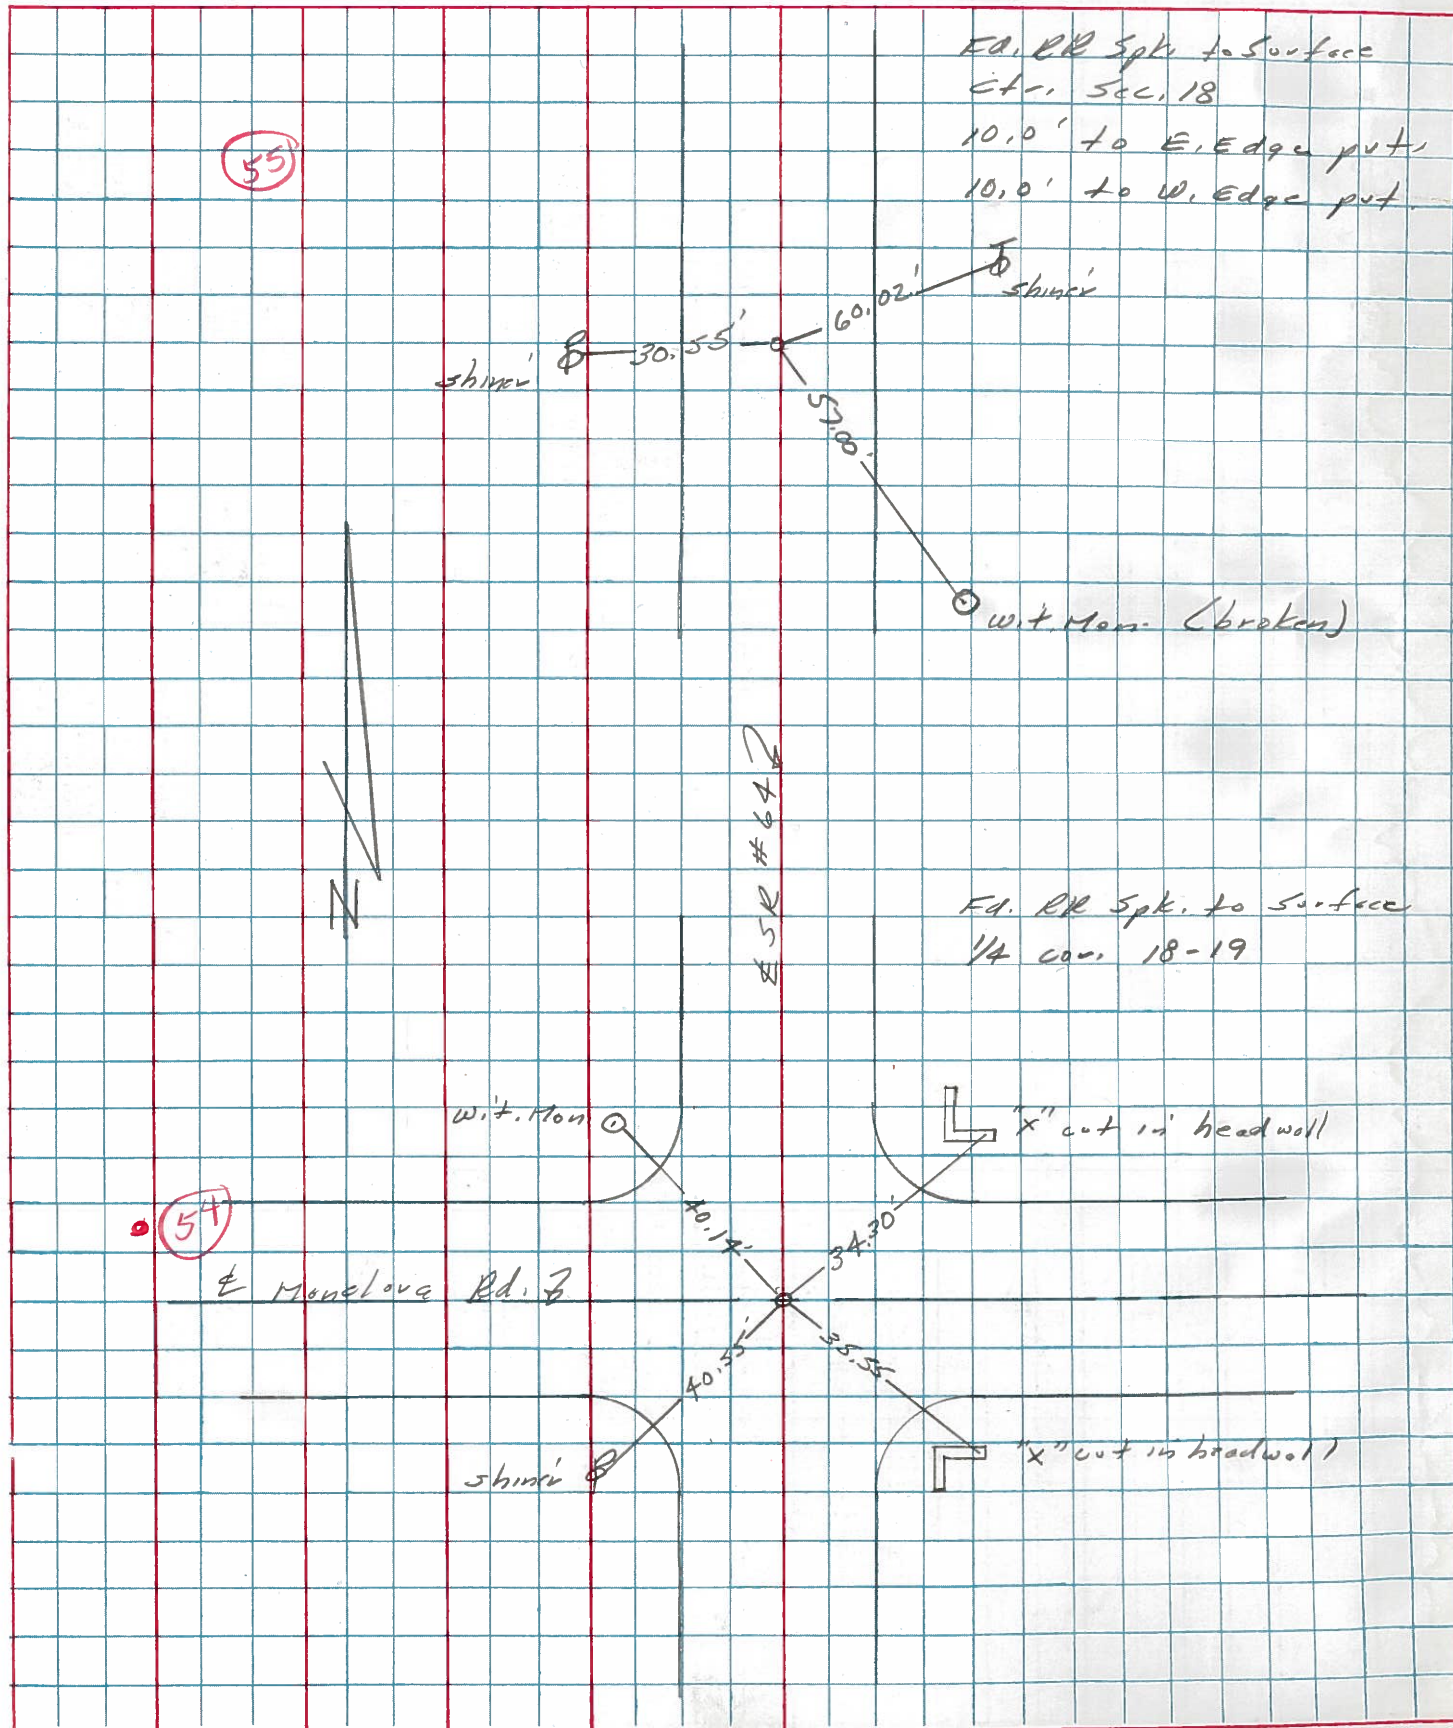

PERSONNEL	TITLE	PERSONNEL	TITLE	COUNTY	Lucas	DATE	Aug. 20, 19
W. Denno				S. R.	C4	WEATHER	warm
D. Curtis				SEC.		TEMP.	85° ±
J. Teal							
J. Brindley							

DESCRIPTION S.R. C4 - Ref. Mon. & Control Points JOB NO. 02994 (C)

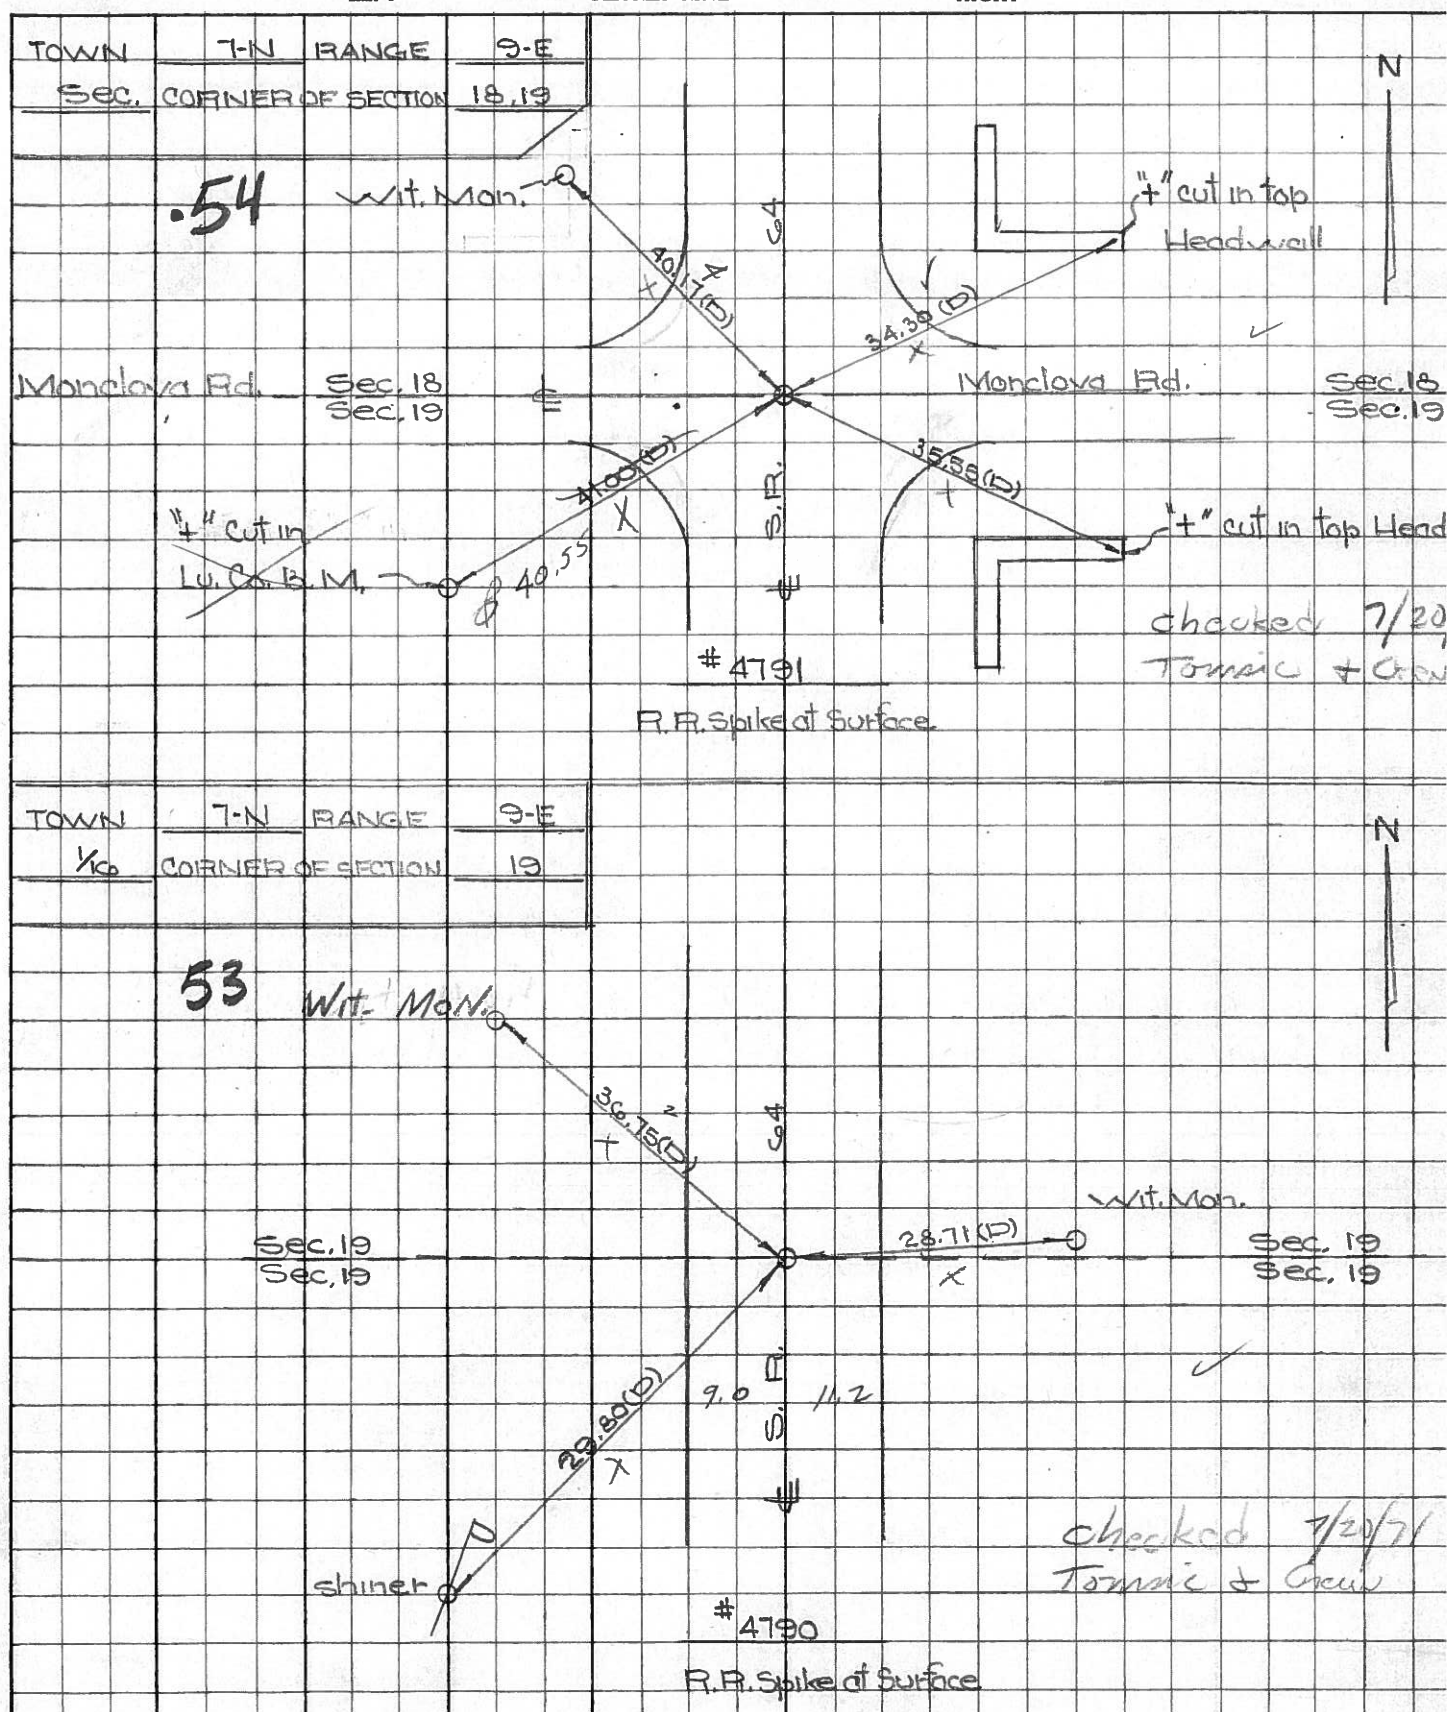

PERSONNEL	TITLE	PERSONNEL	TITLE	COUNTY	DATE	WEATHER	TEMP.
Slone				Lucas	4 Mar. 66		
Reck				S. R. #64		Windy	
Brindley							
Schroeder				SEC. N. From Sunshine Cons.			78°

DESCRIPTION	LEFT	CENTER LINE	RIGHT	JOB NO.
-------------	------	-------------	-------	---------

	.50				
#199	N Line Sec. 30		13.41'	E. To "t" on S.E. Cor. Bridge Wall	
	Fd. R.R. Spk.		13.82'	W. To "t" on S.W. Cor. Bridge Wall	
	To Surface		21.32'	N.E. To "t" on N.E. Cor. Bridge Wall	
			21.51'	N.W. To "t" on N.W. Cor. Bridge Wall	
	51				
#198	Int. Reel Rd.	44.02	22.78	S.W. To Con. W. T. Mon. (D)	
	Fd. R.R. Spk.	40.91	36.52	S.E. To Con. W. T. Mon. (D)	
	To Surface	38.22	28.25	N.E. To Holcom Lu. Co. R.M. (D)	
			34.25	N.W. To Shiner in T.P. (D)	
		36.08		N.W. "t" Cut in top Headwall	
	52				
#197	E & W. Sec. 19		27.46'	W. To Con. W. T. Mon. (D)	
	Fd. R.R. Spk.		43.98'	N.E. To Con. W. T. Mon. (D)	
	To Surface		39.48'	S.E. To Con. W. T. Mon. (D)	
			34.77	W.S.W. To Shiner in 8" Tree (D)	
	53				
#196	Between Wabash R.R. & Monclova Rd.	29.80	29.81'	W. S.W. To Shiner in T.P. (D)	
	Fd. R.R. Spk.	28.71	29.07	N.E. To Shiner in T.P. (D)	
	To Surface	36.75	28.69'	E. To Con. W. T. Mon. (D)	
			37.05	N.W. To Con. W. T. Mon. (D)	
	54				
#195	Int. Monclova Rd.		35.56'	S.E. To "t" on Con. Head Wall (D)	
	Fd. R.R. Spk.		39.30' OK	N.E. To "t" on Con. Head Wall (D)	
	To Surface		34.07	S.W. To Bottom of "V" in 2nd R.M. (D)	
			38.65	N.W. To "t" on Con. Head Wall (D)	
#194	Between Monclova Rd. & E & W. Sec. 18				
	Could Not Find				