

O.D.O.T. DISTRICT 2 SURVEY OFFICE (USE ONLY)

PERSONNEL _____

REFERENCE NO. 10

SHEET 11 OF 12

NOTES STONE

DATE 12/26/61

ROUTE SR 246

H.C. CURTIS

WEATHER COOL

COUNTY LUCAS

R.C. _____

TEMP. 28°

TOWNSHIP CITY OF TOLEDO

DWG BY NIESE

PID _____

SECTION 33

T 9 S R 7 E

TYPE MONUMENT "+" IN CONC _____

ON SURFACE - ~~BELOW~~ ON _____

OFFSET ϕ PAVEMENT _____ LT : RT

_____ TO _____ EDGE PAVEMENT


STATION: 184+80

HORZ.DATUM: _____


GEOID: _____

GRID: NORTHING: _____

EASTING: _____

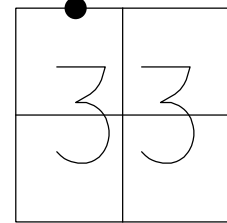

RECORD:
 $\Delta = 00^{\circ}04'00''$ LT
STA 184+46.71
SET "+" IN CONC
12/26/61, STONE

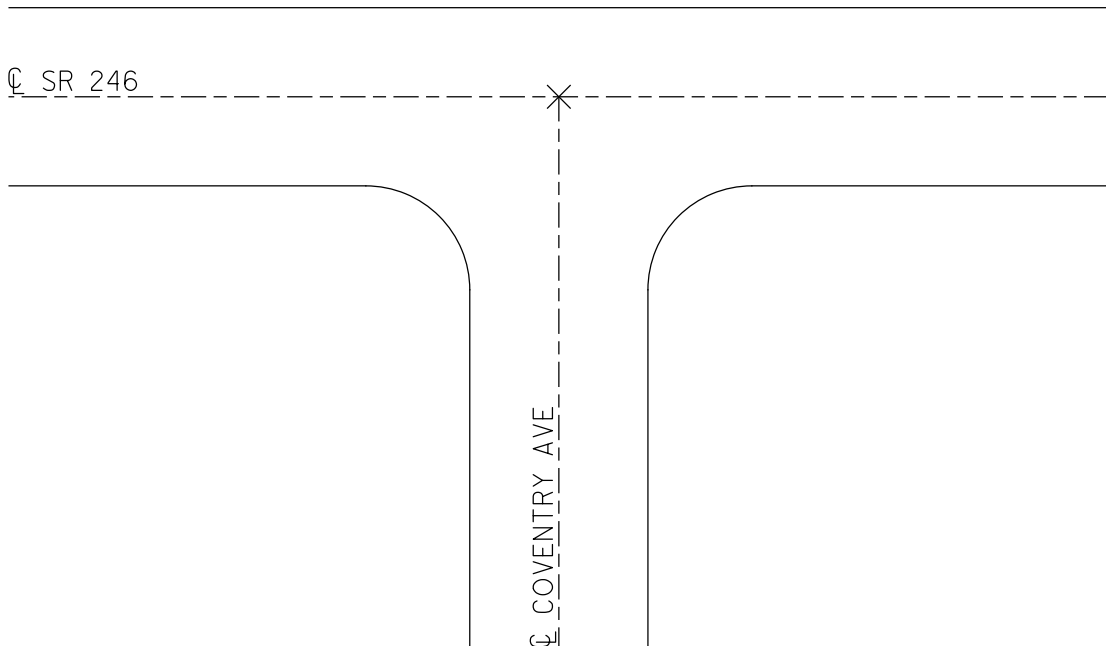

PERSONNEL	TITLE	PERSONNEL	TITLE	COUNTY	DATE
Stone				Lucas	26 Dec. 61
				S. R. # 276	WEATHER Cool
Crew				SEC. Secor to Upton	TEMP. 28°
DESCRIPTION	Dorr St. Alignment			JOB NO.	
	LEFT	CENTER LINE	RIGHT		

