

O.D.O.T. DISTRICT 2 SURVEY OFFICE (USE ONLY)

PERSONNEL

REFERENCE NO. U

SHEET OF

NOTES ASTON DATE 5/28/24
 H.C. NIESE WEATHER CLOUDY
 R.C. PRESTON-COLVIN TEMP. 65°
BLUBAUGH

ROUTE SR 295
 COUNTY LUCAS
 TOWNSHIP PROVIDENCE
 SECTION 33

DWG BY BARRIERE PID 83894

T 6 N R 9 E

TYPE MONUMENT MONBOX W/ 3/4" IPIN

ON SURFACE - BELOW ON

OFFSET Q PAVEMENT 3.0' LT LT : RT


 TO EDGE PAVEMENT

STATION: 101+57

HORIZ.DATUM: OH N/LUC OCCS GEOID: 18

GRID: NORTHING: 645877.709 EASTING: 1602520.863

LDP: NORTHING: 266837.045 EASTING: 113389.876

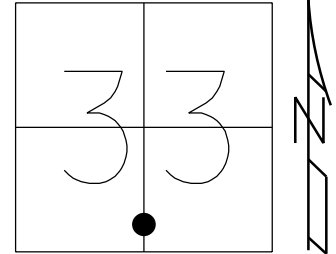

RECORD:

PIN NEEDS TO BE LOWERED

FD MONBOX

6/13/23, DSA

FD MONBOX

W/ 3/4" IPIN

SET STRATTLERS

REFU

9/26/23, TDN

FD MONBOX W/ 3/4" IPIN

NEWREFU

5/28/24, TDN

NOTE: P.T.

REF: LUC-24-0.00

PID: 25490, 83984

NEW MON BOX SET PER PID

#83894 WITH STRADDLERS, NO

IRON PIN WAS FOUND INSIDE.

ODOT STAFF SET 3/4" IRON PIN

FROM STRADDERS. SHOT W/GPS,

BUT DID NOT REFERENCE

YEAR 2017

