

O.D.O.T. DISTRICT 2 SURVEY OFFICE (USE ONLY)

PERSONNEL

REFERENCE NO. V

SHEET OF

NOTES ASTON

DATE 5/28/24

ROUTE SR 295

H.C. NIESE

WEATHER CLEAR

COUNTY LUCAS

R.C. PRESTON-COLVIN

TEMP. 70°

TOWNSHIP PROVIDENCE

BLUBAUGH

SECTION 33

DWG BY BARRIERE

PID 83894

T 6 N R 9 E

TYPE MONUMENT MONBOX W/ 1" IPIN

ON SURFACE - BELOW ON

OFFSET $\varnothing$ PAVEMENT ON LT : RT

 TO EDGE PAVEMENT

STATION: 120+76.20

HORIZ.DATUM: OH N/LUC OCCS


GEOID: 18

GRID: NORTHING: 646644.268

EASTING: 1604280.887

LDP: NORTHING: 267626.761

EASTING: 115139.779

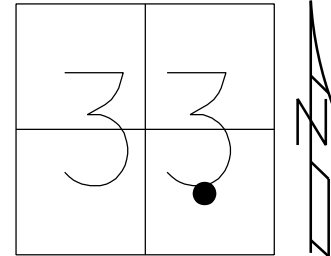

RECORD:
PRIOR REF20-US24
FD P.K./WASHER
6/2/97, BVD
FD SM R.R. SPIKE
SET P.K./WASHER
10-21-97, SAH
FD MONBOX
W/ 1" IPIN
REF17
8-8-17, JLL
FD MONBOX
6/13/23, DSA
FD MONBOX
W/ 1" IPIN
SET STRATTLERS
REFV
9/26/23, TDN
FD MONBOX
W/ 1" IPIN
NEWREFV
5/28/24, TDN

NOTE:
REF: LUC-24-0.00
PID: 25490, 83984

