

PERSONNEL

SHEET _____ OF _____

ROUTE SR 295

COUNTY LUCAS


TOWNSHIP PROVIDENCE

BLUBAUGH

PID 83894

T 6 N R 9 F

T 6 N R 9 F

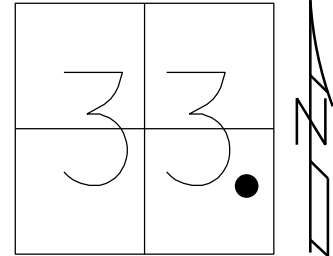EASTING: 115916.517

NOTE: ALL MONBOXES HAVE STRATTLERS

FD SHIs IN GR POSTS

DIST:
Y-I= 16.57'
X-I= 98.57'
Y-X= 82.02'

O.D.O.T. DISTRICT 2 SURVEY OFFICE (USE ONLY)

PERSONNEL

REFERENCE NO. 1

SHEET 1 OF 45

NOTES AUBLE

DATE 5/3/23

ROUTE SR 295

H.C. NIESE

WEATHER WINDY

COUNTY LUCAS

R.C. MILLER

TEMP. 53°

TOWNSHIP PROVIDENCE

DWG BY ASTON

PID CHIP SEAL

SECTION 33

T 6 N R 9 E

TYPE MONUMENT MONBOX W/ 1" IPIN

ON SURFACE - ~~BELOW~~ ON

OFFSET 2.1 ± : RT

9.7 TO RT EDGE PAVEMENT


STATION: 130+23.4

HORIZ.DATUM: NAD83(2011)

GEOID: NAVD88 2018


GRID: NORTHING: 647022.264

EASTING: 1605149.049

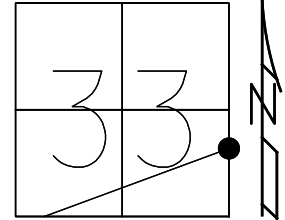

RECORD:
PRIOR REF22-US24
FD P.K./WASHER
6/2/97, BVD
SET P.K./WASHER
10-21-97, SAH
FD MONBOX
W/ 1" IPIN
REF21
8-8-17, JLL
FD MONBOX
9/29/23, JAM

LUCAS: LDP
N: 268016.212
E: 116002.928

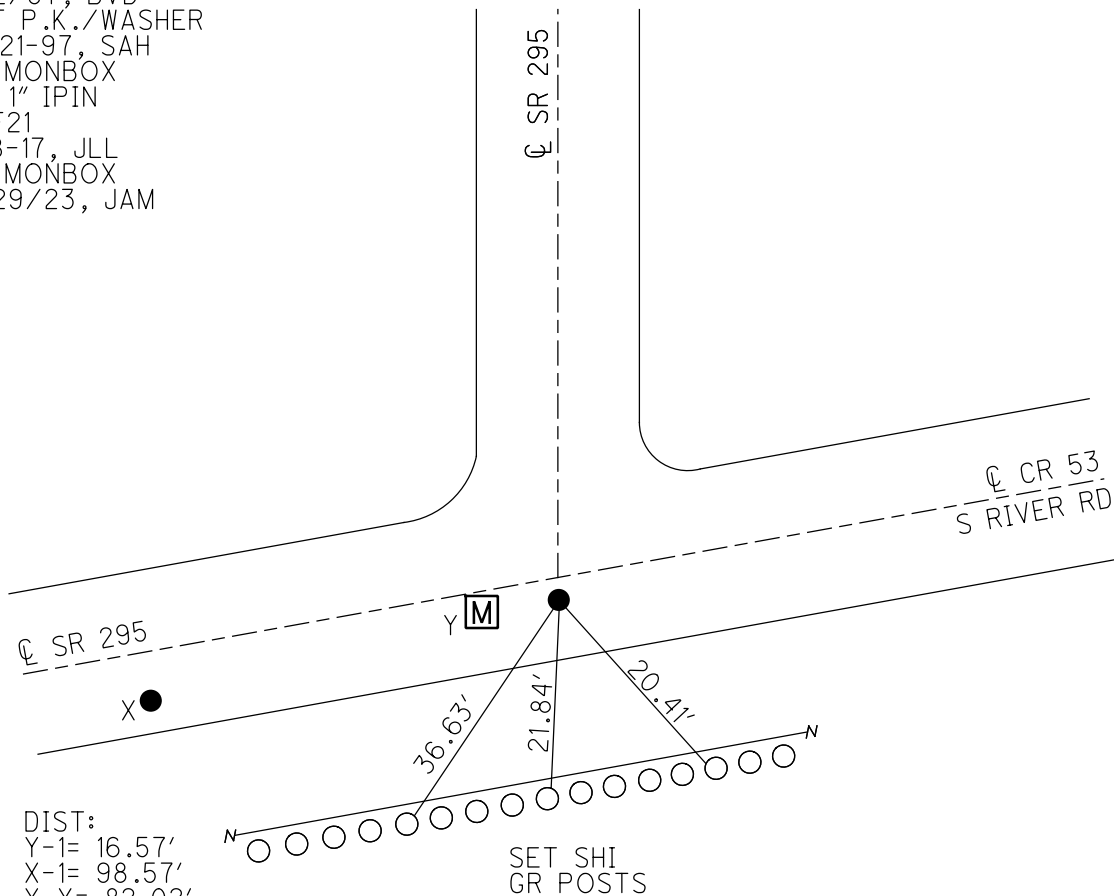

DIST:
Y-1= 16.57'
X-1= 98.57'
Y-X= 82.02'

O.D.O.T. DISTRICT 2 SURVEY OFFICE (USE ONLY)

PERSONNEL

REFERENCE NO. 1

SHEET 20 OF 20

NOTES HUSS

DATE 6/2/97

ROUTE SR 295

H.C. VAN DUSEN

WEATHER CLOUDY/RAIN

COUNTY LUCAS

R.C. CORDES

TEMP. 57°

TOWNSHIP PROVIDENCE

COX

SECTION 33

DWG BY MILLER

PID 83894

T 6 N R 9 E

TYPE MONUMENT P.K./WASHER

ON SURFACE - ~~BELOW~~ ON

OFFSET CL PAVEMENT 2.1 ~~LT~~ : RT

9.7 TO RT EDGE PAVEMENT


STATION: 130+10

HORIZ.DATUM: NAD83(2011)

GEOID: 12A NAVD88


GRID: NORTHING: 647022.264

EASTING: 1605149.049

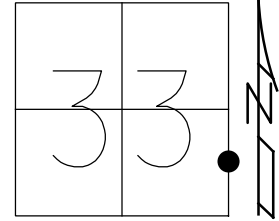

RECORD:
PRIOR REF22-US24
FD P.K./WASHER
6/2/97, BVD
SET P.K./WASHER
10-21-97, SAH
FD MONBOX
W/ 1" IPIN
REF21
8-8-17, JLL


NOTE:
REF: LUC-24-0.00
PID: 25490, 83984

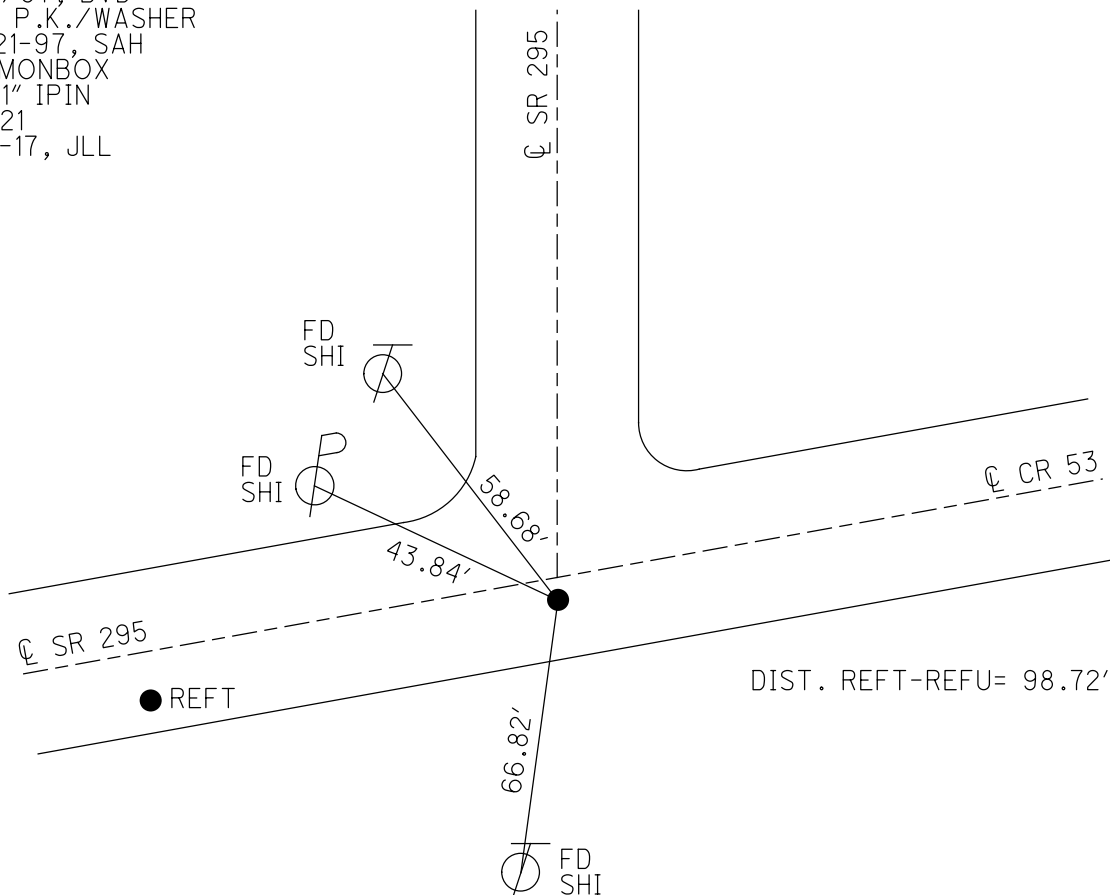

O.D.O.T. DISTRICT 2 SURVEY OFFICE (USE ONLY)


PERSONNEL _____ REFERENCE NO. 1 SHEET 1 OF 45
 NOTES STONE DATE 8/29/89 ROUTE SR 295
 H.C. CURTIS WEATHER HUMID COUNTY LUCAS
 R.C. HOUSEHOLDER TEMP. 84° TOWNSHIP PROVIDENCE
 _____ SECTION 33
 _____ T 6 N R 9 E

TYPE MONUMENT P.K. NAIL
 ON SURFACE - ~~BELOW~~ ON
 LEFT - Q PAV'T - RIGHT -
TO EDGE PAVEMENT
 S.L.M. 130+41.6

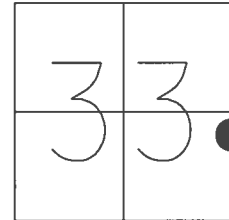

GRID: NORTHING: 647022.264 EASTING: 1605149.049

RECORD:
 FD P.K.NAIL
 8/29/89, IRS
 SET P.K. NAIL
 10/13/89, IRS
 FOR SR 295 RESURFACE
 PROJECT-2002-THIS
 POINT NOT COVERED.
 FD MONBOX W/IPIN
 REF21
 12/4/15, JLL

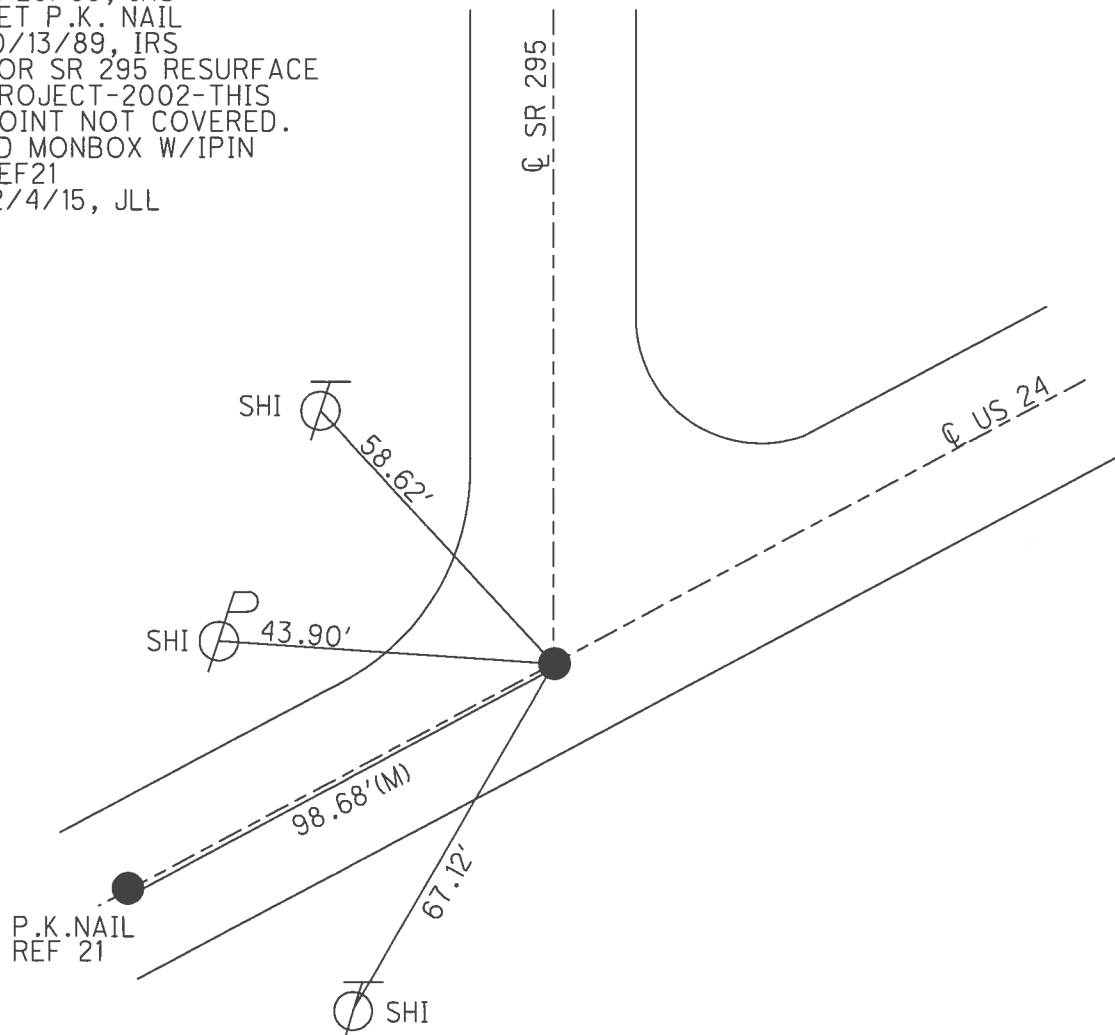

O.D.O.T. DISTRICT 2 SURVEY OFFICE

PERSONNEL

REFERENCE NO. 1

SHEET 1 OF 45

NOTES I. STONE

DATE 8/29/89

ROUTE SR 295

H.C. D. CURTIS

WEATHER HUMID

COUNTY LUCAS

R.C. J. HOUSEHOLDER

TEMP. 84°

TOWNSHIP PROVIDENCE

SECTION 33

T 6 N R 9 E


TYPE MONUMENT P.K. NAIL

ON SURFACE - ~~BELOW~~ ON

LEFT - Q PAV'T - RIGHT


 TO EDGE PAVEMENT

S.L.M. 189+73

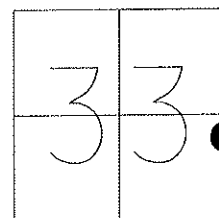

NOTE:
FOR SR 295 RESURFACE
PROJECT-2002-THIS
POINT NOT COVERED.

SET P.K.NAIL
10/13/89, IRS

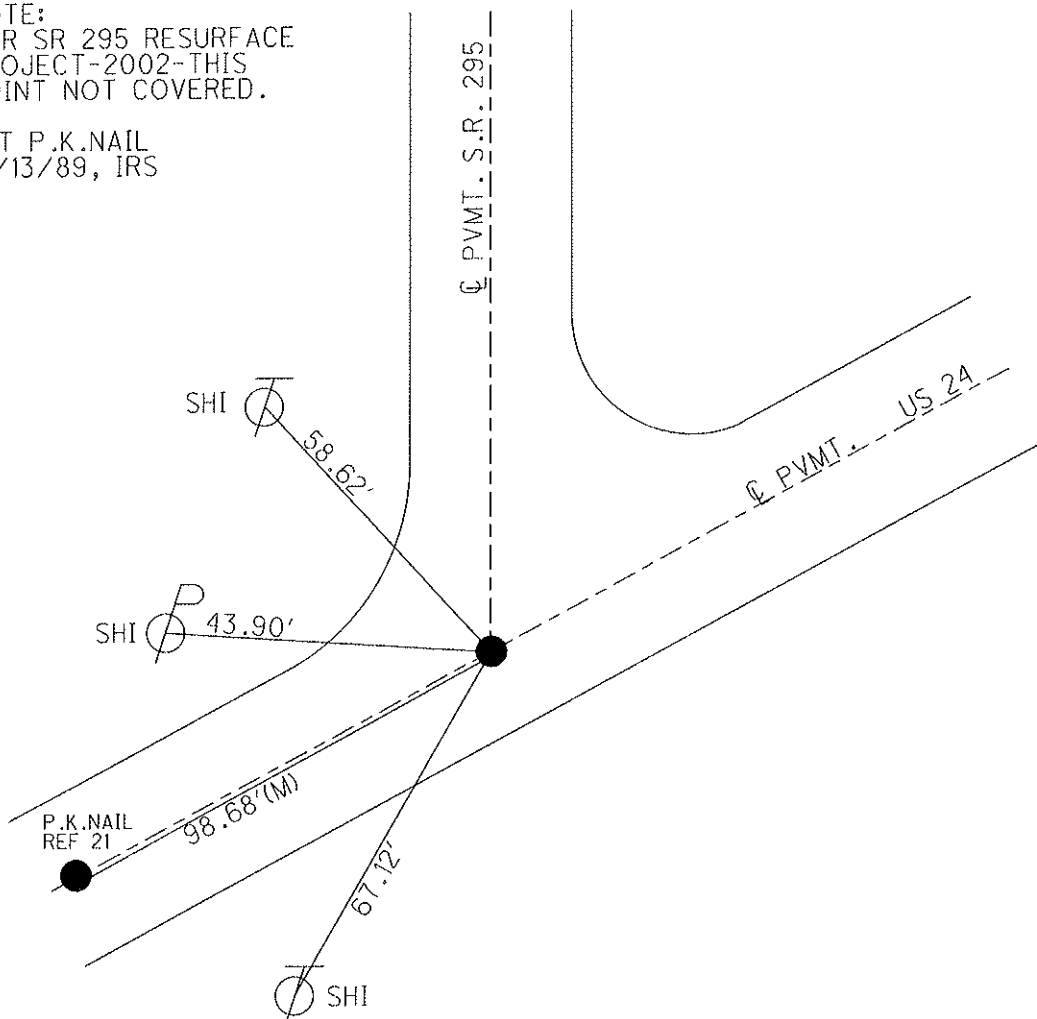

Resurfaced 2002
mill-fill

SHEET NO. 1-28

PERSONNEL TITLE PERSONNEL TITLE

W. DENNO

COUNTY LUCAS

DATE JULY 12, 1971

D. CURTIS

S. R. #295

WEATHER CLOUDY

D. STEVENS

SEC.

TEMP. 70±

R. BRANNAN

DESCRIPTION

REFERENCES TO CONTROL POINTS
LEFT CENTER LINE RIGHT

JOB NO.

