

O.D.O.T. DISTRICT 2 SURVEY OFFICE (USE ONLY)

PERSONNEL

REFERENCE NO. 6

SHEET 6 OF 45

NOTES PRESTON-COLVIN

DATE 10-2-24

ROUTE SR 295

H.C. PRESTON-COLVIN

WEATHER SUNNY

COUNTY LUCAS

R.C. NEISE

TEMP. 70°

TOWNSHIP PROVIDENCE

DWG BY PRESTON-COLVIN

PID PAVING TRAIN

SECTION 22

T 6 N R 9 E

TYPE MONUMENT MAG/WASHER

ON SURFACE - ~~BELOW~~ ON

OFFSET ¢ PAVEMENT 2" ~~LT~~ : RT

9.5' TO RT EDGE PAVEMENT

STATION: 244+15.38

HORZ.DATUM: NAD83(2011)


GEOID: NAVD88 2018

GRID: NORTHING: 658395.963


EASTING: 1605118.134

LDP: NORTHING: 279389.260

EASTING: 115822.329

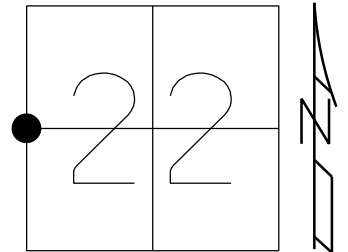

RECORD:
FD 3/4" IPIN
11/2/84
FD P.K.NAIL
8/29/02, DCH
SET MAG/WASHER
11/25/02, DCH
FD MAG ANIL
REF26
12/4/15, JLL
SET MAG/WASHER
7/17/17, DCH
FD MAG/WASHER
REF6
12/6/21, JFO
FD MAG/W
REF6
5-3-23, TDN
9-29-23, JAM
FD MAG/W
6/17/24, JAM
10/2/24, TDN

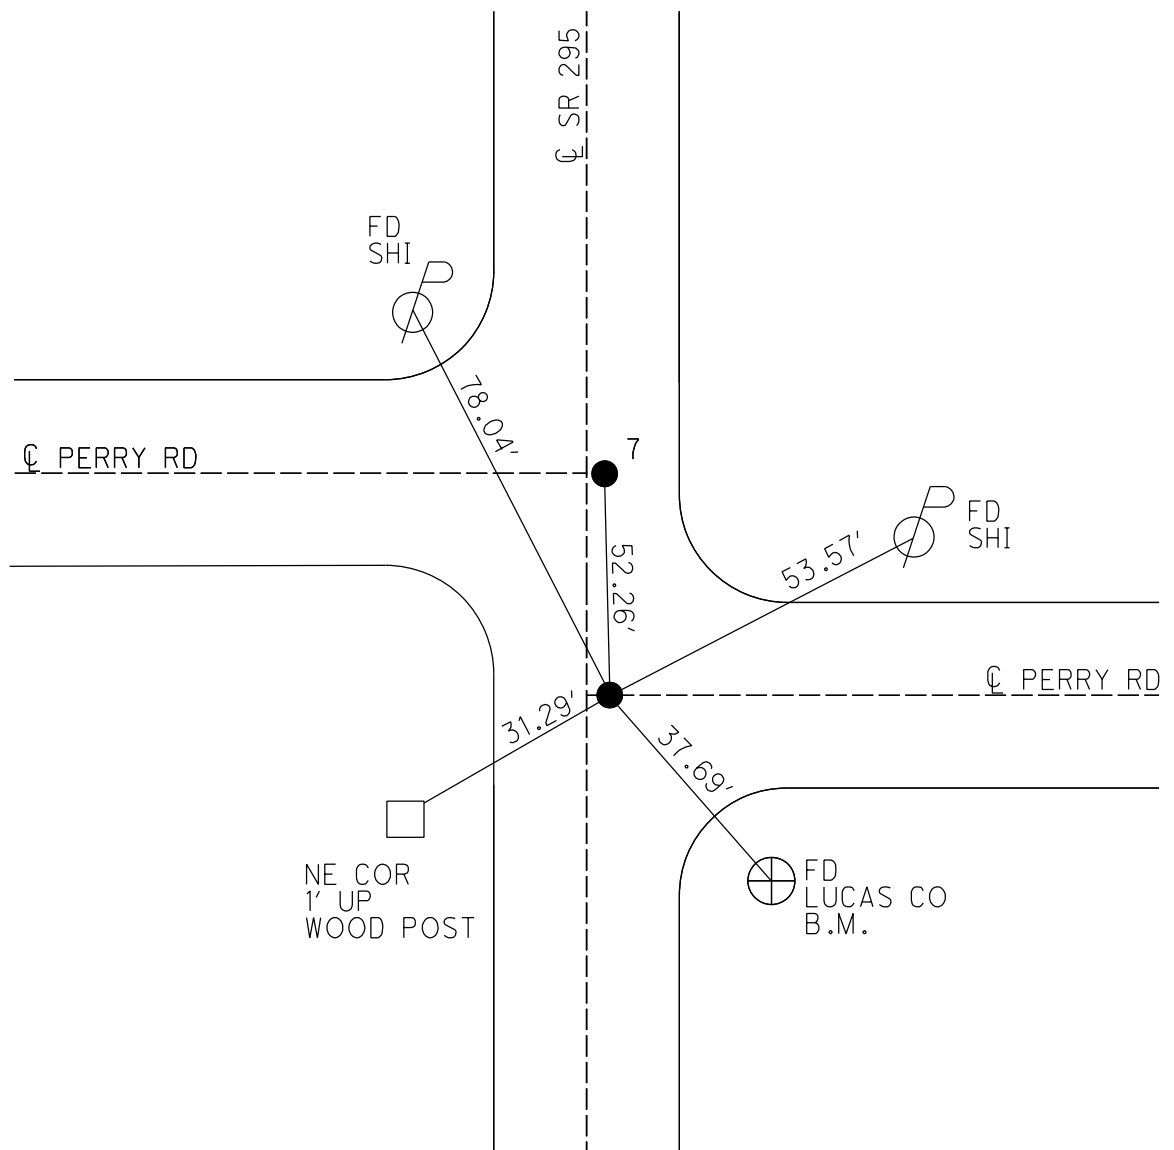

O.D.O.T. DISTRICT 2 SURVEY OFFICE (USE ONLY)

PERSONNEL

REFERENCE NO. 6

SHEET 6 OF 45

NOTES AUBLE

DATE 5-3-23

ROUTE SR 295

H.C. NIESE

WEATHER WINDY

COUNTY LUCAS

R.C. MILLER

TEMP. 53°

TOWNSHIP PROVIDENCE

DWG BY ASTON

PID CHIP SEAL

SECTION 22

T 6 N R 9 E

TYPE MONUMENT MAG/WASHER

ON SURFACE - ~~BELOW~~ ON

OFFSET CL PAVEMENT 2" ~~LT~~ : RT

9.5' TO RT EDGE PAVEMENT


STATION: 244+15.38

HORZ.DATUM: NAD83(2011)

GEOID: NAVD88 2018


GRID: NORTHING: 658395.963

EASTING: 1605118.134

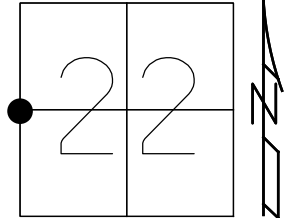

LUCAS: LDP
N: 279389.260
E: 115822.329

RECORD:
FD 3/4" IPIN
11/2/84
FD P.K.NAIL
8/29/02, DCH
SET MAG/WASHER
11/25/02, DCH
FD MAG ANIL
REF26
12/4/15, JLL
SET MAG/WASHER
7/17/17, DCH
FD MAG/WASHER
REF6
12/6/21, JFO
FD MAG/W
REF6
5-3-23, TDN
9-29-23, JAM

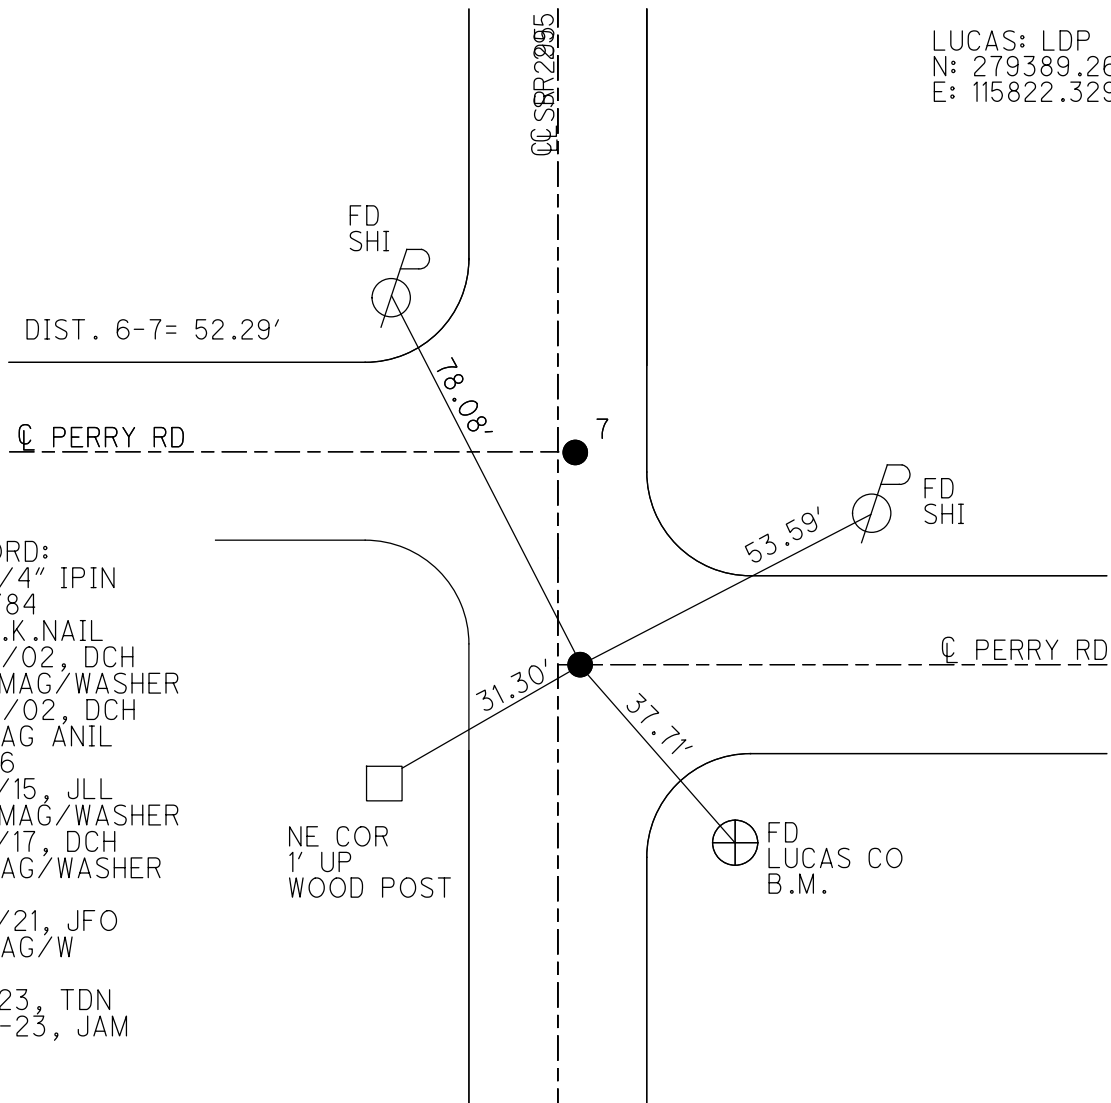

O.D.O.T. DISTRICT 2 SURVEY OFFICE (USE ONLY)

PERSONNEL

REFERENCE NO.

6

SHEET

6

OF

45

NOTES

HOMAN

DATE

3/17/17

ROUTE

SR 295

H.C.

HOMAN

WEATHER

CLOUDY

COUNTY

LUCAS

R.C.

HELDMAN

TEMP.

33°

TOWNSHIP

PROVIDENCE

SECTION

22

T 6 N R 9 E

TYPE MONUMENT

MAG NAIL

ON SURFACE - ~~BELOW~~

ON

~~LEFT~~ - CL PAV'T RIGHT

2"




9.5' TO RT EDGE PAVEMENT

S.L.M.

244+15.38

GRID: NORTHING: 658395.963

EASTING: 1605118.134

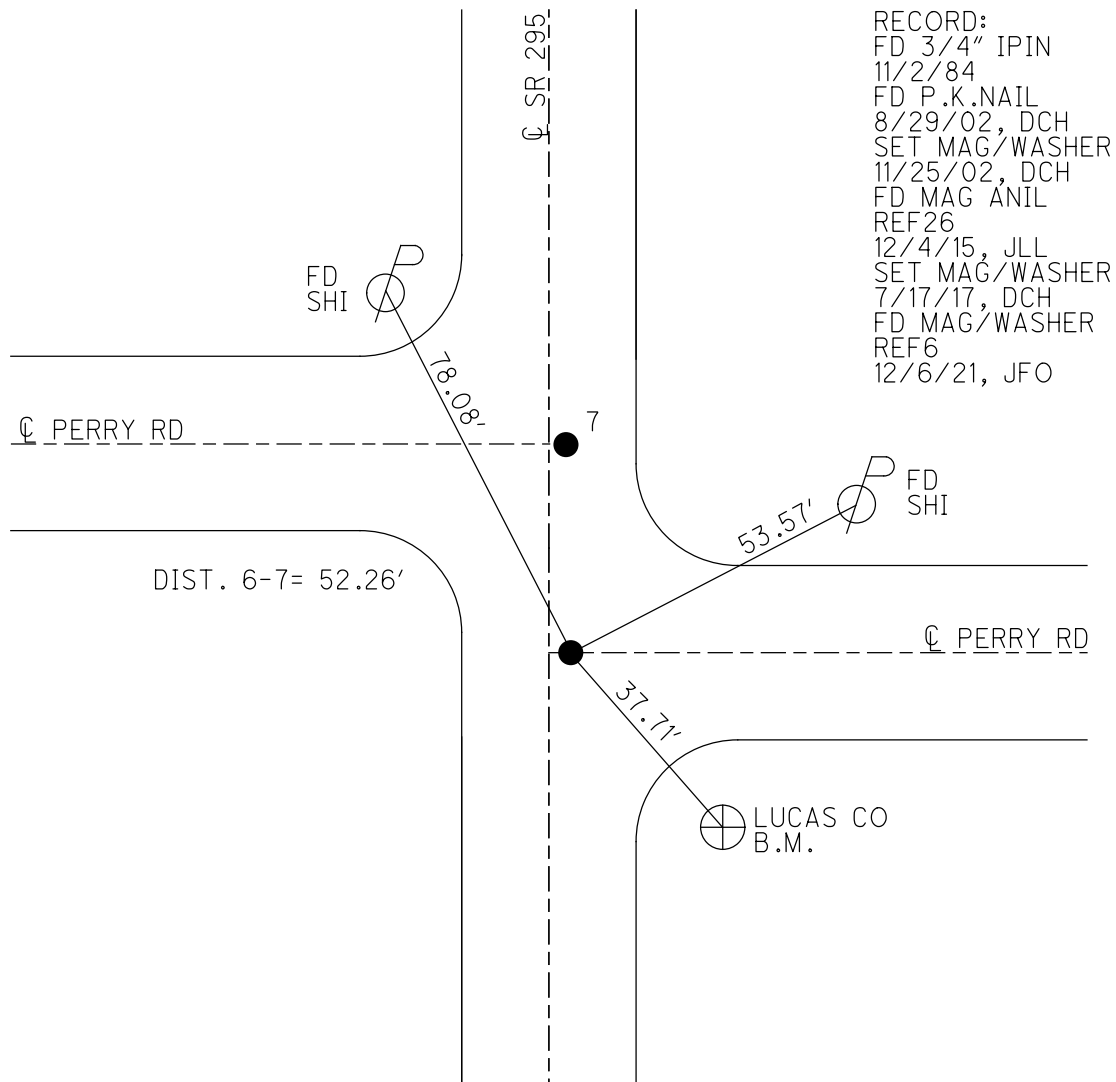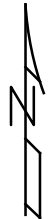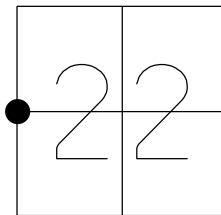

RECORD:

FD 3/4" IPIN

11/2/84

FD P.K.NAIL

8/29/02, DCH

SET MAG/WASHER

11/25/02, DCH

FD MAG ANIL

REF26

12/4/15, JLL

SET MAG/WASHER

7/17/17, DCH

FD MAG/WASHER


REF6

12/6/21, JFO

O.D.O.T. DISTRICT 2 SURVEY OFFICE (USE ONLY)


PERSONNEL	REFERENCE NO. <u>6</u>	SHEET <u>6</u> OF <u>45</u>
NOTES	DATE <u>3/17/17</u>	ROUTE <u>SR 295</u>
H.C. <u>HOMAN</u>	WEATHER <u>CLOUDY</u>	COUNTY <u>LUCAS</u>
R.C. <u>HELDMAN</u>	TEMP. <u>33°</u>	TOWNSHIP <u>PROVIDENCE</u>
		SECTION <u>22</u>
		T <u>6</u> N R <u>9</u> E

TYPE MONUMENT MAG NAIL
 ON SURFACE - ~~BELOW~~ ON
~~LEFT~~ - Q PAV'T RIGHT 2"
9.5' TO RT EDGE PAVEMENT
 S.L.M. 244+15.38

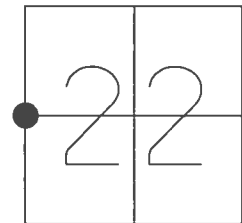

GRID: NORTHING: 658395.980 EASTING: 1605118.141

RECORD:
 FD 3/4" IPIN
 11/2/84
 FD P.K.NAIL
 8/29/02, DCH
 SET MAG/WASHER
 11/25/02, DCH
 FD MAG ANIL
 REF26
 12/4/15, JLL
 SET MAG/WASHER
 7/17/17, DCH

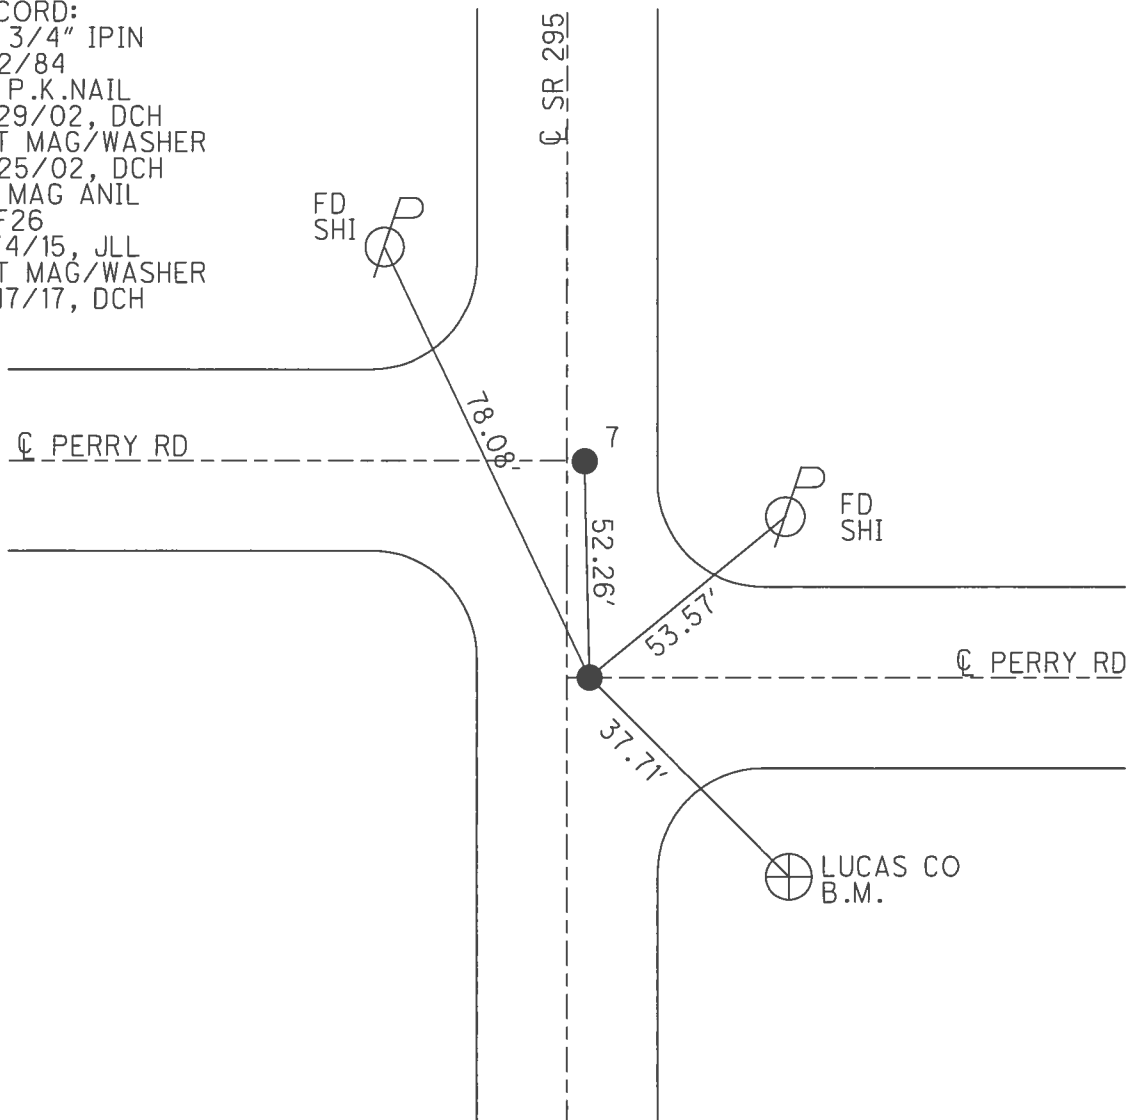

LUCAS CO.
B.M.

O.D.O.T. DISTRICT 2 SURVEY OFFICE

PERSONNEL

REFERENCE NO. 6&7

SHEET 6 OF 40

NOTES HOMAN

DATE 8-29-02

ROUTE S.R. 295

H.C. HOMAN

WEATHER CLOUDY

COUNTY LUCAS

R.C. BEAUMONT

TEMP. 78°

TOWNSHIP PROVIDENCE

SECTION 22

T 6 N R 9 E


TYPE MONUMENT 3/4" I. PIN & PK NAIL

ON SURFACE - BELOW ON SURFACE

LEFT - CL PAV'T - RIGHT 2' RIGHT


9.5' TO RT. EDGE PAVEMENT

S.L.M. 113+71 & 114+52

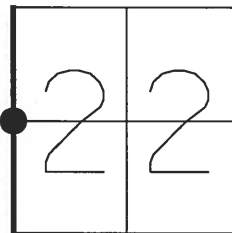

SET MAGS &
WASHERS
11-25-02
DCH

RECORD: FD. 3/4" I. PINS
AT BOTH POINTS
11-2-84

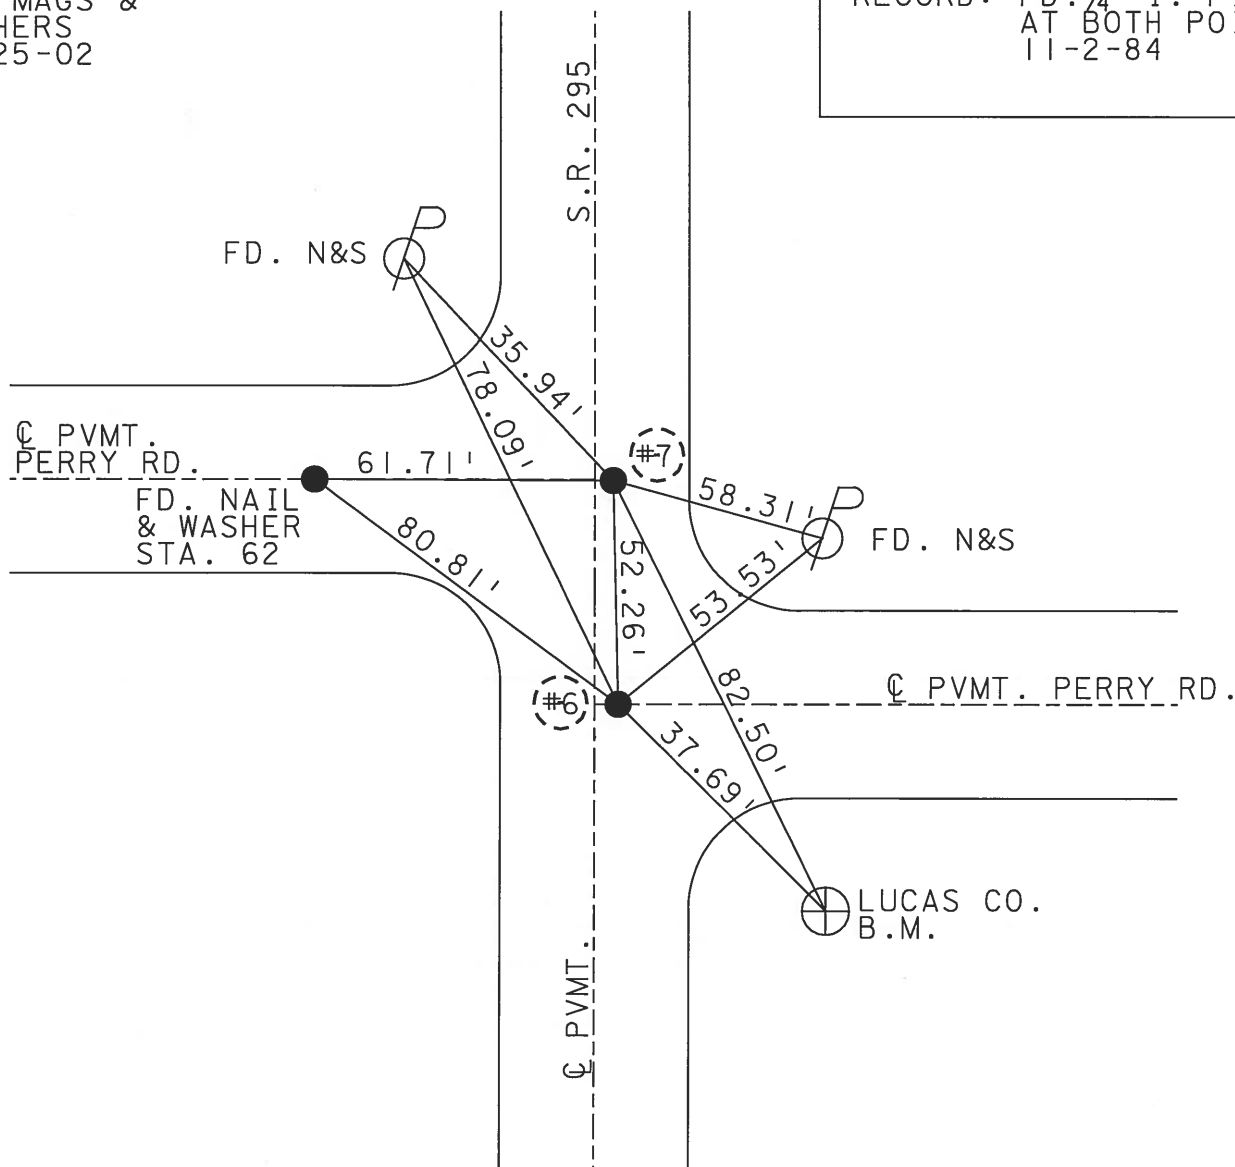

O.D.O.T. DISTRICT 2 SURVEY OFFICE

PERSONNEL

REFERENCE NO. 647

SHEET 5 OF 35

NOTES LOEHRKE

H.C. STONE

R.C. CURTIS

DATE 8-15-91

WEATHER CLEAR

TEMP. +78

ROUTE S.R. 295

COUNTY LUCAS

TOWNSHIP PROVIDENCE

SECTION 22

T. 6 N. R. 9 E

TYPE MONUMENT P.K. Nails

ON SURFACE - BELOW YES


LEFT - Q PAV'T. - RIGHT

 TO EDGE PAVEMENT


S.L.M. 114+27 ± 114+52

Set P.K./WASHERS

3-24-92

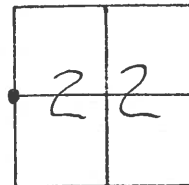

Records: Fd 3/4" I. Pins at
BOTH POINTS, 11-2-84

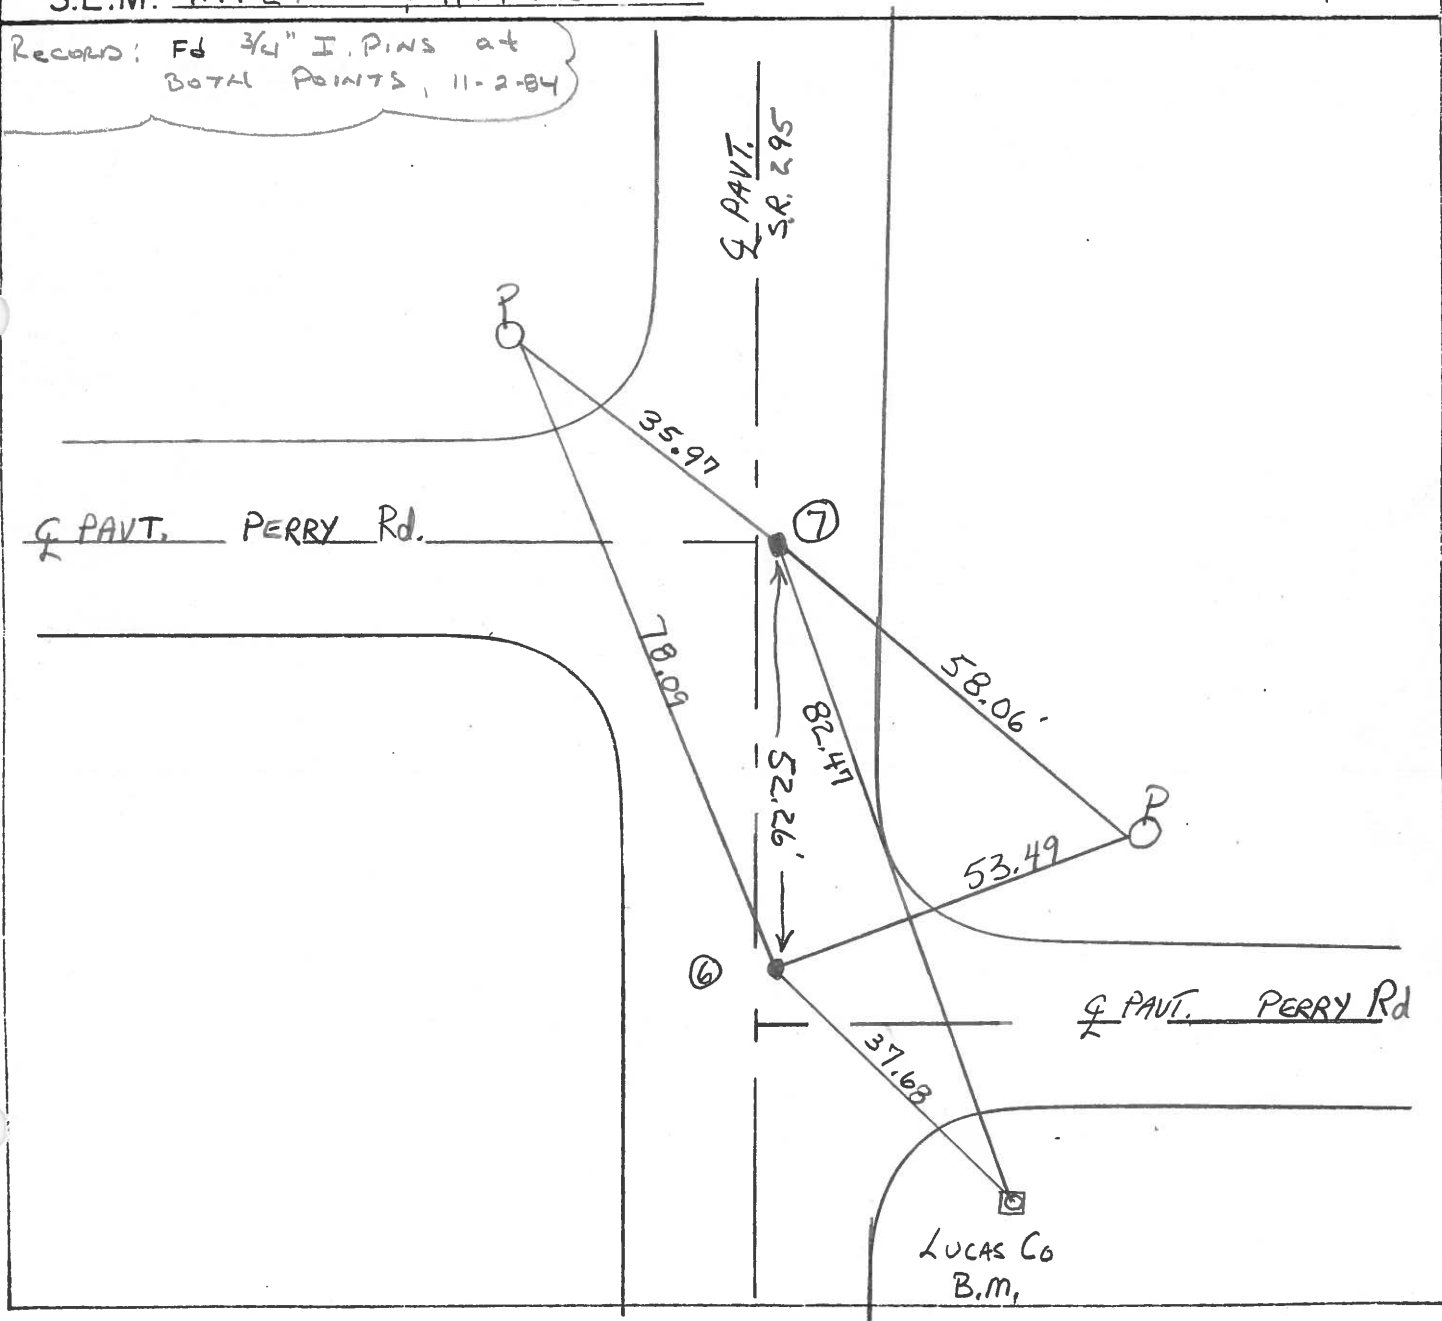

SHEET 5 OF 5

Date 3 Apr. '84


Weather cloudy

Temp. 45°

N
A

D. Curtis

Ref. No. 6 & 7

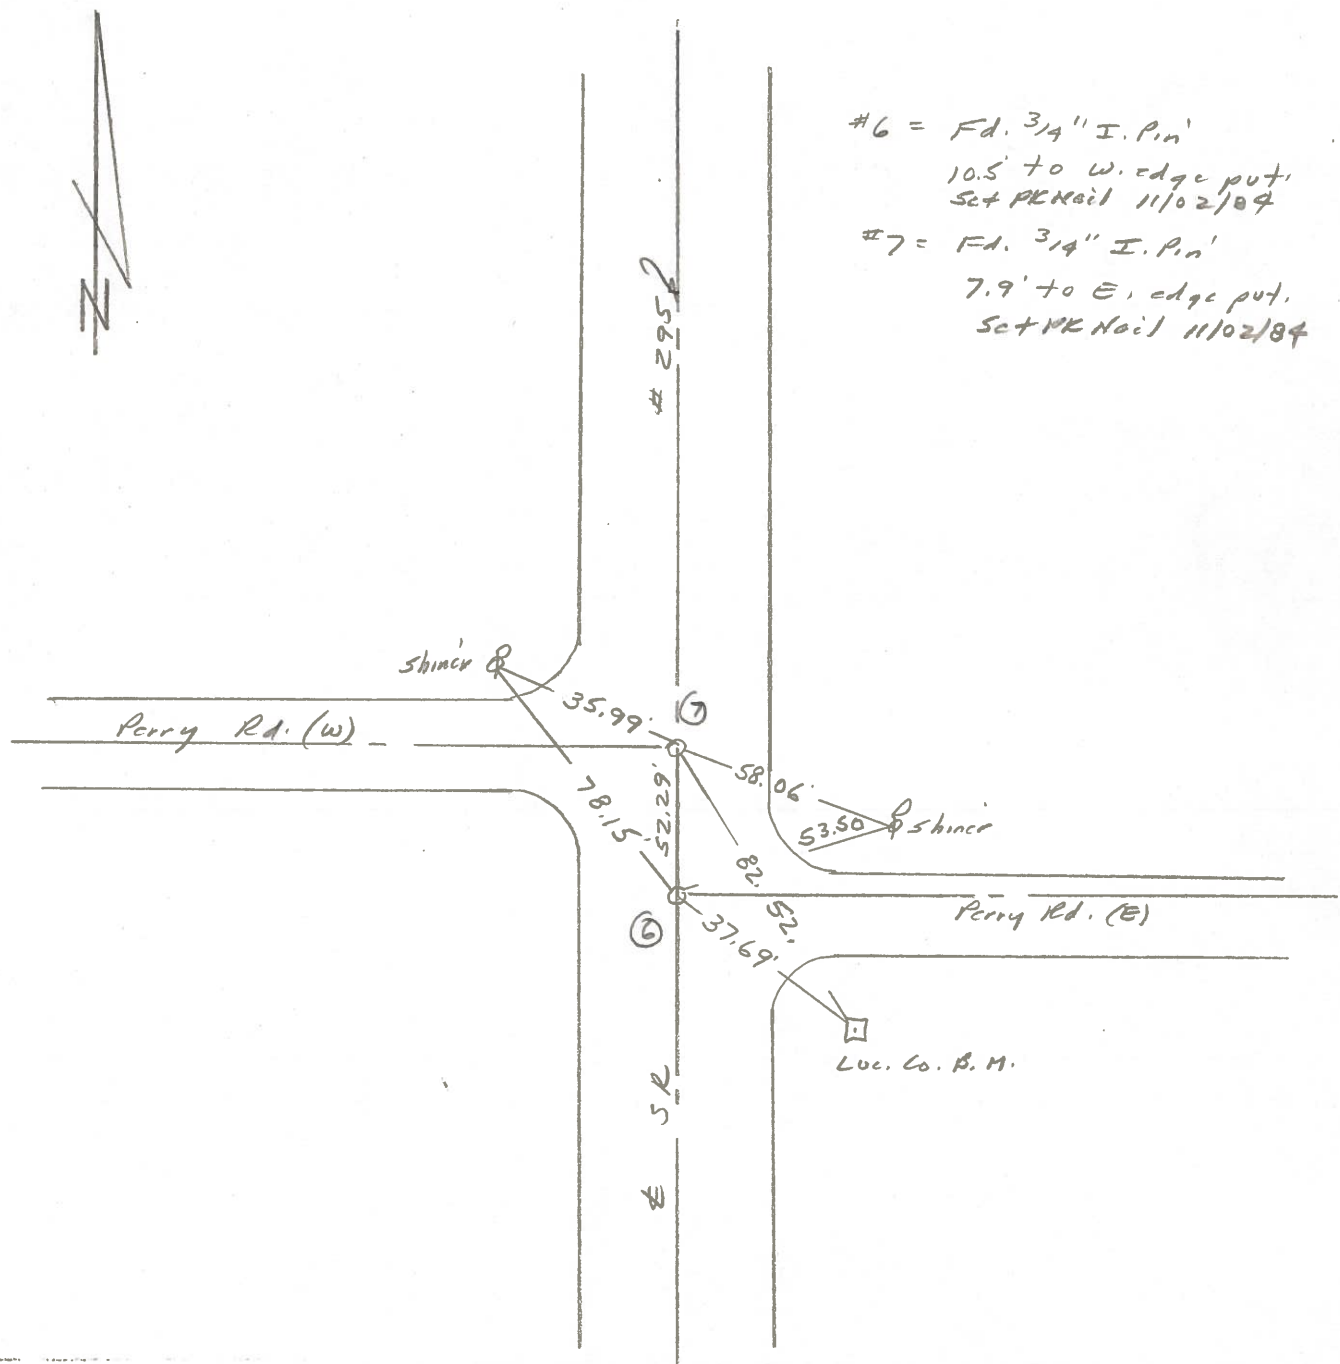

PERSONNEL	TITLE	PERSONNEL	TITLE
W. DENNO			
D. CURTIS			
D. STEVENS			
R. BRANNEN			

COUNTY LUCASDATE JULY 13, 1971S. R. #295WEATHER CLOUDY

SEC. _____


TEMP. 70 ±DESCRIPTION REFERENCES TO CONTROL POINTS

JOB NO. _____

LEFT

CENTER LINE

RIGHT

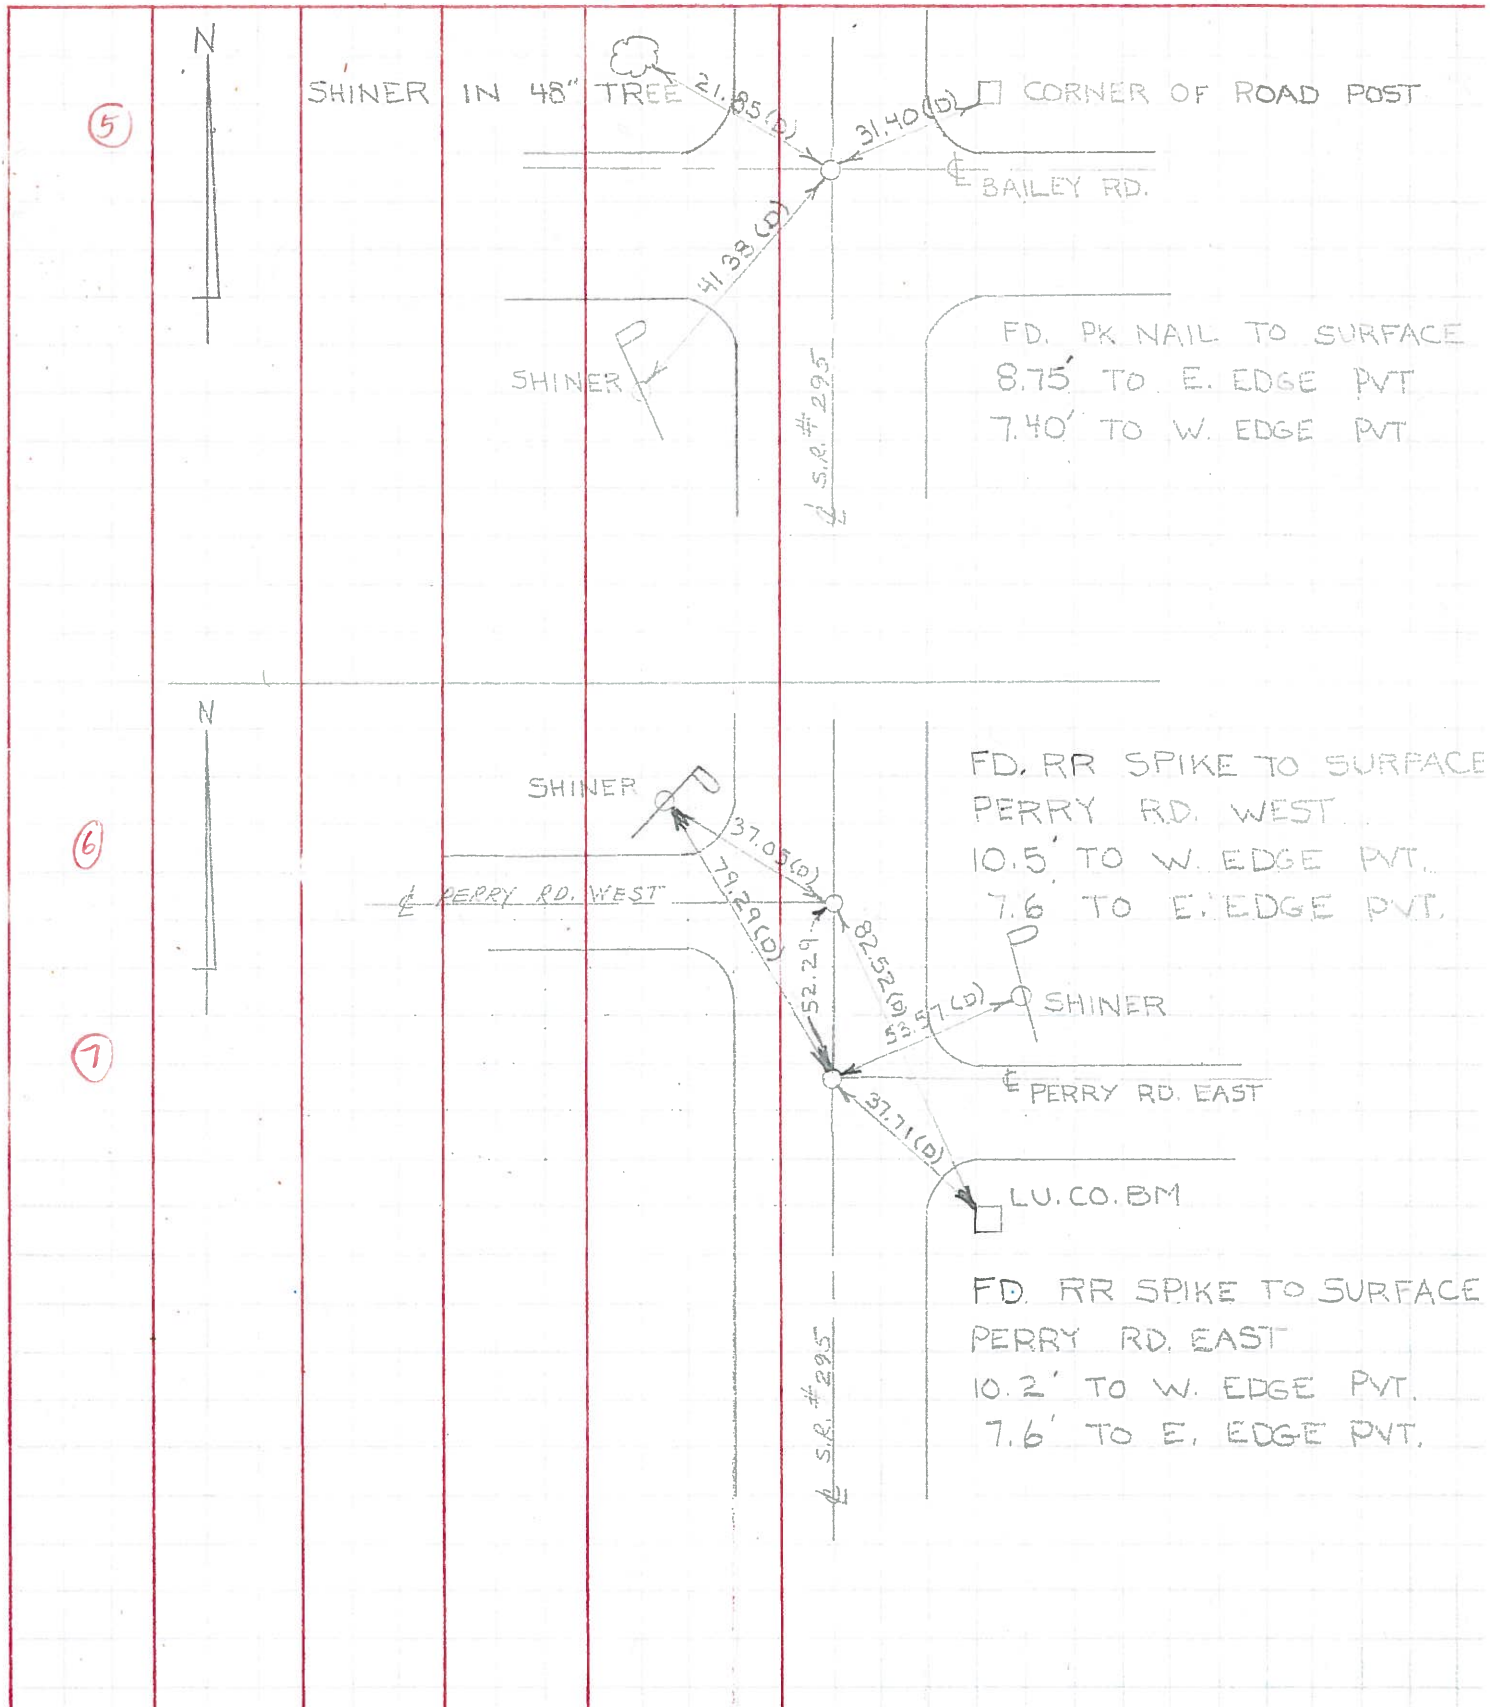

PERSONNEL	TITLE	PERSONNEL	TITLE	COUNTY	DATE
Stone	Notes			Lucas	6 June 68
Beck	Tape			S. R. # 295	WEATHER Hot
Michaelok	Tape			SEC.	TEMP. 87°

DESCRIPTION References to Control Points JOB NO. _____

LEFT CENTER LINE RIGHT

