

O.D.O.T. DISTRICT 2 SURVEY OFFICE (USE ONLY)

PERSONNEL

REFERENCE NO. 10

SHEET 10 OF 45

NOTES PRESTON-COLVIN

DATE 10-2-24

ROUTE SR 295

H.C. PRESTON-COLVIN

WEATHER SUNNY

COUNTY LUCAS

R.C. NEISE

TEMP. 70°

TOWNSHIP PROVIDENCE

DWG BY PRESTON-COLVIN

PID PAVING TRAIN

SECTION 15

T 6 N R 9 E

TYPE MONUMENT MAG/WASHER

ON SURFACE - ~~BELOW~~ ON

OFFSET Q PAVEMENT 5' LT : ~~RT~~

TO EDGE PAVEMENT

STATION: 297+75.45

HORZ.DATUM: NAD83(2011)


GEOID: NAVD88 2018

GRID: NORTHING: 666412.988


EASTING: 1605084.271

LDP: NORTHING: 287405.655

EASTING: 115682.910

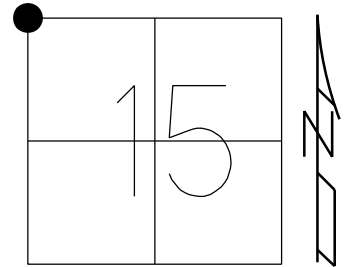

RECORD:
FD P.K.NAIL
8/29/02, DCH
SET MAG/WASHER
11/21/02, DCH
FD MAG NAIL
REF23
12/4/15, JLL
SET MAG/WASHER
7/17/17, DCH
FD MAG/WASHER
RE10
5-3-23, TDN
9-29-23, JAM
FD MAG/WASHER
6/17/24, JAB
10/2/24, TDN

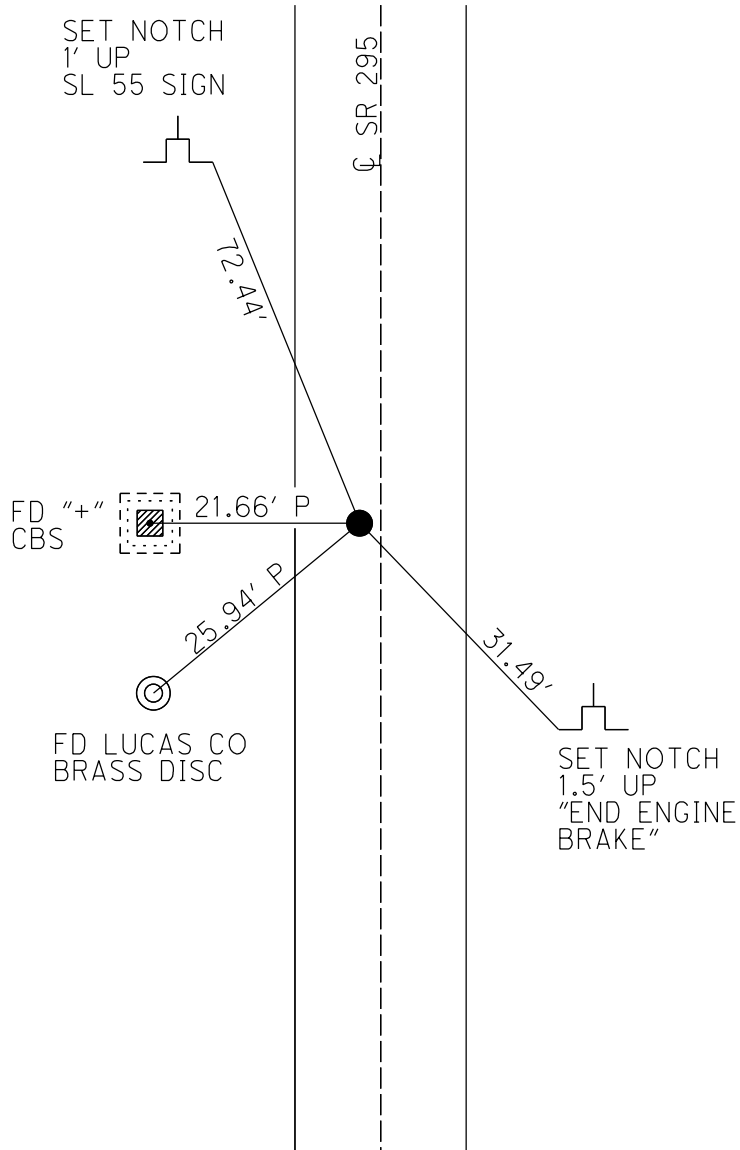

O.D.O.T. DISTRICT 2 SURVEY OFFICE (USE ONLY)

PERSONNEL

REFERENCE NO. 10

SHEET 10 OF 45

NOTES AUBLE

DATE 5-3-23

ROUTE SR 295

H.C. NIESE

WEATHER WINDY

COUNTY LUCAS

R.C. MILLER

TEMP. 48°

TOWNSHIP PROVIDENCE

DWG BY ASTON

PID CHIP SEAL

SECTION 15

T 6 N R 9 E

TYPE MONUMENT MAG/WASHER

ON SURFACE - ~~BELOW~~ ON

OFFSET Q PAVEMENT 5' LT : ~~RT~~

TO EDGE PAVEMENT


STATION: 297+75.45

HORIZ.DATUM: NAD83(2011)

GEOID: NAVD88 2018

GRID: NORTHING: 666412.988

EASTING: 1605084.271

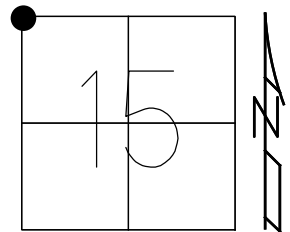

RECORD:
FD P.K.NAIL
8/29/02, DCH
SET MAG/WASHER
11/21/02, DCH
FD MAG NAIL
REF23
12/4/15, JLL
SET MAG/WASHER
7/17/17, DCH
FD MAG/WASHER
RE10
5-3-23, TDN
9-29-23, JAM

SET NOTCH
1' UP
SL 55 SIGN

Q SR 295

LUCAS: LDP
N: 287405.655
E: 115682.910

FD "+"
CBS

21.69' P

25.93' P

FD LUCAS CO
BRASS DISC

31.49'

SET NOTCH
1.5' UP
"END ENGINE
BRAKE"

O.D.O.T. DISTRICT 2 SURVEY OFFICE (USE ONLY)

PERSONNEL _____ REFERENCE NO. 10 SHEET 10 OF 45

NOTES HOMAN DATE 3/17/17 ROUTE SR 295

H.C. HOMAN WEATHER CLOUDY COUNTY LUCAS

R.C. HELDMAN TEMP. 33° TOWNSHIP PROVIDENCE

SECTION 15

T 6 N R 9 E

TYPE MONUMENT MAG NAIL


ON SURFACE - ~~BELOW~~ ON

LEFT - ℄ PAV'T - ~~RIGHT~~ 5'

6.7' TO LT EDGE PAVEMENT

S.L.M. 324+32.46

GRID: NORTHING: 666412.988 EASTING: 1605084.271

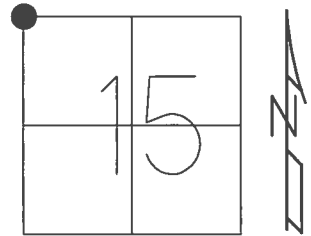

RECORD:
FD P.K.NAIL
8/29/02, DCH
SET MAG/WASHER
11/21/02, DCH
FD MAG NAIL
REF23
12/4/15, JLL
SET MAG/WASHER
7/17/17, DCH

FD "+" NE/COR
CON.CBS



21.66' P

LUCAS CO
BRASS DISC



25.93' P

℄ SR 295

O.D.O.T. DISTRICT 2 SURVEY OFFICE

PERSONNEL

REFERENCE NO. 10

SHEET 10 OF 45

NOTES BEAUMONT

DATE 8-29-02

ROUTE S.R. 295

H.C. HOMAN

WEATHER SUNNY

COUNTY LUCAS

R.C. BEAUMONT

TEMP. 79°

TOWNSHIP PROVIDENCE

SECTION 15

T 6 N R 9 E


TYPE MONUMENT P.K. NAIL

ON SURFACE - ~~BELOW~~ ON

LEFT - Q PAV'T - ~~RIGHT~~ 5'

6.7' TO LT EDGE PAVEMENT

S.L.M. 193+93

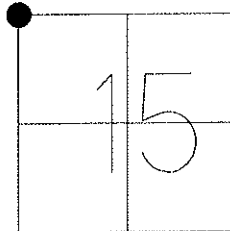

NOTE:
1/2 MILE NORTH
OF DORAN RD.

SET MAG &
WASHER
11-21-02
DCH

S.W. CORNER
CONC C.B.



26.83'
(P)

LUCAS CO.
BRASS DISC

25.93'
(P)

S.R. 295

Q PVMT.

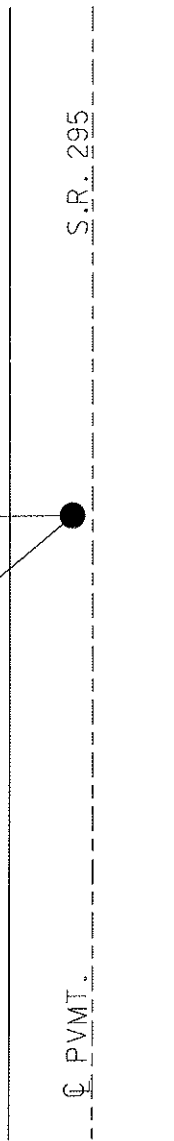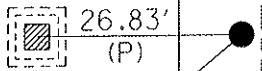

O.D.O.T. DISTRICT 2 SURVEY OFFICE

PERSONNEL

REFERENCE NO. 10

SHEET 8 OF 35

NOTES LOEHRKE

H.C. STONE

R.C. CURTIS

DATE 8-17-91

WEATHER CLEAR

TEMP. +80

ROUTE S.R. 295

COUNTY LUCAS

TOWNSHIP PROVIDENCE

SECTION 15

T.L. N R 9 E

TYPE MONUMENT P.K. Nail


ON SURFACE - BELOW YES

LEFT - PAV'T. - RIGHT

5.0 TO LT EDGE PAVEMENT

S.L.M. 193+93

Set P.K./WASHER
3-25-92

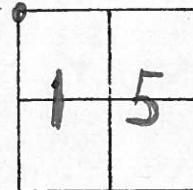

$\frac{1}{2}$ mile NORTH
of DORAN Rd.

IRON Rod in
Broken REF. Mon

28.56

F.B. 22.00

S.E. CORNER
CONC. CATCH BASIN
(NOT LID)

24.61

"+" TOP CENTER
CONC. Hdwl.

PAVT

O.D.O.T. DISTRICT 2 SURVEY OFFICE

SHEET

OF

County Lucas S.R. 295

Date 23 April 82

Township Providence

Weather Sunny

Section 9-10-15-16

Temp. 56°

T N, R E

Personnel L. Stone


R. Michalek

D. Curtis

9	10
16	15



REF. No. 10

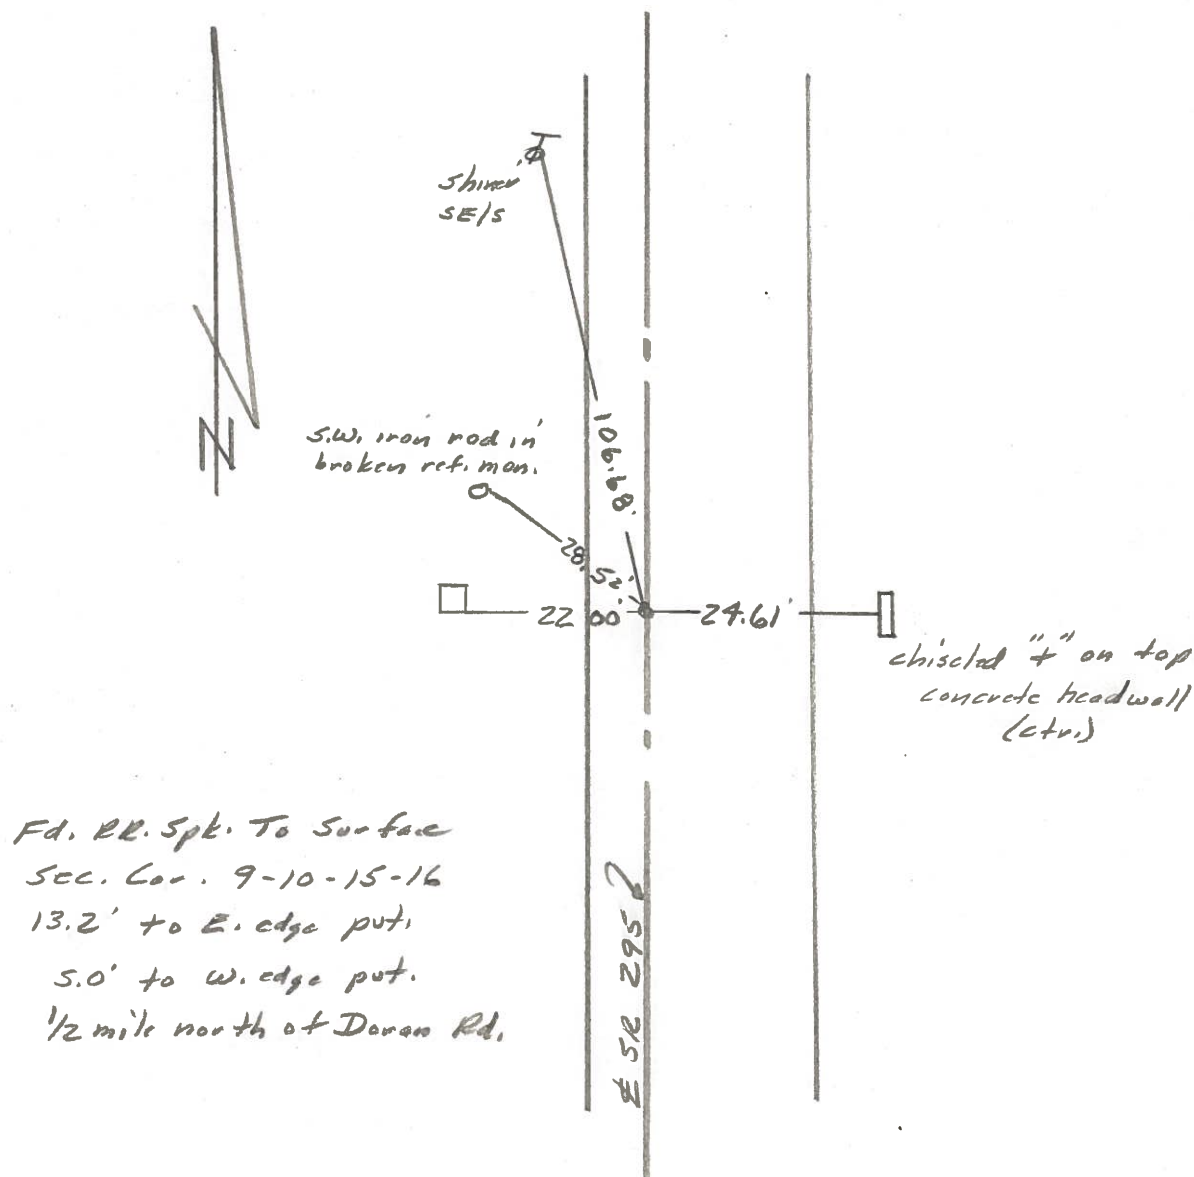

PERSONNEL TITLE PERSONNEL TITLE

COUNTY Lucas DATE 6 June 68Stone NotesBeck TapeMichalak TapeS. R. 295 WEATHER HotSEC. _____ TEMP. 88°

DESCRIPTION

References to Control Points
LEFT CENTER LINE RIGHT

JOB NO. _____

