

O.D.O.T. DISTRICT 2 SURVEY OFFICE (USE ONLY)

PERSONNEL

REFERENCE NO. 16

SHEET 17 OF 45

NOTES MILLER
H.C. MILLER
R.C. BARRIERE

DATE 6/10/24
WEATHER CLOUDY
TEMP. 54

ROUTE SR 295
COUNTY LUCAS
TOWNSHIP WATERVILLE
SECTION 33

DWG BY BLUBAUGH PID

T 7 N R 9 E

TYPE MONUMENT 3/4" IPIPE

ON SURFACE - ~~BELOW~~ ON

OFFSET Q PAVEMENT - LT : RT

- TO - EDGE PAVEMENT

STATION: 429+60.39

HORZ.DATUM: NAD83 (11)


GEOID: 18

GRID: NORTHING: 676940.678


EASTING: 1605013.336

LDP: NORTHING: 297932.118

EASTING: 115473.328

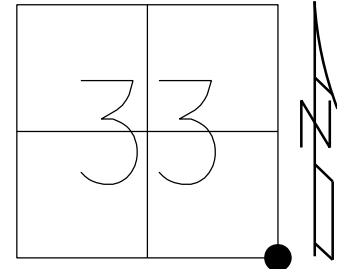

RECORD:
SET 3/4" IPIN
4/14/76
FD 3/4" IPIPE
REF37
3/22/17, DCH
FD IPIPE
REF 16
6/10/24

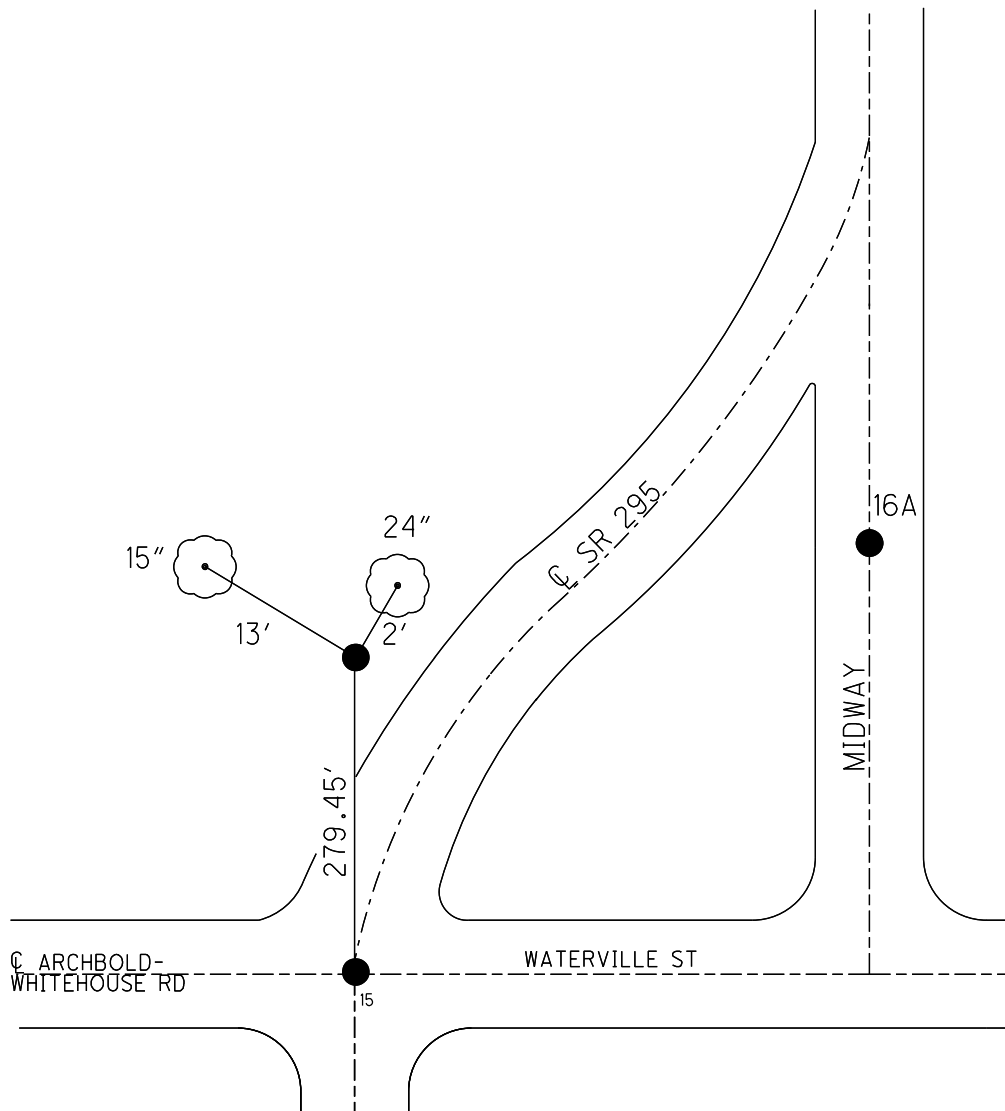

O.D.O.T. DISTRICT 2 SURVEY OFFICE (USE ONLY)

PERSONNEL

REFERENCE NO.

16

SHEET

17

OF

45

NOTES

HOMAN

DATE

3/22/17

ROUTE

SR 295

H.C.

HOMAN

WEATHER

SUNNY

COUNTY

LUCAS

R.C.

HELDMAN

TEMP.

26°

TOWNSHIP

WATERVILLE

SECTION

33

T 7 N R 9 E

TYPE MONUMENT

3/4" IPIPE

ON SURFACE - ~~BELOW~~

ON

LEFT - ℄ PAV'T - RIGHT

-

- TO - EDGE PAVEMENT

S.L.M.


429+60.39

GRID: NORTHING:

676940.678

EASTING:

1605013.336

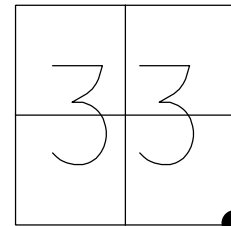

RECORD:


SET 3/4" IPIN

4/14/76

FD 3/4" IPIPE

REF37

3/22/17, DCH

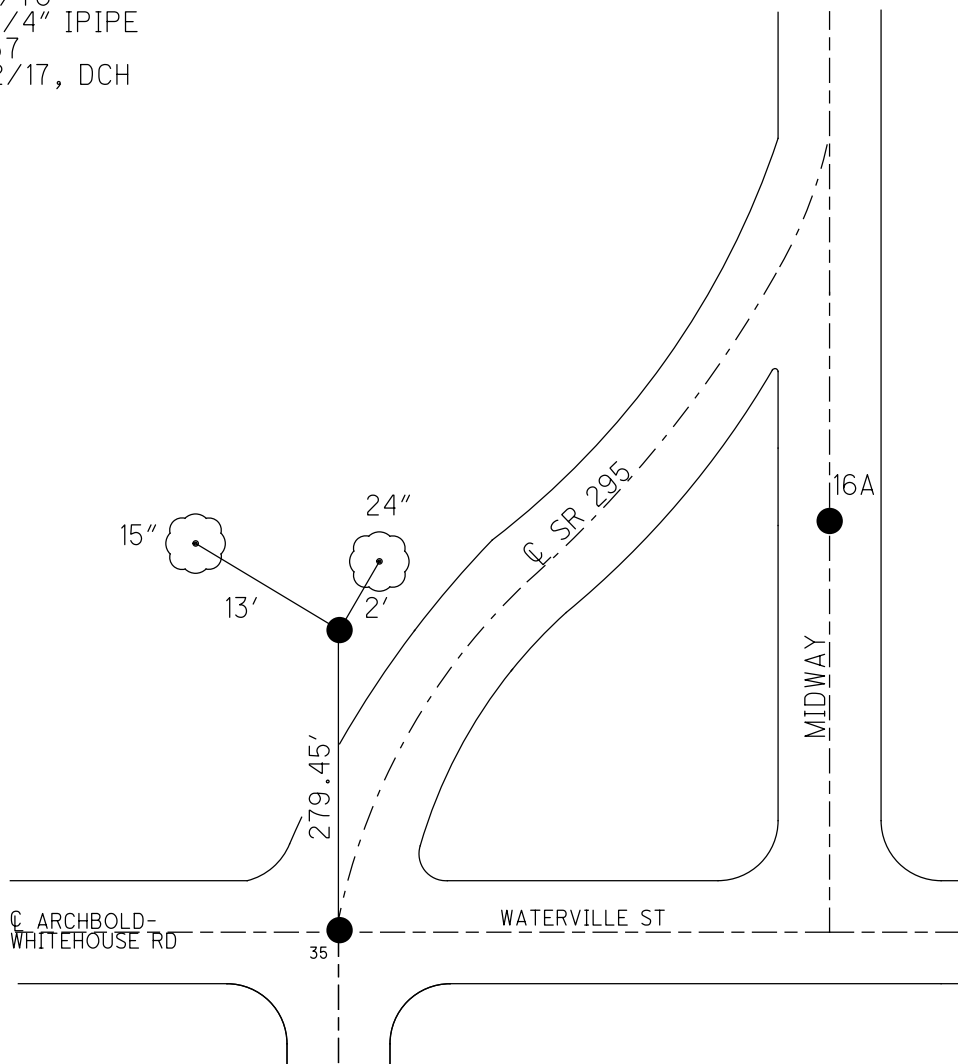

O.D.O.T. DISTRICT 2 SURVEY OFFICE

PERSONNEL

REFERENCE NO. 16


SHEET 17 OF 45

NOTES STONE
H.C. CURTIS
R.C. NEUSER
GRANATA


DATE 4/14/76
WEATHER WARM
TEMP. 74°

ROUTE SR 295
COUNTY LUCAS
TOWNSHIP WATERVILLE
SECTION 33
T 7 N R 9 E

TYPE MONUMENT SET 3/4" IRON PIN
ON SURFACE - BELOW ON
LEFT - Q PAV'T - RIGHT TO
EDGE PAVEMENT
S.L.M. TO

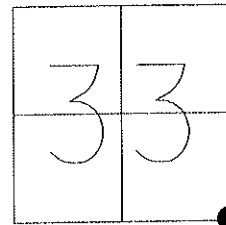


REDRAWN ON 8/26/11
NEED FIELD VISIT FOR
ORIENTATION OF EXACT
TIE LOCATIONS. JMH

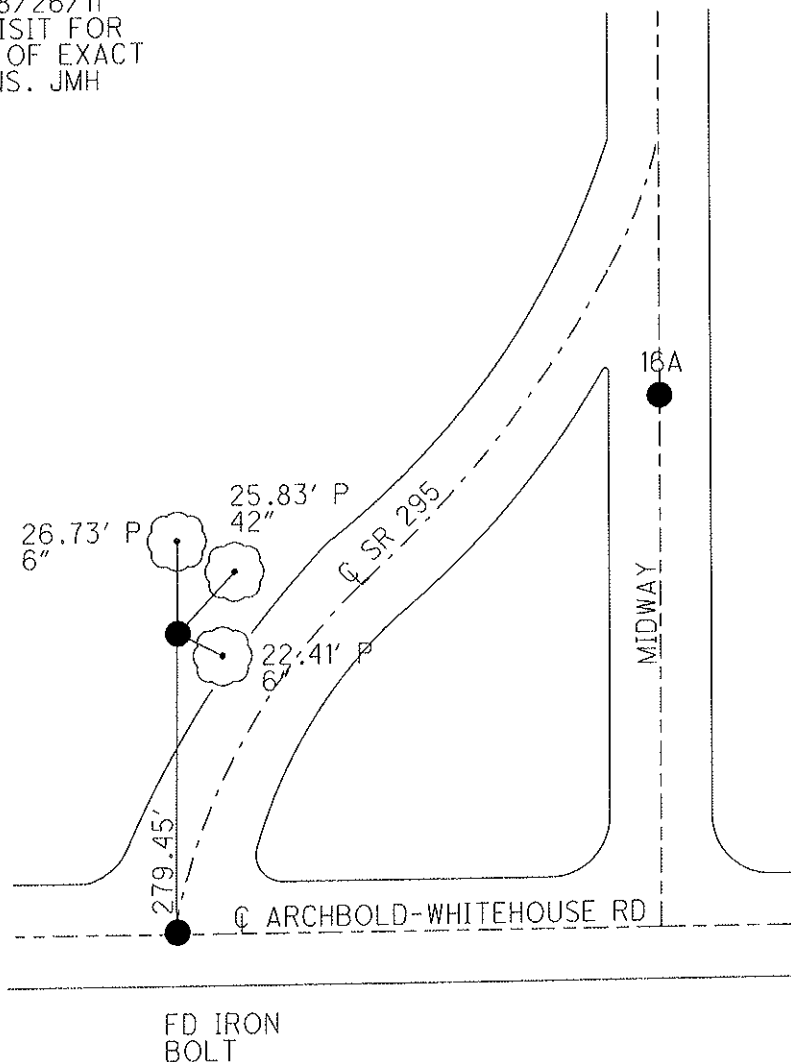

PERSONNEL	TITLE	PERSONNEL	TITLE	COUNTY	DATE	S. R.	WEATHER	SEC.	TEMP.	DESCRIPTION	JOB NO.
Stone				Lucas	14 April 76	275	Warm	5.80	74°	References to Control Points	
Curtis										LEFT	
Nusser										CENTER LINE	
Granata										RIGHT	

TWP 7N
RNG 9E
33 QUAD. SE SEC.

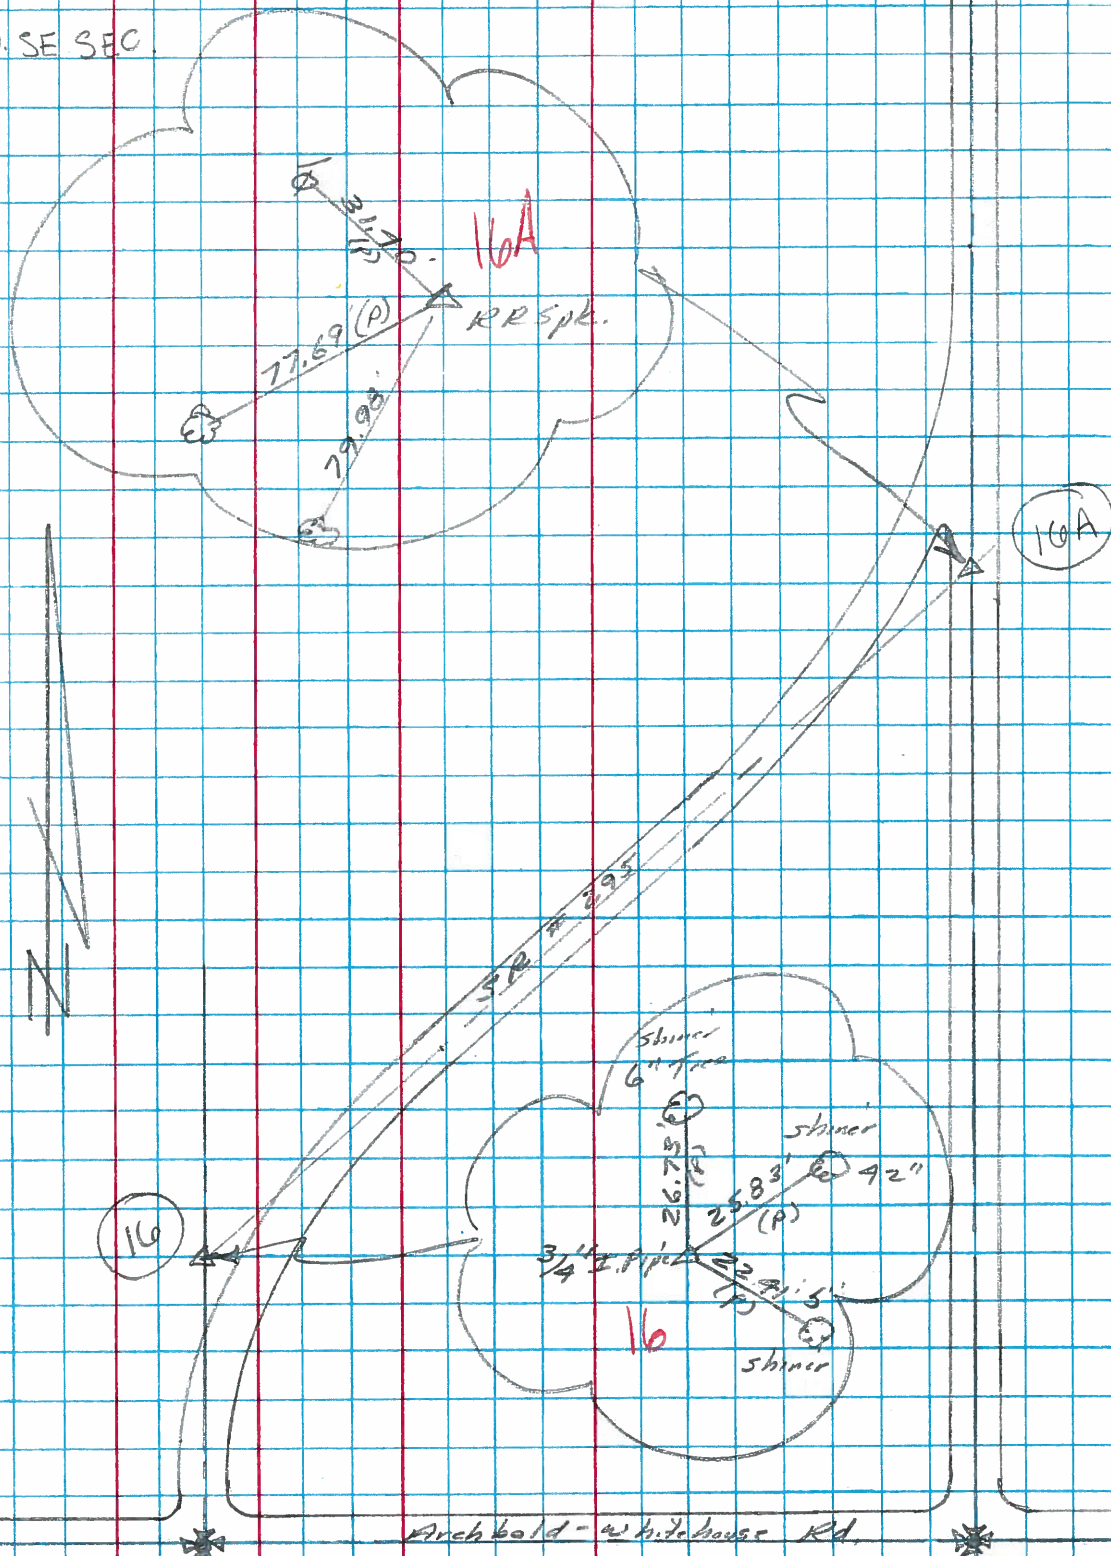

PERSONNEL TITLE PERSONNEL TITLE

COUNTY Lucas DATE 14 April 76

S. R. 295 WEATHER Warm

SEC. 5.80 ± TEMP. 72°

DESCRIPTION

LEFT

CENTER LINE

RIGHT

JOB NO.

